



O.D.O.T. DISTRICT 2 SURVEY OFFICE (USE ONLY)

PERSONNEL _____ REFERENCE NO. 26 U SHEET 17 OF 25
 NOTES LEU DATE 8/20/14 ROUTE SR 65
 H.C. HOMAN WEATHER SUNNY COUNTY WOOD
 R.C. WESTFALL TEMP. 80° TOWNSHIP PERRYSBURG
 _____ SECTION RT 64
 _____ T 7 N R 10 E

TYPE MONUMENT P.K.NAIL
~~ON SURFACE~~ - BELOW 2 1/2"
 LEFT - CL PAV'T - ~~RIGHT~~ 1.2'
10.4' TO LT EDGE PAVEMENT
 S.L.M. 886+53.68
 Grid: Northing: 688050.991 Easting: 1651922.384

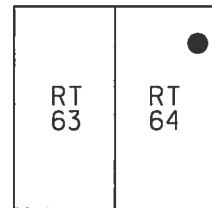

RECORD: P.I.
 STA. 884+42.18
 $\Delta = 9^\circ 51' 40''$ LT
 FD P.K.SHANK
 IN HOLE
 5/11/84, SAH
 FD P.K./WASHER
 5/18/95, SAH
 SET P.K./WASHER
 8/15/95, CL
 FD P.K./WASHER
 REFU26
 9/24/12, SAH
 FD P.K.SHANK
 REFM26
 8/20/14, EBW
 SET MAG/WASHER
 6/8/17, DCH

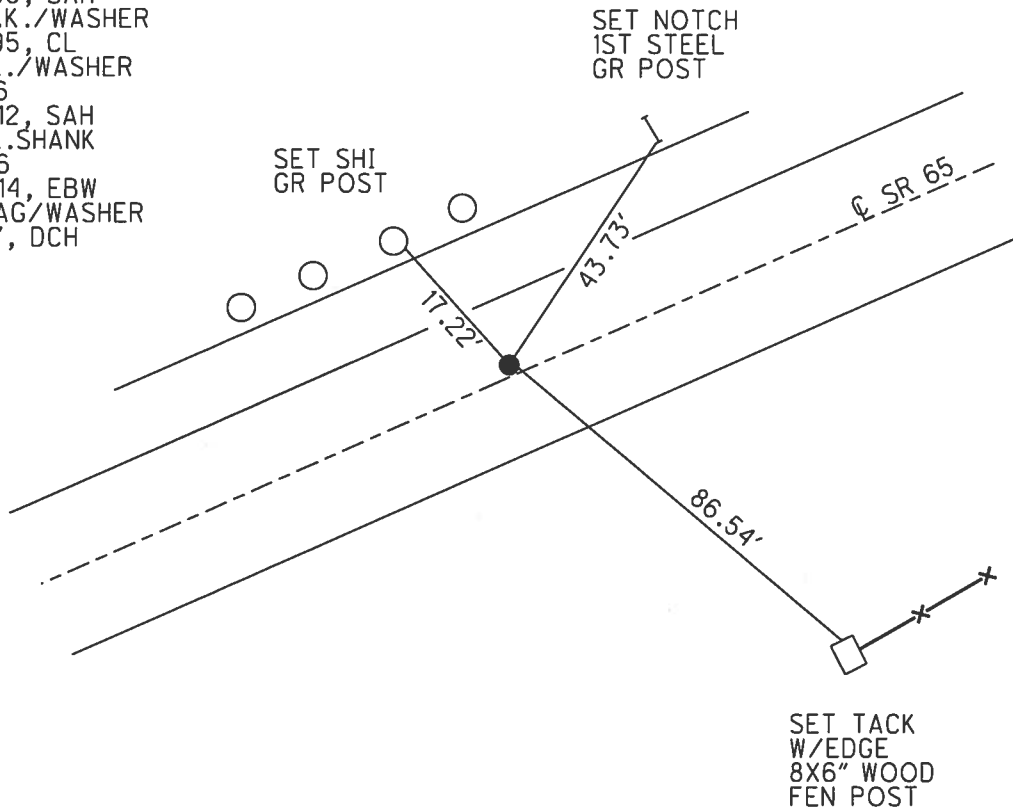

O.D.O.T. DISTRICT 2 SURVEY OFFICE

PERSONNEL _____

REFERENCE NO. _____

SHEET 85 OF 91

NOTES Van Dusen

H.C. Moser

R.C. Huss

DATE 5-18-95

WEATHER Cloudy

TEMP. +55° F.

ROUTE SR-65

COUNTY Wood

TOWNSHIP Perrysburg

SECTION R.T. 64

T 7 N R 10 E


TYPE MONUMENT PK/Washer

(ON SURFACE) - BELOW on surface


LEFT - & PART - RIGHT left of &

12.5' TO the EDGE PAVEMENT

S.L.M. 884147

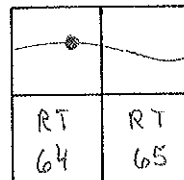

Set PK/Washer
8-15-95 C.L.

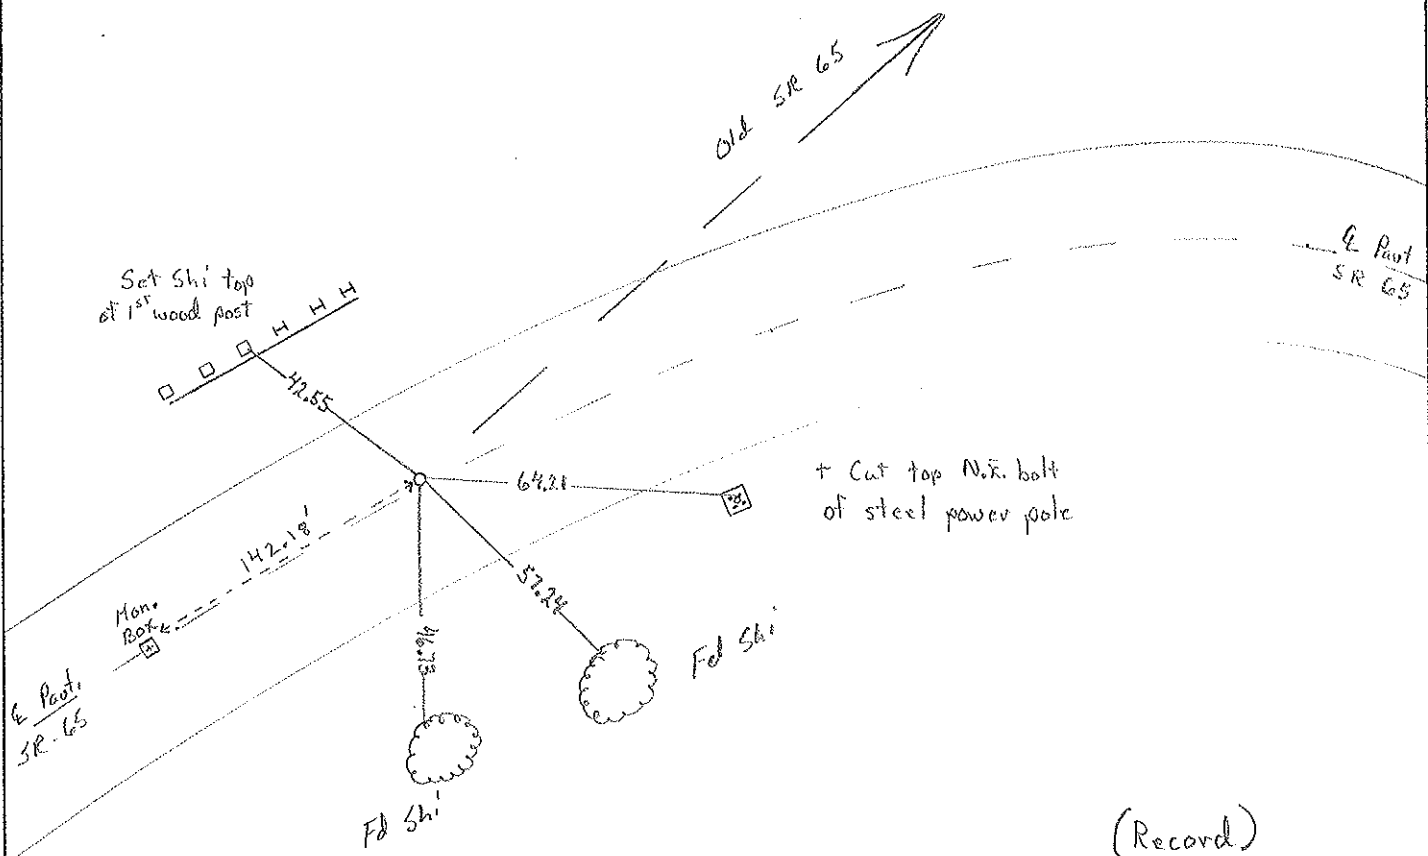

(Record)

Old P.I. - 884+42.18
 $\Delta = 90^\circ - 51' - 40''$ Lt.

F&H Hole w/ Shank of PK
set by J. Stone 4-26-77
1.0' Lt &
11.0' Lt EOP S.H.
13.1' Rt EOP 5-11-84

County Wood S.R. 65

Date 5-11-84

Township Perrysburg

Weather P. CLEAR

Section R.T. 64

Temp. 60°

T7N, R10E

Personnel Hoffman

Loehrer

Householder H.C.

Barnhiser R.C.

26-U

RT	RT
64	65




Fd Hole w/ Shank of P.K. set by I. Stone 4-26-77
 1.0' LT of & PAUT
 11.0' TO LT. EP.
 13.1' TO RT. EP.

SLM 884+47


SET PK/WASHER
 11-5-84
 S.W.H.

Record:
 OLD P.I. = 884+42.18
 $\Delta = 90^\circ - 51' - 40''$ LT
 SET P.K. PER OLD PLAN

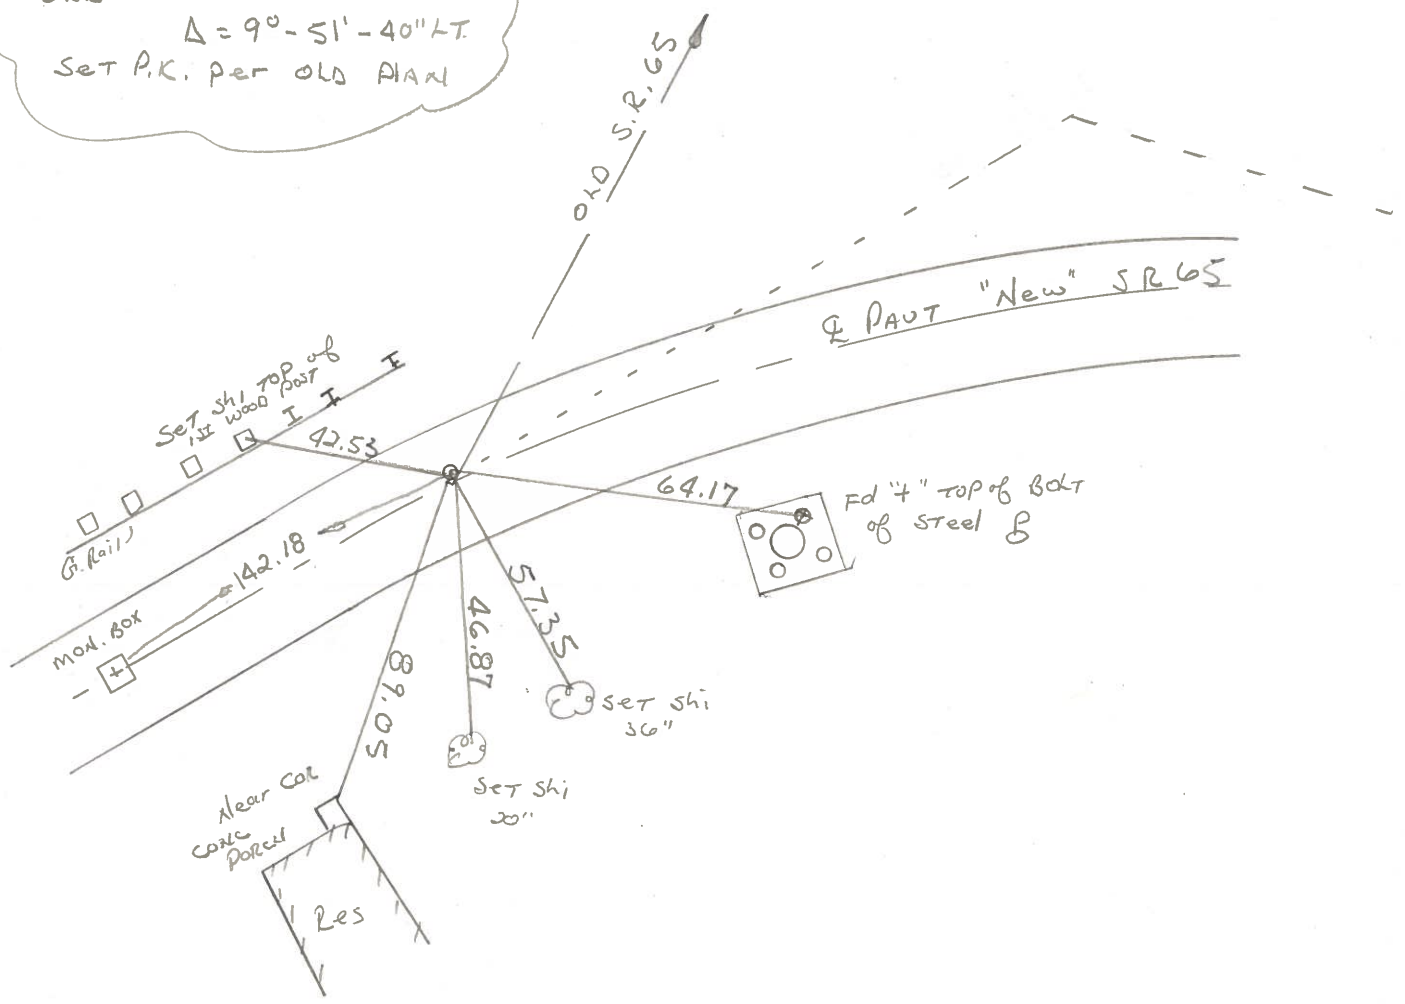

PERSONNEL _____ TITLE _____ PERSONNEL _____ TITLE _____
 COUNTY Wood DATE 26 April '77
 S. R. SR #65 WEATHER Fair
PERRYBURG TWP
 SEC. 16.76 TEMP. 55°

DESCRIPTION Reference to Central Points JOB NO. _____
 LEFT CENTER LINE RIGHT

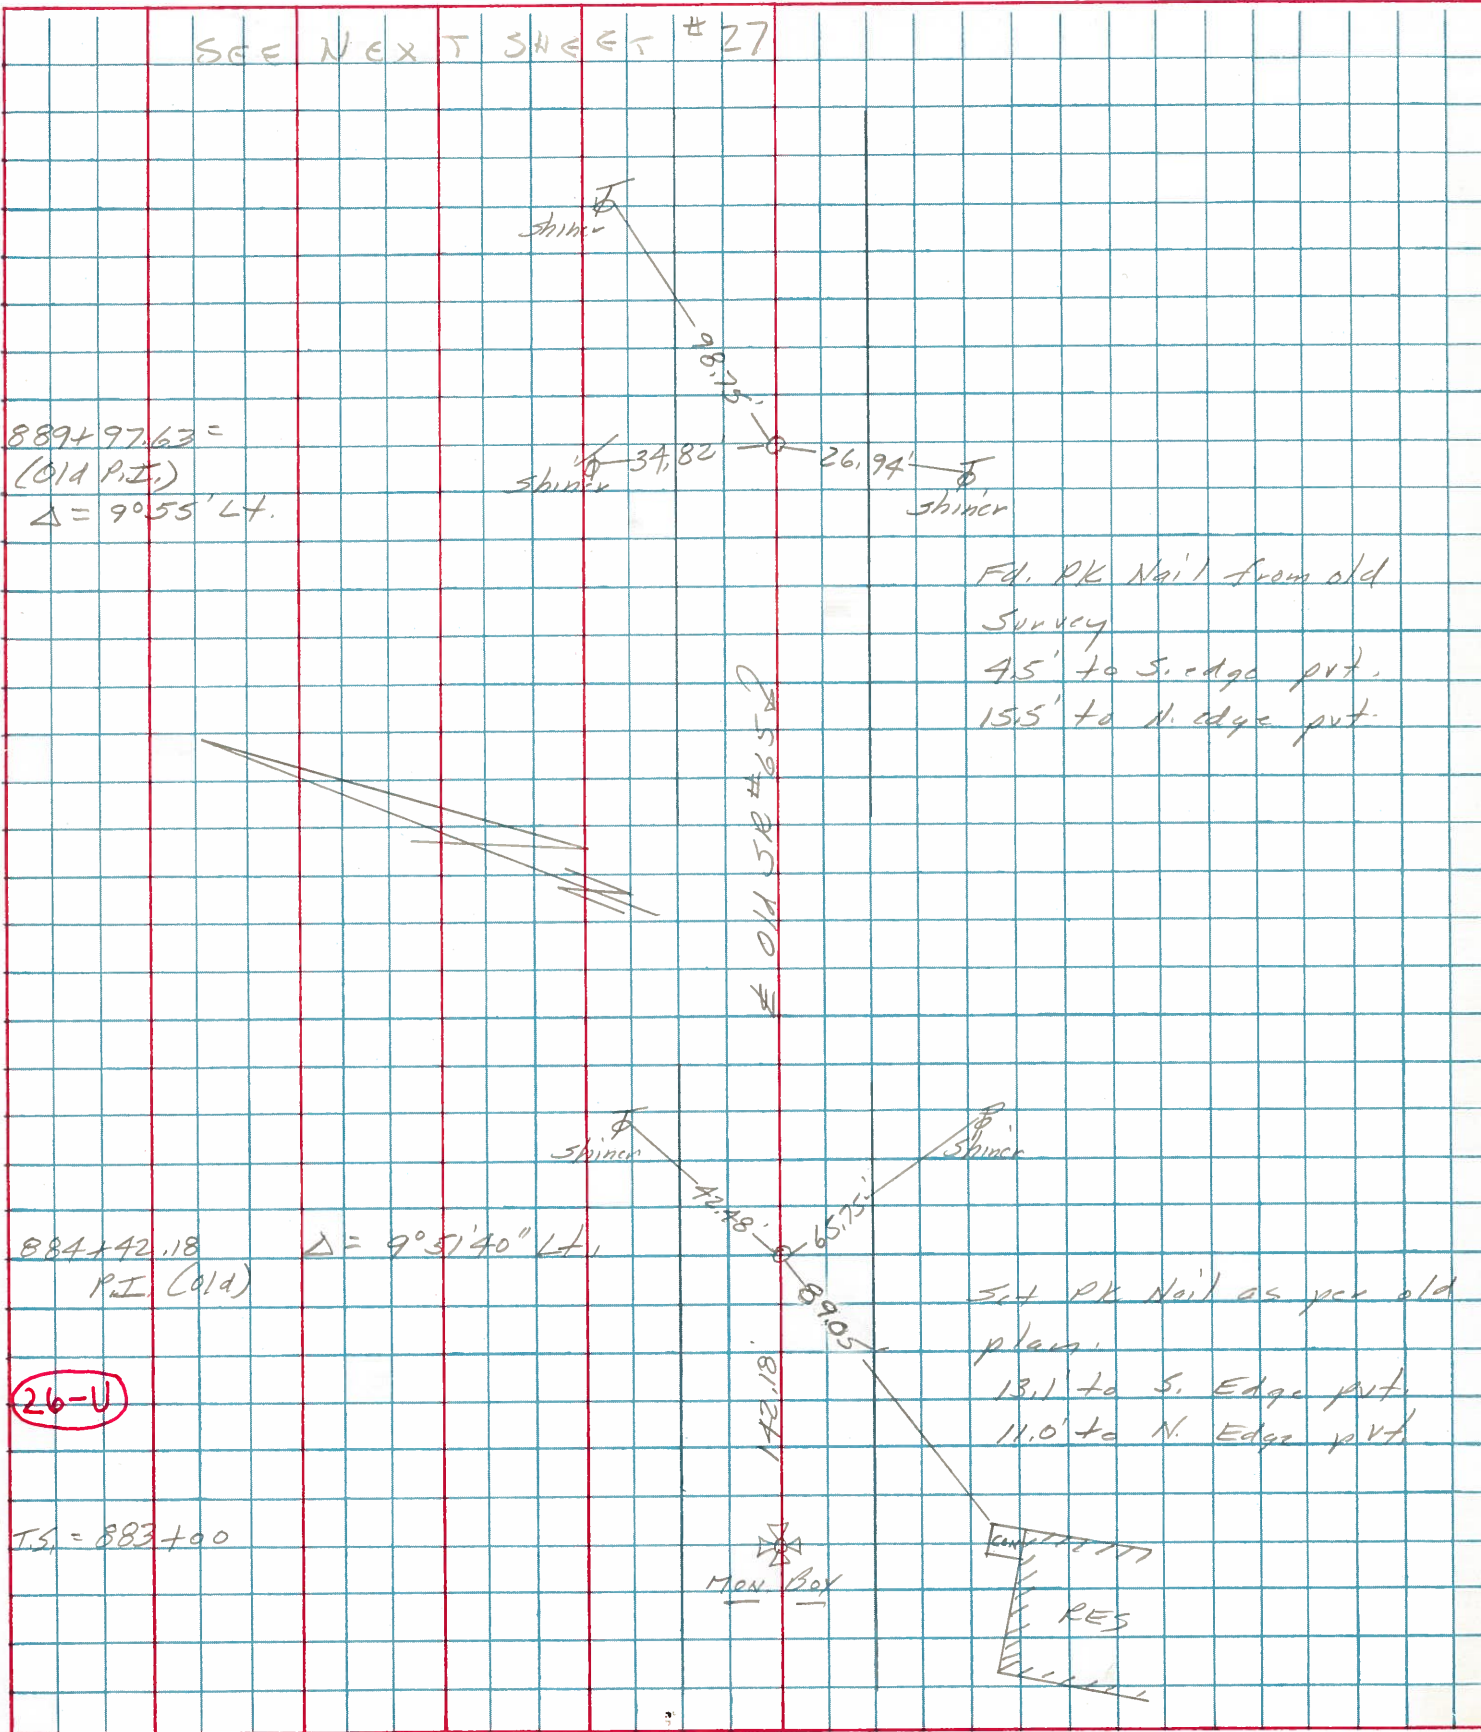

PERSONNEL	TITLE	PERSONNEL	TITLE	COUNTY	DATE
Radenmaski	IV			Wood	11-9-68
Michalak	H.C.			S. R. 65	WEATHER Cold-Clear
Beck	P.C.			SEC. Ft. Meigs	TEMP. 25°
Schroder	I				JOB NO. 02466

Ref. to control Points

