



O.D.O.T. DISTRICT 2 SURVEY OFFICE (USE ONLY)

PERSONNEL _____ REFERENCE NO. 26 UV1 SHEET 18 OF 25
 NOTES LEU DATE 8/20/14 ROUTE SR 65
 H.C. HOMAN WEATHER PTLY CLOUDY COUNTY WOOD
 R.C. WESTFALL TEMP. 80° TOWNSHIP PERRYSBURG
 _____ SECTION RT 64 & 65
 _____ T 7 N R 10 E

TYPE MONUMENT P.K.NAIL
~~ON SURFACE~~ - BELOW 2"
 LEFT - ☉ PAV'T - ~~RIGHT~~ 42'±
 - TO - EDGE PAVEMENT
 S.L.M. 894+00
 Grid: Northing: 688247.177 Easting: 1652650.889

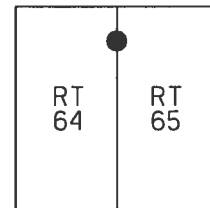

RECORD:
 STA. 9+43.89
 ☉ FT. MEIGS RD
 FD HOLE W/P.K.SHANK
 POINT W/STATS
 SET P.K.NAIL
 5/11/84, CL
 D.N.F. POINT
 9/24/12, SAH
 FD P.K.NAIL
 2" DOWN
 REFN26
 8/20/14, EBW

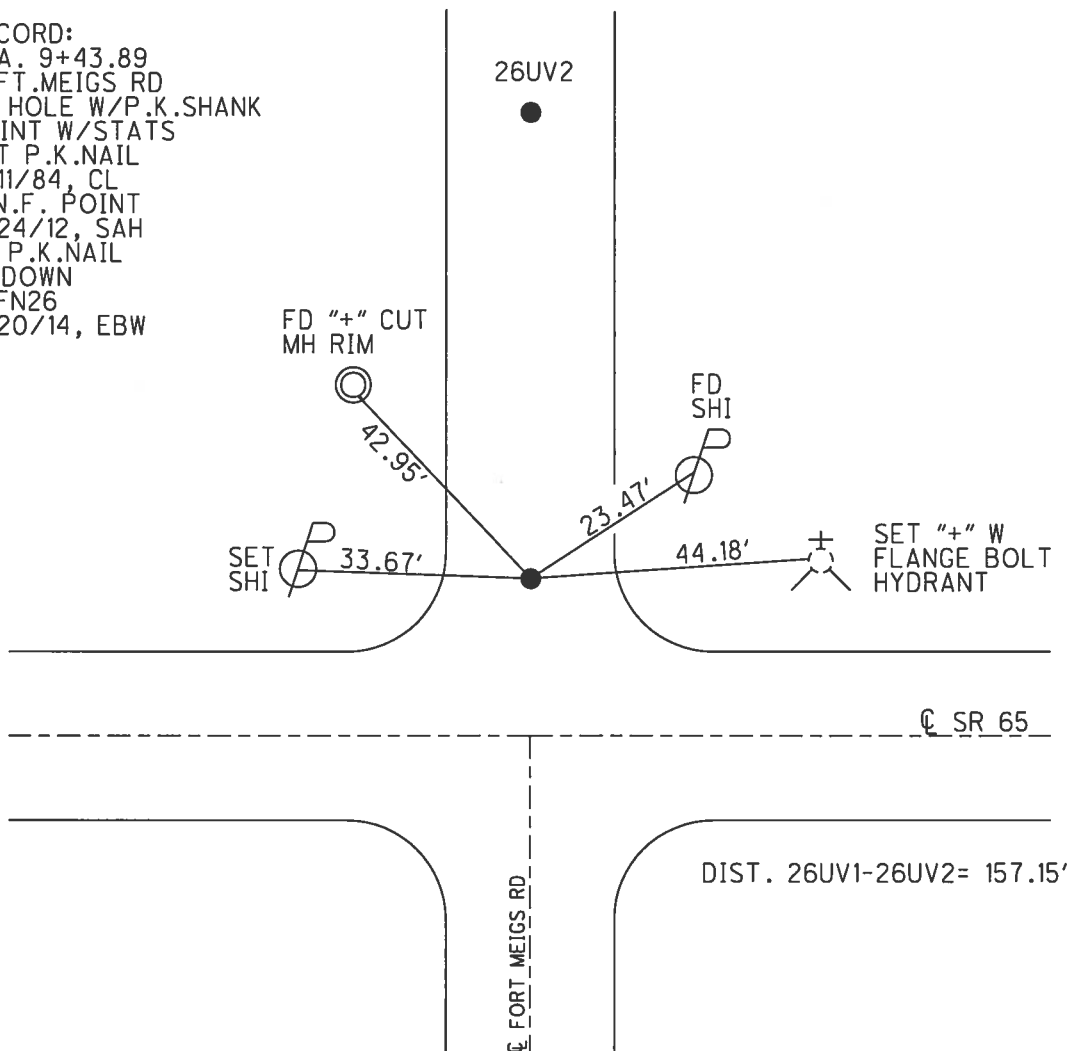


DIST. 26UV1-26UV2= 157.15'

O.D.O.T. DISTRICT 2 SURVEY OFFICE (USE ONLY)

PERSONNEL _____ REFERENCE NO. 26 UV2 SHEET 19 OF 25


NOTES LEU DATE 8/20/14 ROUTE SR 65
 H.C. HOMAN WEATHER PTLY CLOUDY COUNTY WOOD
 R.C. WESTFALL TEMP. 80° TOWNSHIP PERRYSBURG
 SECTION RT 64 & 65
 T 7 N R 10 E

TYPE MONUMENT MAG/WASHER
 ON SURFACE - ~~BELOW~~ ON _____
 LEFT - C PAV'T - ~~RIGHT~~ 199.13'±
 - TO - EDGE PAVEMENT
 S.L.M. 894+00

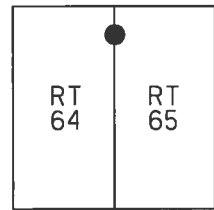

Grid: Northing: 688404.302 Easting: 1652653.097

RECORD:
 STA. 11+01.06
 C. FT. MEIGS RD
 FD P.K.NAIL
 5/11/84, CL
 D.N.F. POINT
 9/24/12, SAH
 SET MAG/WASHER
 REFP26
 8/20/14, EBW
 FD MAG/WASHER
 6/8/17, DCH

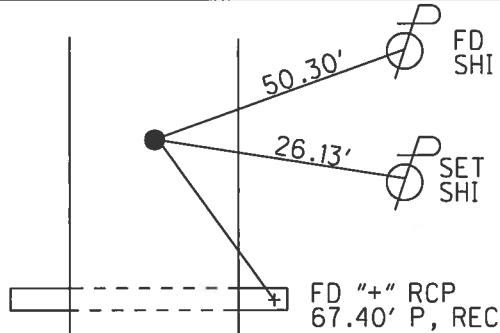

●
26UV1

⊖ SR 65

⊖ FORT MEIGS RD

DIST. 26UV1-26UV2= 157.15'

County WOOD S.R. 65

Date 5-11-84

Township PERRYSBURG

Weather P. CLEAR


Section R.T. 64 & 65

Temp. 60°

T7N, R1E

Personnel HOFFMAN
LOEHRKE
HOUSEHOLDER H.C.
BARNHISEL R.C.


26-UV1
26-UV2

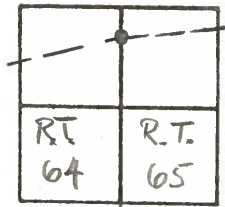

"B" = Fd P.K. @ surface
 Rec. - STA. 11+01.06 & FT. MEIGS ROAD
 (TRANSIT TIE)

NOTE:
 ALSO See NOTES BY I. STONE
 of 4-26-77

"A" Fd Hole w/ shank of PK
 AND 4 Ref Nails . x .
 Reset P.K.
 Rec. - STA. 9+43.89 & FT. MEIGS ROAD
 (TRANSIT TIE)
 SROG SLM

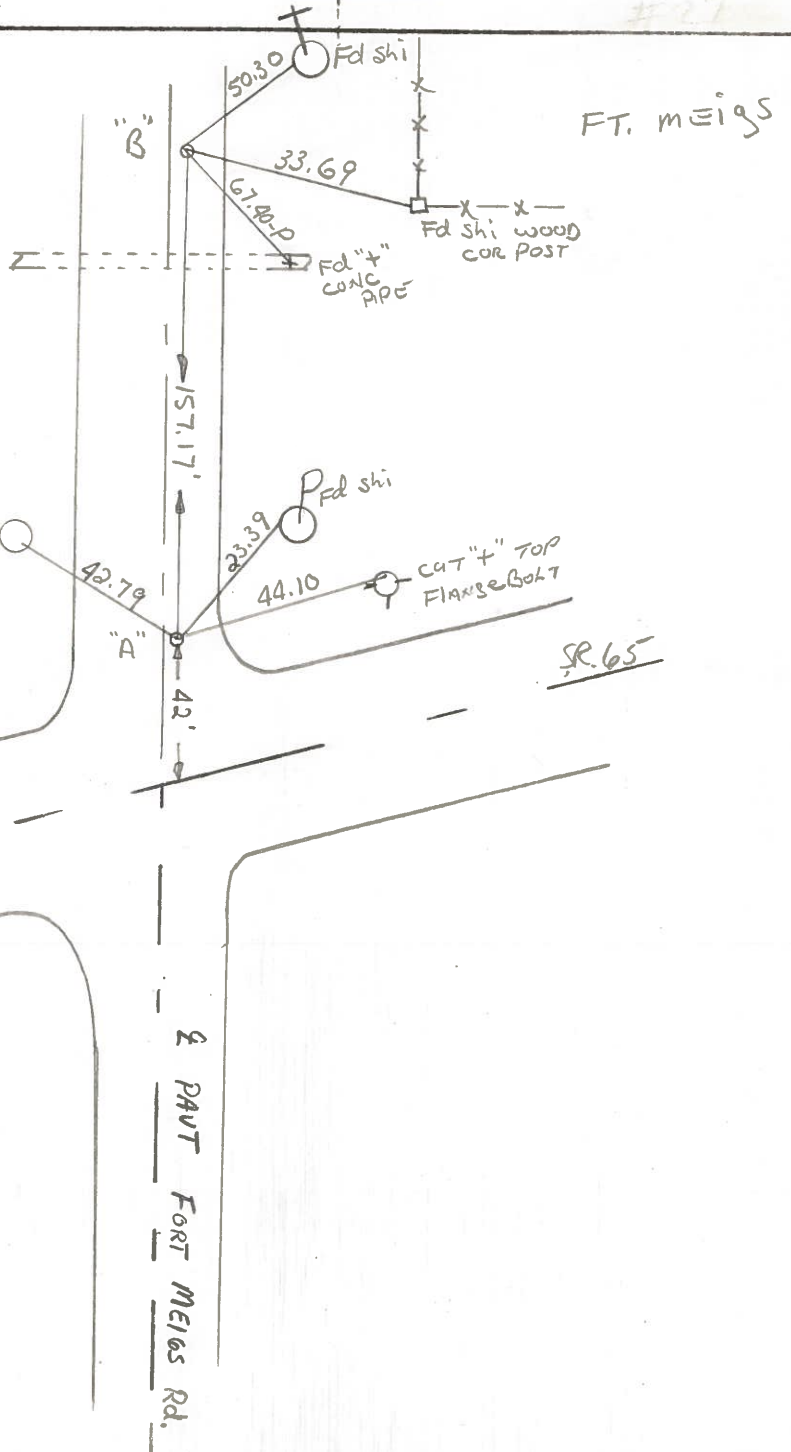

O.D.O.T. DISTRICT 2 SURVEY OFFICE

PERSONNEL _____

REFERENCE NO. _____

SHEET 86 OF 91

NOTES Hoffman

H.C. Householder

R.C. Barnhisel

Loehrke

DATE 5-1-84

WEATHER Pt. Clear

TEMP. +60° F

ROUTE SR-65

COUNTY Wood

TOWNSHIP Perrysburg

SECTION RT-64 + 65

T 7 N R 10 E

TYPE MONUMENT _____

ON SURFACE - BELOW _____


LEFT - ☉ PAV'T. - RIGHT _____

_____ TO _____ EDGE PAVEMENT

S.L.M. _____


26-UV1

26-UV2

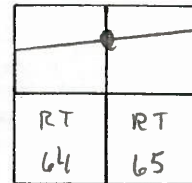

(A) Fd hole w/shank of PK
and 4 ref nails 'x'.
Reset PK -
Record 9+43.89 @ Ft Meigs Rd
Transit Tie

(B) Fd PK @ surface
Rec- Sta. 11+01.06 @ Ft Meigs Rd
transit tie

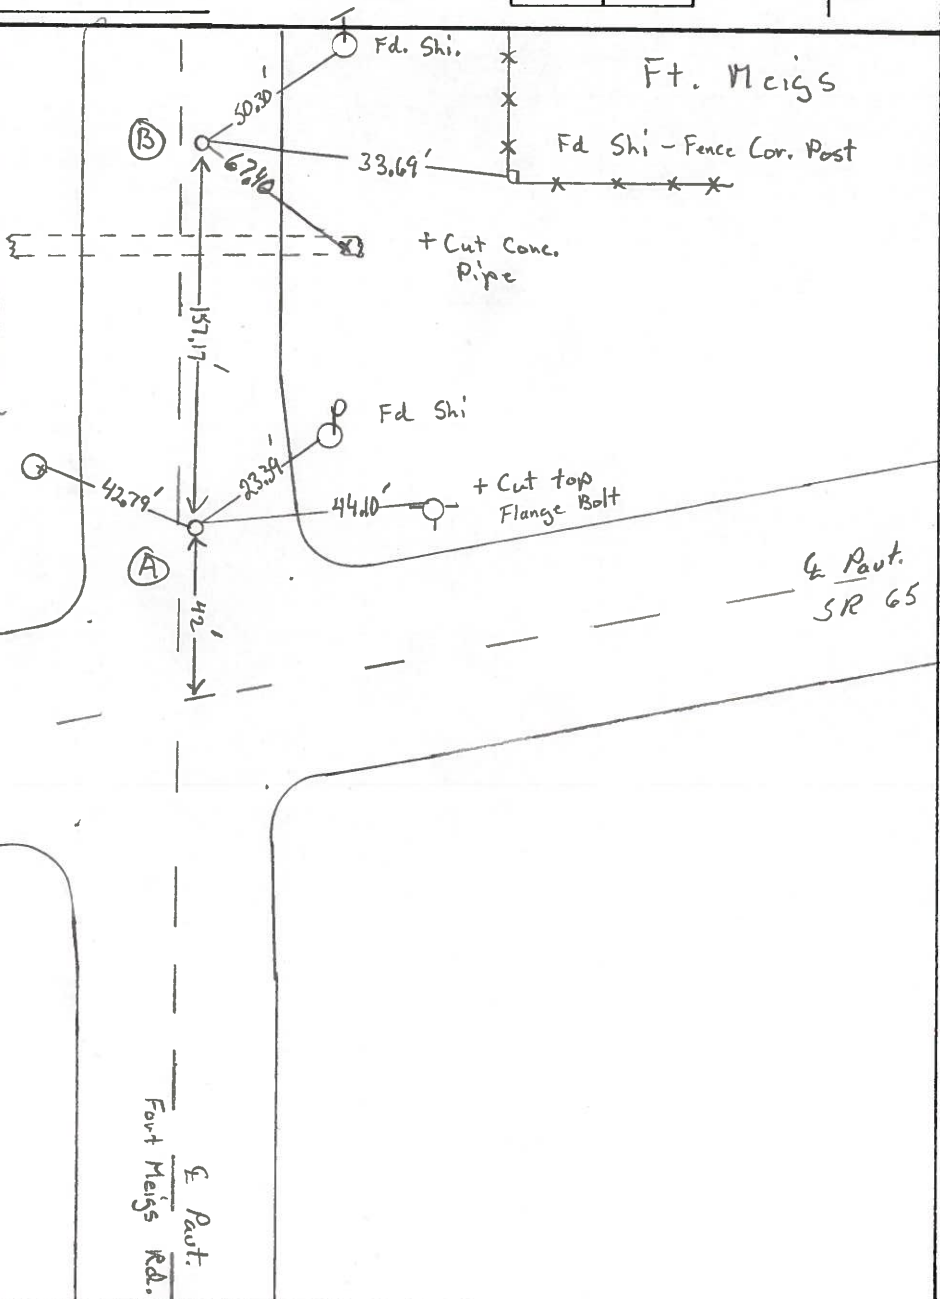

☉ Pavt.
SR-65

☉ Pavt.
SR-65

☉ Pavt.
Fort Meigs Rd.

PERSONNEL	TITLE	PERSONNEL	TITLE	COUNTY	DATE
Stoye				Wood	26 Apr. 77
E				S. R. #65	WEATHER Fair
Crew				PERRYSBURG TWP	TEMP. 55°
				SEC. 16.76	

DESCRIPTION References to Control Points JOB NO. _____

LEFT CENTER LINE RIGHT

