

O.D.O.T. DISTRICT 2 SURVEY OFFICE (USE ONLY)

PERSONNEL _____ REFERENCE NO. 27 SHEET 25 OF 25

NOTES	<u>RHOADES</u>	DATE	<u>4/9/14</u>	ROUTE	<u>SR 65</u>
H.C.	<u>ROUSOS</u>	WEATHER	<u>CLEAR</u>	COUNTY	<u>WOOD</u>
R.C.	<u>HOMAN</u>	TEMP.	<u>41°</u>	TOWNSHIP	<u>PERRYSBURG</u>
	<u>GABLE</u>			SECTION	<u>6, RT 67</u>
				T	<u>4</u> N
				R	<u>11</u> E

TYPE MONUMENT SM.R.R.SPIKE


ON SURFACE - ~~BELOW~~ ON

LEFT - ☉ PAV'T - RIGHT - _____

_____ TO _____ EDGE PAVEMENT


S.L.M. 936+25.33

Grid: Northing: 689187.351 Easting: 1656600.601

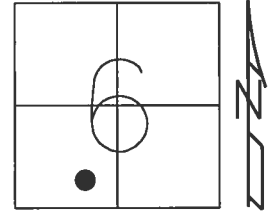

NOTE: REF 54E SR 25

RECORD:
 FD SM.R.R.SPIKE
 4/22/91, I.S.
 SET SM.R.R.SPIKE
 6/6/91, DJC
 FD SM.R.R.SPIKE
 REFE54
 9/24/12, SAH
 SET MAG/WASHER
 REFE54
 6/19/15, DCH

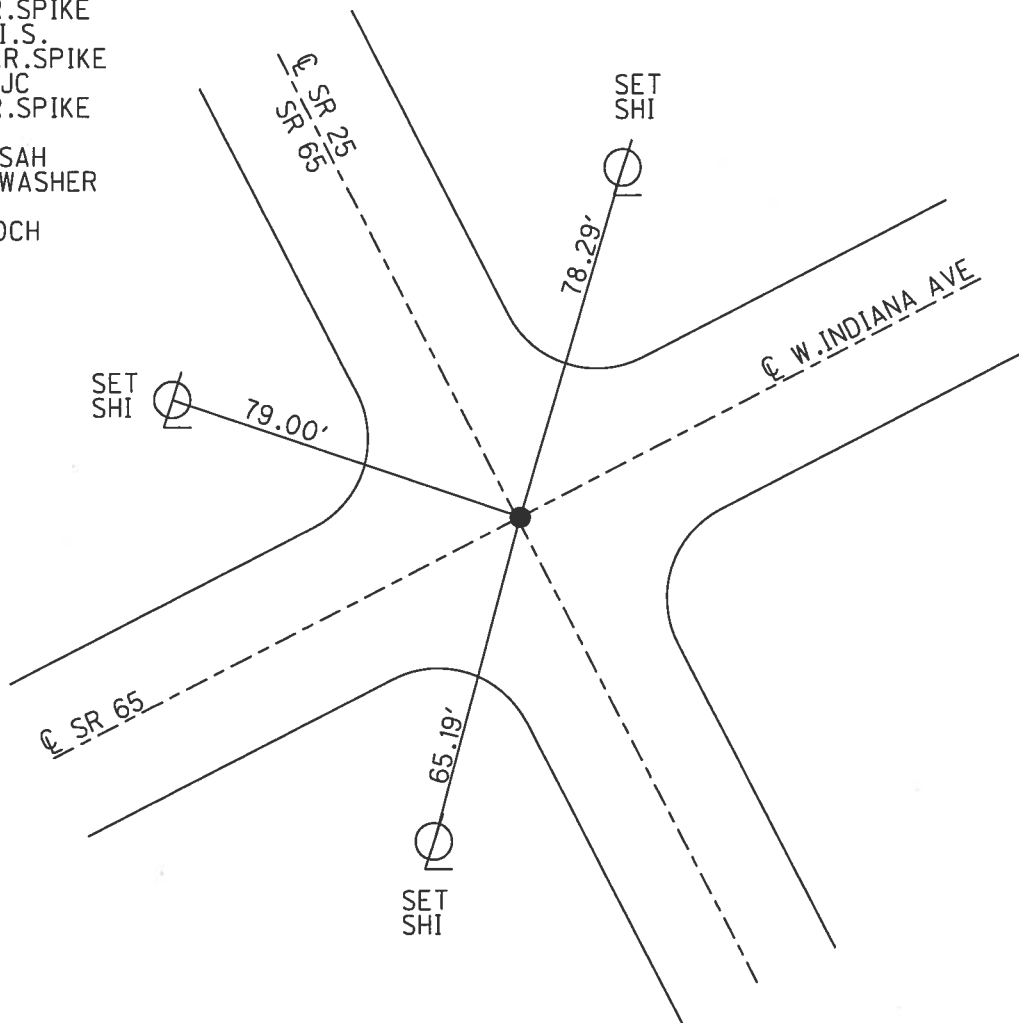

O.D.O.T. DISTRICT 2 SURVEY OFFICE

91 of 91 SRGS

PERSONNEL

REFERENCE NO. 54-E

SHEET 28 OF 29

NOTES L. Stone

H.C. D. Curtis

R.C. J. Householder

DATE 22 April 91

WEATHER Cool

TEMP. 48°

ROUTE SR #25

COUNTY Wood

TOWNSHIP Perrysburg

SECTION _____

T _____ R _____

TYPE MONUMENT Sm. RR Spk.


ON SURFACE - BELOW Surface

LEFT - & PAV'T. - RIGHT _____

TO _____ EDGE PAVEMENT

S.L.M. 1179+15


(27)

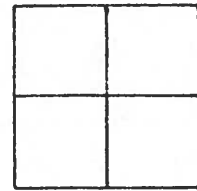

SET SM. R. P. SPK. TO SURFACE

6-6-91

AJC

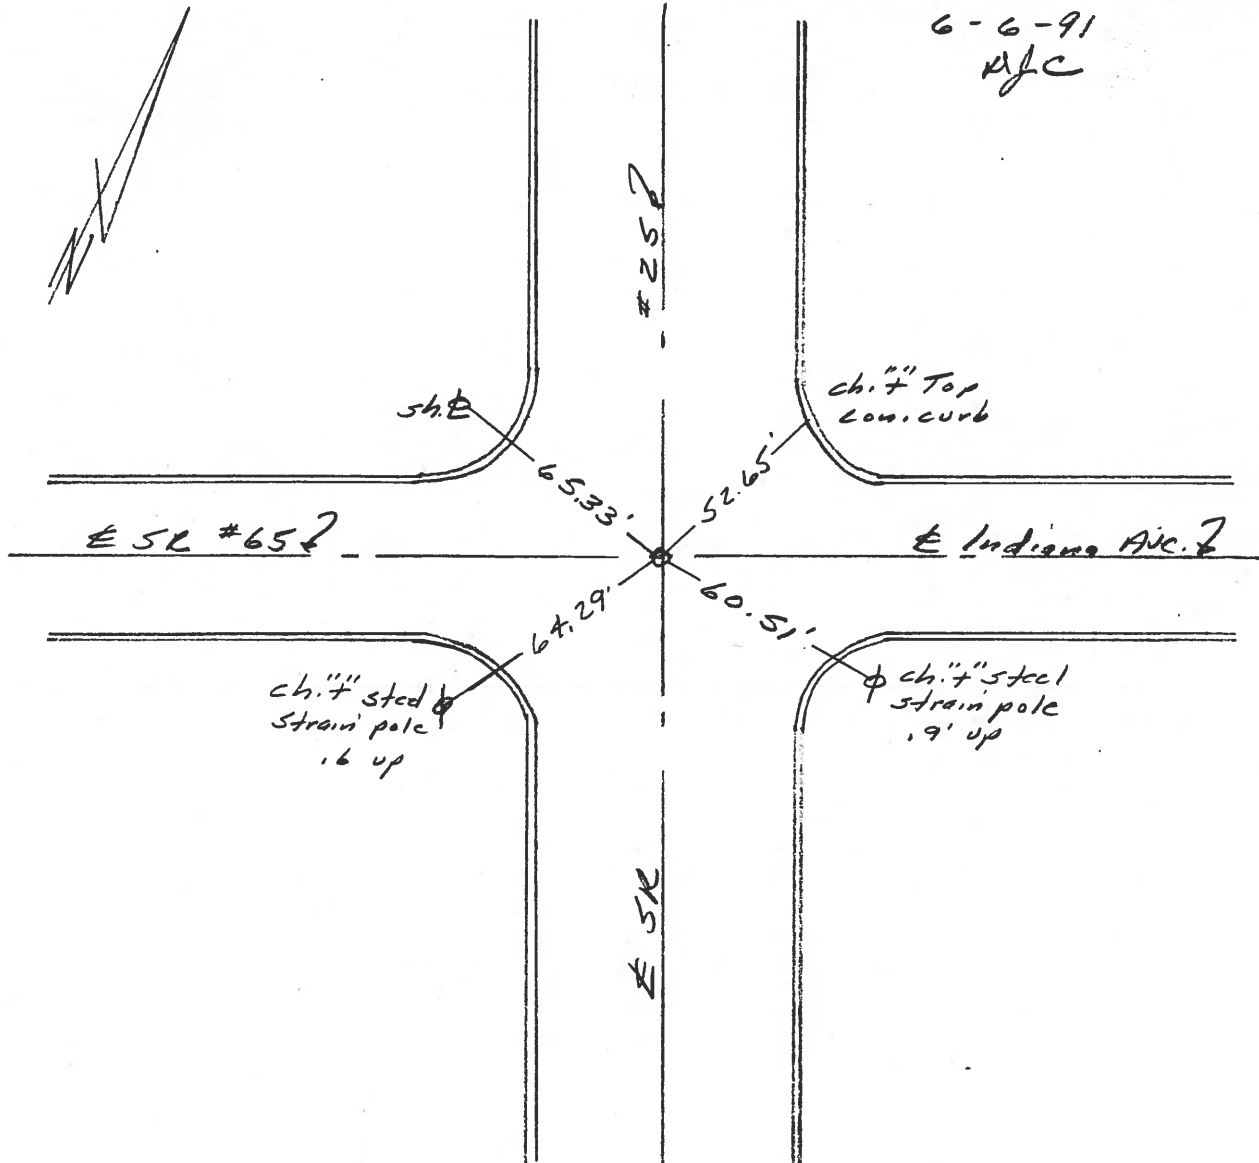

PERSONNEL TITLE PERSONNEL TITLE

Stoye
E
Crew


COUNTY Wood DATE 26 Apr. 77

S. R. # 65 WEATHER Fair
PERRYSBURG TWP

SEC. 16.76 TEMP. 55°

DESCRIPTION References to Control Points JOB NO. _____

LEFT CENTER LINE RIGHT

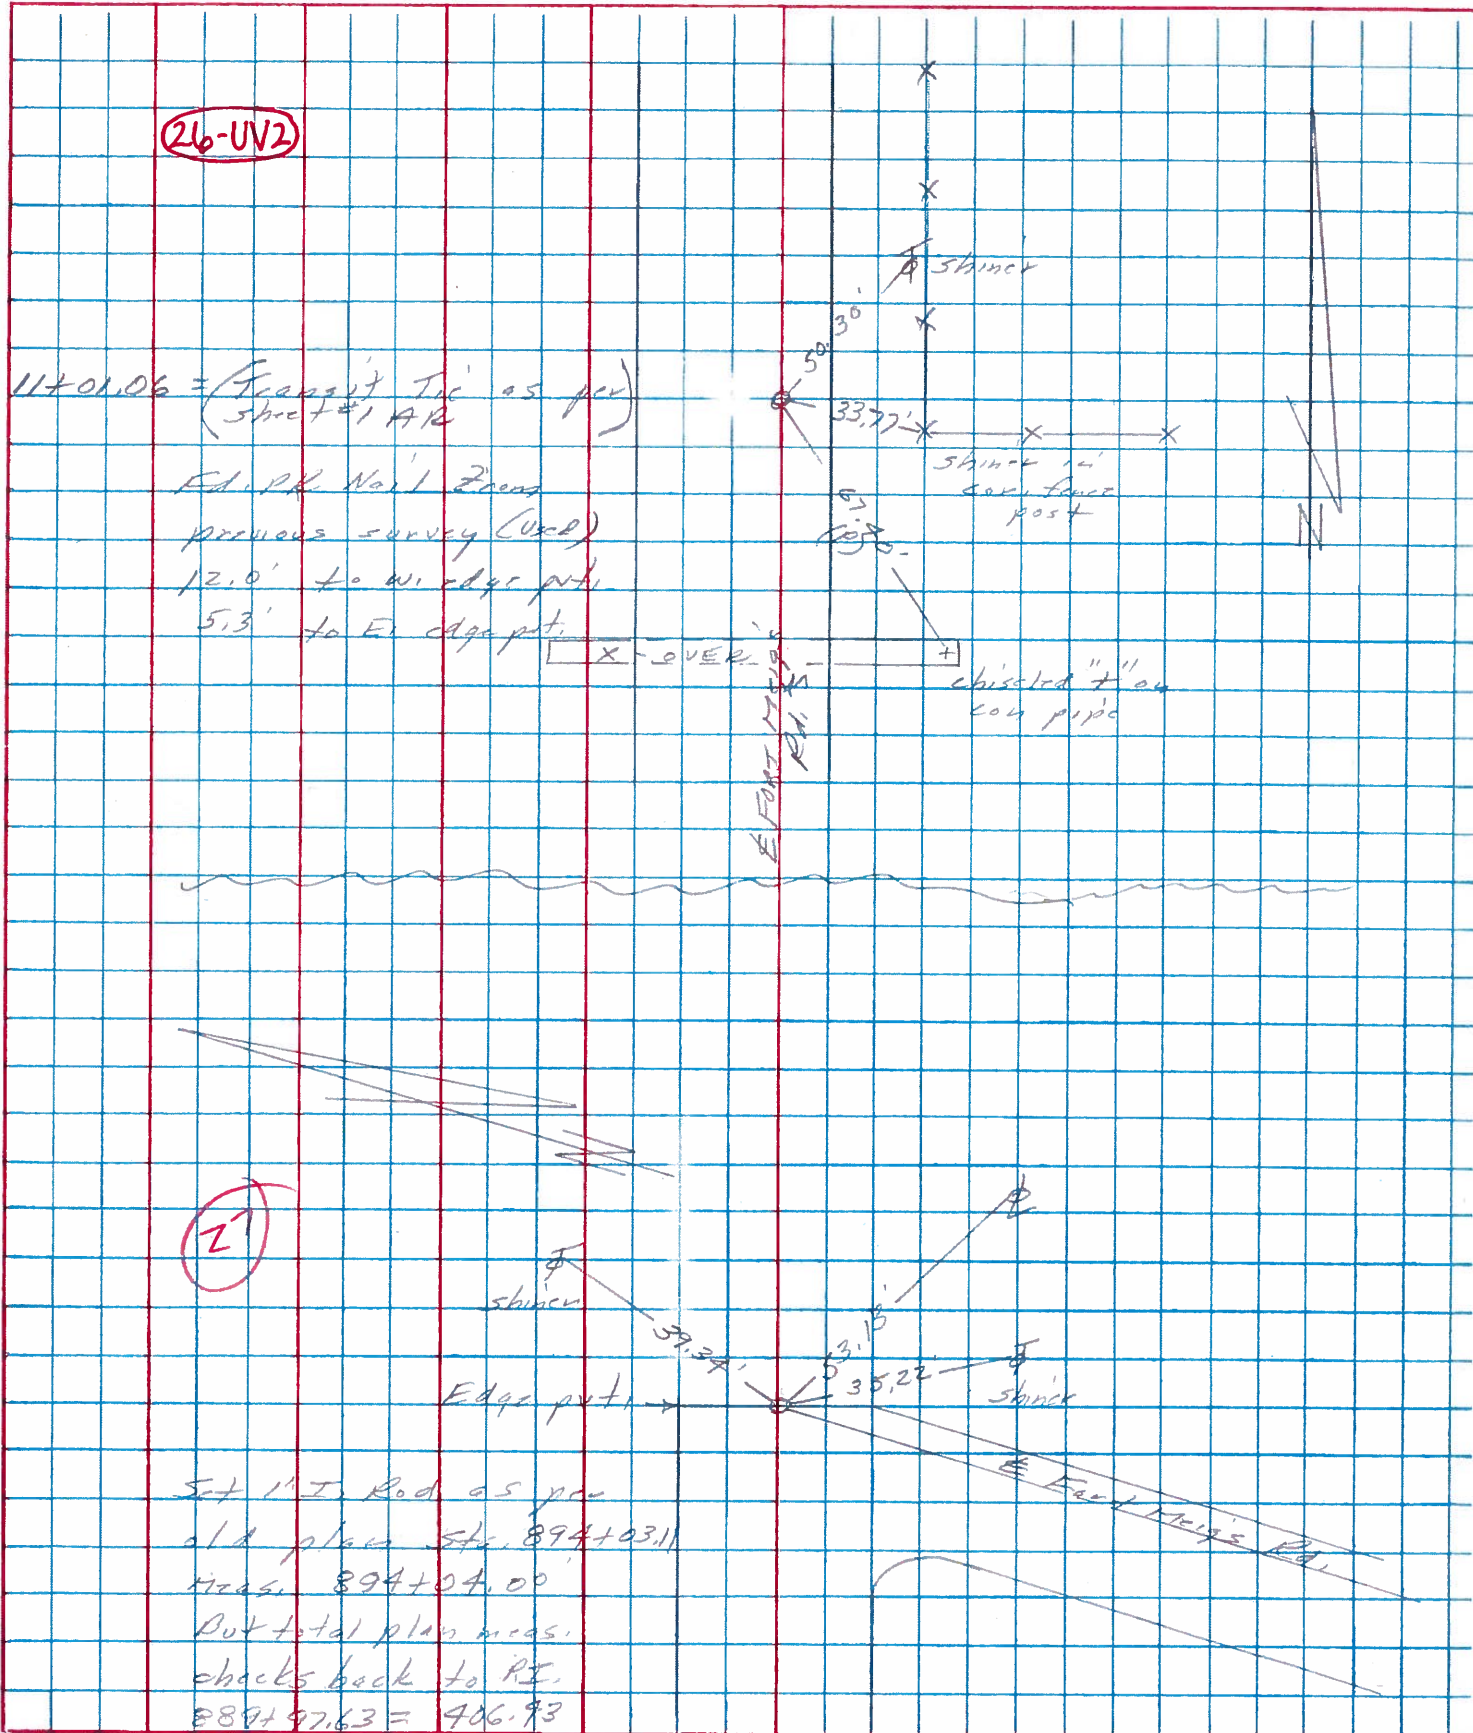

(26-UV2)

11+01.06 = (Transit Tie as per sheet #1 A12)

Ed. PK Nail 2' long
previous survey (used)
12.0' to W. edge pt.
5.3' to E. edge pt.

(27)

Set 1" I. Rod as per
old plan str. 894+03.11
meas. 894+04.00
But total plan meas.
checks back to PI.
889+97.63 = 906.93

PERSONNEL TITLE PERSONNEL TITLE

COUNTY Wood

DATE 26 Apr 1972

Steffe

S. R. 65

WEATHER Fair

Craw

SEC. 16.76

TEMP. 58°

DESCRIPTION


Alignment & References PERRYSBURG TWP

JOB NO.

LEFT

CENTER LINE

RIGHT


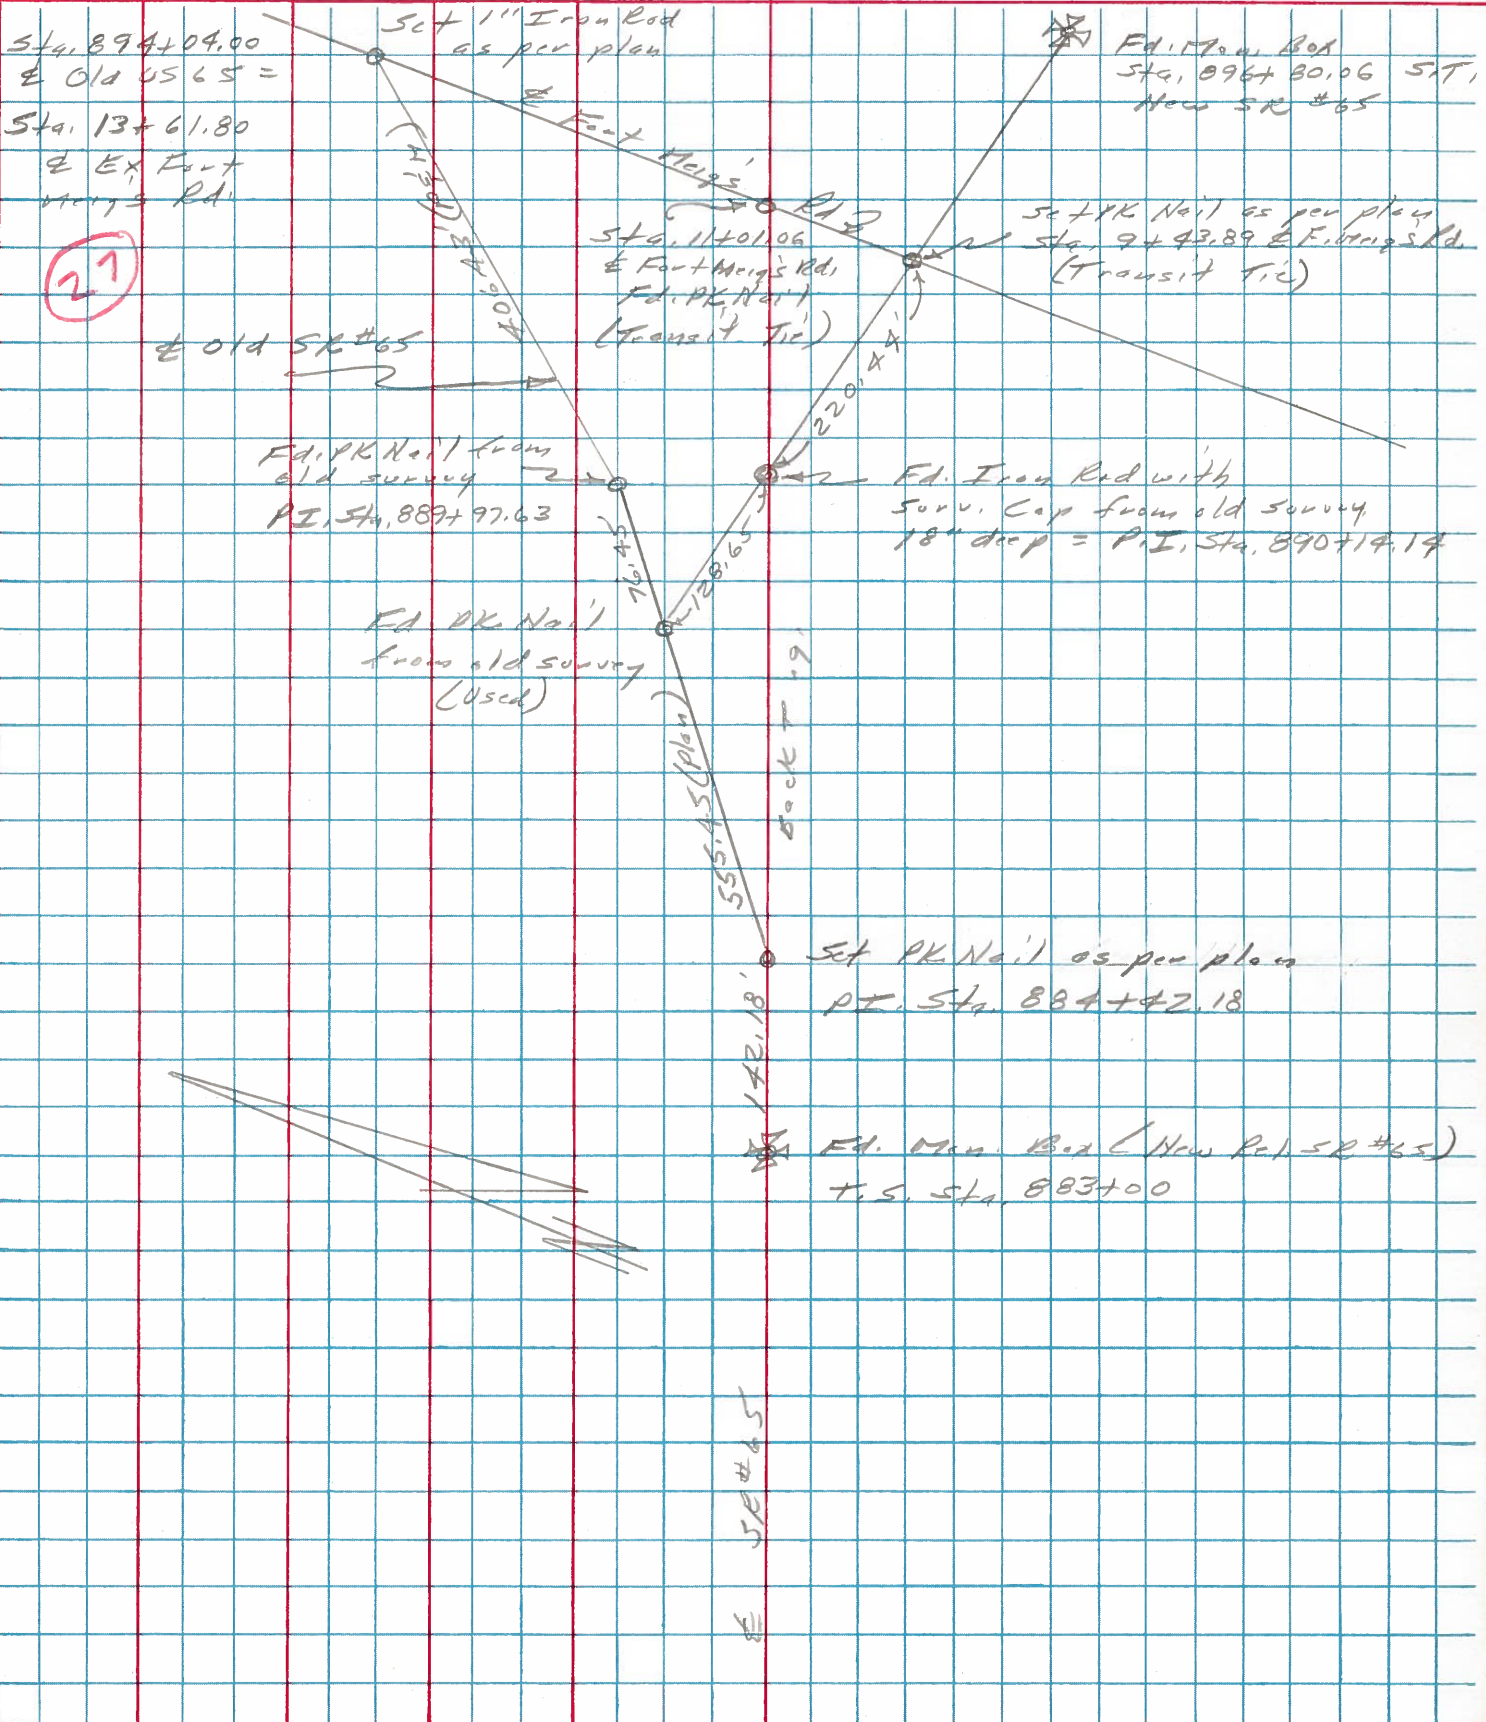


Q.D.O.T. DISTRICT 2 SURVEY OFFICE


Sht. 1 of 20
S.R. 65

County WOOD
 Township PERRYSBURG
 Section _____
 T N, R E
 Personnel BURNSIDE
BOWERS

Date 8-1-78
 Weather CLEAR
 Temp. +80

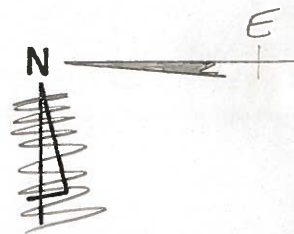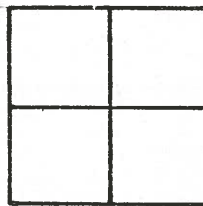

BEGIN POINT CHECK

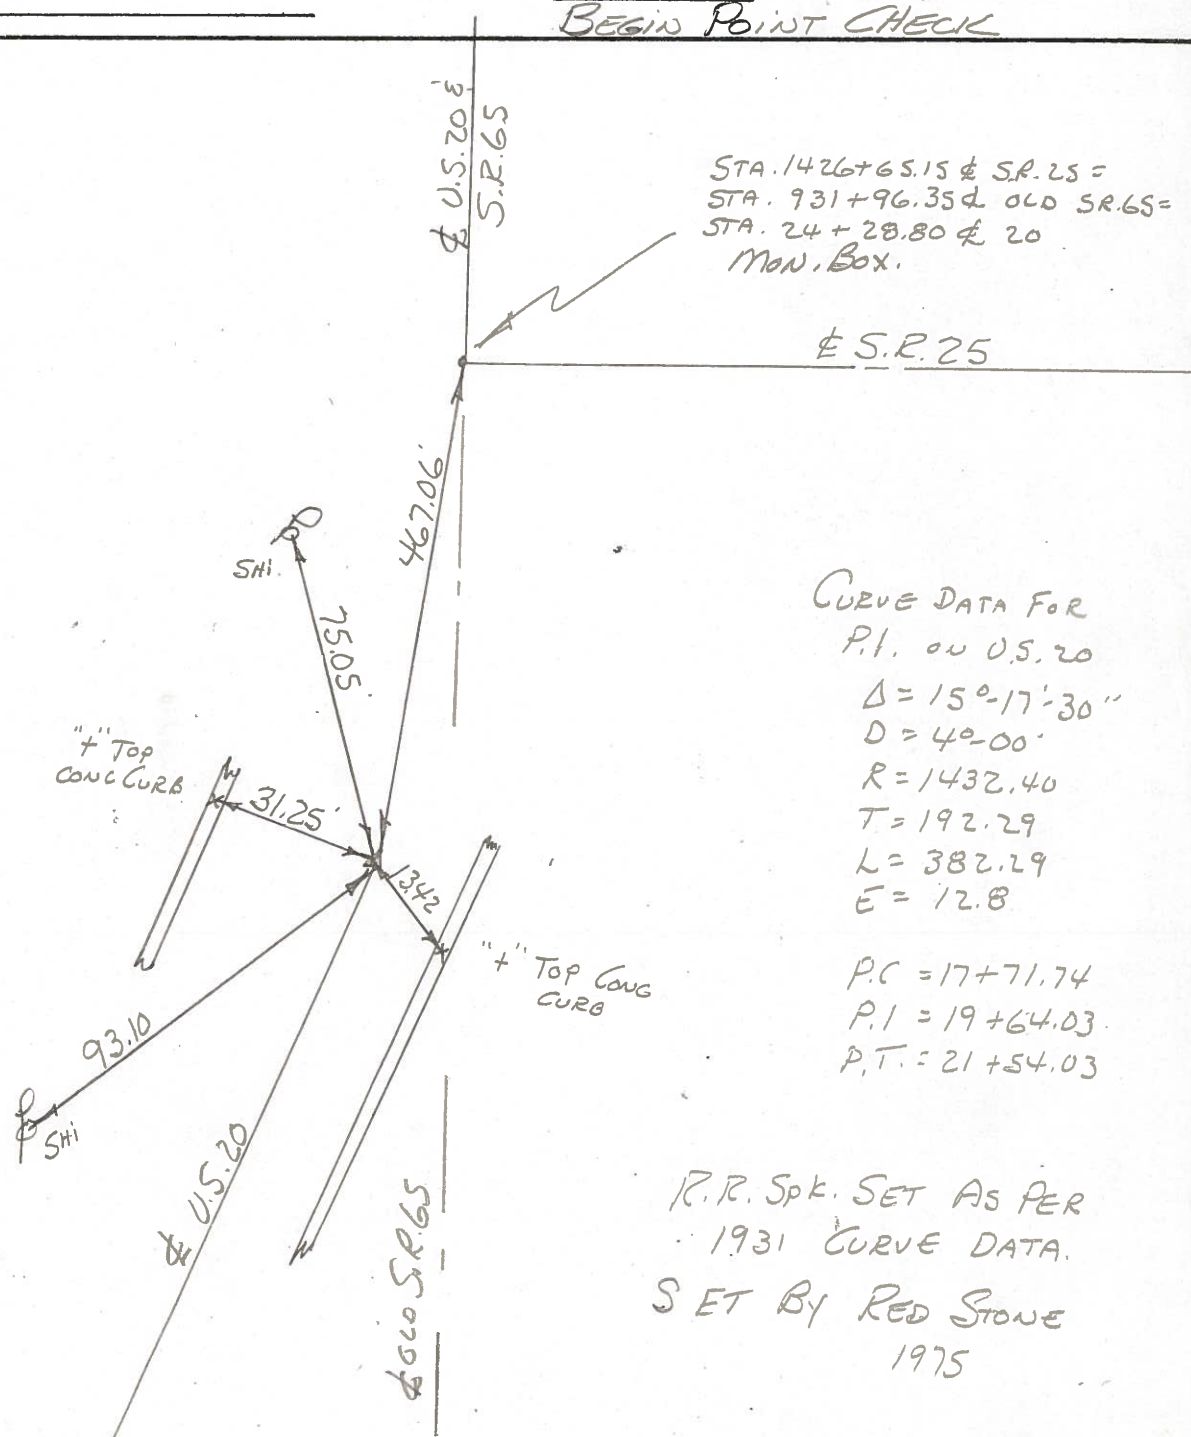

STA. 1426+65.15 & S.R. 25 =
 STA. 931+96.35 & OLD S.R. 65 =
 STA. 24+28.80 & 20
 MON. BOX.

CURVE DATA FOR
 P.I. ON U.S. 20
 $\Delta = 15^{\circ} 17' 30''$
 $D = 49-00'$
 $R = 1432.40$
 $T = 192.29$
 $L = 382.29$
 $E = 12.8$

P.C. = 17+71.74
 P.I. = 19+64.03
 P.T. = 21+54.03

P.R. Spk. SET AS PER
 1931 CURVE DATA.
 SET BY RED STONE
 1975