

O.D.O.T. DISTRICT 2 SURVEY OFFICE (USE ONLY)

PERSONNEL

REFERENCE NO. 29 C

SHEET 4 OF 9

NOTES LOEHRKE

DATE 6/4/85

ROUTE SR 65

H.C. BARNHISEL

WEATHER PT. CLOUDY

COUNTY WOOD

R.C. HOFFMAN

TEMP. 74°

TOWNSHIP PERRYSBURG

SECTION 12 MILE RESERVE

DWG BY NIESE PID _____

T 4 US

TYPE MONUMENT LG.R.R.SPIKE

~~ON SURFACE~~ - BELOW 1"


OFFSET \odot PAVEMENT 7.2' LT : ~~RT~~

TO EDGE PAVEMENT


STATION: 961+24

HORIZ.DATUM: _____ GEOID: _____

GRID: NORTHING: _____ EASTING: _____

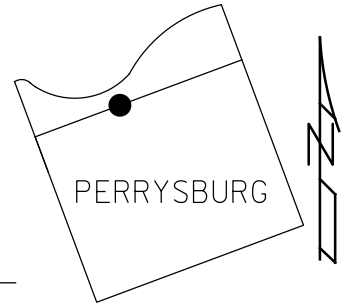

RECORD:
 US 20 SLM 53+74
 FD LG.R.R.SPIKE
 1" DOWN
 6/4/85, CL
 SET SM.R.R.SPIKE
 7/1/85, CL

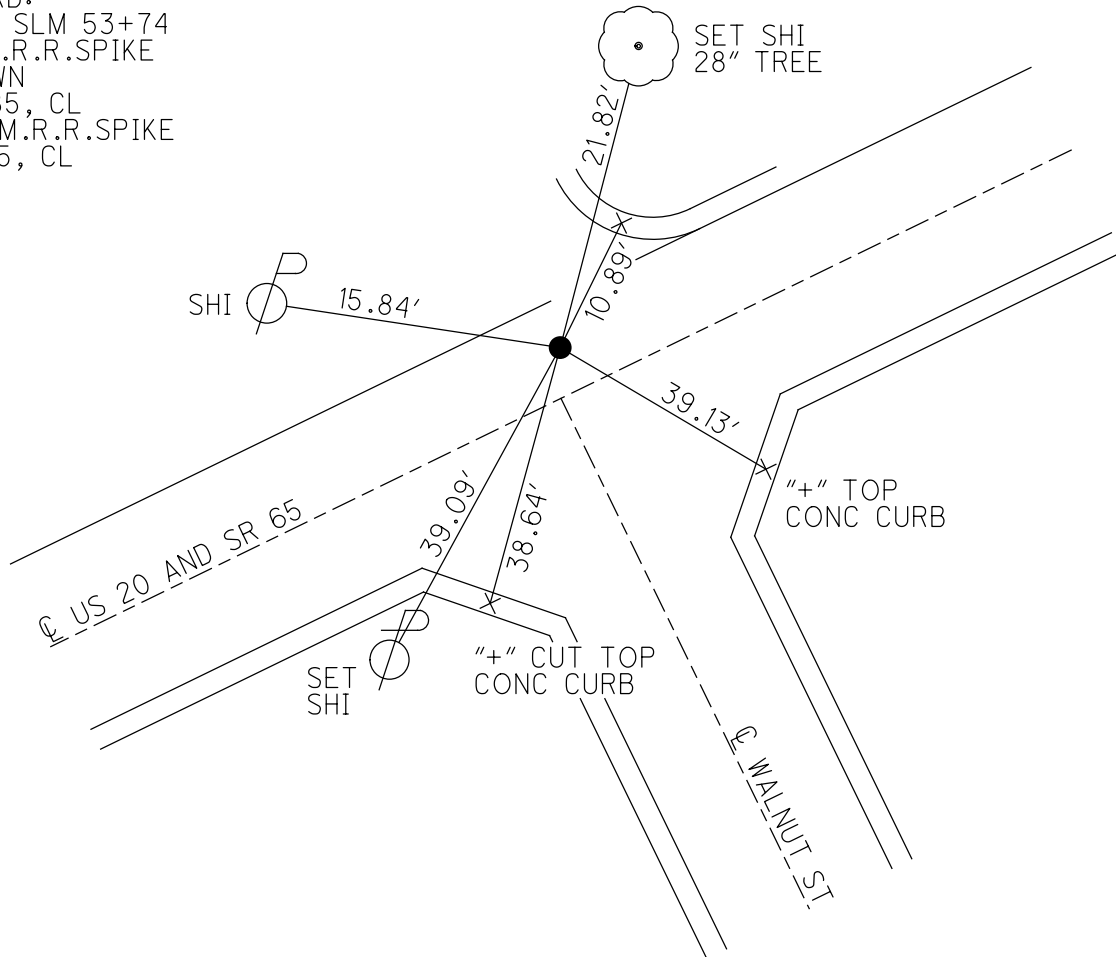

County WOOD S.R. 65 & US 20

Date 6-4-85

Township PERRYSBURG, CITY

Weather PE CLOUDY

Section _____


Temp. +74

T N, R E

Personnel LOEHRKE

HOFFMAN

BRUNHISEL

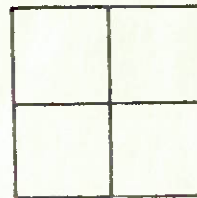

7.2 Lf & PART SR. 65
1' NE. & PART WALNUT ST.


65' to Lf F.P

SLM 53+74

SR U.S. 20

Fd: Lg R.R. Spike
1" Below SURFACE

Set Sm R.R Spike
7-1-85
C.L.

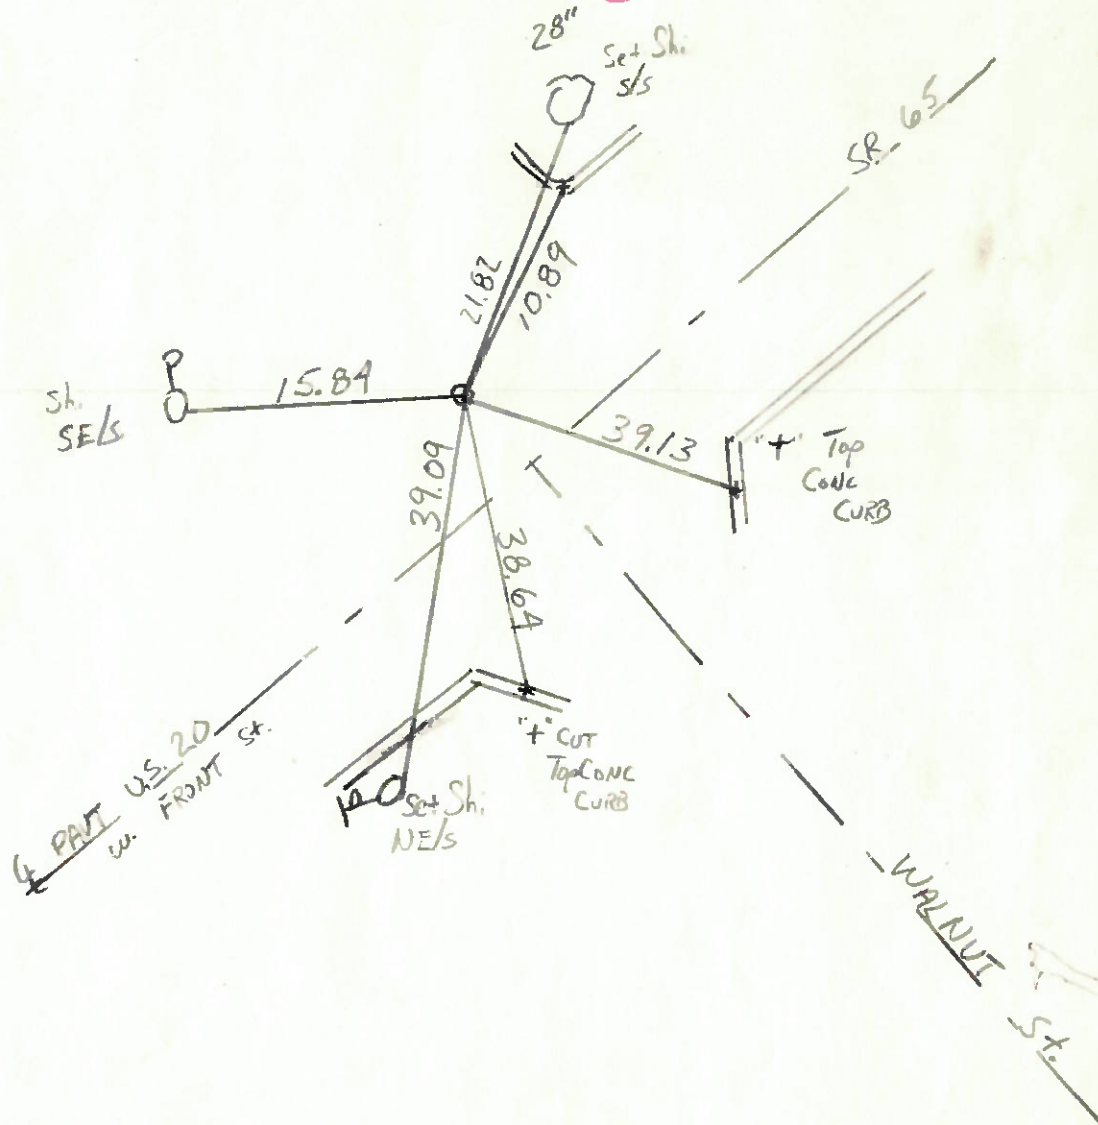

County WOOD

Date 7-31-78

Township PERRY/BURG




Weather PT. CLOUDY

Section _____

Temp. +72°

T N, R E


Personnel BURNSIDE
SMITH
BOWERS
KNAPE
MEAD

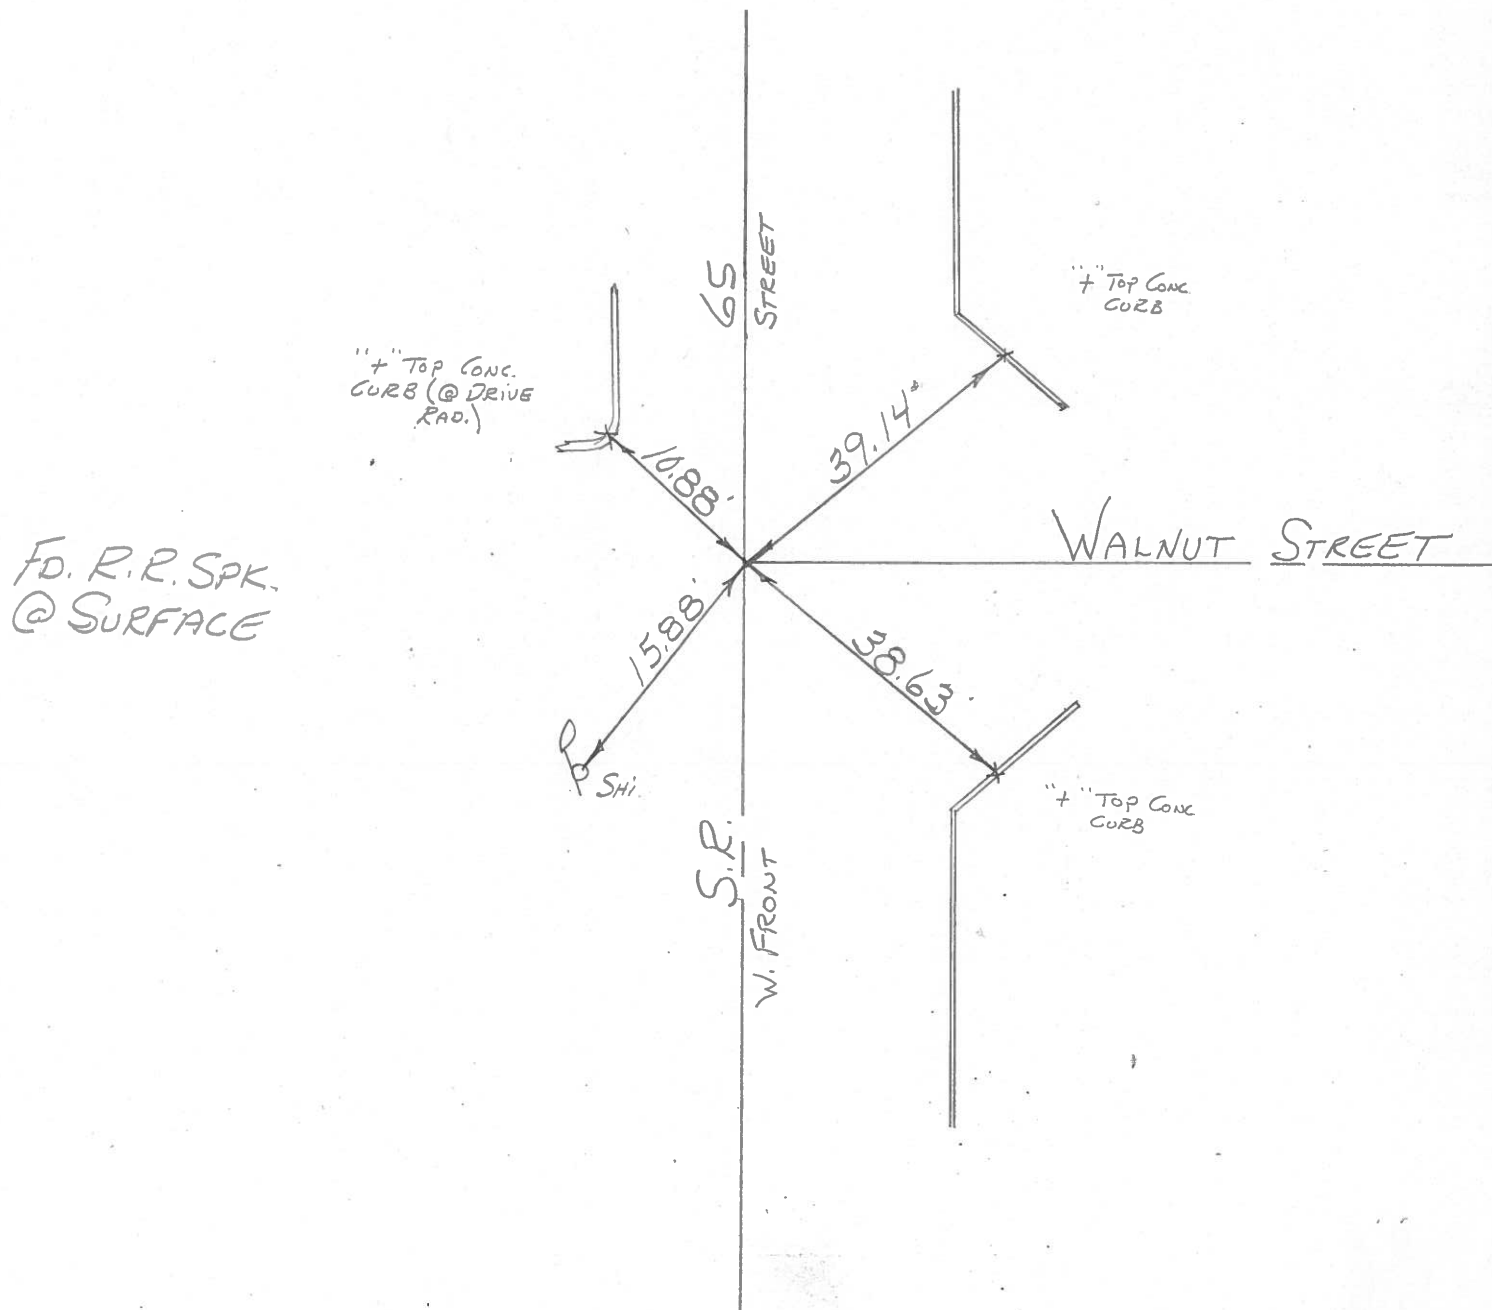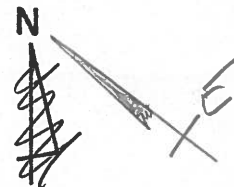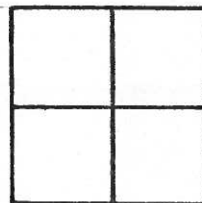

PERSONNEL TITLE PERSONNEL TITLE
SILVESTER _____
BURNSIDE _____
SMITH _____

COUNTY: Wood DATE _____
 S. R. 65 WEATHER _____
 SEC. _____ TEMP. _____

DESCRIPTION LEFT CENTER LINE RIGHT JOB NO.

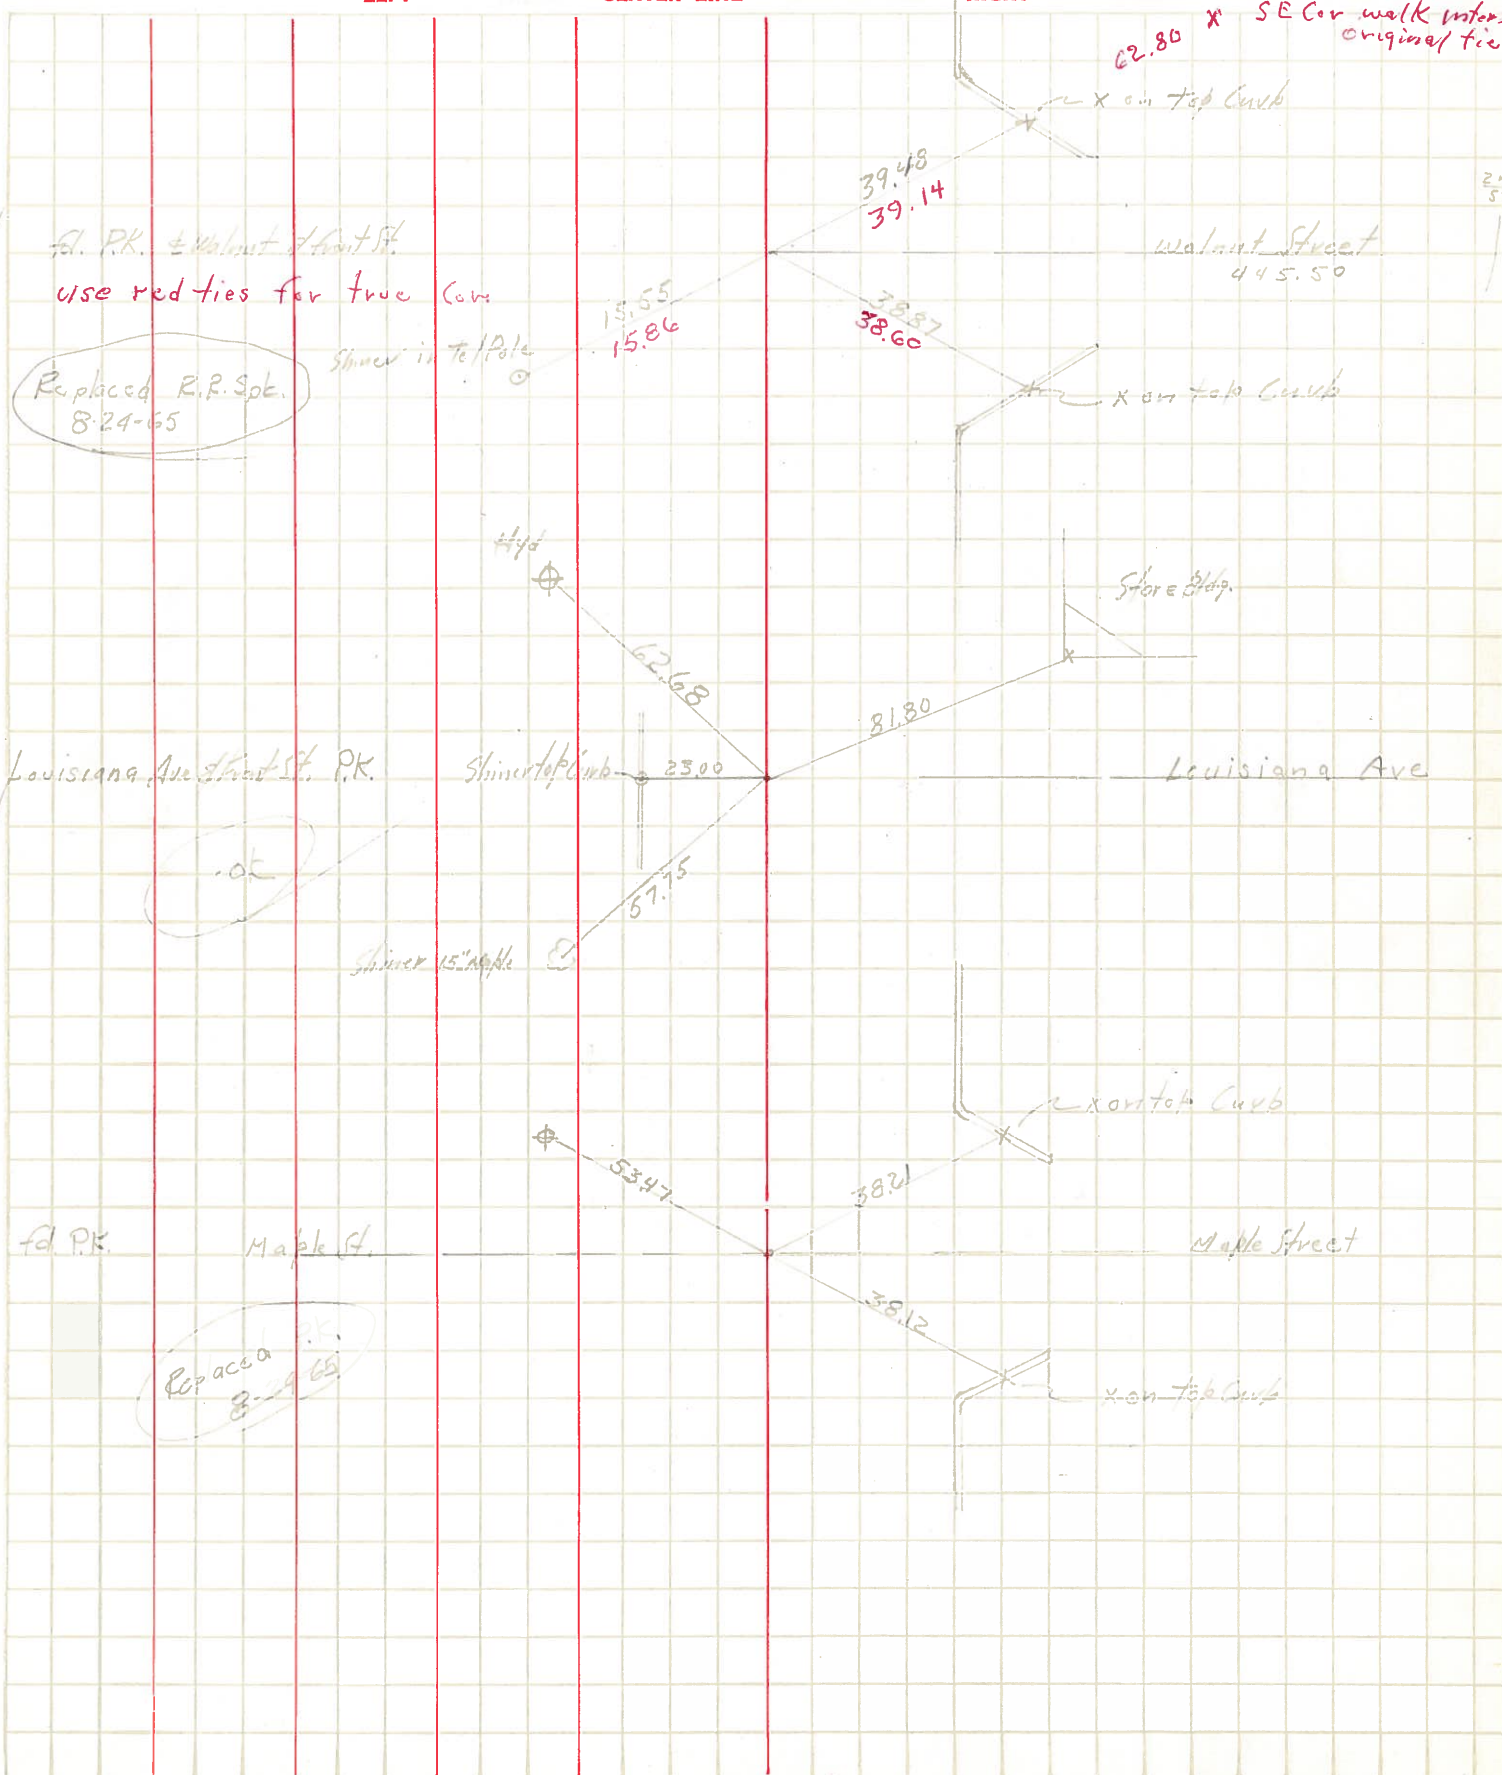

✓
 ✓

✓

Replaced R.P. Spk.
 8-24-65