

O.D.O.T. DISTRICT 2 SURVEY OFFICE (USE ONLY)

PERSONNEL

REFERENCE NO. 29 F

SHEET 7 OF 9

NOTES LOEHRKE

DATE 6/4/85

ROUTE SR 65

H.C. BARNHISEL

WEATHER CLOUDY

COUNTY WOOD

R.C. HOFFMAN

TEMP. 60°

TOWNSHIP PERRYSBURG

SECTION 12 MILE RESERVE

DWG BY NIESE PID \_\_\_\_\_

T 4 US

TYPE MONUMENT P.K. NAIL

~~ON SURFACE~~ - BELOW 1"

OFFSET CL PAVEMENT 8.5' LT : ~~RT~~

- TO - EDGE PAVEMENT


STATION: 980+90

HORZ. DATUM: \_\_\_\_\_


GEOID: \_\_\_\_\_

GRID: NORTHING: \_\_\_\_\_

EASTING: \_\_\_\_\_

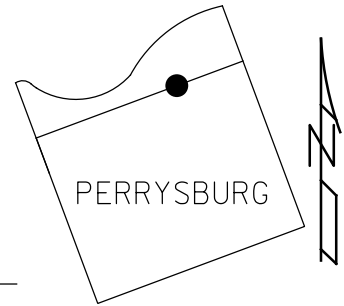

RECORD:  
FD P.K. NAIL  
1" DOWN  
6/4/85, CL  
SET SM.R.R. SPIKE  
7/1/85, CL

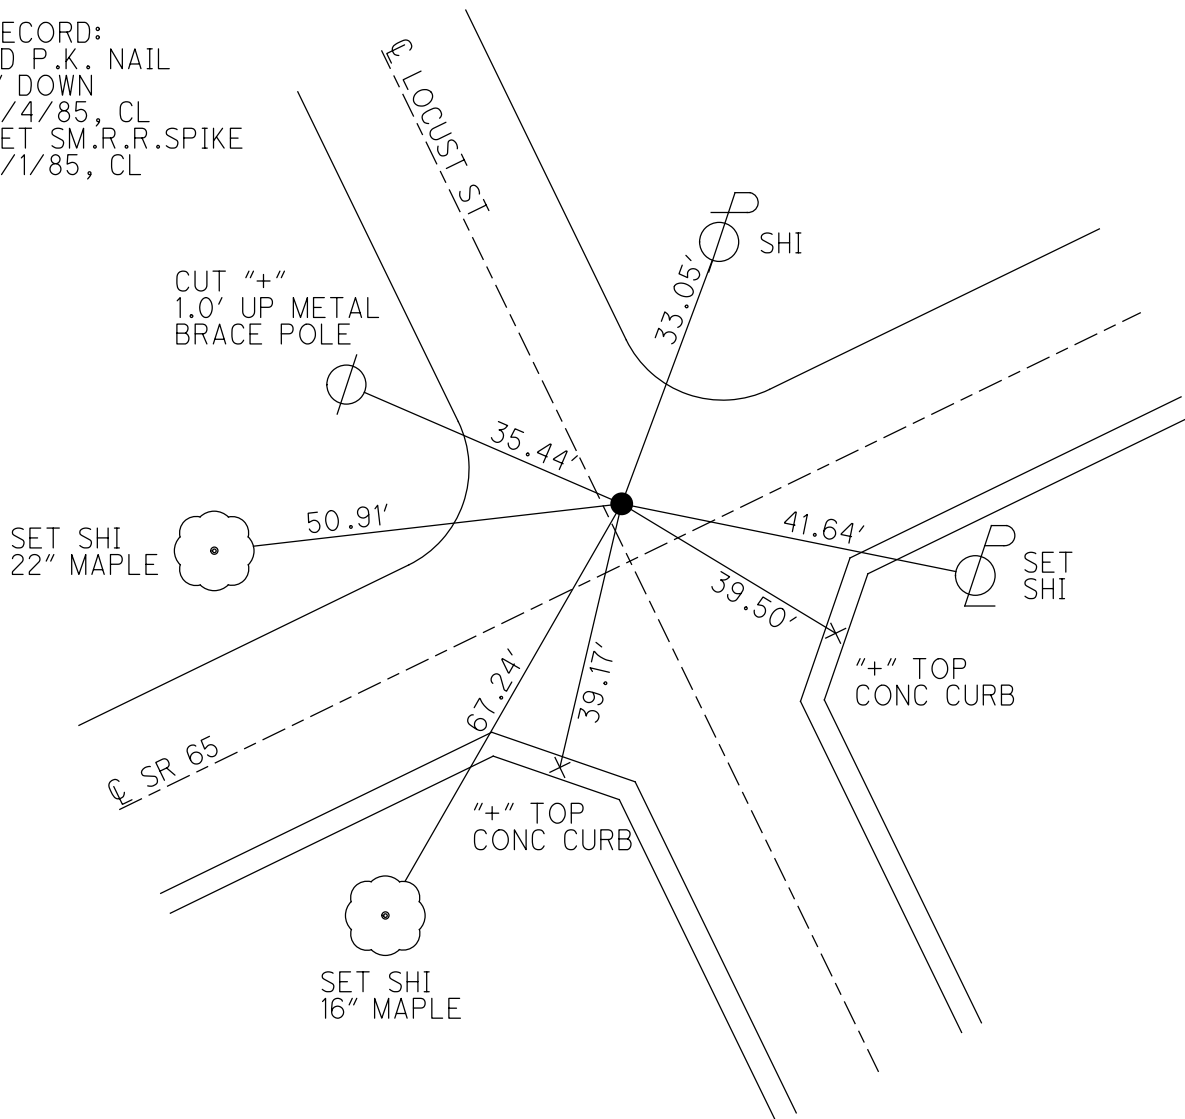

County WOOD S.R. 65

Township PERRYSBURG, CITY

Section \_\_\_\_\_

T N, R E

Personnel LOEHIRKE III

Hoffman RC

BARUNISER HC

Date 6-4-85

Weather CLOUDY


Temp. +60



8.5 Lt of Q PAVT SR 65  
1' NE of Q PAVT LOCUST ST N.

Fd: PK. NAIL  
1" BELOW SURFACE  
SLM = 980 + 90

Set Sm. R.R. Spike  
7-1-85  
C.L.

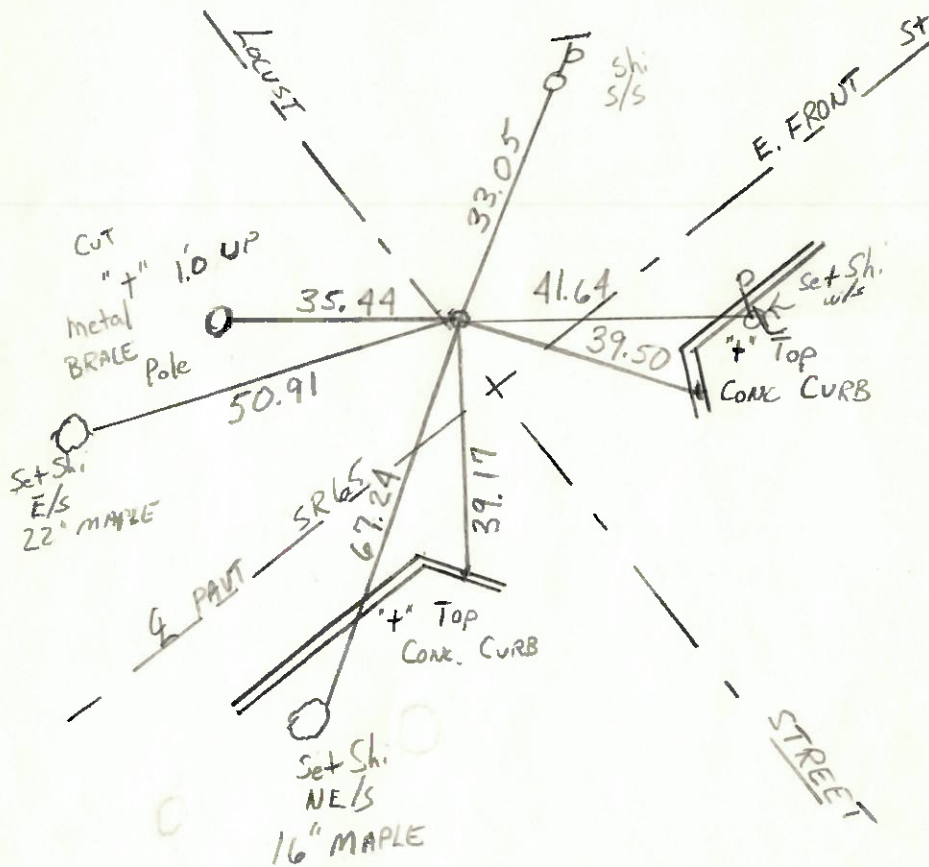

O.D.O.T. DISTRICT 2 SURVEY OFFICE

Sht. 1 of 20  
S.R. 65

County WOOD

Date 7-31-78

Township PERRYSBURG



Weather PT. CLOUDY

Section \_\_\_\_\_

Temp. + 73°

T N, R E

Personnel BURNSIDE

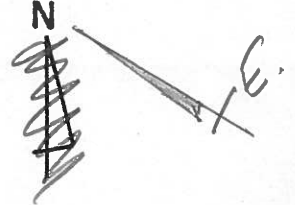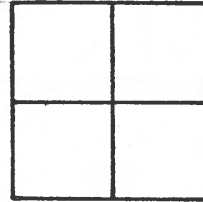

SMITH

BOWERS

KNAPE

MEAD

FD. SMALL P. K. NAIL  
@ SURFACE  
(ORIGIN UNKNOWN)

