

O.D.O.T. DISTRICT 2 SURVEY OFFICE (USE ONLY)

PERSONNEL

REFERENCE NO. 29 G

SHEET 8 OF 9

NOTES LOEHRKE

DATE 6/4/85

ROUTE SR 65

H.C. BARNHEISEL

WEATHER CLOUDY

COUNTY WOOD

R.C. HOFFMAN

TEMP. 64°

TOWNSHIP PERRYSBURG

DWG BY NIESE PID _____

SECTION 12 MILE RESERVE
T 4 US

TYPE MONUMENT LG.R.R.SPIKE

~~ON SURFACE~~ - BELOW 4"

OFFSET \odot PAVEMENT 7.7' LT : ~~RT~~

- TO - EDGE PAVEMENT


STATION: 987+35

HORIZ.DATUM: _____


GEOID: _____

GRID: NORTHING: _____

EASTING: _____

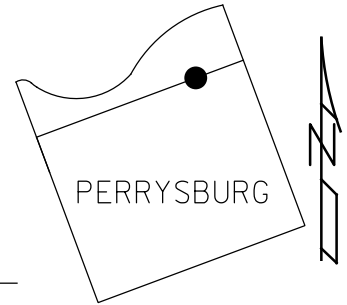

RECORD:
FD LG.R.R.SPIKE
4" DOWN
6/4/85, CL
SET SM.R.R.SPIKE
7/1/85, CL
SET SM.R.R.SPIKE
11/25/86, CL

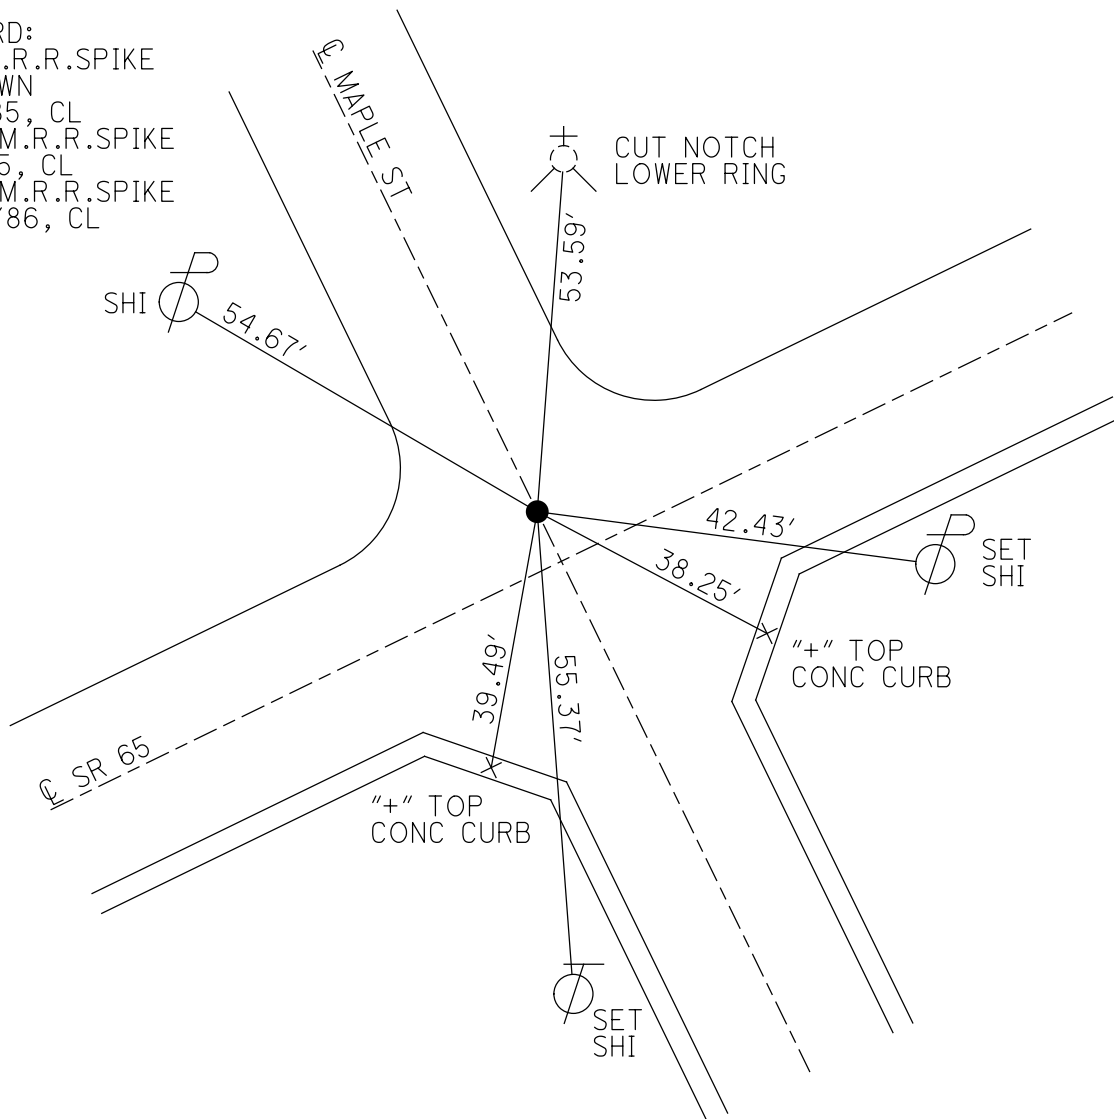

County WOOD S.R. 65

Township PERRYSBURG

Section _____

T N, R E

Personnel LOEHRYE □


Hoffman RC

BARVAISEL HC

Date 6-4-85

Weather CLOUDY

Temp. +64

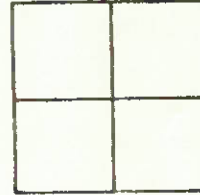


7.7' LF of Q PAVT SR, 65
ON Q PAVT MAPLE

Fd. L R.R Spike
4" Below

SLM 987+35

Set Sm. R.R Spike
7-1-85
C.L.

Re-set SMALL RR SOK
11-25-86 C.L.

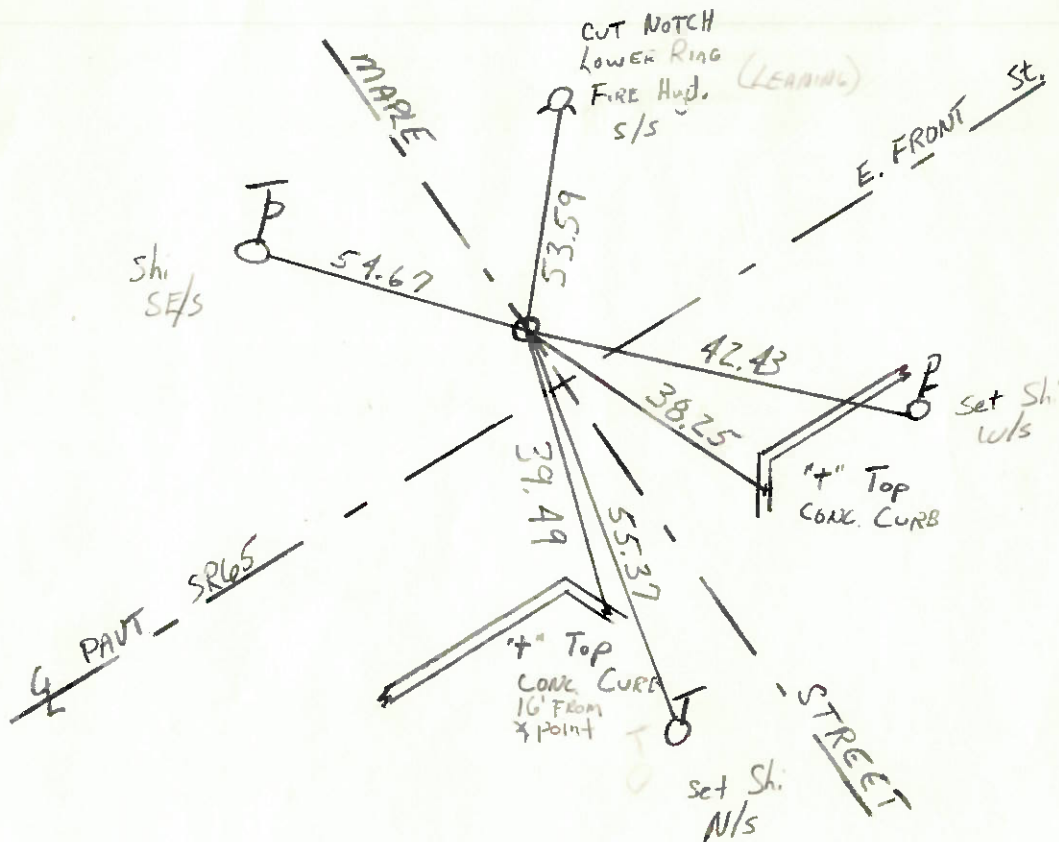

OD.O.T. DISTRICT 2 SURVEY OFFICE

Sht. 8 of 20
S.R. 65

County WOOD

Date 7-31-78

Township PERRYSBURG

Weather PT. CLOUDY

Section _____

Temp. +74°

T N, R E



Personnel BURNSIDE

SMITH


BOWERS

KNAPE

MEAD

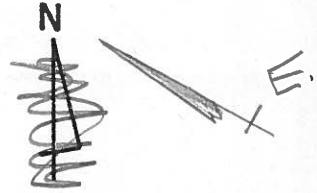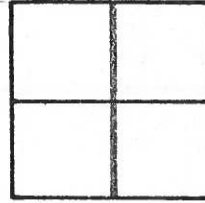

FD.R.R. SPK.
3" DEEP

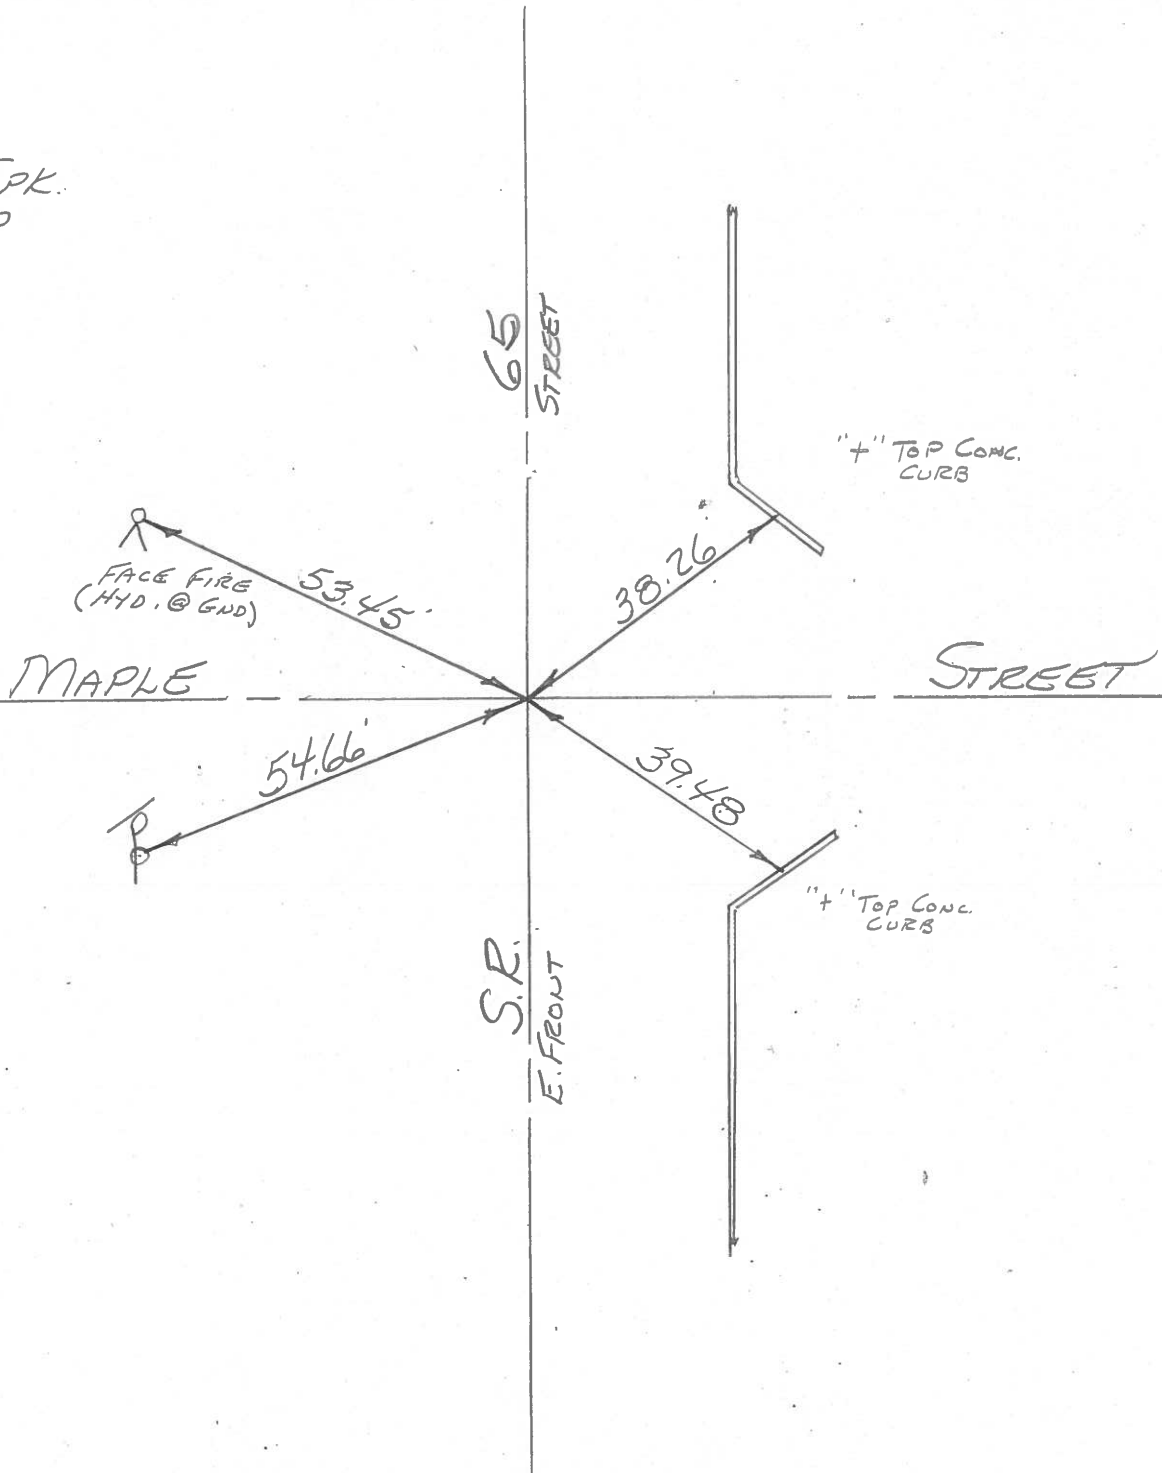

PERSONNEL	TITLE	PERSONNEL	TITLE	COUNTY	DATE
SILVESTER				Wood	
BURNSIDE				S. R. 65	WEATHER
SMITH				SEC.	TEMP.

DESCRIPTION LEFT CENTER LINE RIGHT JOB NO.

