



O.D.O.T. DISTRICT 2 SURVEY OFFICE (USE ONLY)

PERSONNEL	REFERENCE NO. <u>29 H</u>	SHEET <u>9</u> OF <u>9</u>
NOTES <u>LOEHRKE</u>	DATE <u>6/4/85</u>	ROUTE <u>SR 65</u>
H.C. <u>BARNHISEL</u>	WEATHER <u>CLOUDY</u>	COUNTY <u>WOOD</u>
R.C. <u>HOFFMAN</u>	TEMP. <u>64°</u>	TOWNSHIP <u>PERRYSBURG</u>
DWG BY <u>NIESE</u>	PID _____	SECTION <u>12 MILE RESERVE</u>
		T <u>4 US</u>
TYPE MONUMENT <u>LARGE IRON BOLT</u>		
ON SURFACE - BELOW <u>6"</u>		
OFFSET \odot PAVEMENT <u>8.6'</u> LT : RT		
<u>-</u> TO <u>-</u> EDGE PAVEMENT		
STATION: <u>993+78</u>		
HORIZ.DATUM: _____		GEOID: _____
GRID: NORTHING: _____		EASTING: _____

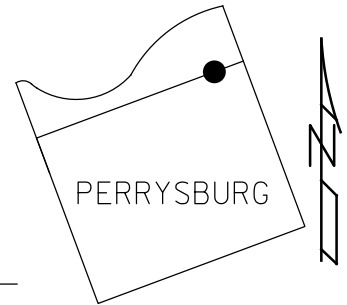

RECORD:
 FD LG. IRON BOLT
 6" DOWN
 6/4/85, CL
 SET SM.R.R.SPIKE
 7/1/85, CL
 SET SM.R.R.SPIKE
 11/25/86, CL

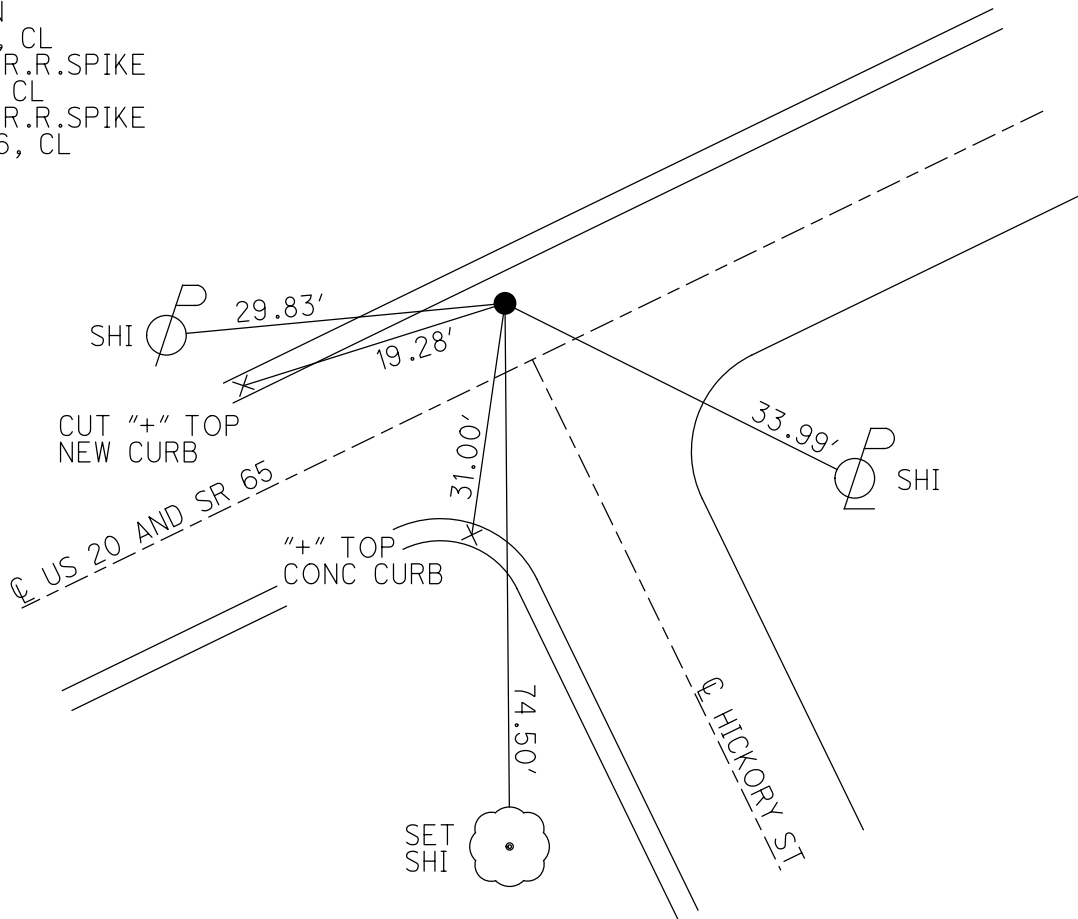

County WOOD S.R. 65

Township PERPYSBURG

Section _____

T N, R E

Personnel KOEHRE IT


Hoffman RC

BARNHISEL HC

Date 6-4-85

Weather CLOUDY

Temp. +64

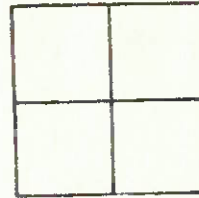

8.6 LF ♀ PAUT SR 65
ON ♀ PAUT HICKORY

Fd. Lg IRON Bolt
6" BELOW SURFACE

SLM 993+78

Set Sm R.R. Spike
7-1-85
C.L.

Re-set small R.R. SPL
11-25-86 C.L.

