



O.D.O.T. DISTRICT 2 SURVEY OFFICE (USE ONLY)

PERSONNEL _____ REFERENCE NO. 30 SHEET 1 OF 23
 NOTES HUSS DATE 9/13/05 ROUTE SR 65
 H.C. HOMAN WEATHER CLOUDY COUNTY WOOD
 R.C. MIKLOVIC TEMP. 72° TOWNSHIP PERRYSBURG
 DWG BY RHOADES PID _____ SECTION RT 68
 T 4 12 MILE RESERVE

TYPE MONUMENT MONBOX W/1" IPIN
 ON SURFACE - ~~BELOW~~ ON _____
 OFFSET \varnothing PAVEMENT 7.3' LT : ~~RT~~
 _____ TO _____ EDGE PAVEMENT
 STATION: 1003+60
 HORZ.DATUM: _____ GEOID: _____
 GRID: NORTHING: _____ EASTING: _____

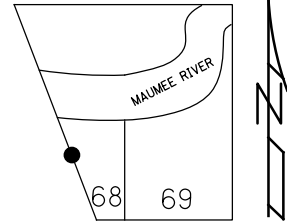

RECORD: P.I.
 STA. 0+00
 1937 PLANFD R.R.SPIKE
 FD P.K.NAIL
 5/22/72, BURNSIDE
 FD MONBOX
 W/1" IPIN
 6/4/85, CL
 9/13/05, DCH

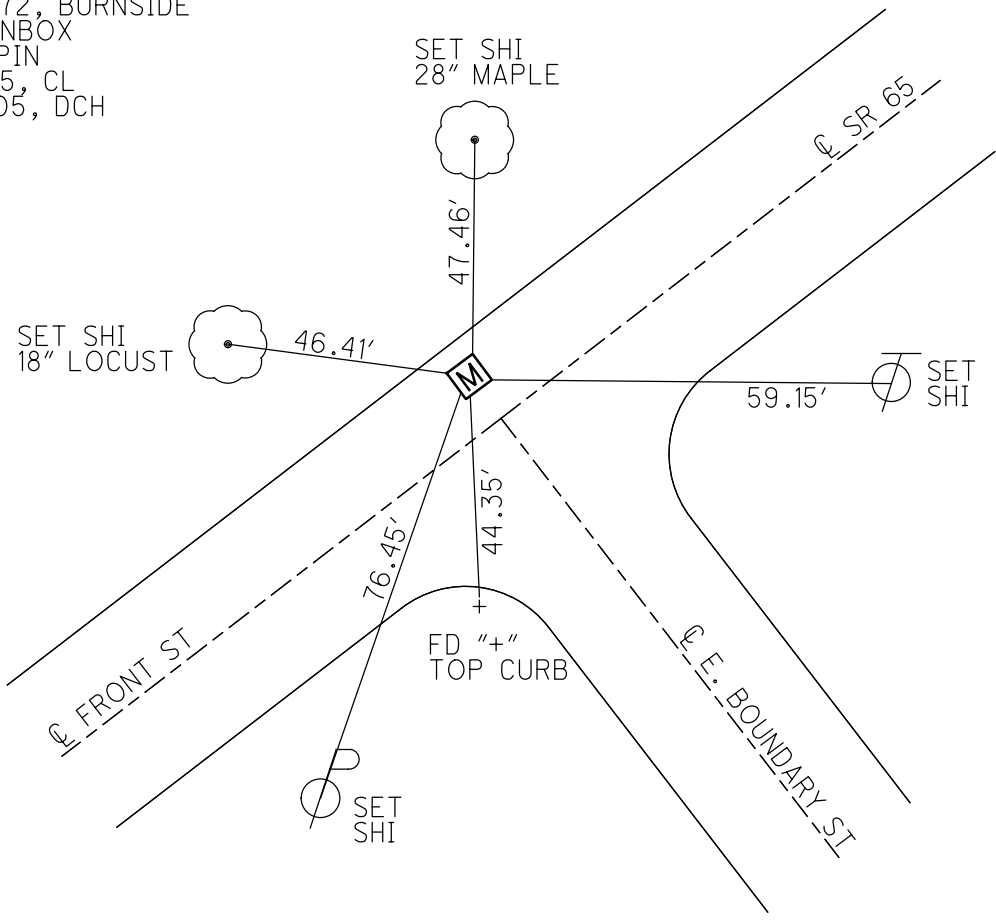

O.D.O.T. DISTRICT 2 SURVEY OFFICE

PERSONNEL

REFERENCE NO. 30

SHEET 1 OF 14

NOTES HUSS

DATE 9-13-05

ROUTE S.R. 65

H.C. HOMAN

WEATHER CLOUDY

COUNTY WOOD

R.C. MIKLOVIC

TEMP. 72°

TOWNSHIP Perryburg

SECTION _____

T N R E
 TOWN 4, 12 mile Res



TYPE MONUMENT _____ MON BOX _____

ON SURFACE - ~~BELOW~~ _____ ON _____

LEFT - ~~Q PAVT~~ - ~~RIGHT~~ _____ 7.3' LT. _____

_____ TO _____ EDGE PAVEMENT

S.L.M. 1003 +60

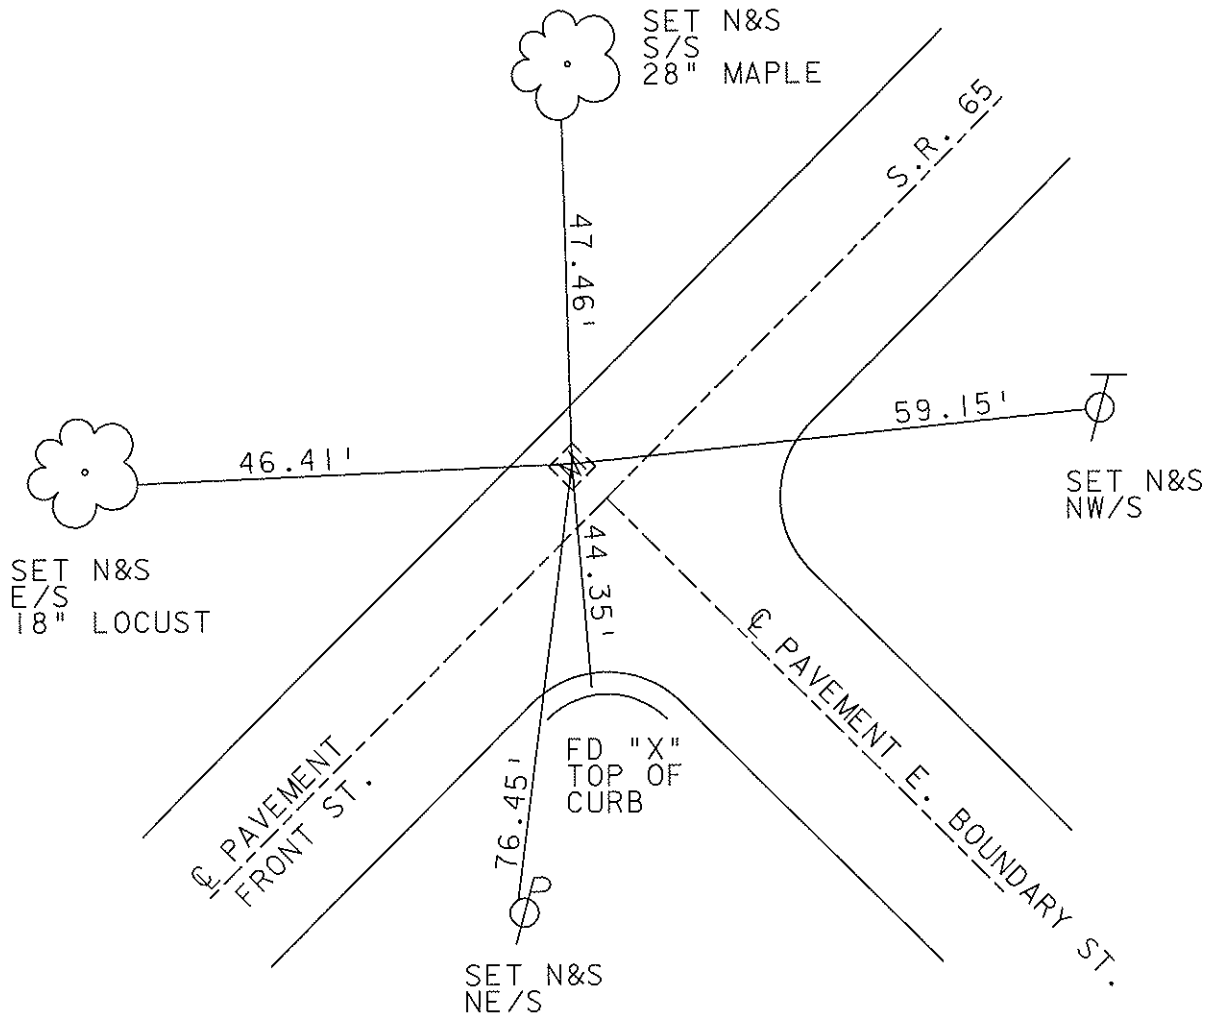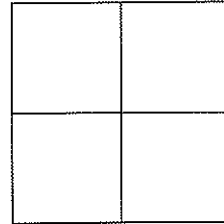

County WOOD S.R. 65

Township PERRYSBURG, CITY

Section _____

T N, R E

Personnel LOEHRKE

Hoffman RC


BARNHISEL HC

Date 6-4-85

Weather CLOUDY

Temp. +65

30

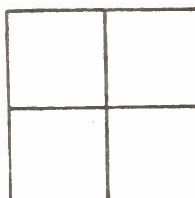


MON. BOX @ SURFACE " + " Top

7.3 LF OF 4 PAUT SR65

ON 4 PAUT E. BOUNDARY ST.

SLM 1003+60

Box RAISED TO SURFACE
As of 7-1-85
C.L.

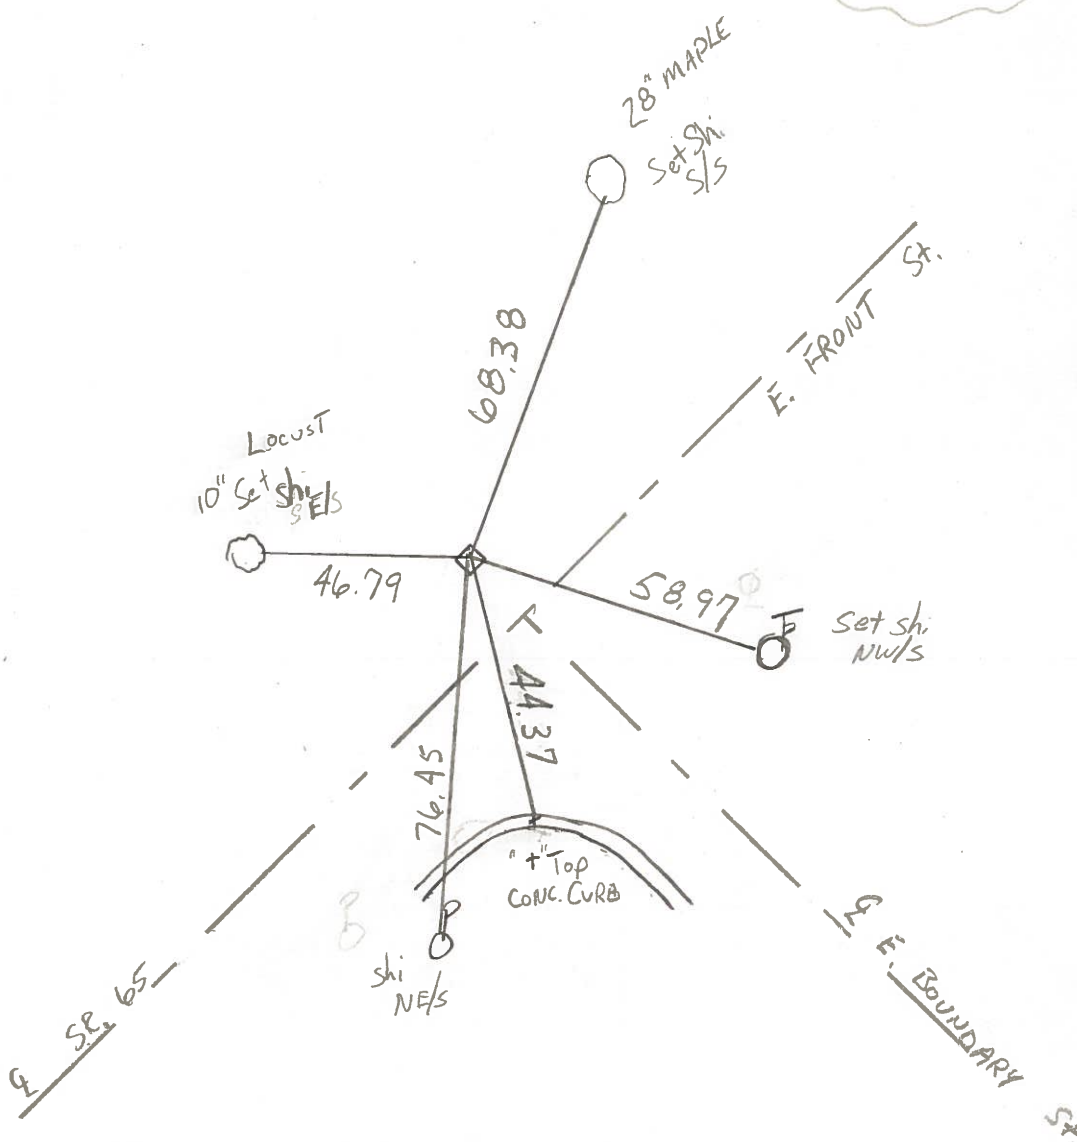

O.D.O.T. DISTRICT 2 SURVEY OFFICE

SHEET _____ OF _____

County Wood S.R. 65

Date 13 Nov. 80

Township _____

Weather Cloudy

Section Perrysburg

Temp. 40°

T_N, R_E


Personnel I. Stone

P. Neuser


R. Michalak

D. Curtis

H. Mead

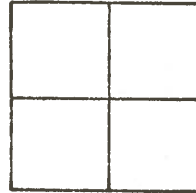

REF. NO. 30

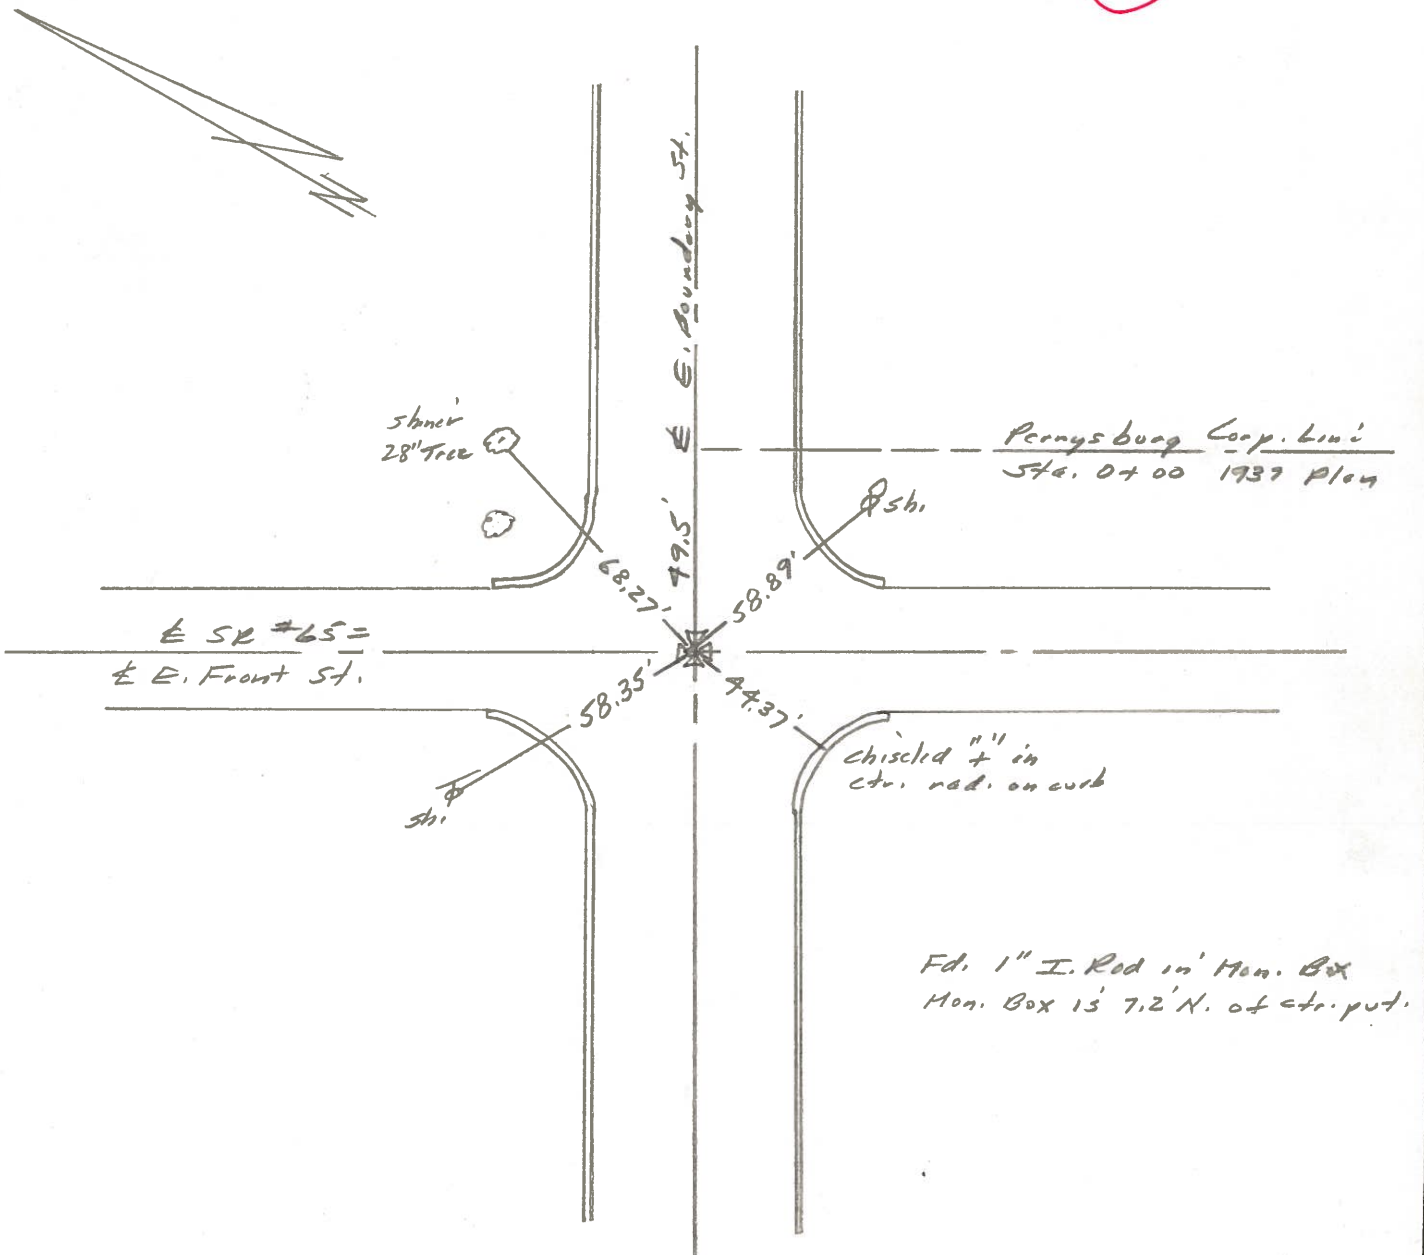

PERSONNEL	TITLE	PERSONNEL	TITLE
BURNSIDE			
SMITH			
BOWERS			

COUNTY Wood DATE 5-22-72
 S. R. 65 WEATHER CLEAR
 SEC. PERRYSBURG - EAST TEMP. +70°

DESCRIPTION _____ **PERRYSBURG TWP.** JOB NO. _____

