

O.D.O.T. DISTRICT 2 SURVEY OFFICE (USE ONLY)

PERSONNEL

REFERENCE NO. 30 C

SHEET 3 OF 8

NOTES HOFFMAN

DATE 4/4/85

ROUTE SR 65

H.C. BARNHISEL

WEATHER CLOUDY

COUNTY WOOD

R.C. LOEHRKE

TEMP. 50°

TOWNSHIP PERRYSBURG

DWG BY NIESE

PID -

SECTION RT 69

T 3 12 MILE RESERVE

TYPE MONUMENT SANDSTONE W/ DRILLH

ON SURFACE - ~~BELOW~~ ON

OFFSET \bar{C} PAVEMENT 41.00' ~~±~~ : RT

25.7' TO RT EDGE PAVEMENT


STATION: 1044+34

HORZ. DATUM: NAD83(2011)


GEOID: 2012A

GRID: NORTHING: 696064.792

EASTING: 1665602.426

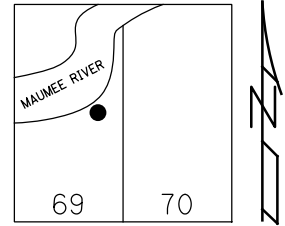

RECORD: P.I.
 1937 \bar{C} SURVEY
 STA. 40+25.7
 $\Delta = 26^\circ 22' \text{ LT}$
 $D = 3^\circ 00'$
 $T = 447.39'$
 $L = 878.88'$
 $E = 51.69'$
 $R = 1909.86'$
 $T = 298.32'$
 FD 3/4" IPIN
 5/22/72, BURNSIDE
 FD STONE
 SET DRILLH
 11/13/80, IRS
 FD IPID
 W/ 1 1/2" CAP
 3 1/2" DOWN
 REFC30
 12/16/19, JFO

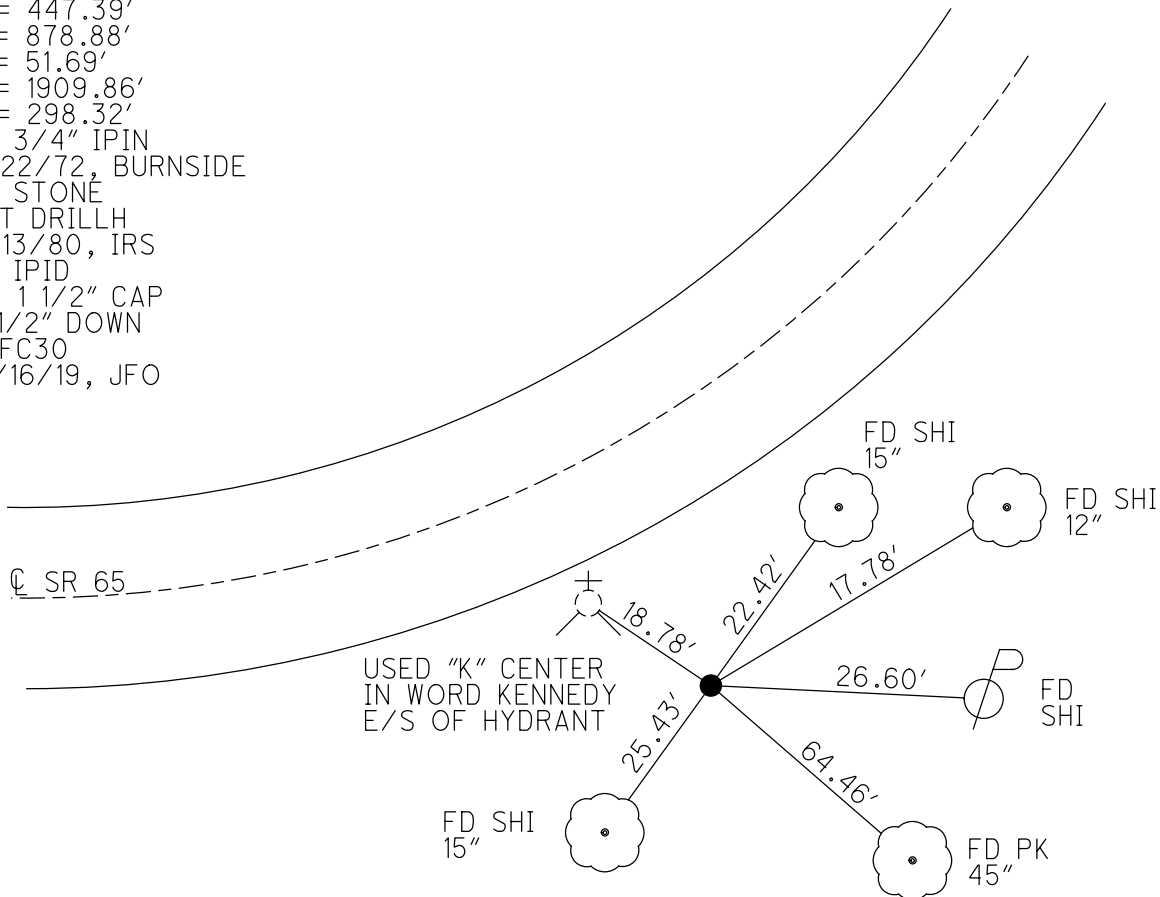

O.D.O.T. DISTRICT 2 SURVEY OFFICE

PERSONNEL

REFERENCE NO. 30-C SHEET 5 OF 14



NOTES _____
 H.C. HOFFMAN
 R.C. BARNHISEL

DATE 4-4-85
 WEATHER CLOUDY
 TEMP. 50°

ROUTE SR 65
 COUNTY WOOD
 TOWNSHIP PERRYSBURG
 SECTION RIVER TRACT


~~T 7 N~~ ~~R 11 E~~
 Town 3, 12 mile Loc.

TYPE MONUMENT SANDSTONE W/ DRILL HOLE
 ON SURFACE - ~~BELOW~~ _____ ON _____
~~LEFT~~ ~~Q PAVT~~ - RIGHT 41' RT
25.7' TO RT EDGE PAVEMENT
 S.L.M. 1044+34

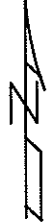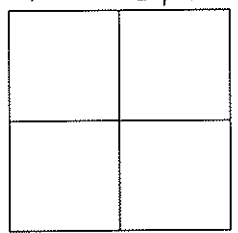

1937 C SURVEY STATION=
 P.I. 40+25.7
 DELTA=26°22' LT.

NOTE: OFF ROAD
 Did not locate
 ALL Recono Data

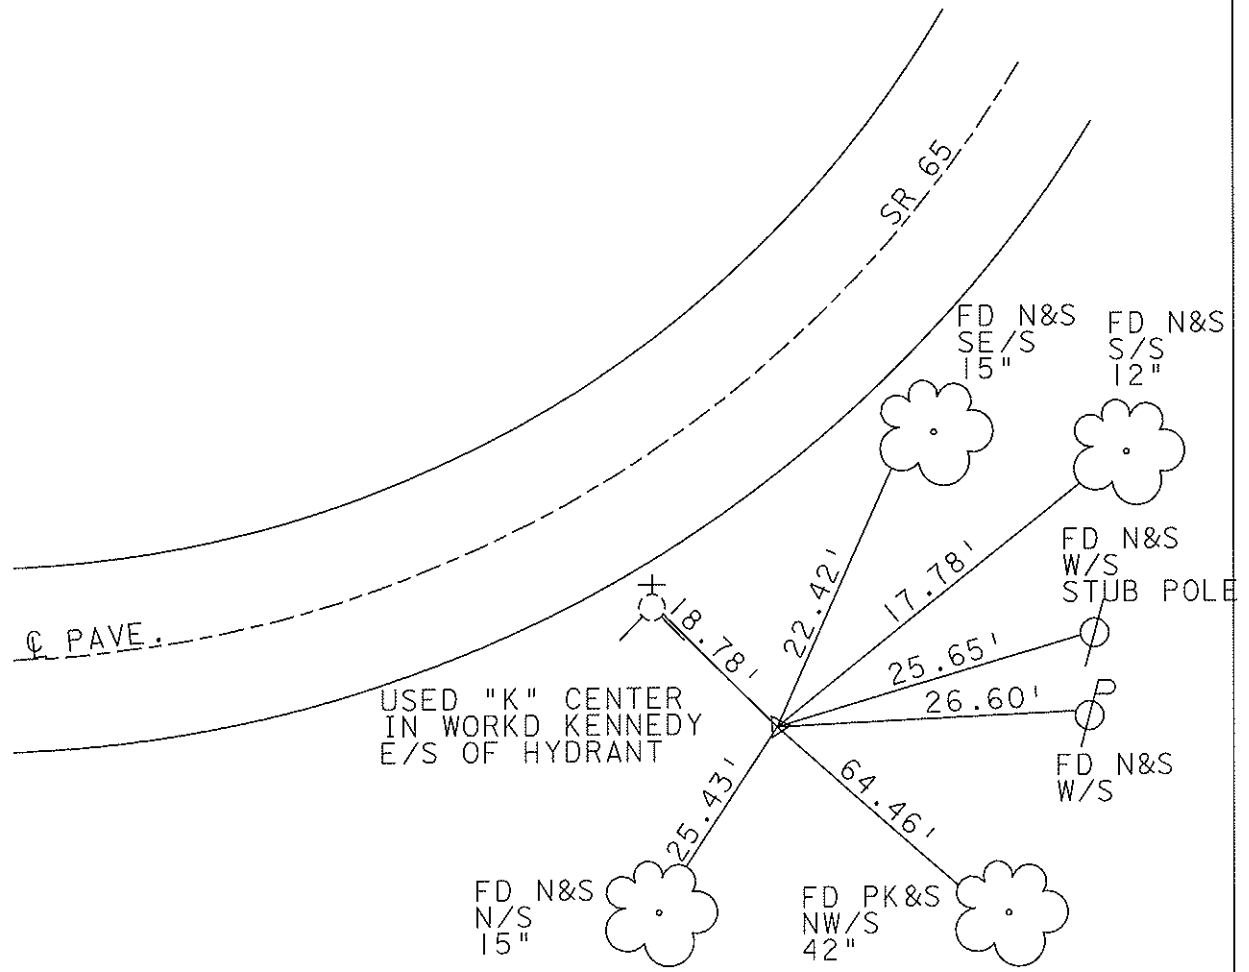

O.D.O.T. DISTRICT 2 SURVEY OFFICE

SHEET _____ OF _____

County Wood S.R. 65

Date 13 Nov. 1980

Township _____


Weather Cloudy

Section _____


Temp. 45°

T N, R E

Personnel I. Stone
P. Neuser
R. Michalak
D. Curtis
H. Mead

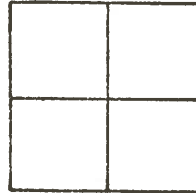

REF. No. 30C

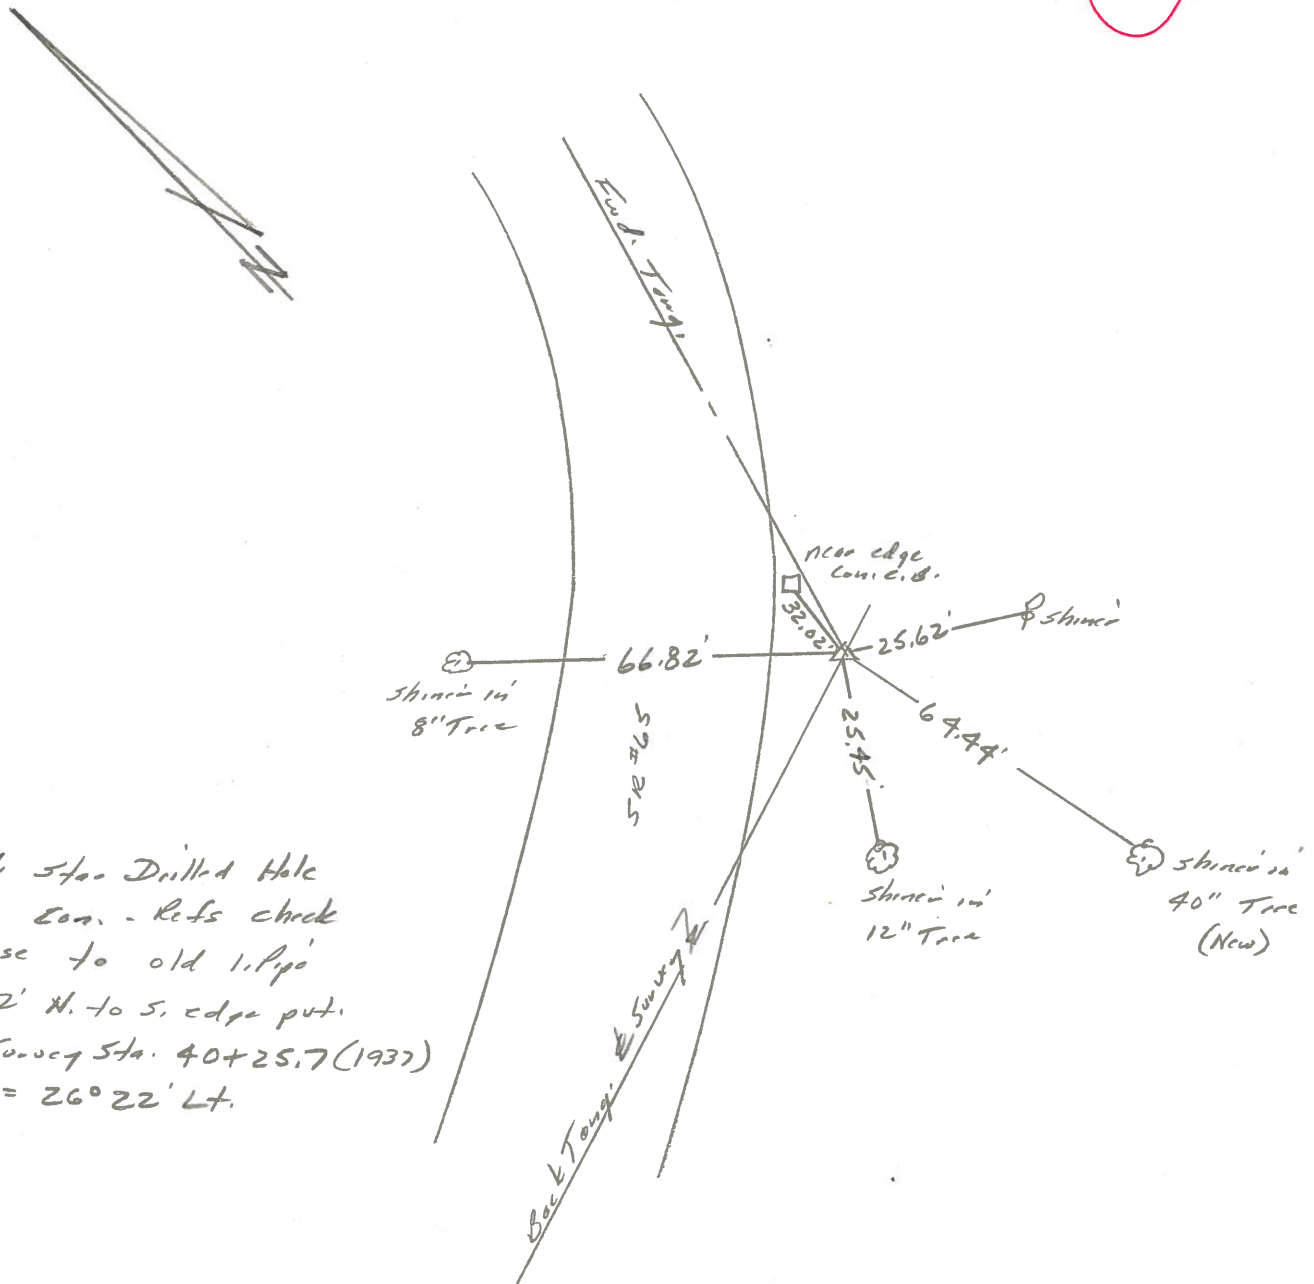


Fd. Sta. Drilled Hole
 10' Eon. - Refs check
 close to old 1. Pipe
 26.2' N. to S. edge put.
 E Survey Sta. 40+25.7 (1937)
 $\Delta = 26^{\circ} 22' Lt.$

PERSONNEL TITLE PERSONNEL TITLE
BURNSIDE _____
SMITH _____
BOWERS _____

COUNTY WOOD DATE 5-22-72
 S. R. 65 WEATHER CLEAR
 SEC. C (PT) TEMP. +80°

DESCRIPTION _____ PERYSBURG TWP JOB NO. _____

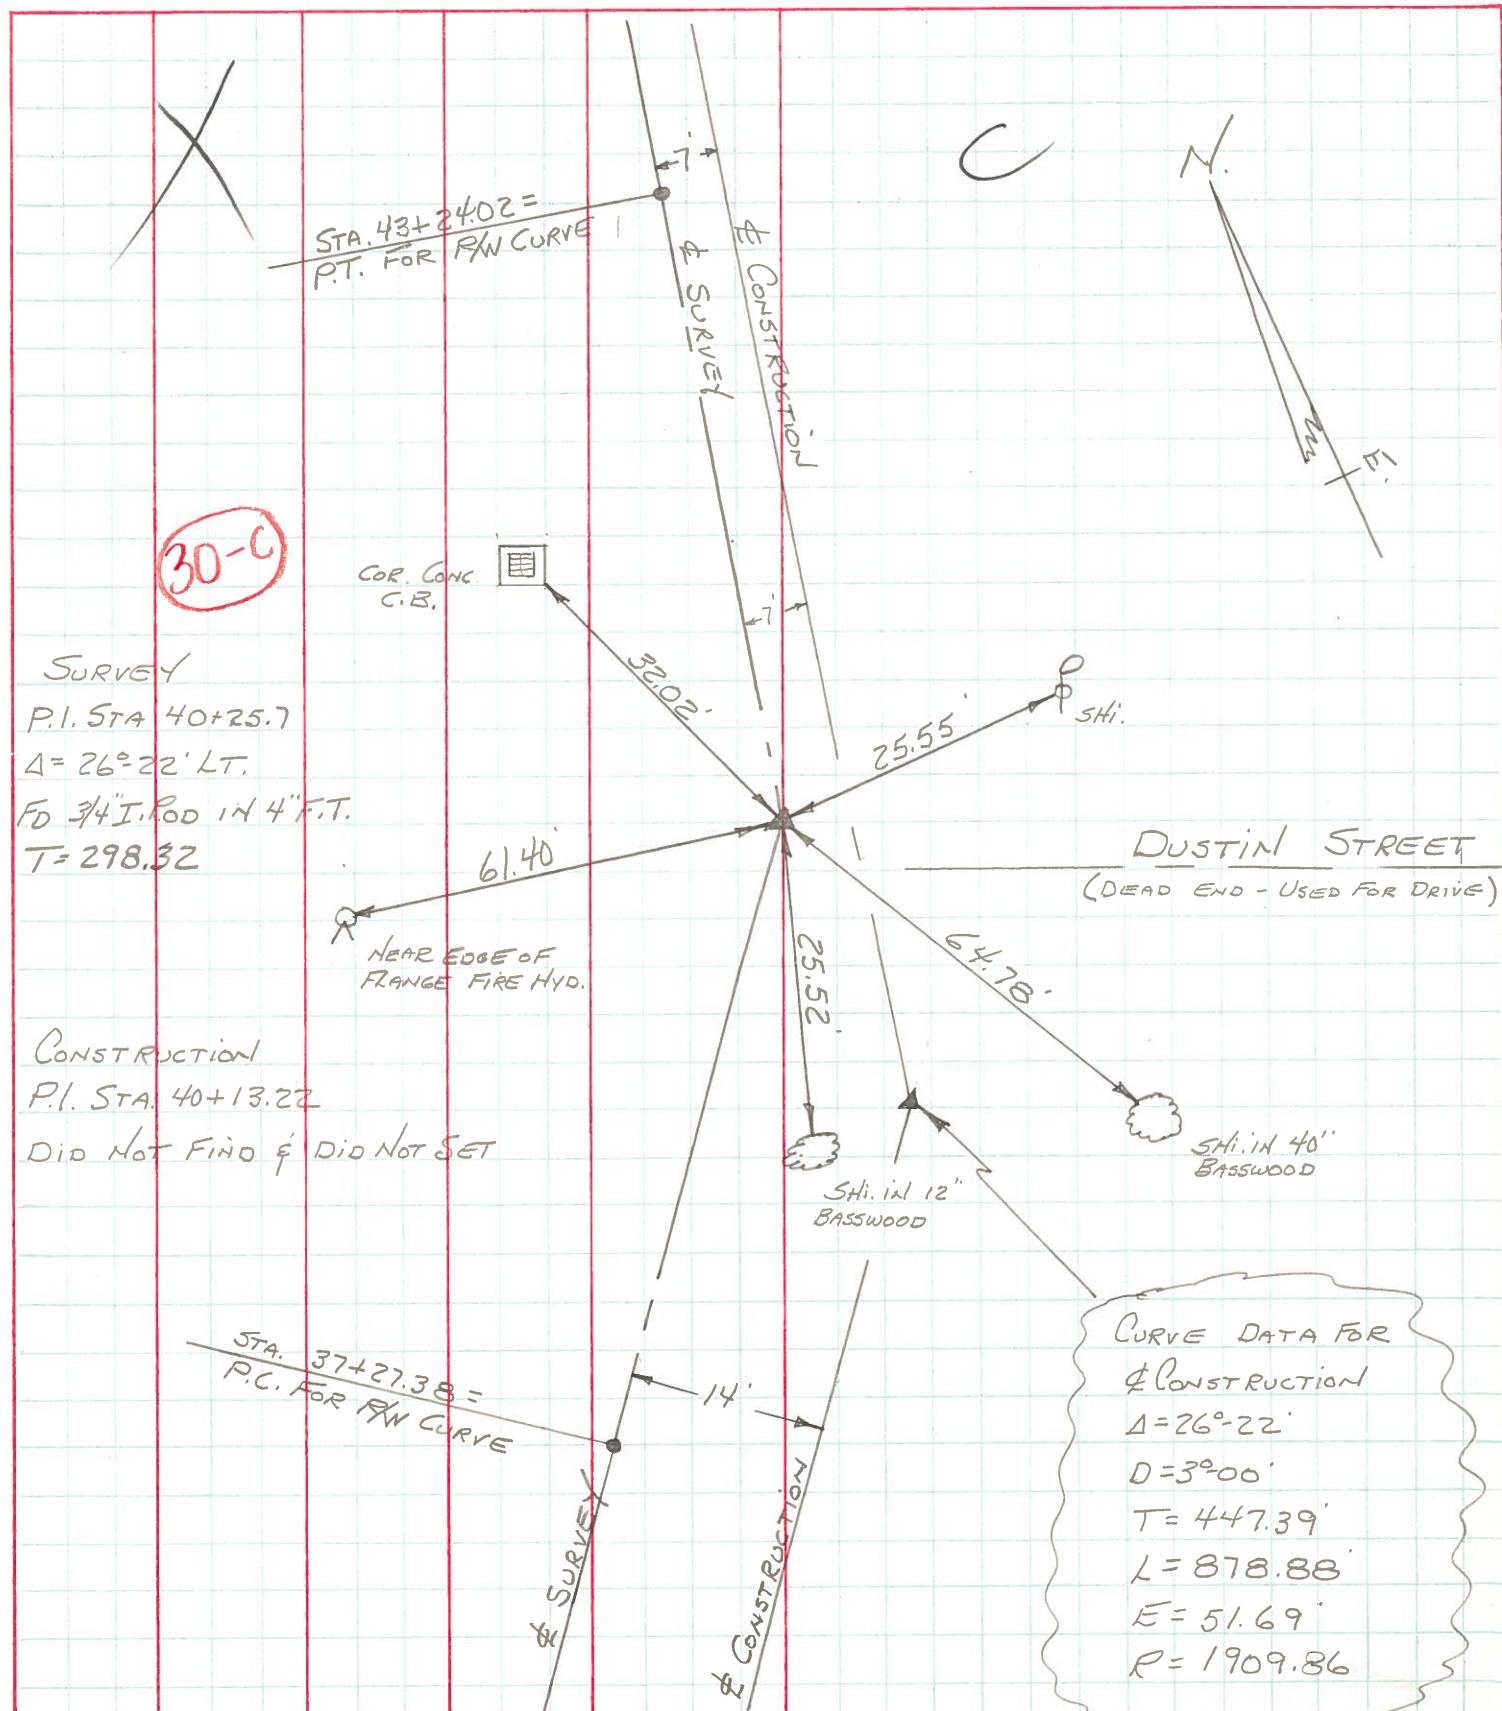

30-C

SURVEY
 P.I. STA 40+25.7
 $\Delta = 26^\circ 22' LT.$
 FD $\frac{3}{4}$ " I. ROD IN 4" F.T.
 $T = 298.32$

CONSTRUCTION
 P.I. STA. 40+13.22
 DID NOT FIND ϕ DID NOT SET

CURVE DATA FOR
 ϕ CONSTRUCTION
 $\Delta = 26^\circ 22'$
 $D = 3^\circ 00'$
 $T = 447.39'$
 $L = 878.88'$
 $E = 51.69'$
 $R = 1909.86'$