

O.D.O.T. DISTRICT 2 SURVEY OFFICE (USE ONLY)

PERSONNEL \_\_\_\_\_ REFERENCE NO. 30 D SHEET 4 OF 8  
 NOTES BARNHISEL DATE 5/2/88 ROUTE SR 65  
 H.C. REED WEATHER SUNNY COUNTY WOOD  
 R.C. LOEHRKE TEMP. 70° TOWNSHIP PERRYSBURG  
           HOFFMAN SECTION RT 69  
 DWG BY NIESE PID - T 3 12 MILE RESERVE

TYPE MONUMENT 3/4" IPIN

~~ON SURFACE~~ - BELOW 12"


OFFSET  $\odot$  PAVEMENT 46.3' LT : ~~RT~~

31.2' TO LT EDGE PAVEMENT


STATION: 1052+43

HORZ. DATUM: - GEOID: -

GRID: NORTHING: - EASTING: -

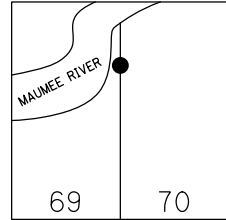

RECORD: P.I.  
 1937  $\odot$  SURVEY & RW  
 STA. 48+54.2  
 $\Delta = 32^\circ 09' RT$   
 DNF  
 12/16/19, JFO

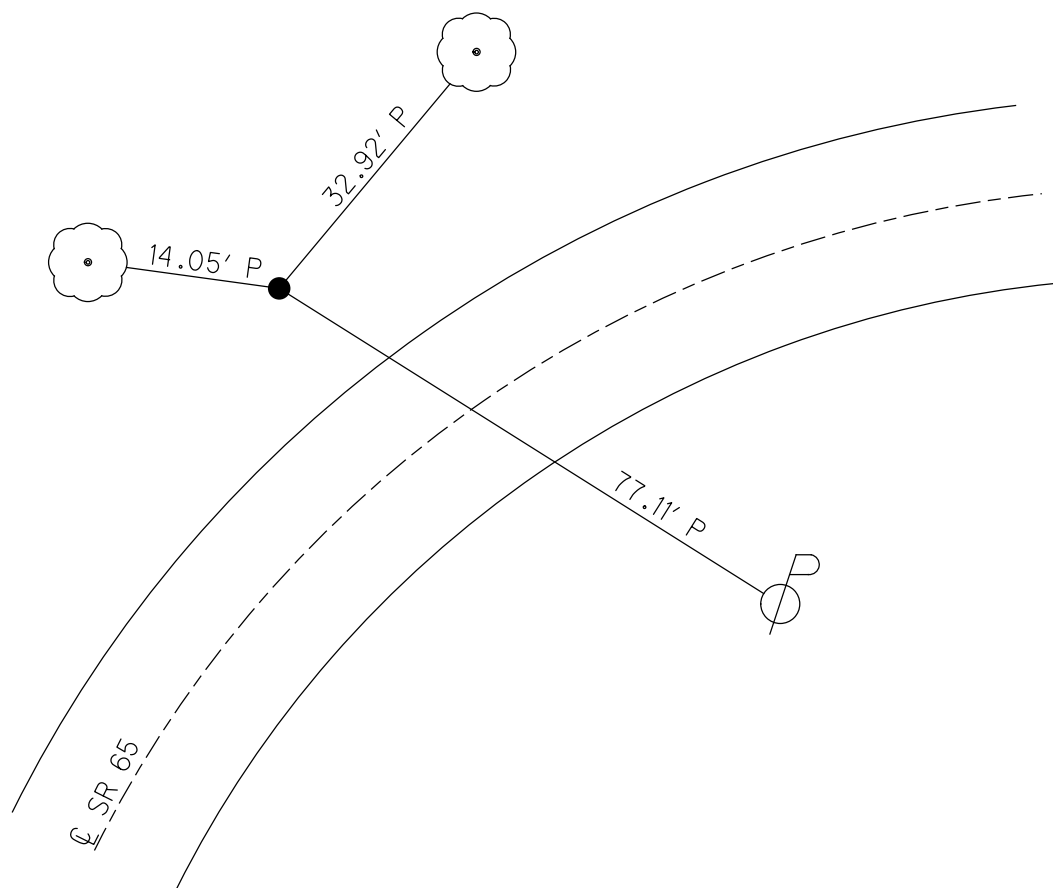

O.D.O.T. DISTRICT 2 SURVEY OFFICE

PERSONNEL


NOTES BARNHISEL  
 H.C. REED  
 R.C. LOEHRKE  
HOFFMAN

REFERENCE NO. 30-D SHEET 6 OF 14

DATE 5-2-88  
 WEATHER SUNNY  
 TEMP. 70°


ROUTE SR 65  
 COUNTY WOOD  
 TOWNSHIP PERRYSBURG  
 SECTION RIVER TRACT  
~~T7-N~~ ~~R11-E~~  
 Total 3, 12 mile Res.

TYPE MONUMENT P.I. 3 / 4" IRON ROD  
~~ON SURFACE~~ - BELOW 12"  
 LEFT - ~~Q PAVT~~ ~~RIGHT~~ 46.3' LT  
31.2' TO LT EDGE PAVEMENT  
 S.L.M. 1052+43

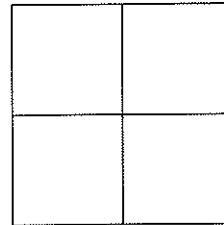

RECORD  
 1937 Q SURVEY & Q R/W STATION=  
 P.I. 48+54.2  
 DELTA=32°09' RT.

NOTE: OFF ROAD  
 DID NOT LOCATE  
 ALL RECORD DATA

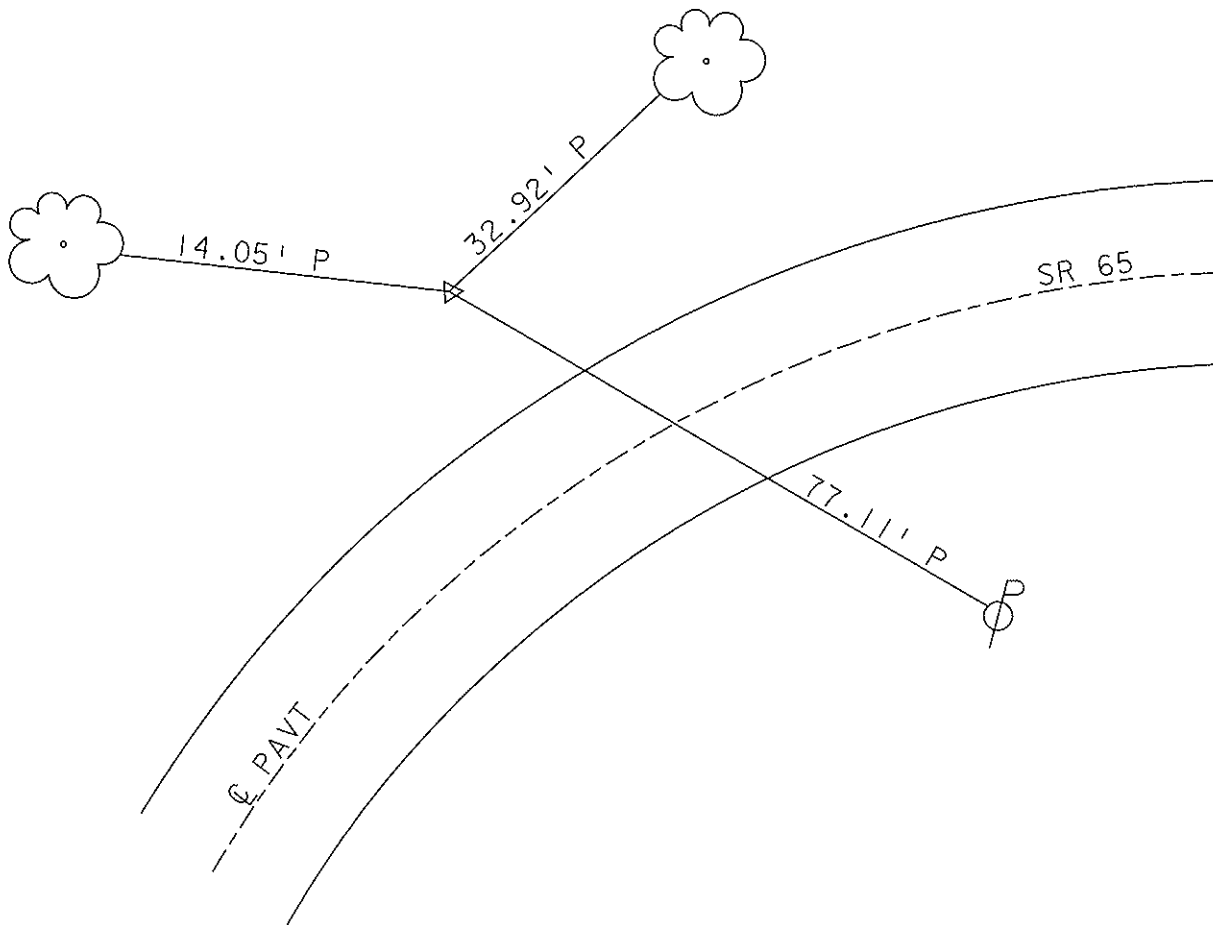

# O.D.O.T. DISTRICT 2 SURVEY OFFICE

PERSONNEL

REFERENCE NO. 30-D

SHEET      OF     

NOTES BARNHISEL

H.C. Reed

DATE 5-2-88

ROUTE 65

R.C. Locheke

WEATHER SUNNY

COUNTY WOOD

HOFFMAN

TEMP. +70°

TOWNSHIP Perryburg

SECTION RIVER TRACT 70

T 7 N R 11 E


TYPE MONUMENT P.I. 3/4" IRON ROD

ON SURFACE - BELOW 12"

~~LEFT~~ - CL PAV'T. - RIGHT 46.3

31.2 TO Lt EDGE PAVEMENT

S.L.M. 1052+43

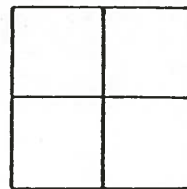


RECORD

1937 & Survey / E/W Station =

48+54.2

A = 32°-09' Rt

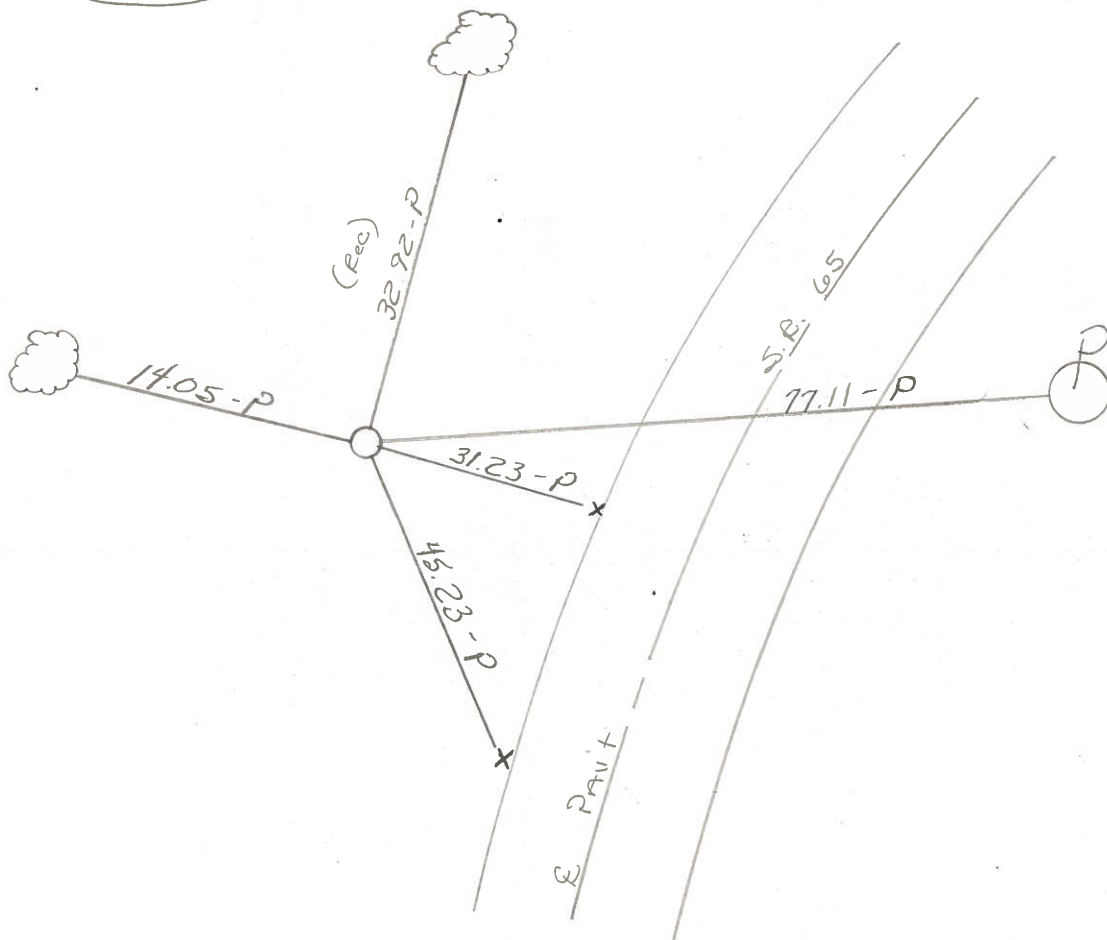

# O.D.O.T. DISTRICT 2 SURVEY OFFICE

PERSONNEL \_\_\_\_\_

REFERENCE NO. 30-D

SHEET \_\_\_\_\_ OF \_\_\_\_\_

NOTES Hoffman

H.C. Barnhisel

R.C. Loehrer

DATE 4-4-85

WEATHER P. CLEAR

TEMP. 50°

ROUTE SR 65

COUNTY Wood

TOWNSHIP Perrysburg

SECTION RIVER TRACT 70

T \_\_\_\_\_ R \_\_\_\_\_


TYPE MONUMENT 3/4" I. ROD IN 4" F. TILE

~~ON SURFACE~~ - BELOW 12"


LEFT - C PAV'T. - RIGHT 46.3

31.2 TO EAST EDGE PAVEMENT

S.L.M. LT.

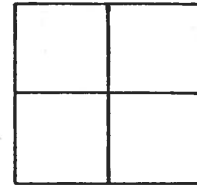

1937 E SURVEY/R/W STATION =  
 48+54.2  
 $\Delta = 32^{\circ}-09' RT.$

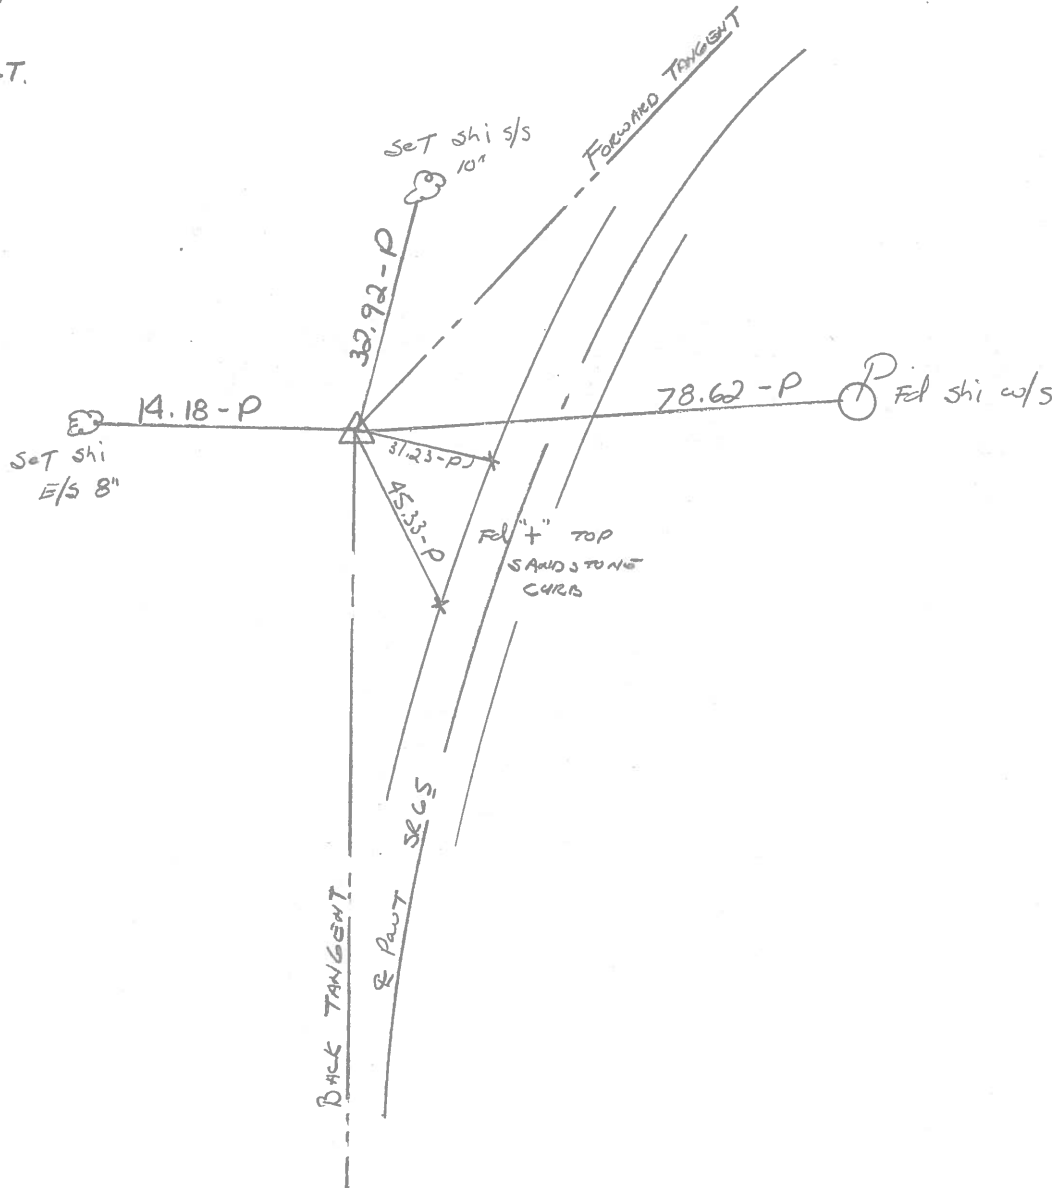

O.D.O.T. DISTRICT 2 SURVEY OFFICE

SHEET \_\_\_\_\_ OF \_\_\_\_\_

County Wood S.R. 65

Date 13 Nov. 80

Township \_\_\_\_\_

Weather Cloudy

Section \_\_\_\_\_

Temp. 46°

T\_N, R\_E


Personnel J. Stone

R. Michalak


P. Neuser

D. Curtis

H. Meed

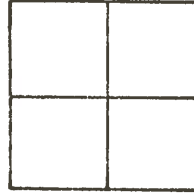

REF. No 30D

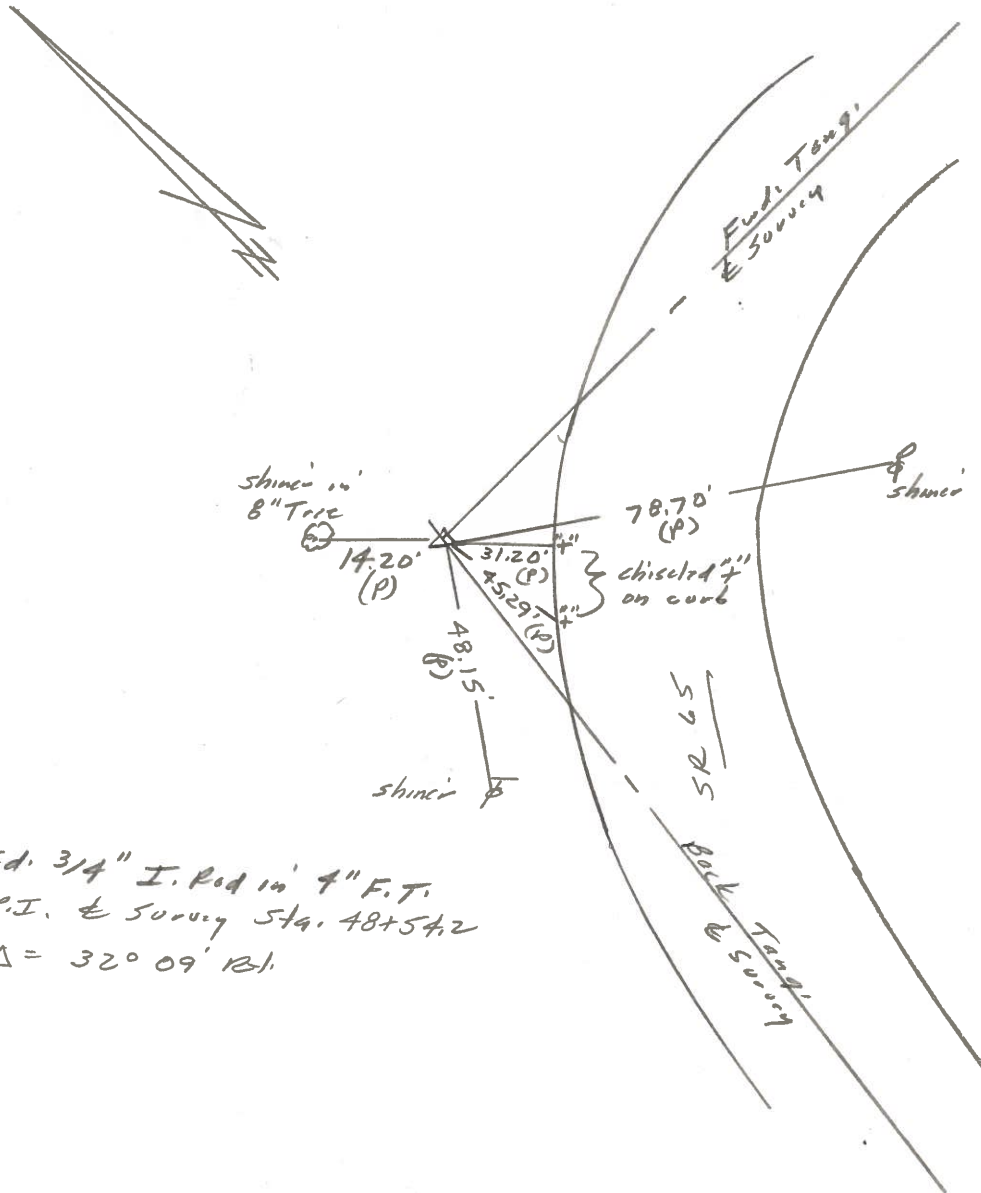


Fd. 3/4" I. Rod in 4" F.T.  
 P.I. & Survey Sta. 48+54.2  
 $\Delta = 32^\circ 09' 13.1$

| PERSONNEL | TITLE | PERSONNEL | TITLE |
|-----------|-------|-----------|-------|
| BURNSIDE  |       |           |       |
| SMITH     |       |           |       |
| BOWERS    |       |           |       |

COUNTY WOOD DATE 5-22-72  
 S. R. 65 WEATHER CLEAR  
 SEC. C.(PT) TEMP. +80°

DESCRIPTION \_\_\_\_\_ **PERRYSBURG TWP** JOB NO. \_\_\_\_\_

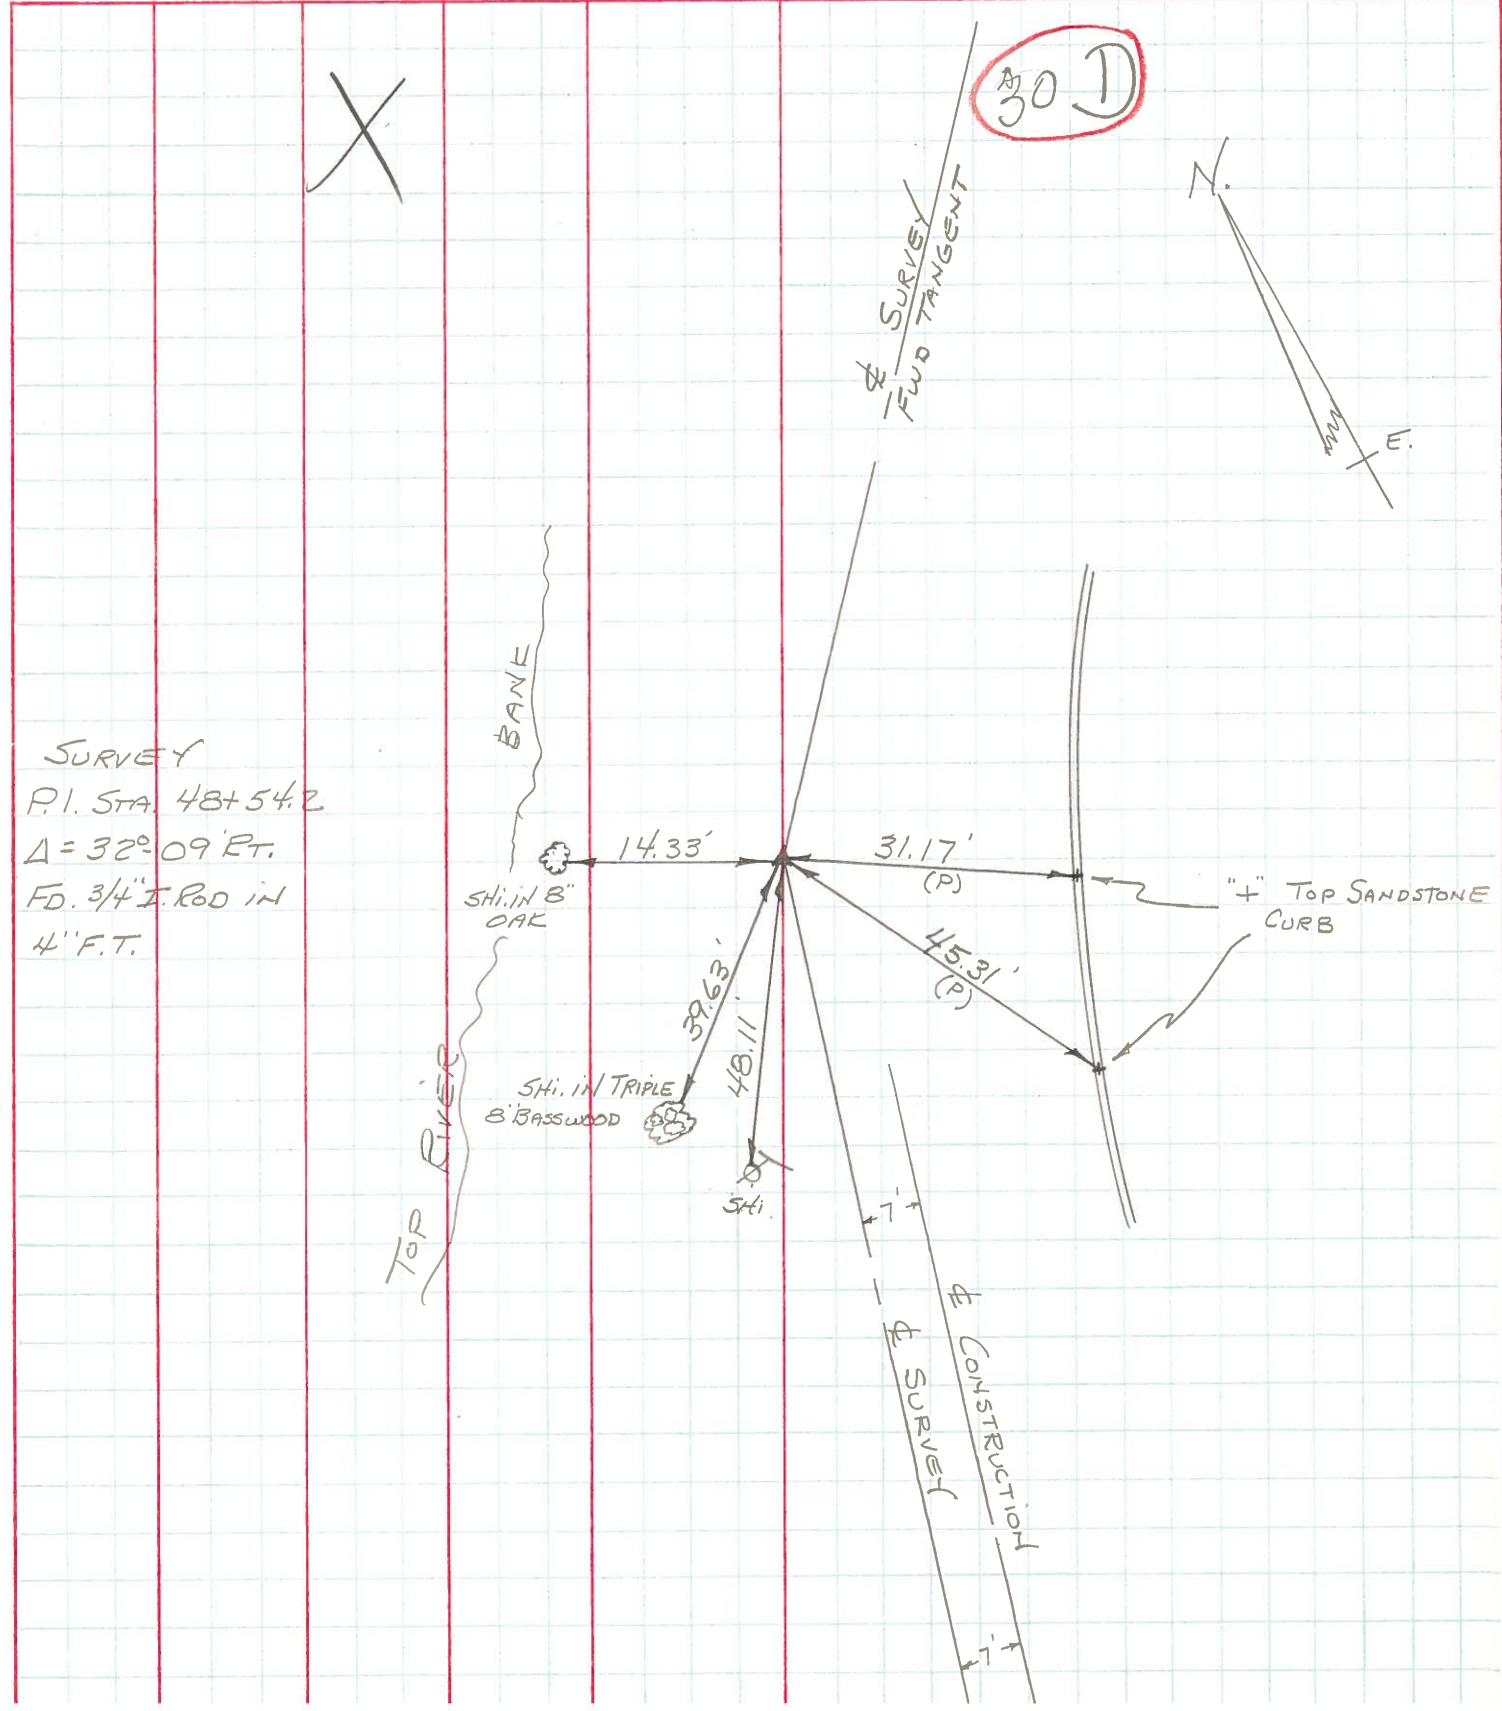

SURVEY  
 P.I. STA. 48+54.2  
 $\Delta = 32^\circ 09' RT.$   
 FD. 3/4" I. ROD IN  
 4" F.T.