


O.D.O.T. DISTRICT 2 SURVEY OFFICE (USE ONLY)

PERSONNEL _____ REFERENCE NO. 30 E SHEET 5 OF 21
 NOTES AUBLE DATE 5/8/23 ROUTE SR 65
 H.C. NIESE WEATHER CLOUDY COUNTY WOOD
 R.C. AUBLE TEMP. 55° TOWNSHIP PERRYSBURG
 DWG BY RHOADES PID PAVING TRAIN SECTION RT 70
 T 3 12 MILE RESERVE


TYPE MONUMENT MAG/WASHER
 ON SURFACE - ~~BELOW~~ ON
 OFFSET CL PAVEMENT 7.1' LT : ~~RT~~
4.8' TO LT EDGE PAVEMENT
 STATION: 1066+22

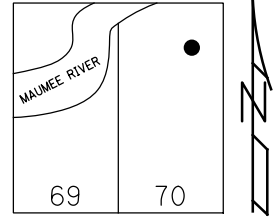

HORZ. DATUM: NAD83 2011 GEOID: NAVD88 2018
 GRID: NORTHING: 697801.237 EASTING: 1666843.670

RECORD:
 SET MAG/WASHER
 10/28/05, SAH
 FD MAG/WASHER
 REF30
 12/16/19, JFO
 FD MAG/WASHER
 REF30E
 5/8/23, TDN
 10/12/23, TDN

WOOD LPD:
 N: 519831.728
 E: 177026.605

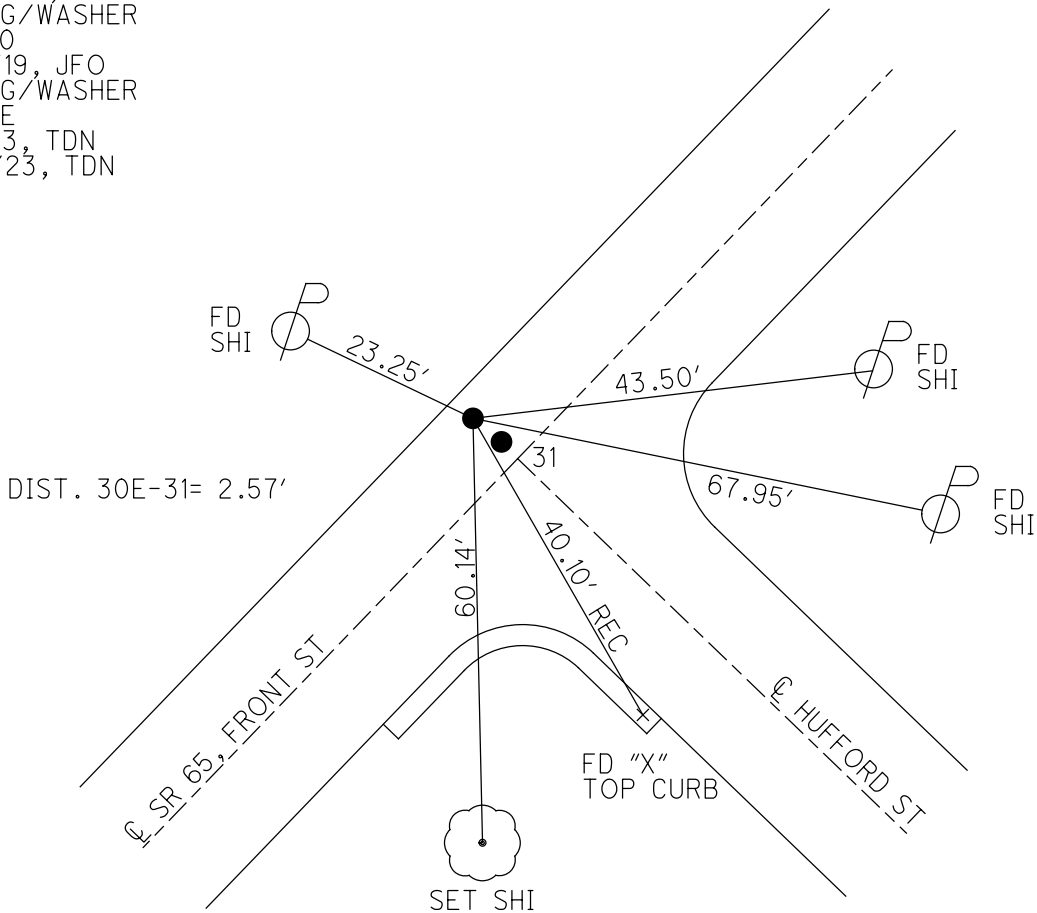

O.D.O.T. DISTRICT 2 SURVEY OFFICE (USE ONLY)

PERSONNEL

REFERENCE NO. 30 E

SHEET 5 OF 8

NOTES HUSS

DATE 9/13/05

ROUTE SR 65

H.C. HOMAN

WEATHER SUNNY

COUNTY WOOD

R.C. MIKLOVIC

TEMP. 80°

TOWNSHIP PERRYSBURG

SECTION RT 70

DWG BY NIESE

PID -

T 3

12 MILE RESERVE

TYPE MONUMENT P.K.NAIL

ON SURFACE - ~~BELOW~~ ON

OFFSET Q PAVEMENT 7.1' LT : ~~RT~~

4.8' TO LT EDGE PAVEMENT


STATION: 1066+22

HORZ.DATUM: NAD83(2011)


GEOID: 2012A

GRID: NORTHING: 697801.253

EASTING: 1666843.673

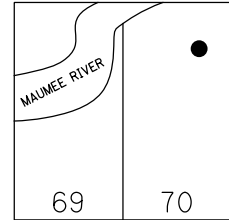

RECORD:
 SET MAG/WASHER
 10/28/05, SAH
 FD MAG/WASHER
 REFE30
 12/16/19, JFO

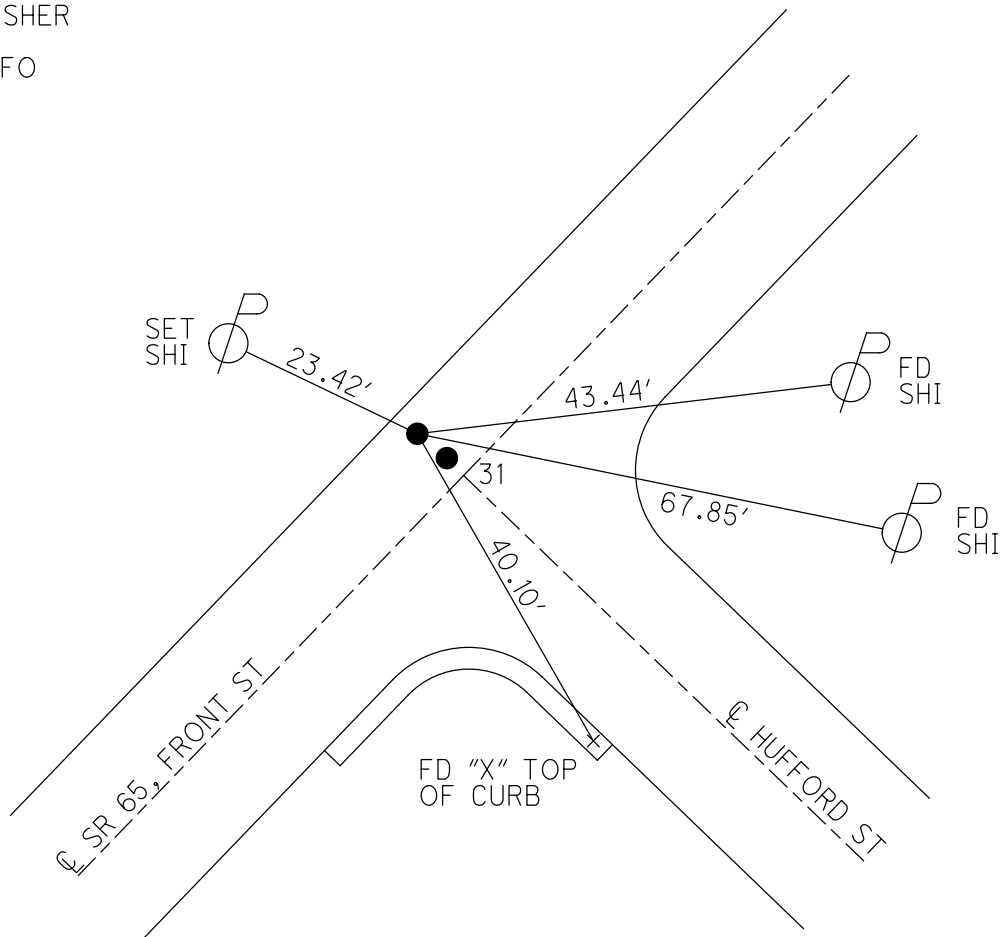

O.D.O.T. DISTRICT 2 SURVEY OFFICE

PERSONNEL

REFERENCE NO. 31

SHEET 7 OF 14

NOTES

HUSS

DATE 9-13-05

ROUTE S.R. 65

H.C.

HOMAN

WEATHER SUNNY

COUNTY WOOD

R.C.

MIKLOVIC

TEMP. 80°

TOWNSHIP PERRYSBURG

SECTION RIVER TRACT

~~T 7 N R 11 E~~

~~town 3, 12 miles Res.~~


TYPE MONUMENT PK NAILS

ON SURFACE - ~~BELOW~~ ON


LEFT - ~~C PAVT~~ - ~~RIGHT~~ A 7.1' B 4.6'

^A 4.8'
^B 7.4' TO LT EDGE PAVEMENT

S.L.M. 1066+22

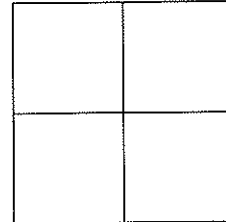

SET MAG NAILS
& WASHERS
10-28-05
SAH

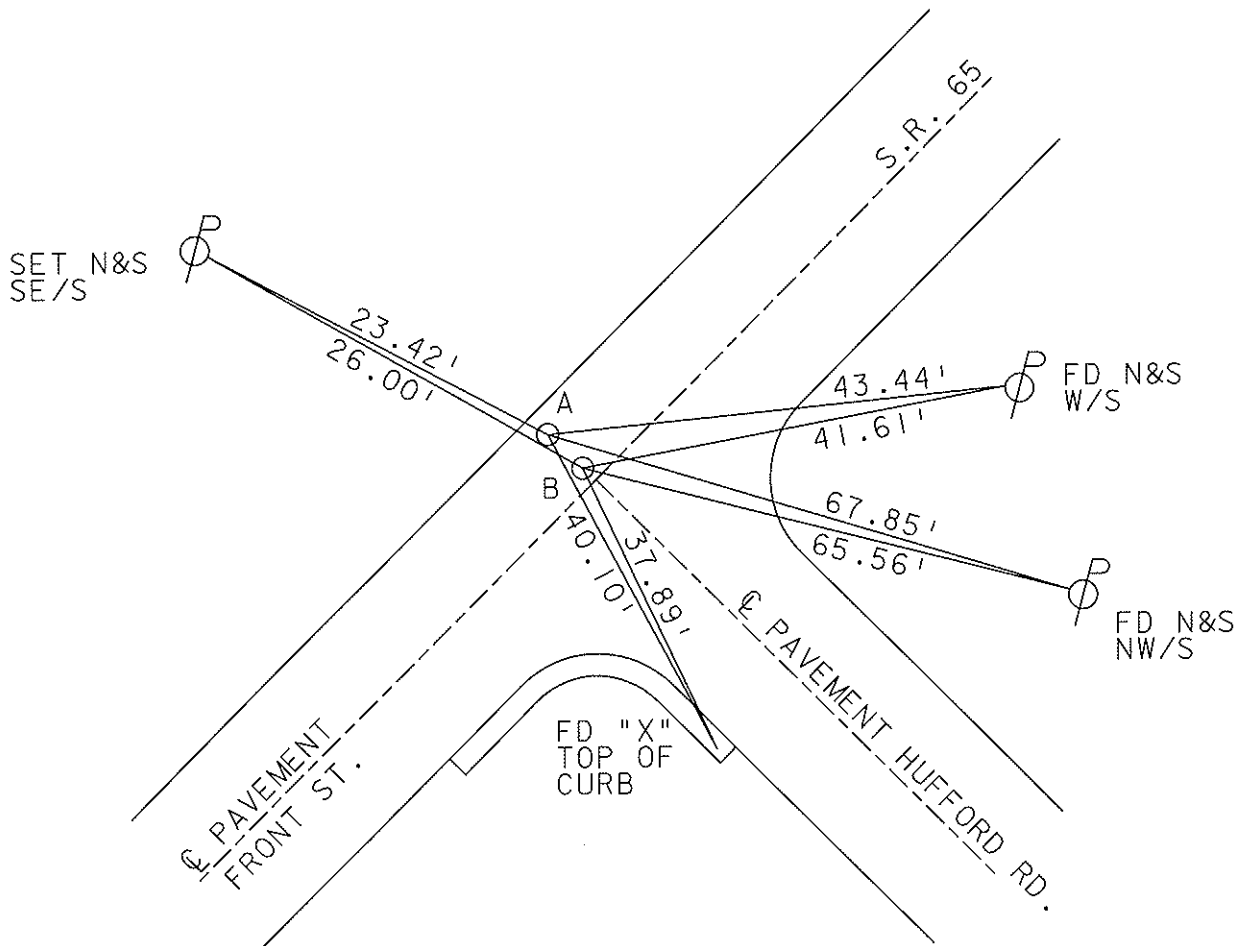

O.D.O.T. DISTRICT 2 SURVEY OFFICE

PERSONNEL _____ REFERENCE NO. 31 SHEET _____ OF _____

NOTES BARWISSEL

H.C. Reed DATE 5-3-88 ROUTE 65

R.C. Loehrke WEATHER Partly Cloudy COUNTY Wood

HOFFMAN TEMP. +55° TOWNSHIP Perrysburg

SECTION River Tract 70

T 7 R 11 E


TYPE MONUMENT P.K. Nails

ON SURFACE - ~~BELOW~~ yes

LEFT-~~C~~ PAV'T. - ~~RIGHT~~ 5.2 - 2.60 Between


8.2
10.8 TO Lt EDGE PAVEMENT

S.L.M. 1066 + 22

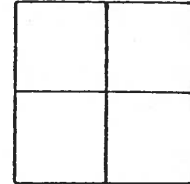

Pt. A.
Pt. B.

Set P.K.'s & washers
8-26-88
m.B.

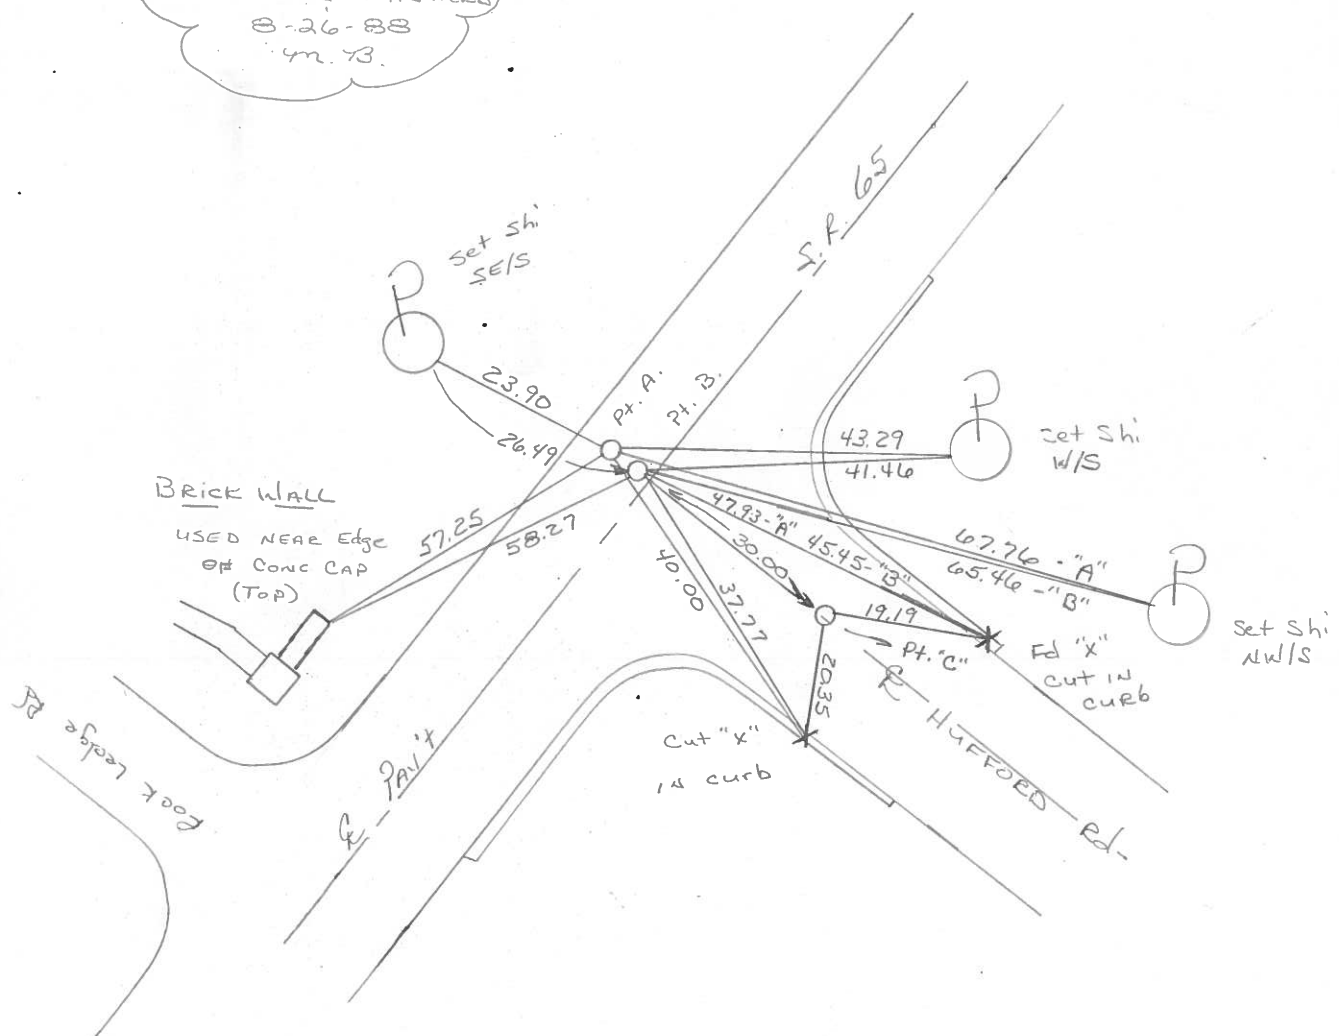

9-13-05 DID NOT FIND OR
Reset "C"

O.D.O.T. DISTRICT 2 SURVEY OFFICE

SHEET _____ OF _____

County Wood S.R. 65

Date 13 Nov. 80

Township _____

Weather Cloudy

Section _____

Temp. 50°

T N, R E


Personnel J. Stone

P. Neuser


R. Michelak

D. Curtis

H. Mead

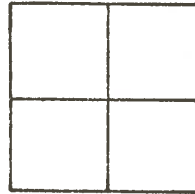

REF. NO. 31

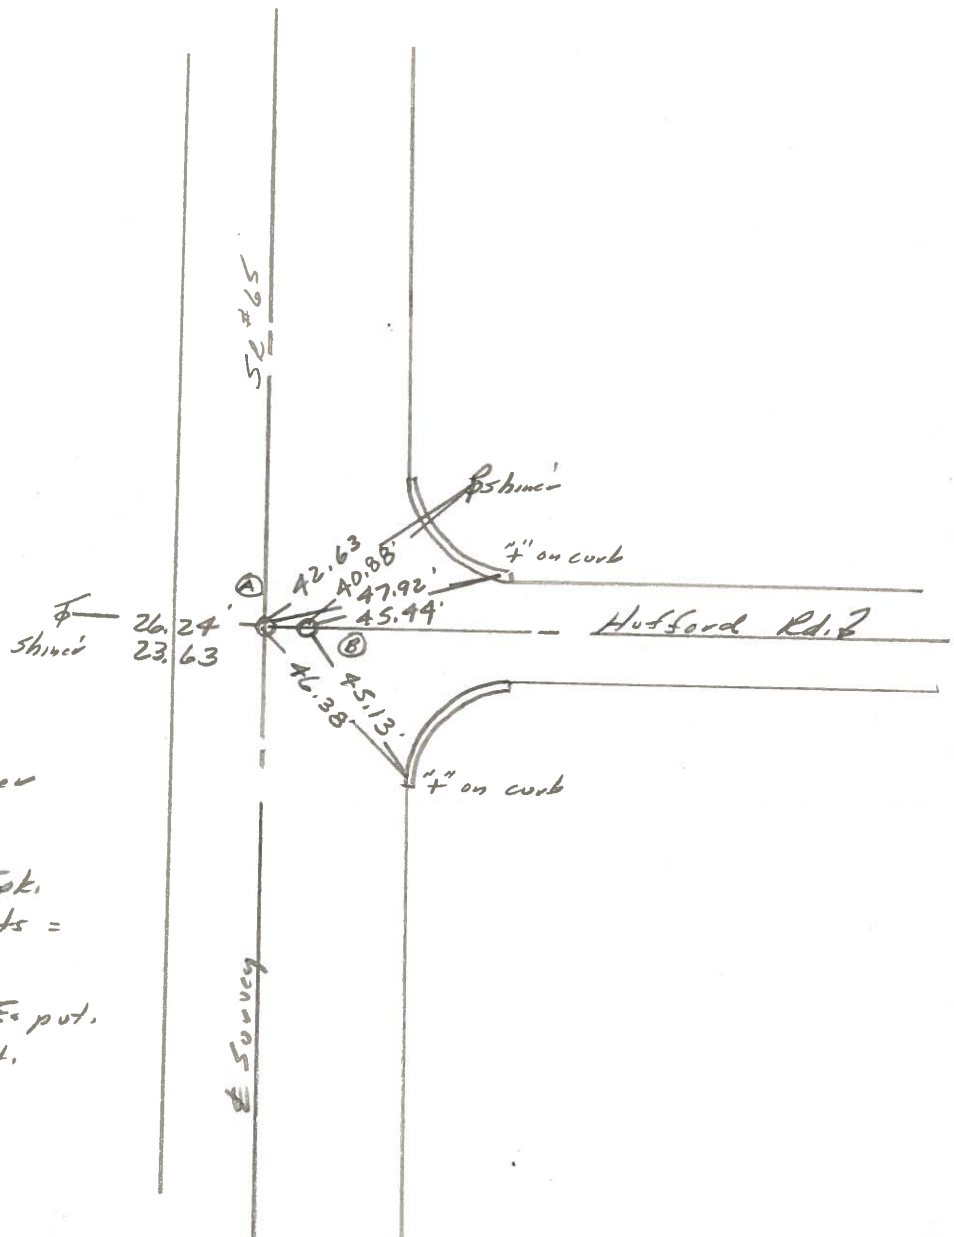

Set PK Nails as per
 1978 Refs.
 400 ± S. of Ohio Tpk.
 distance between points =
 2.60'
 Splits **A** = 8.2' to N.E. put.
B = 10.7' to N.E. put.

O.D.O.T. DISTRICT 2 SURVEY OFFICE

Sht. 14 of 20
S.R. 65

County WOOD

Date 7-31-78

Township PERRYSBURG


Weather CLEAR

Section _____

Temp. +75°

T_N, R_E

Personnel BURNSIDE

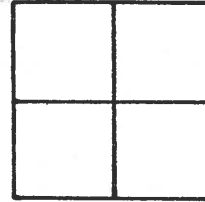

SMITH

BOWERS


KNAPE

MEAD

31




FD P.K. NAILS
@ SURFACE

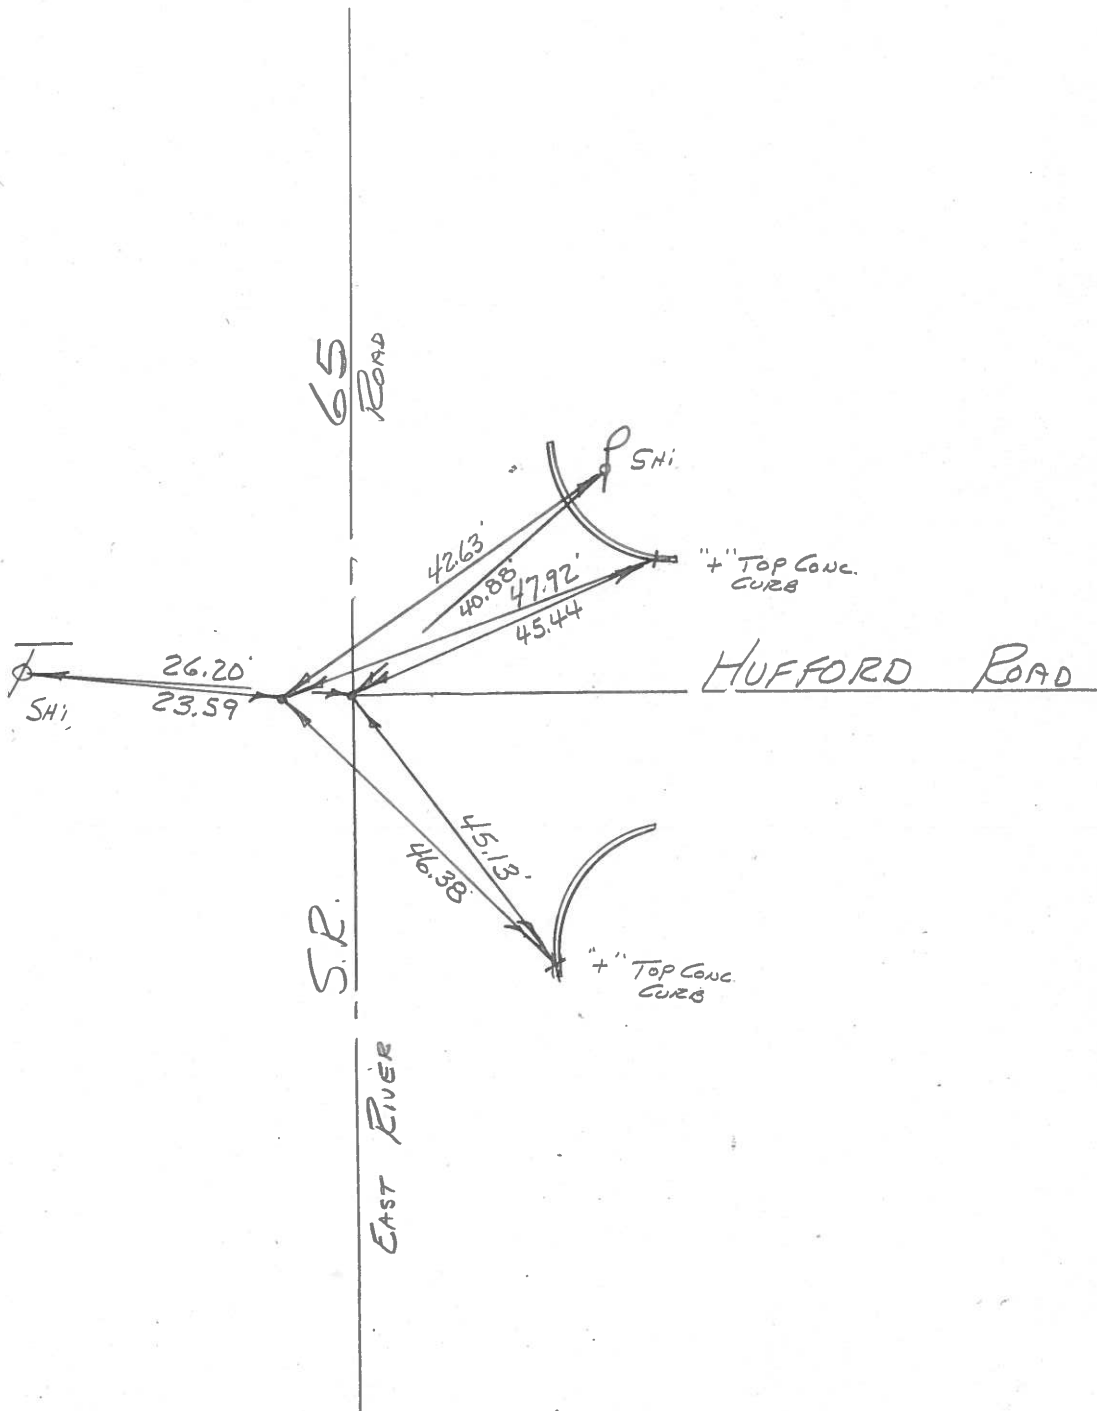

PERSONNEL	TITLE	PERSONNEL	TITLE
Granata			
Neuser			
Vanyo			
Jackson			

COUNTY Wood DATE Aug. 16, 1971
 S. R. #65 WEATHER Fair
 SEC. PERRYSBURG TWP TEMP. 80's

DESCRIPTION Reference Mon. on S.R. #65 JOB NO. _____
 LEFT CENTER LINE RIGHT

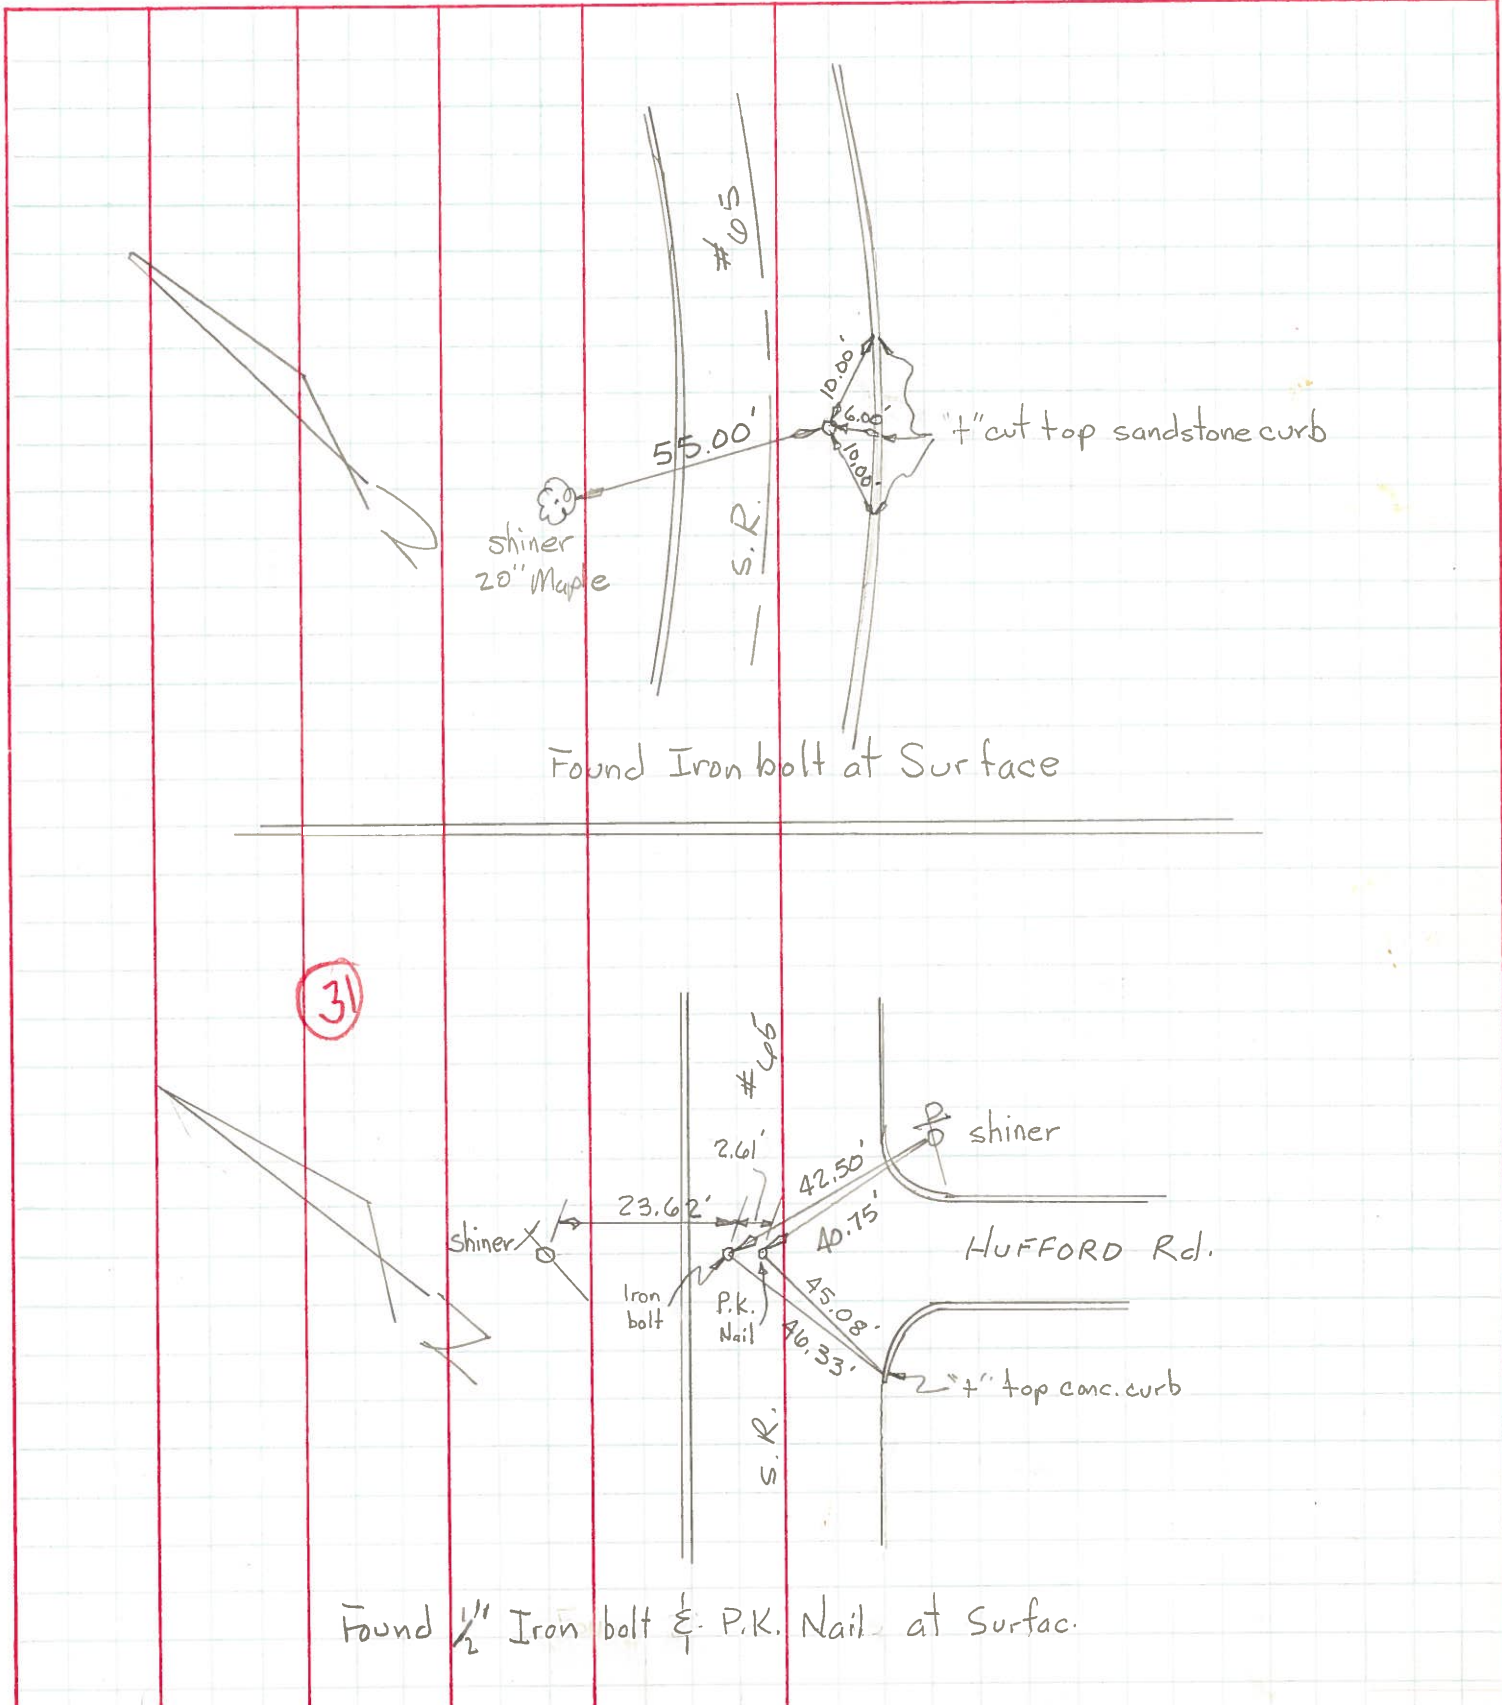

PERSONNEL TITLE PERSONNEL TITLE

COUNTY Wood DATE _____

S. R. 65 WEATHER _____

SEC. _____ TEMP. _____

DESCRIPTION LEFT CENTER LINE RIGHT JOB NO.

Use Center Line for Trac. Cor.

Use Center Line for Trac. Cor.

Replaced R.R. Spk. 8-29-65
58 South
1/4 East of Iron Bolt 3 1/2" below Surface

33.58
30.56
33.36
33.11
R.R.

30


Fd. P.K.
Mon. Box
Replaced P.K.
8-29-65



E. COVINGTON ST.

31


Fd. P.K.
Replaced P.K.
8-29-65

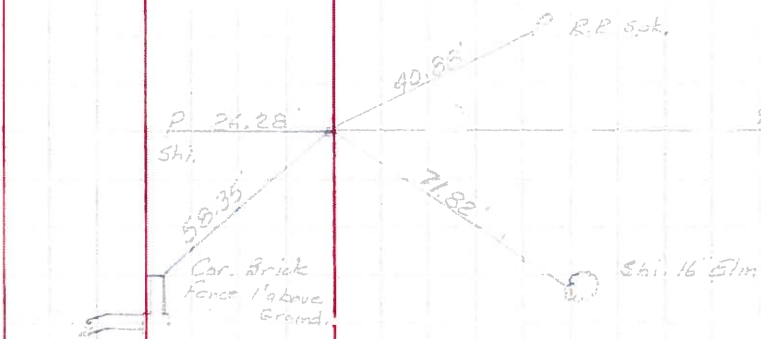

HUFFORD ST.

31-A

Fd. P.K.
P.K. 0+20 West

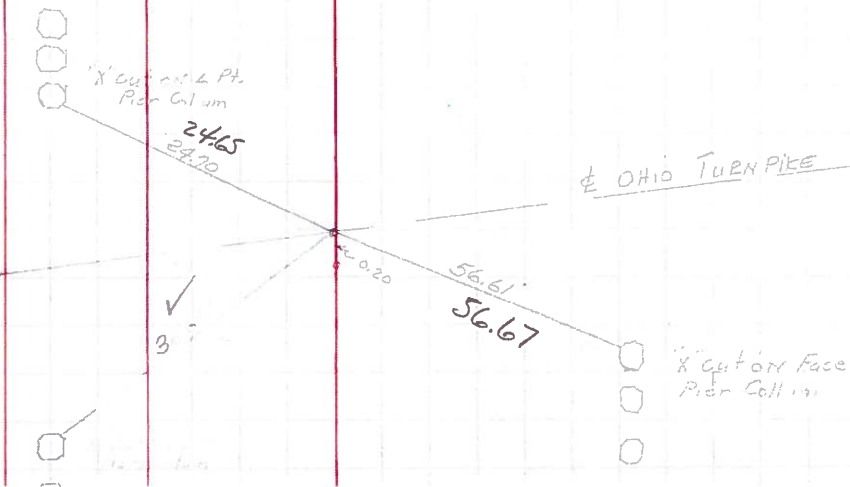

OHIO TURNPIKE