


O.D.O.T. DISTRICT 2 SURVEY OFFICE (USE ONLY)

PERSONNEL \_\_\_\_\_ REFERENCE NO. 31 B SHEET 8 OF 21  
 NOTES AUBLE DATE 5-8-23 ROUTE SR 65  
 H.C. NIESE WEATHER CLOUDY COUNTY WOOD  
 R.C. AUBLE TEMP. 55° F TOWNSHIP PERRYSBURG  
 DWG BY AUBLE PID PAVING TRAIN SECTION RT 71  
 T 3 12 MILE RESERVE


TYPE MONUMENT MAG SHANK  
 ON SURFACE - ~~BELOW~~ ON  
 OFFSET  $\odot$  PAVEMENT 7.0' LT : RT  
5.4' TO LT EDGE PAVEMENT  
 STATION: 1075+11

HORZ. DATUM: NAD83 2011 GEOID: NAVD88 2018  
 GRID: NORTHING: 698402.077 EASTING: 1667499.575

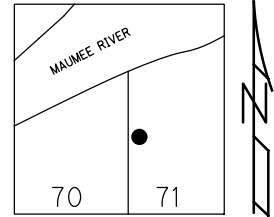

RECORD:  
 SET MAG/WASHER  
 10-28-05, SAH  
 FD MAG SHANK  
 REFB31  
 11-7-2019, JLL  
 FD MAG SHANK  
 REFB31  
 11-17-22, TDN  
 5-8-23, TDN  
 10/12/23, TDN

WOOD LPD:  
 N: 520441.196  
 E: 177674.557

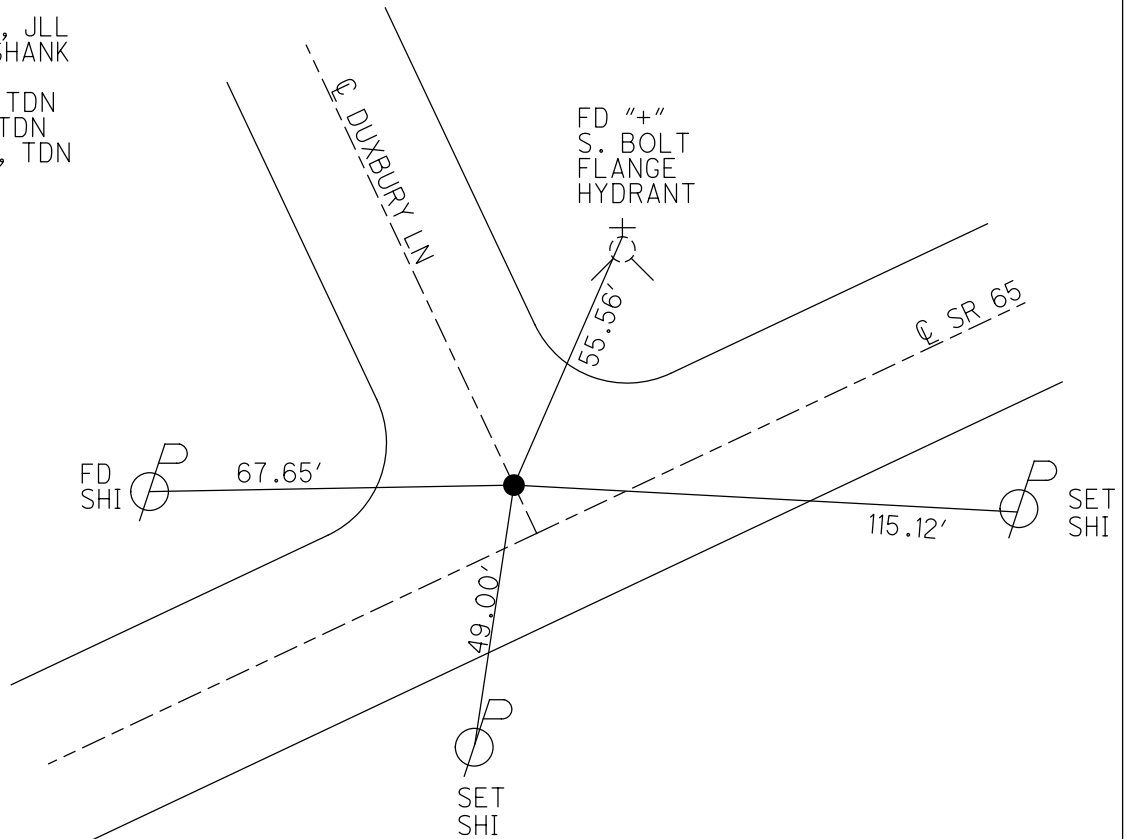

O.D.O.T. DISTRICT 2 SURVEY OFFICE (USE ONLY)

PERSONNEL \_\_\_\_\_ REFERENCE NO. 31 B SHEET 8 OF 8

NOTES AUBLE DATE 11-7-2019 ROUTE SR 65

H.C. LEU WEATHER CLOUDY COUNTY WOOD

R.C. NASON TEMP. 40° F TOWNSHIP PERRYSBURG

SECTION RT 71

DWG BY AUBLE PID 100460 T 3 12 MILE RESERVE

TYPE MONUMENT MAG SHANK

ON SURFACE - ~~BELOW~~ ON


OFFSET Q PAVEMENT 7.0' LT : RT

5.4' TO LT EDGE PAVEMENT


STATION: 1075+11

HORZ.DATUM: NAD83 (2011) GEOID: 2012A

GRID: NORTHING: 698402.0631 EASTING: 1667499.6086

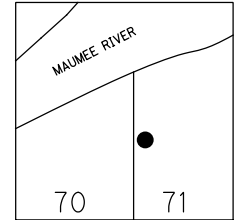

RECORD:  
 SET MAG/WASHER  
 10-28-05, SAH  
 FD MAG SHANK  
 REFB31  
 11-7-2019, JLL

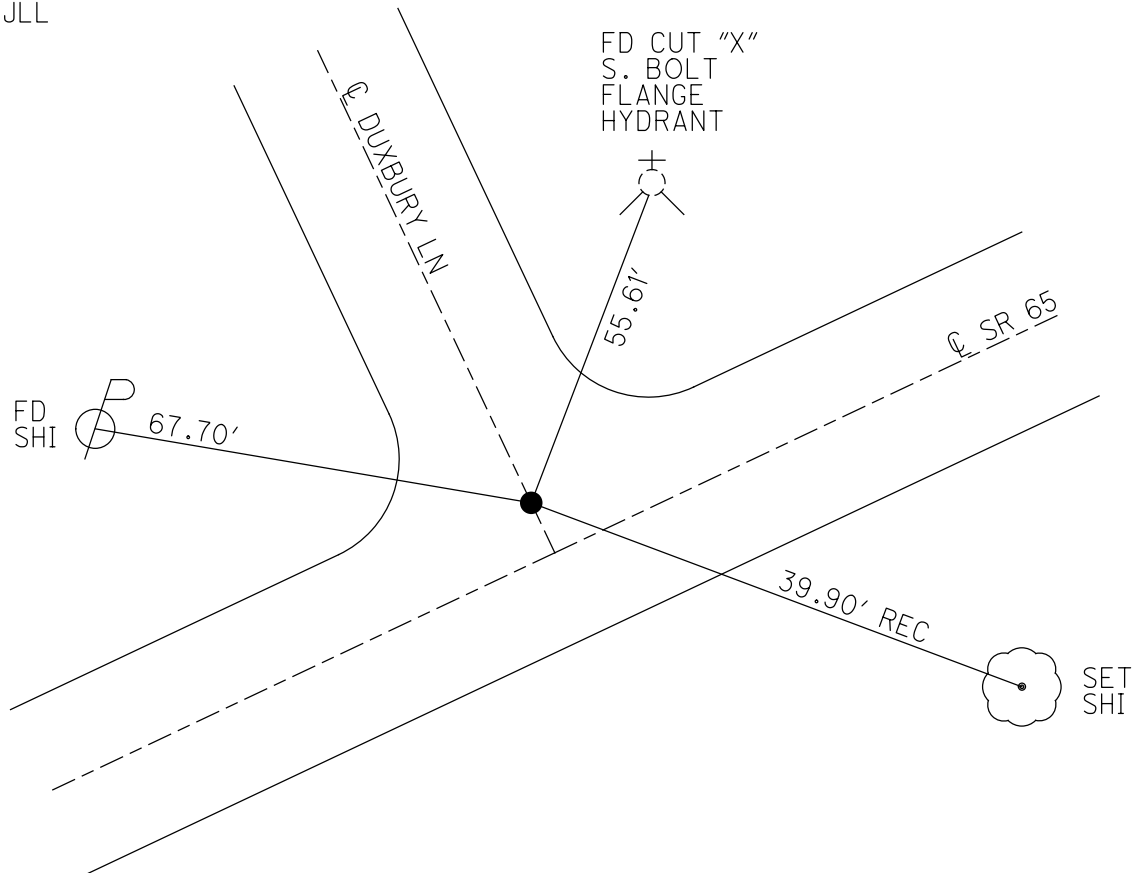

O.D.O.T. DISTRICT 2 SURVEY OFFICE

PERSONNEL

REFERENCE NO. 31-6

SHEET 9 OF 14

NOTES

HUSS

DATE

9-13-05

ROUTE

S.R. 65

H.C.

HOMAN

WEATHER

SUNNY

COUNTY

WOOD

R.C.

MIKLOVIC

TEMP.

80°

TOWNSHIP PERRYSBURG

SECTION RIVER TRACT

~~T7N R11E~~

Town 3, 12 mile Res.

TYPE MONUMENT

SM RR SPIKE

~~ON SURFACE~~ - BELOW

1"



LEFT - ~~C PAVT~~ - RIGHT

7.0' LT

5.4' TO LT EDGE PAVEMENT

S.L.M.

1075+11

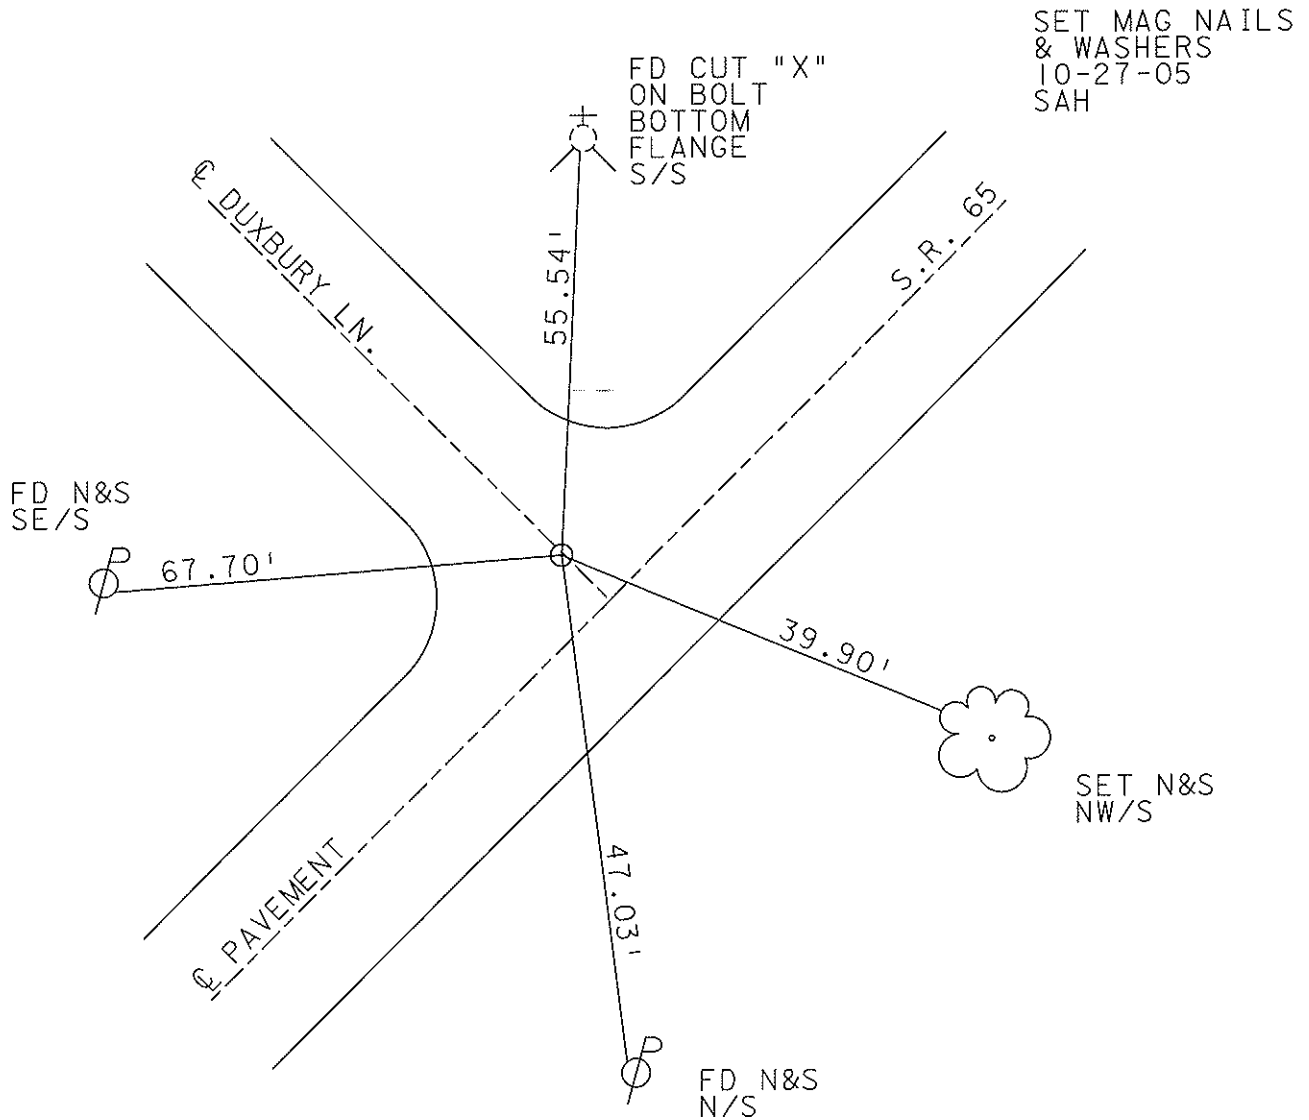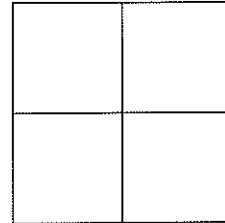

# O.D.O.T. DISTRICT 2 SURVEY OFFICE

PERSONNEL

REFERENCE NO. 31 B

SHEET      OF     

NOTES BARNHISEL

H.C. Reed

DATE 5-3-88

ROUTE 65

R.C. Loehrke

WEATHER SUNNY

COUNTY Wood

HOFFMAN

TEMP. +58°

TOWNSHIP Pereysburg

SECTION River Tract 71

T 7 N R 11 E


TYPE MONUMENT Sm BR Spk - P.K. NAIL ON R/W

ON SURFACE - ~~BELOW~~ yes


LEFT-~~C~~ PAV'T. - ~~RIGHT~~ 7.4

8.5 TO Lt EDGE PAVEMENT

S.L.M. 1075+11

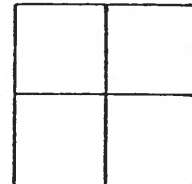

Set P.K. & Washer  
8-26-88  
m.s.

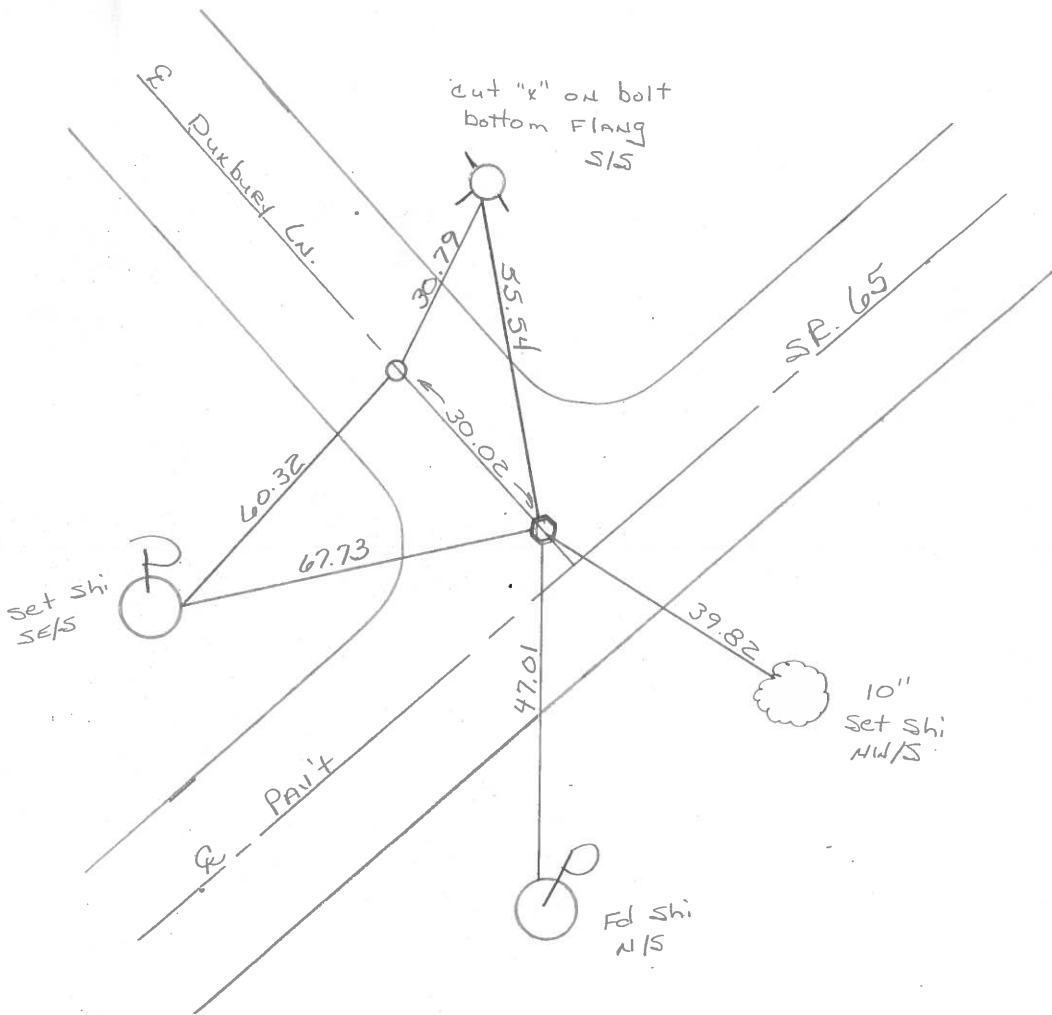

ODOT DISTRICT 2 SURVEY OFFICE

SHEET \_\_\_\_\_ OF \_\_\_\_\_

County Wood S.R. 65

Date 17 Nov. 80

Township \_\_\_\_\_


Weather cloudy

Section \_\_\_\_\_

Temp. 38°

T N, R E

Personnel J. Stone

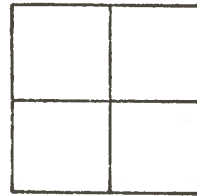


R. Michalak

P. Neuser

D. Curtis

H. Mead

REF. NO. 313

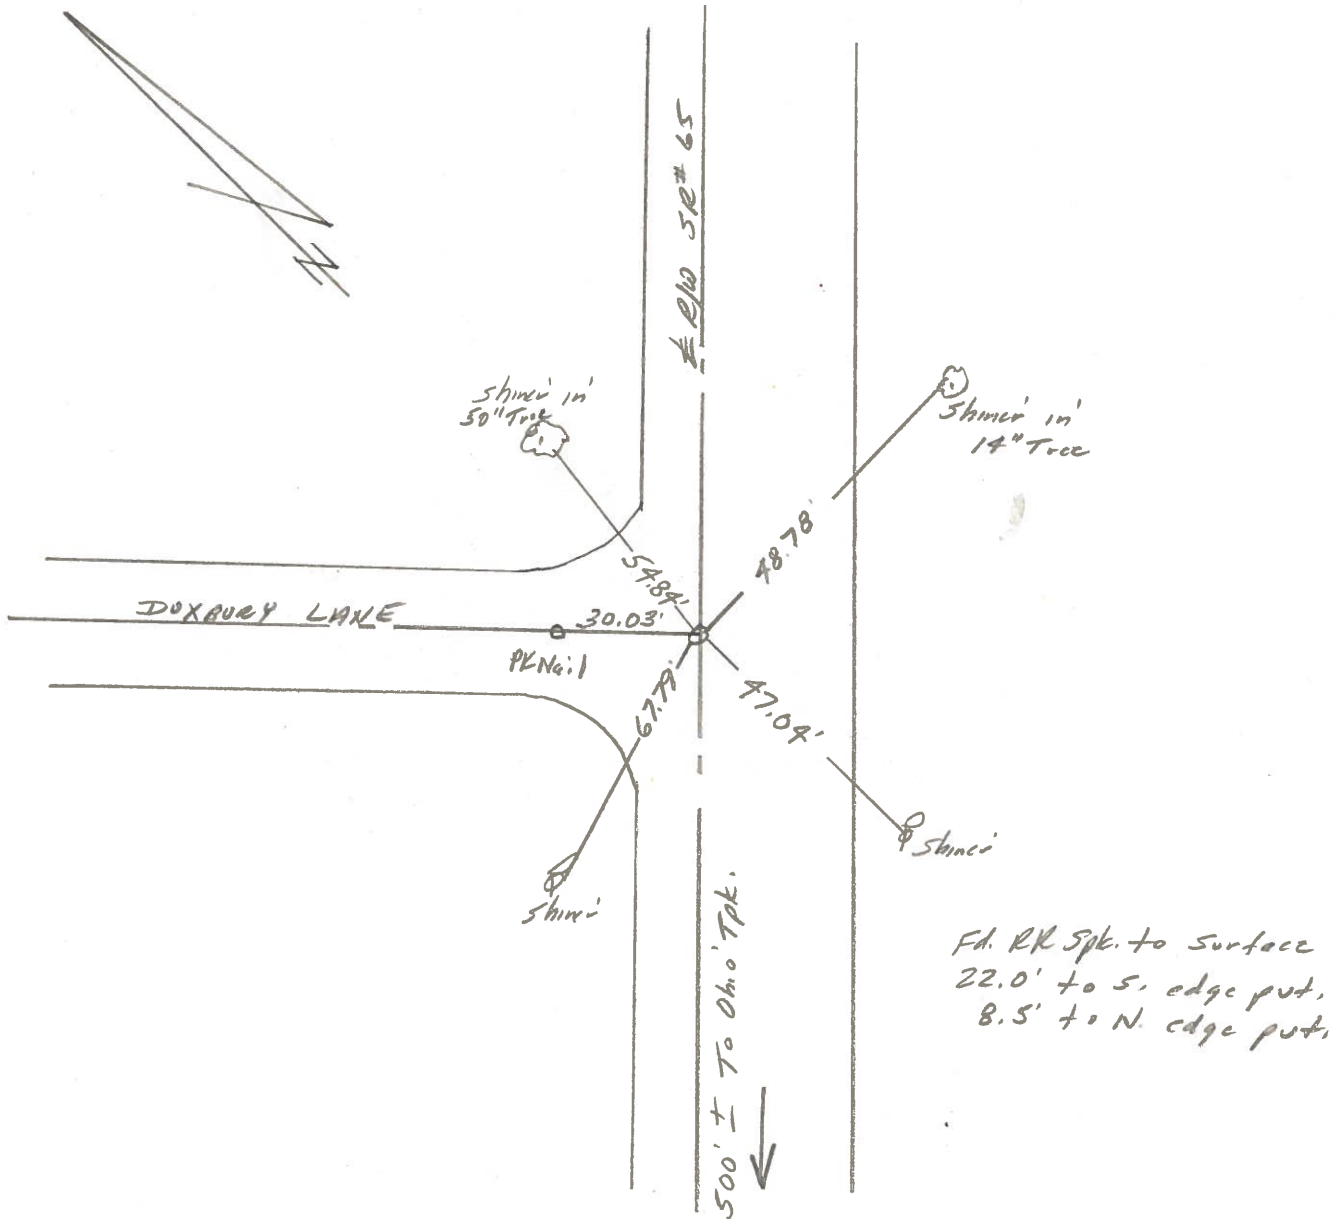

Fd. RR Spk. to surface  
22.0' to S. edge put,  
8.5' to N. edge put,

500' ± To Ohio Tpk.  
↓