


O.D.O.T. DISTRICT 2 SURVEY OFFICE (USE ONLY)

PERSONNEL _____ REFERENCE NO. 36 SHEET 12 OF 12
 NOTES BARNHISEL DATE 4-24-91 ROUTE SR 65
 H.C. LOEHEKE WEATHER CLOUDY COUNTY WOOD
 R.C. HOFFMAN TEMP. 58° F TOWNSHIP ROSSFORD
 SECTION RT 81
 DWG BY AUBLE PID _____ T 8 N N 11 E


TYPE MONUMENT BRASS R/W PLATE
~~ON SURFACE~~ - BELOW 4"
 OFFSET Q PAVEMENT 12.0' LT : RT
37' TO RT EDGE PAVEMENT
 STATION: 1227+77

79	8081	8283
	●	
78		
77		SEC
76		23

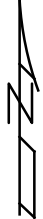

HORZ. DATUM: - GEOID: -
 GRID: NORTHING: - EASTING: -

RECORD:
 $\Delta = 31^\circ - 46'$
 SET 1 ROD PER
 R/W PLAN 1934
 STA: 224+22.00
 $\Delta = 32^\circ - 01'$
 FD BRASS R/W
 PLATE 4" DEEP
 SET PK/WASHER
 5-31-91, MB
 CITY OF ROSSFORD
 SUPPOSED TO SET MON

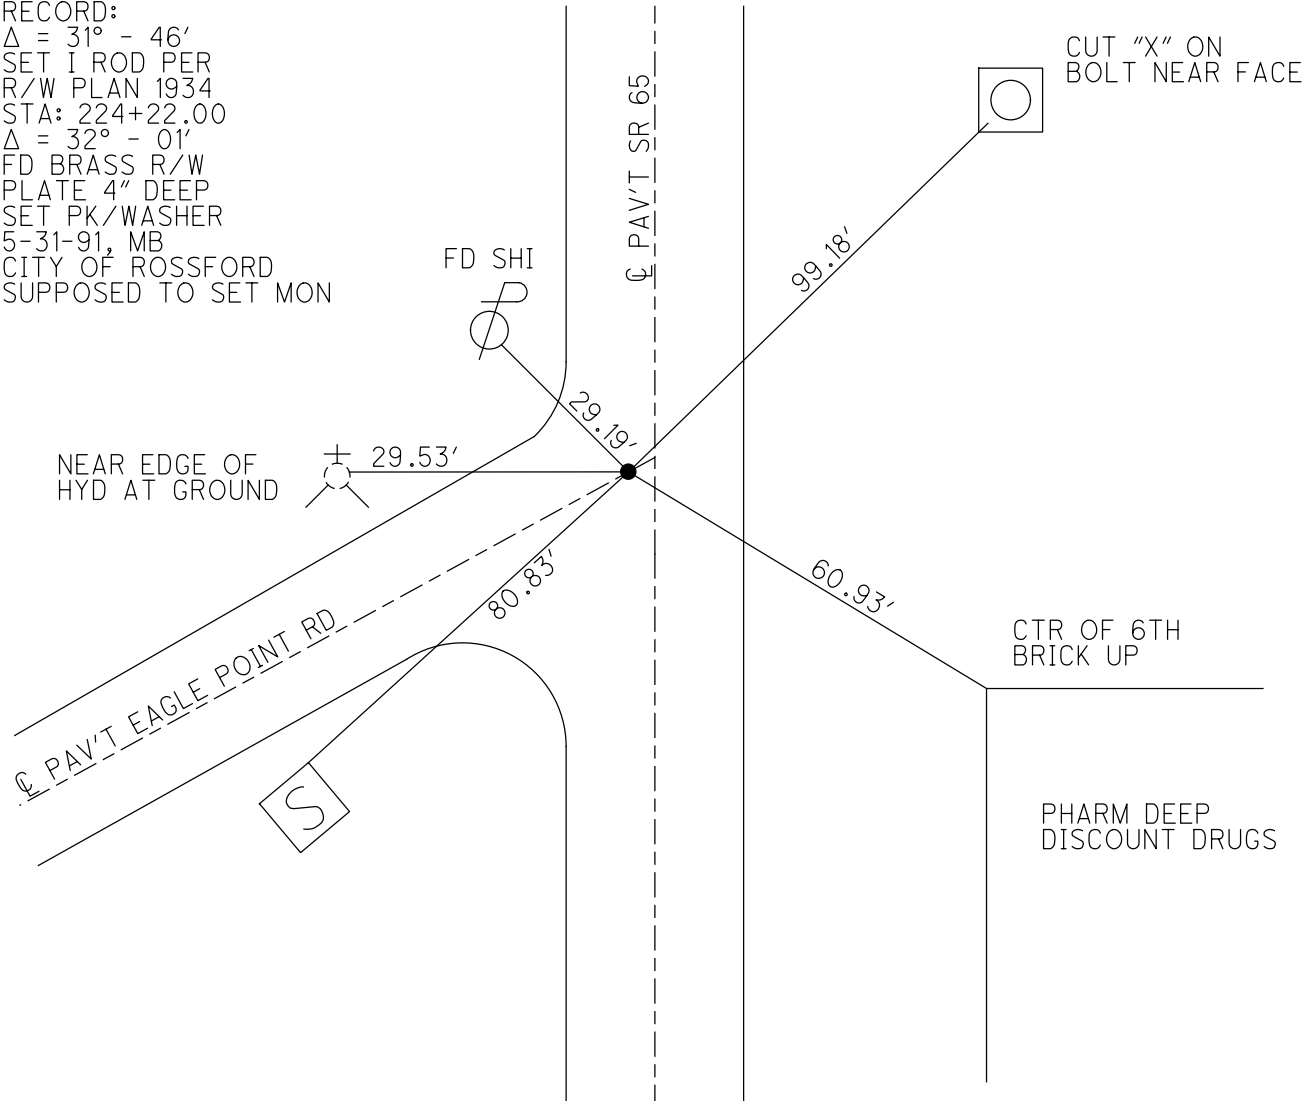

O.D.O.T. DISTRICT 2 SURVEY OFFICE

PERSONNEL

REFERENCE NO. 36

SHEET OF

NOTES BARNHISEL

H.C. Loehcke

R.C. HOFFMAN

DATE 4-24-91

WEATHER cloudy

TEMP. +58°

ROUTE 65

COUNTY Wood

TOWNSHIP Rossford

SECTION RT. 81

T 8 N R 11 E

TYPE MONUMENT BRASS R/W PLATE


ON SURFACE - BELOW 4"

LEFT - 0 PAV'T. - RIGHT 12.0

37.0 TO RT EDGE PAVEMENT (OR curb)

S.L.M. 1227+77

19	20	21
18	77	Sec. 23
76		

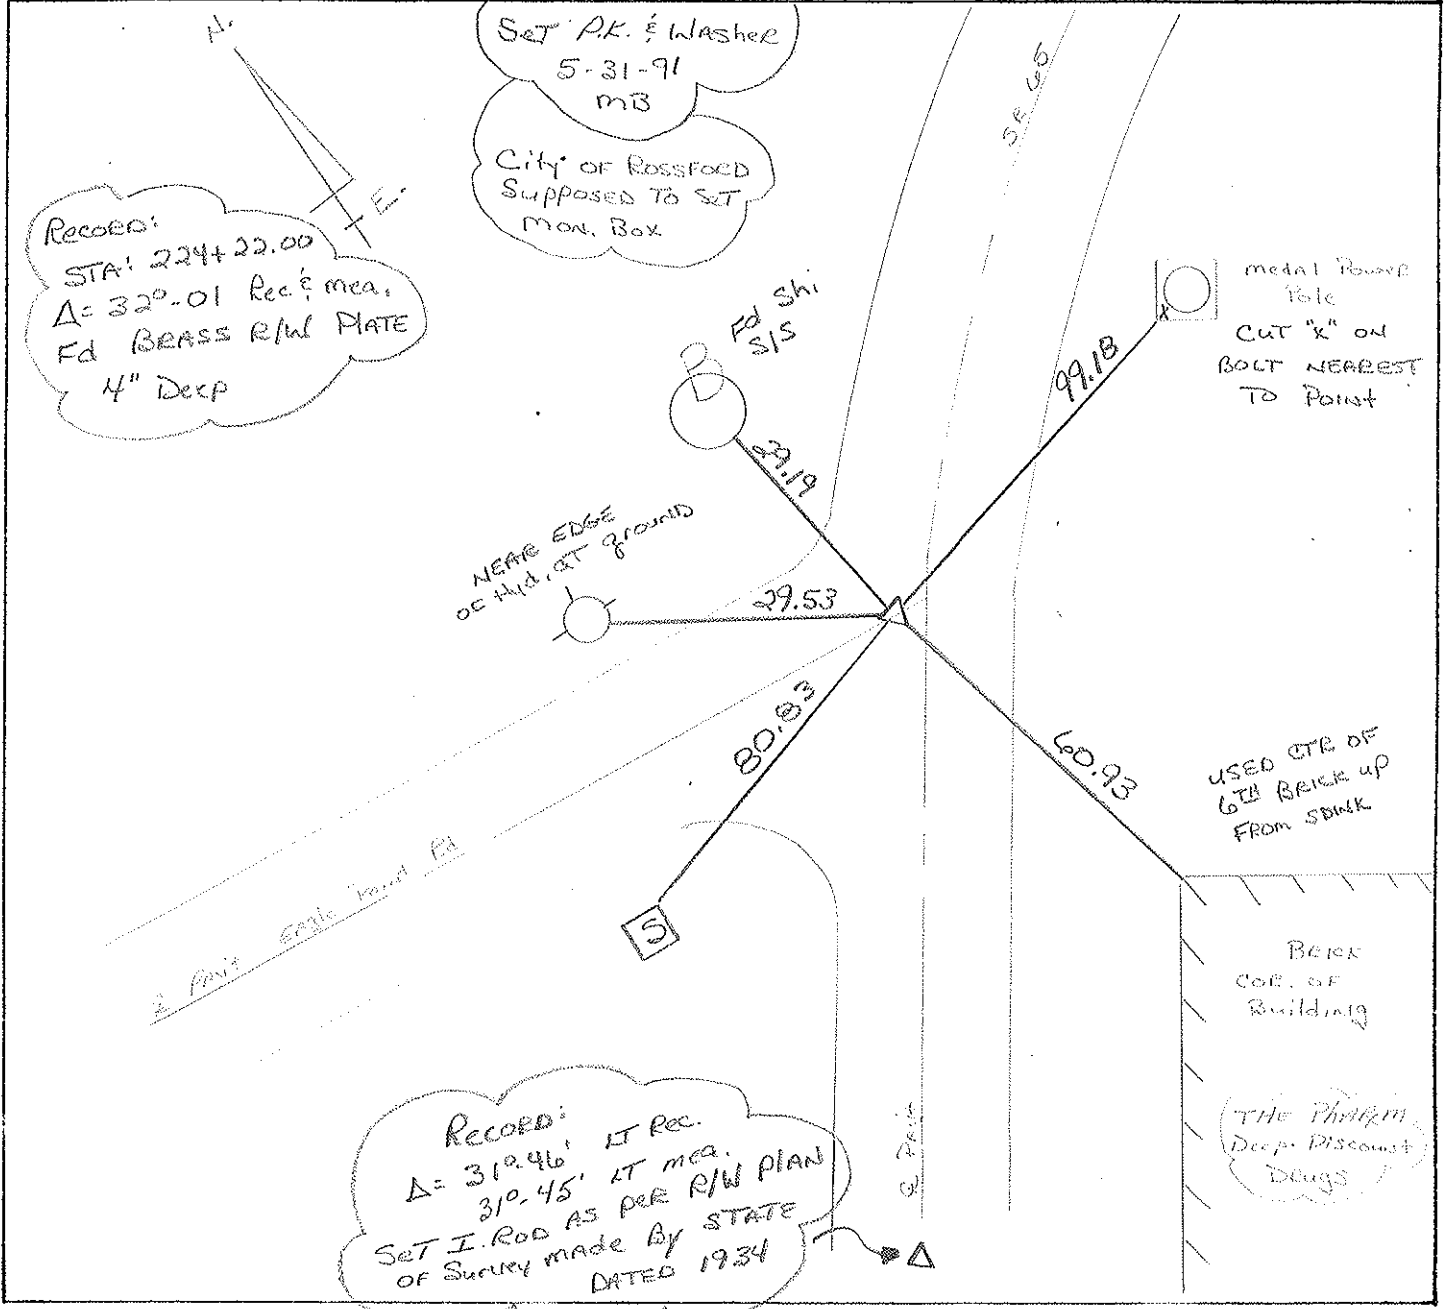

Records:
 STA: 224+22.00
 Δ = 320.01 Rec. & mea.
 Fd BRASS R/W PLATE
 4" Deep


Records:
 Δ = 310.46' LT Rec.
 310.45' RT mea.
 SET I. ROD AS PER R/W PLAN
 OF SURVEY MADE BY STATE
 DATED 1934

PERSONNEL TITLE PERSONNEL TITLE
 BURNSIDE _____
 BOWERS _____
 MEAD _____

COUNTY Wood DATE 9-9-76
 S. R. 65 WEATHER CLOUDY-RAIN
 SEC. ROSSFORD TEMP. +83°

DESCRIPTION LOCATE & CONTROL POINTS
 LEFT CENTER LINE RIGHT JOB NO.

36

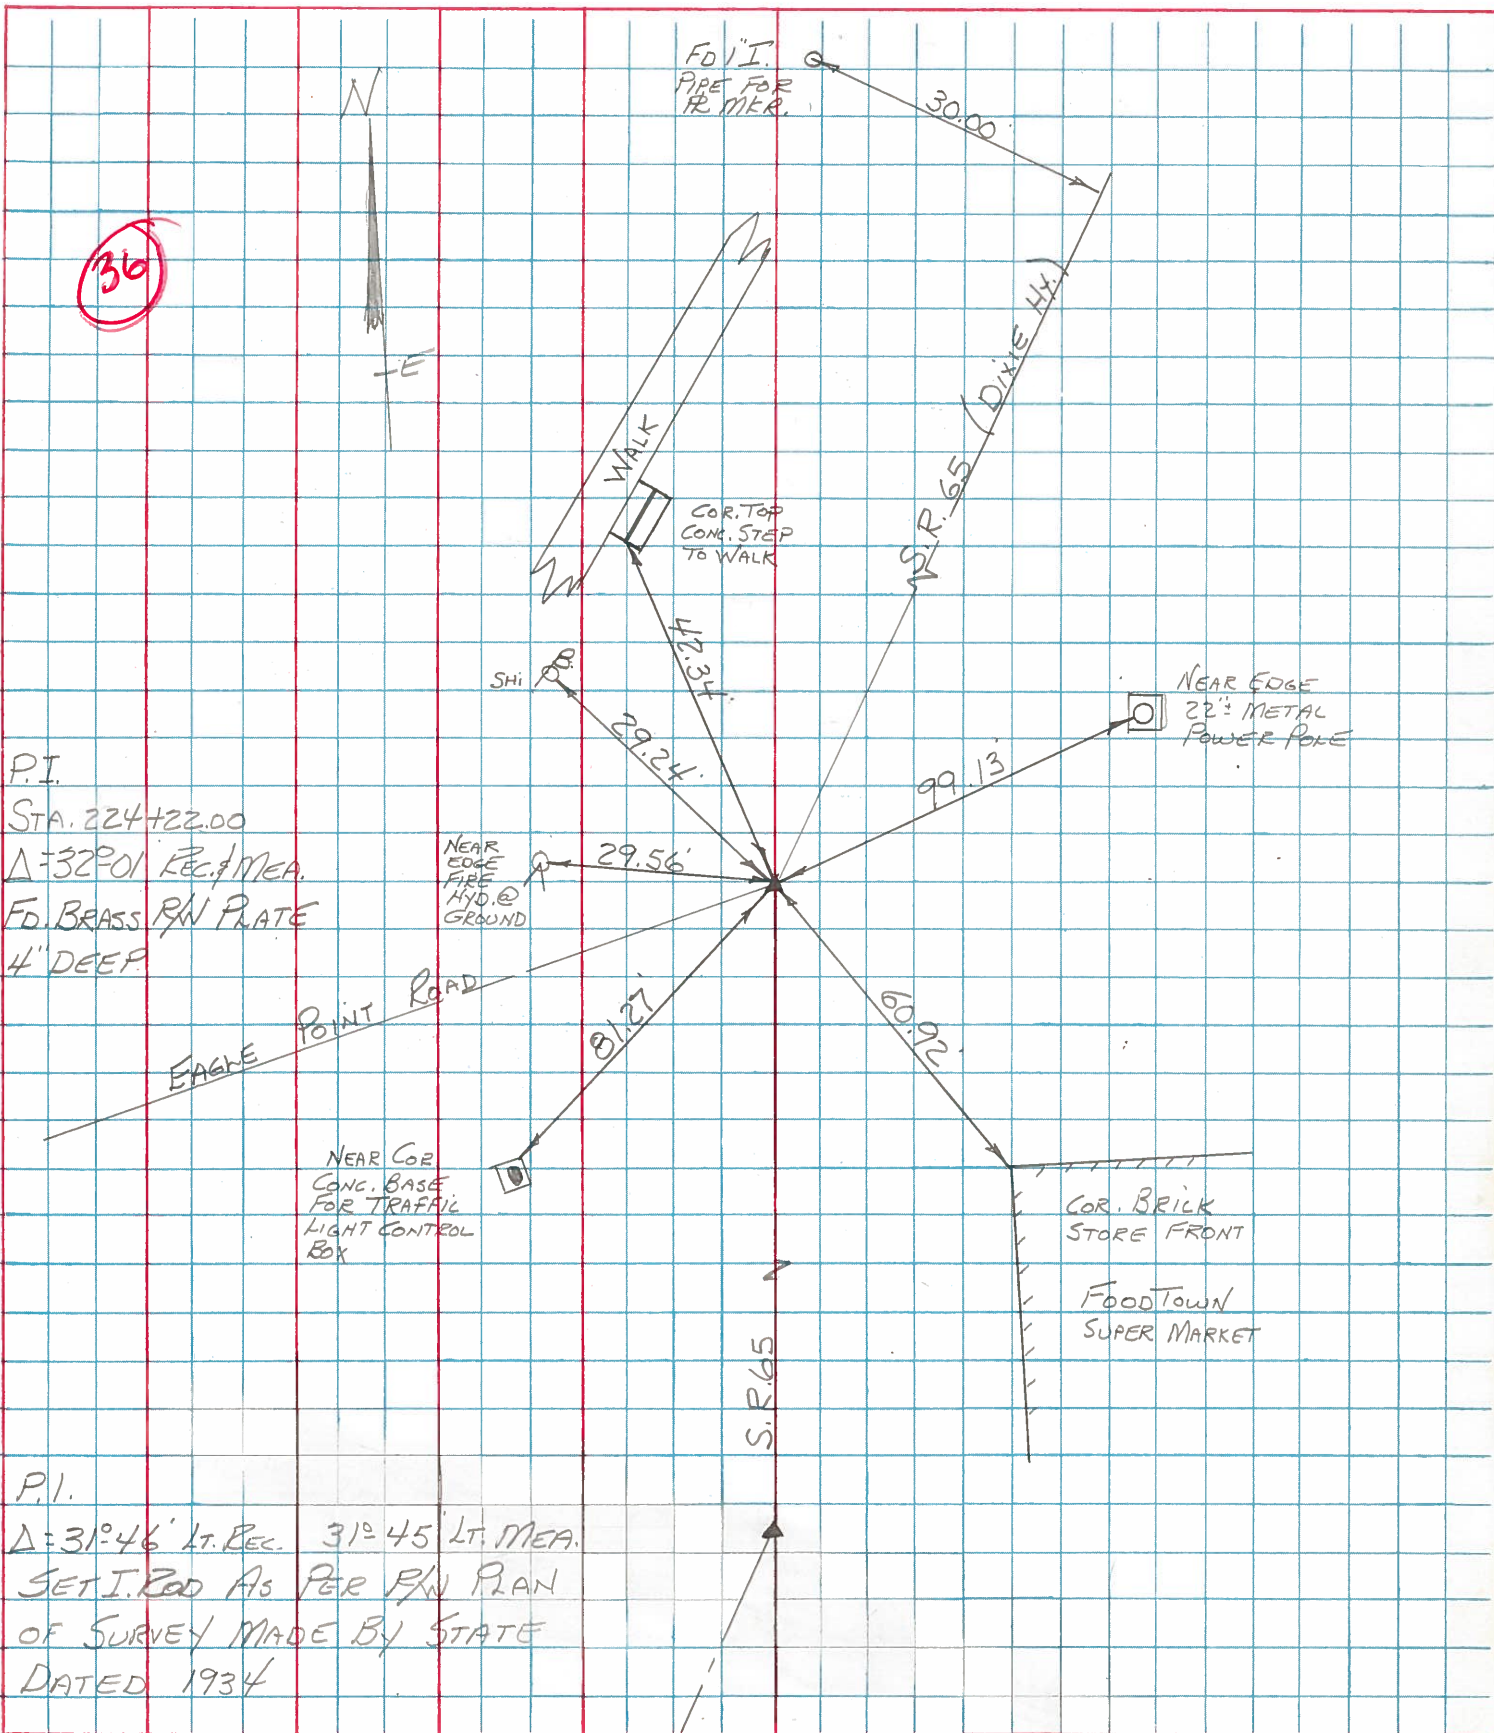

P.I.
 STA. 224+22.00
 $\Delta = 32^\circ 01'$ REC. & MEA.
 FD. BRASS RN PLATE
 4" DEEP.

P.I.
 $\Delta = 31^\circ 46'$ LT. REC. $31^\circ 45'$ LT. MEA.
 SET I. ROD AS PER RN PLAN
 OF SURVEY MADE BY STATE
 DATED 1934

PERSONNEL	TITLE	PERSONNEL	TITLE
Tomsia			
Granata			
Vanyo			
Jackson			

COUNTY Wood DATE Aug. 23, 1971
 S. R. # 65 WEATHER Fair
 SEC. _____ TEMP. 80°'s

DESCRIPTION Reference Mon. on S.R. # 65 JOB NO. _____

