

1-21-93

WLOO I-75 14.91 SOUTHBOUND

Job No. 623033

Bob:

P.A.

Lisa Liew Requested some PAVEMENT ELEVATIONS at the BRIDGE (WLOO-75-17.56).

Establish stations on the pavement (paint the stations) from the $\pm$ monuments. There is a fiberglass stake by the monuments at each end of the BRIDGE from a previous location project. Right Δ over to establish your stations. Lay out 25' stations on $\pm$ pavement & BOTTL Edge Lines, (SOUTHBOUND ONLY). Locate the approach SLAB by station & TAKE shots on each side of the joint. DRAW A DETAIL SKETCH to show the joints & the BRIDGE END DAMS. CARRY stations & shots ACROSS BRIDGE & 100' past the END of the approach SLABS.

Thank you

Steve

SCHEMATIC PLAN




4" Intermediate
Leveling

Leveling
8" (*)
on 1 3/4" Intermediate Curve (*)

T NO. 4
N DETAILS

*Need elevations
for approach*

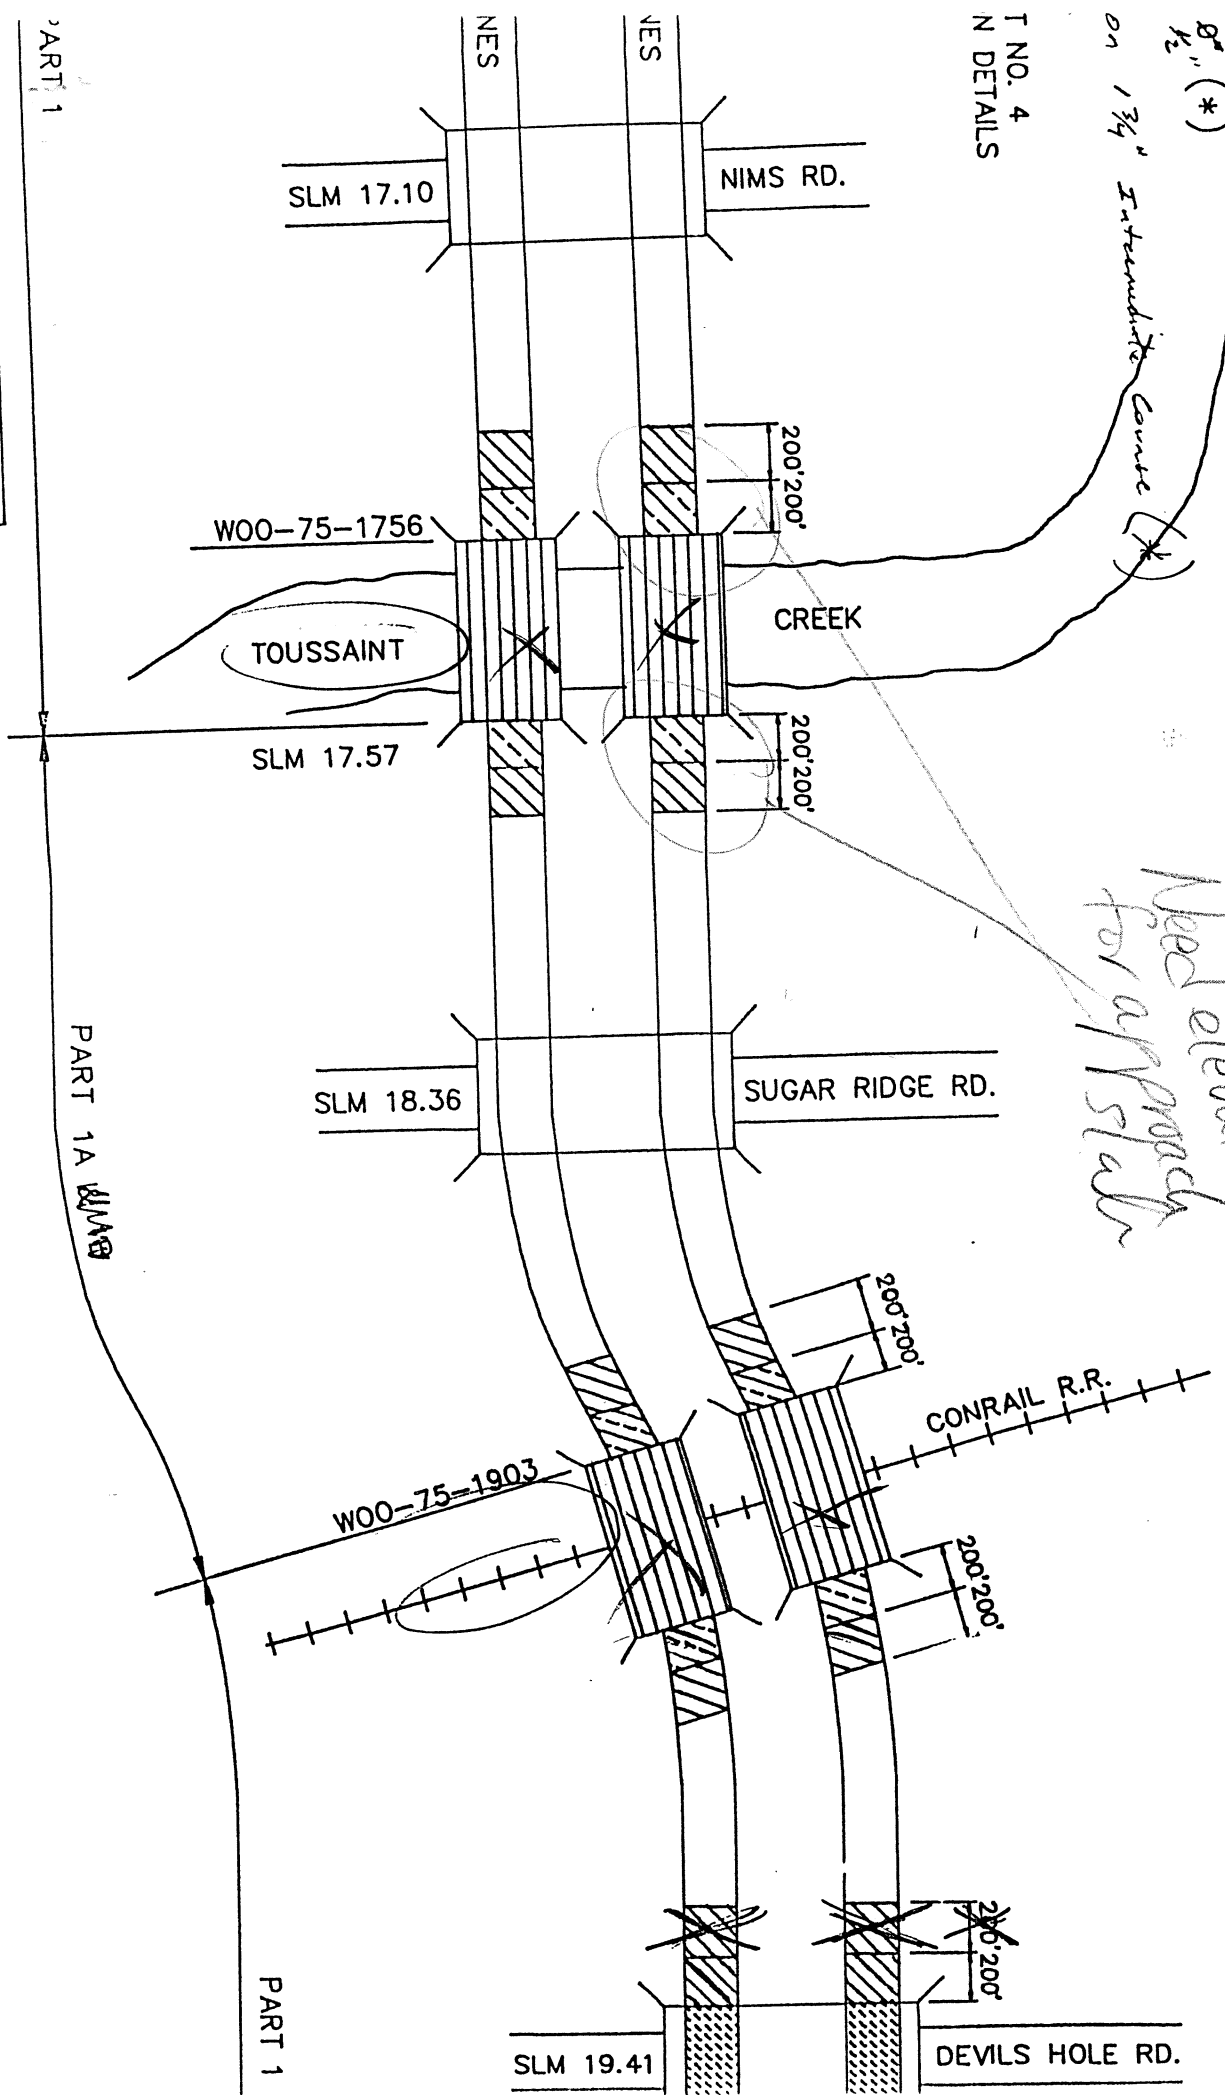

8608-1
0517