


PERSONNEL	TITLE	PERSONNEL	TITLE	COUNTY	DATE
VAN DUSEN		CURTIS		WOOD	1-27-93
BARNHISEL	□	SIMON		I-75	cloudy
GREEN				17.56	+29°

DESCRIPTION BRIDGE INFORMATION JOB NO. 623033

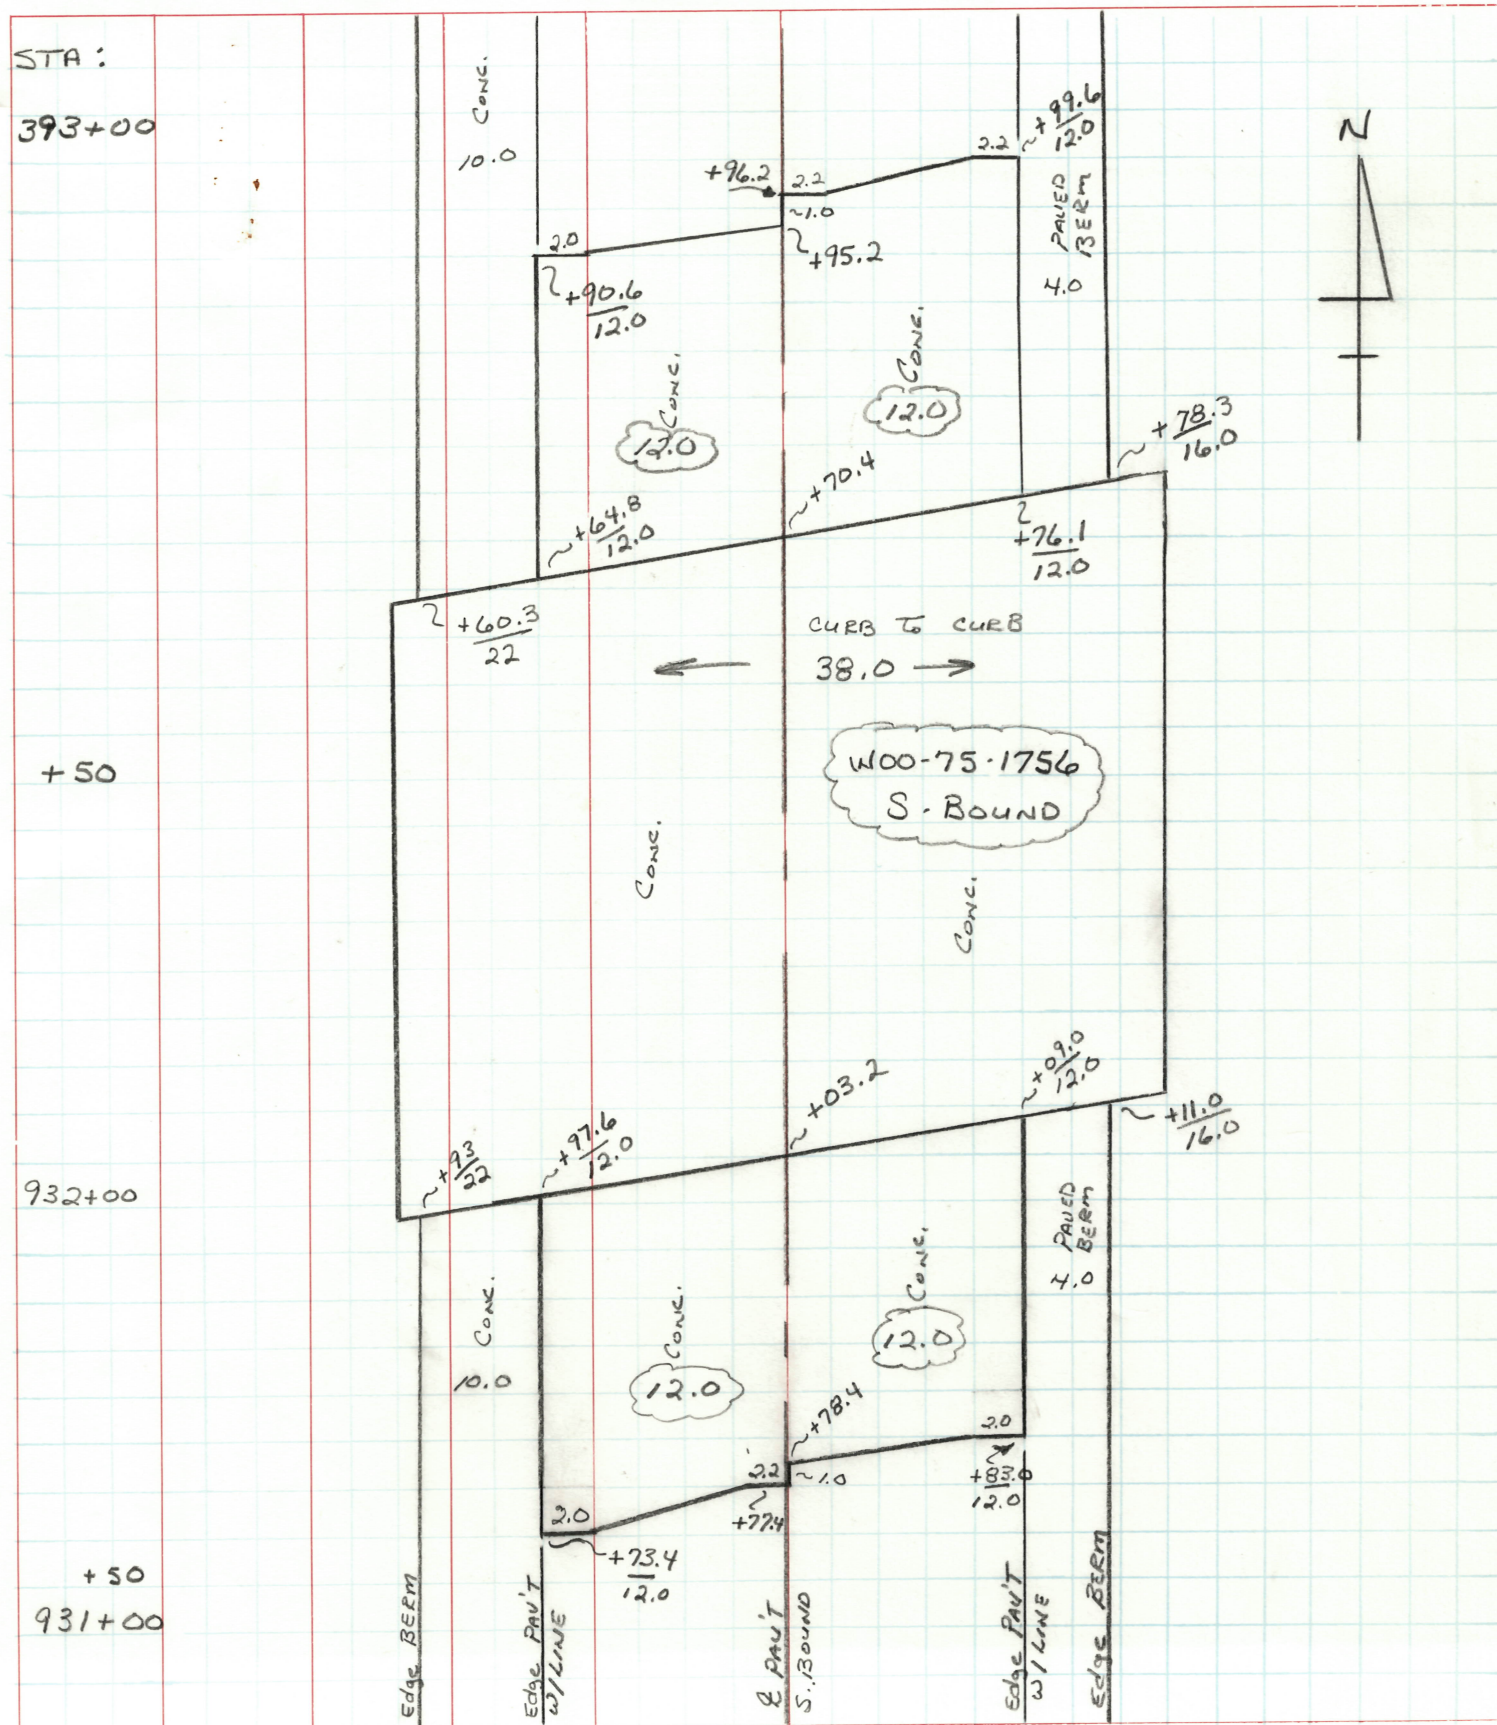

PERSONNEL	TITLE	PERSONNEL	TITLE	COUNTY	DATE
VAN DUSEN	DM	SIMON	Ø	WOOD	1-27-93
BARNHISEL				S. R. I-75	WEATHER CLOUDY
GREEN	TAPE			SEC. 17.56	TEMP. +27°F
CURTICE	T				

DESCRIPTION PAVEMENT X-SECTIONS STRUCTURE 17.56 JOB NO. 623033

STA.	BS	HI	FS	ELEV.	LEFT	CENTER LINE	RIGHT
SITE BM	4.13	675.27		671.14	934.93	23.8 LT.	
930+75			5.42 22 BERM	5.08 11.9 WL	4.83 0 E	4.99 11.9 YEL LINE	5.12 16 BERM
931+00			5.36 22	5.05 11.9 WL	4.80 0 E	4.95 11.9 YEL LINE	5.06 16 BERM
931+25			5.32	5.02 11.9 WL	4.73 0 E	4.89 11.9 YEL LINE	4.94 16
931+50			5.20	4.91 11.9 WL	4.61 0 E	4.84 11.9 YEL LINE	4.87 16
931+75			5.08	4.79 11.9 WL	4.61 0 E	4.81 11.9 YEL LINE	4.83 16
932+00			4.91	SEE SHEET 2			4.85 16
+25			4.85	4.70 11.9 WL	4.56 0 E	4.73 11.9 YEL LINE	4.80 16
+50			4.83	4.68 11.9 WL	4.51 0 E	4.68 11.9 YEL LINE	4.77 16
+75			4.82	4.61 11.9 WL	SEE SHEET 2		
933+00			4.82	4.58 11.9 WL	4.39 0 E	4.53 11.9 YEL LINE	4.57 16
+25			4.83	4.53 11.9 WL	4.35 0 E	4.52 11.9 YEL LINE	4.55

W. SOUTH
BOUND
LANE

PERSONNEL	TITLE	PERSONNEL	TITLE	COUNTY	DATE
VAN DUSEN	M	SIMON	Ø	WOOD	1-27-93
BARNHISEL	M			S.R. I-75	WEATHER CLOUDY
GREEN	A			SEC. 17.56	TEMP. +29 F
CURTIS	T				

DESCRIPTION CONTROL & BENCH MARK JOB NO. 623033

LEFT CENTER LINE RIGHT

