

O.D.O.T. DISTRICT 2 SURVEY OFFICE

PERSONNEL

REFERENCE NO. _____

SHEET 4 OF 9

NOTES VAN DUSEN

H.C. BARNHISEL

R.C. KUSZ

DATE 9-3-91

WEATHER CLOUDY

TEMP. +65° F

ROUTE I-75

COUNTY WOOD

TOWNSHIP HENRY

SECTION 25

T3 N R 10 E



TYPE MONUMENT MON. BOX

ON SURFACE - BELOW YES

LEFT- & PAV'T. - RIGHT YES

___ TO ___ EDGE PAVEMENT

S.L.M. PLAN 5 TH. 106+00.65

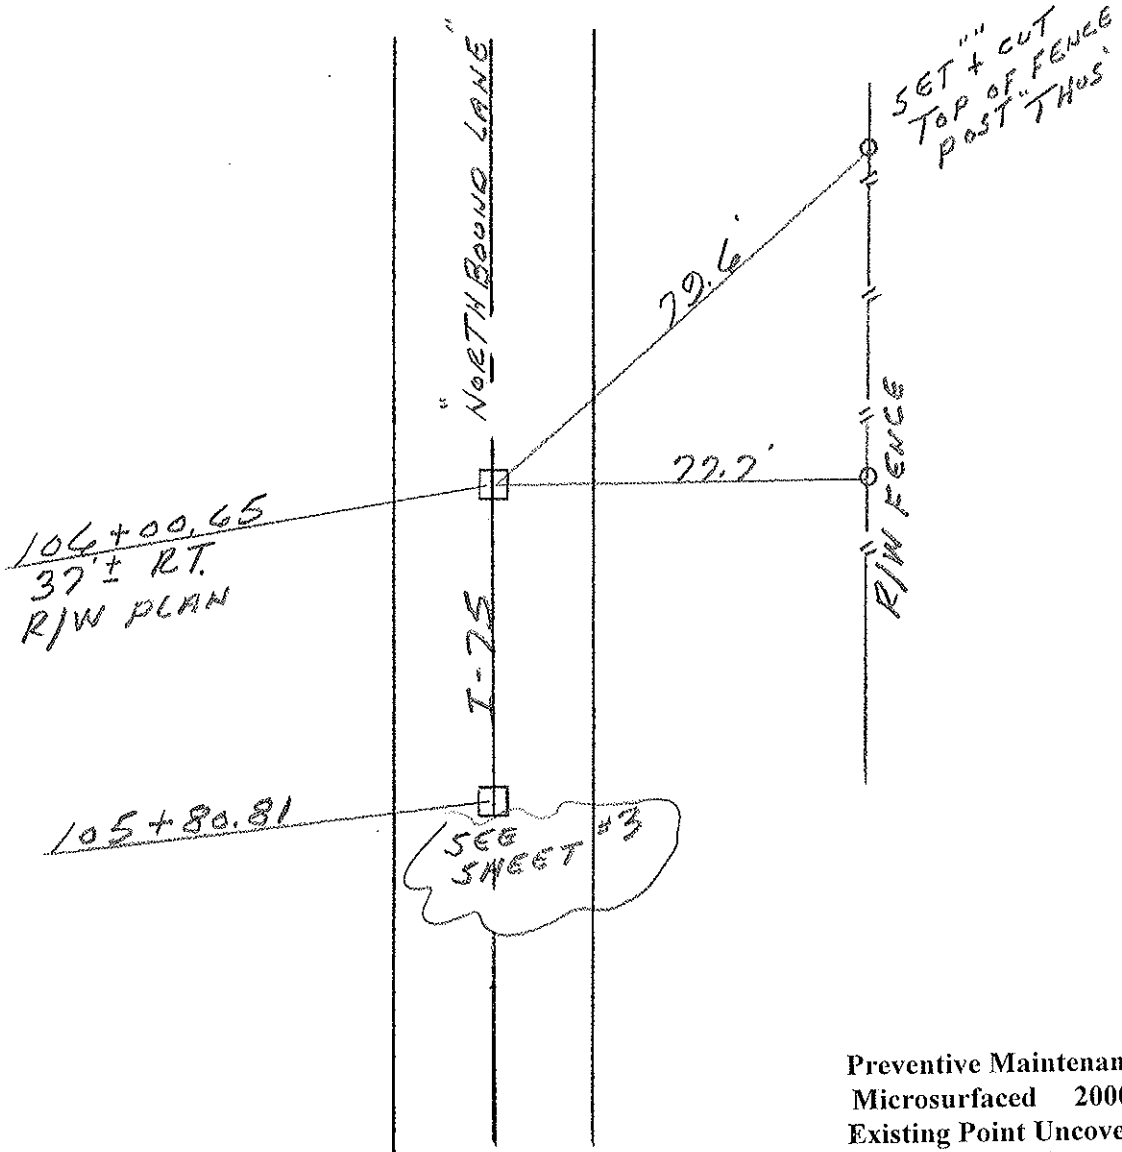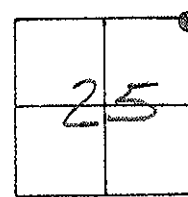

Preventive Maintenance
Microsurfaced 2000
Existing Point Uncovered
Date 01-85-01