

O.D.O.T. DISTRICT 2 SURVEY OFFICE

PERSONNEL

REFERENCE NO. _____

SHEET 1 OF 9

NOTES VAN DUSEN

H.C. BARNHISEL

R.C. KUSZ

DATE 2-3-91

WEATHER CLOUDY

TEMP. +65°F

ROUTE I-75

COUNTY WOOD

TOWNSHIP BLOOM

SECTION 30

T.3 N. R.11 E



TYPE MONUMENT MON. BOX

ON SURFACE - ~~BELOW~~ YES

LEFT - & PAV'T. - RIGHT YES

TO _____ EDGE PAVEMENT

S.L.M. PLAN STA. 79+33.22

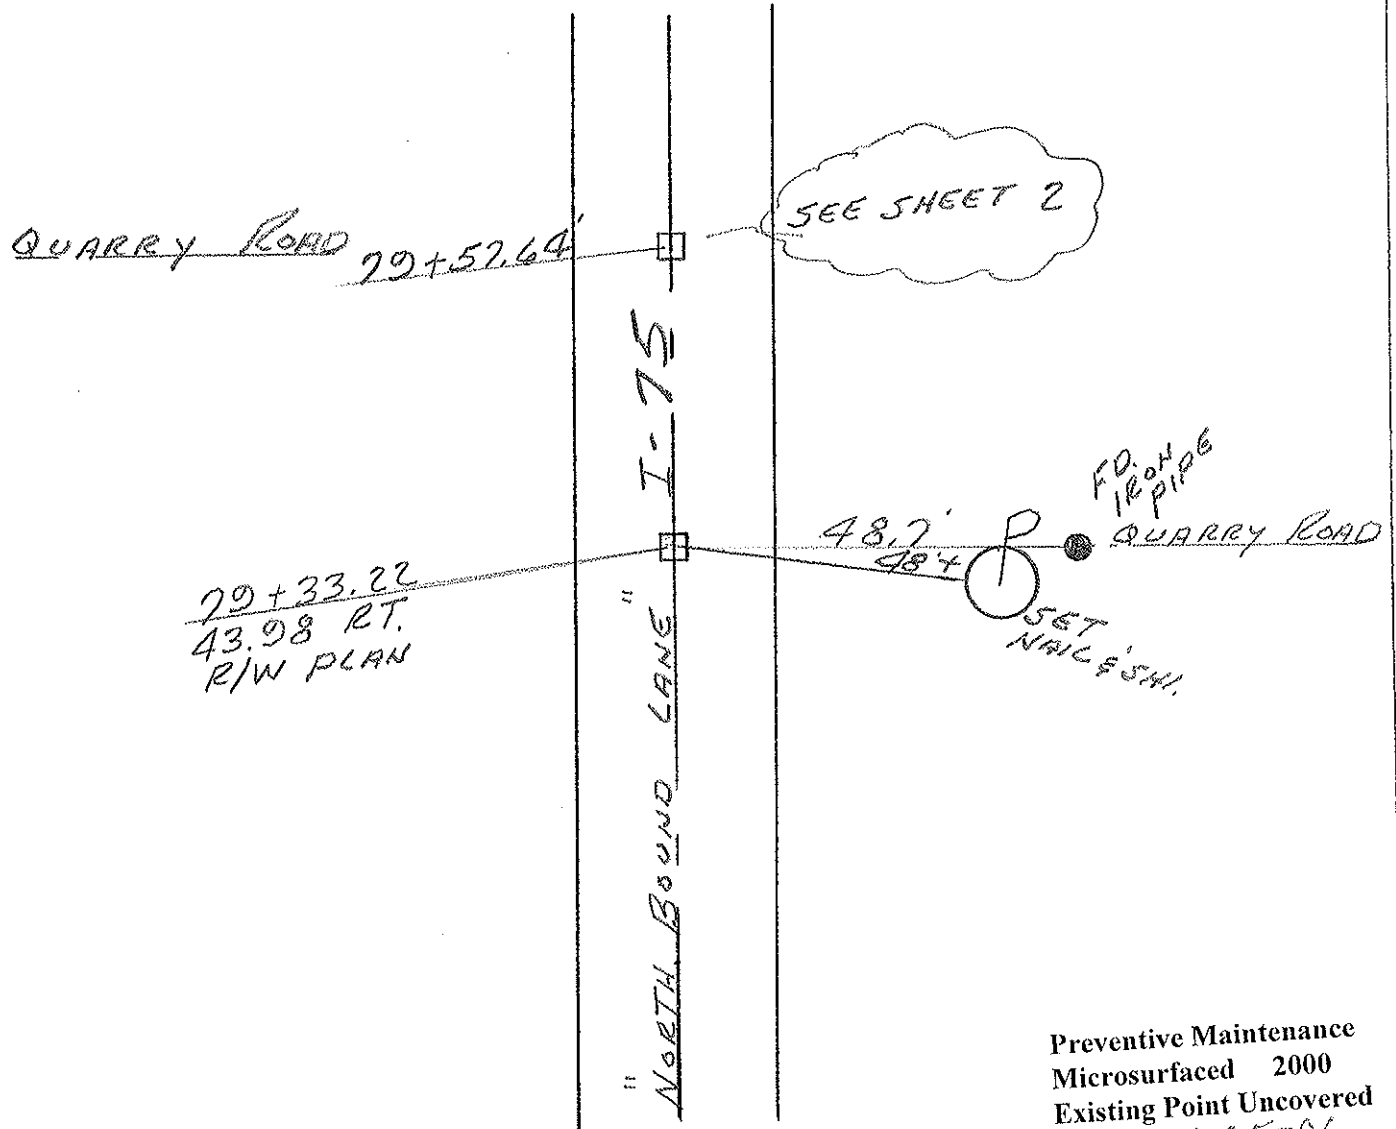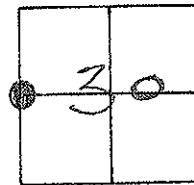

Preventive Maintenance
Microsurfaced 2000
Existing Point Uncovered
Date 01-05-01