

PERSONNEL
Stone
Deno
Michael
Cortis
Brannon

TITLE
Notes
H.C.
A
P.C.
M


COUNTY Wood
 S.R. 105
 SECTION 22
 TWP CENTER
 RANGE 11-E
 TOWN 5-N

SHEET NO. 1-A
 DATE 29 Aug 72
 WEATHER Warm
 TEMP. 79°
 JOB NO. _____

SE 1/4


E Sec. 22
 Fd. 3/4" I. Pipe

E 1/4 Cor. Sec. 22
 Fd. 3/4" I. Pipe

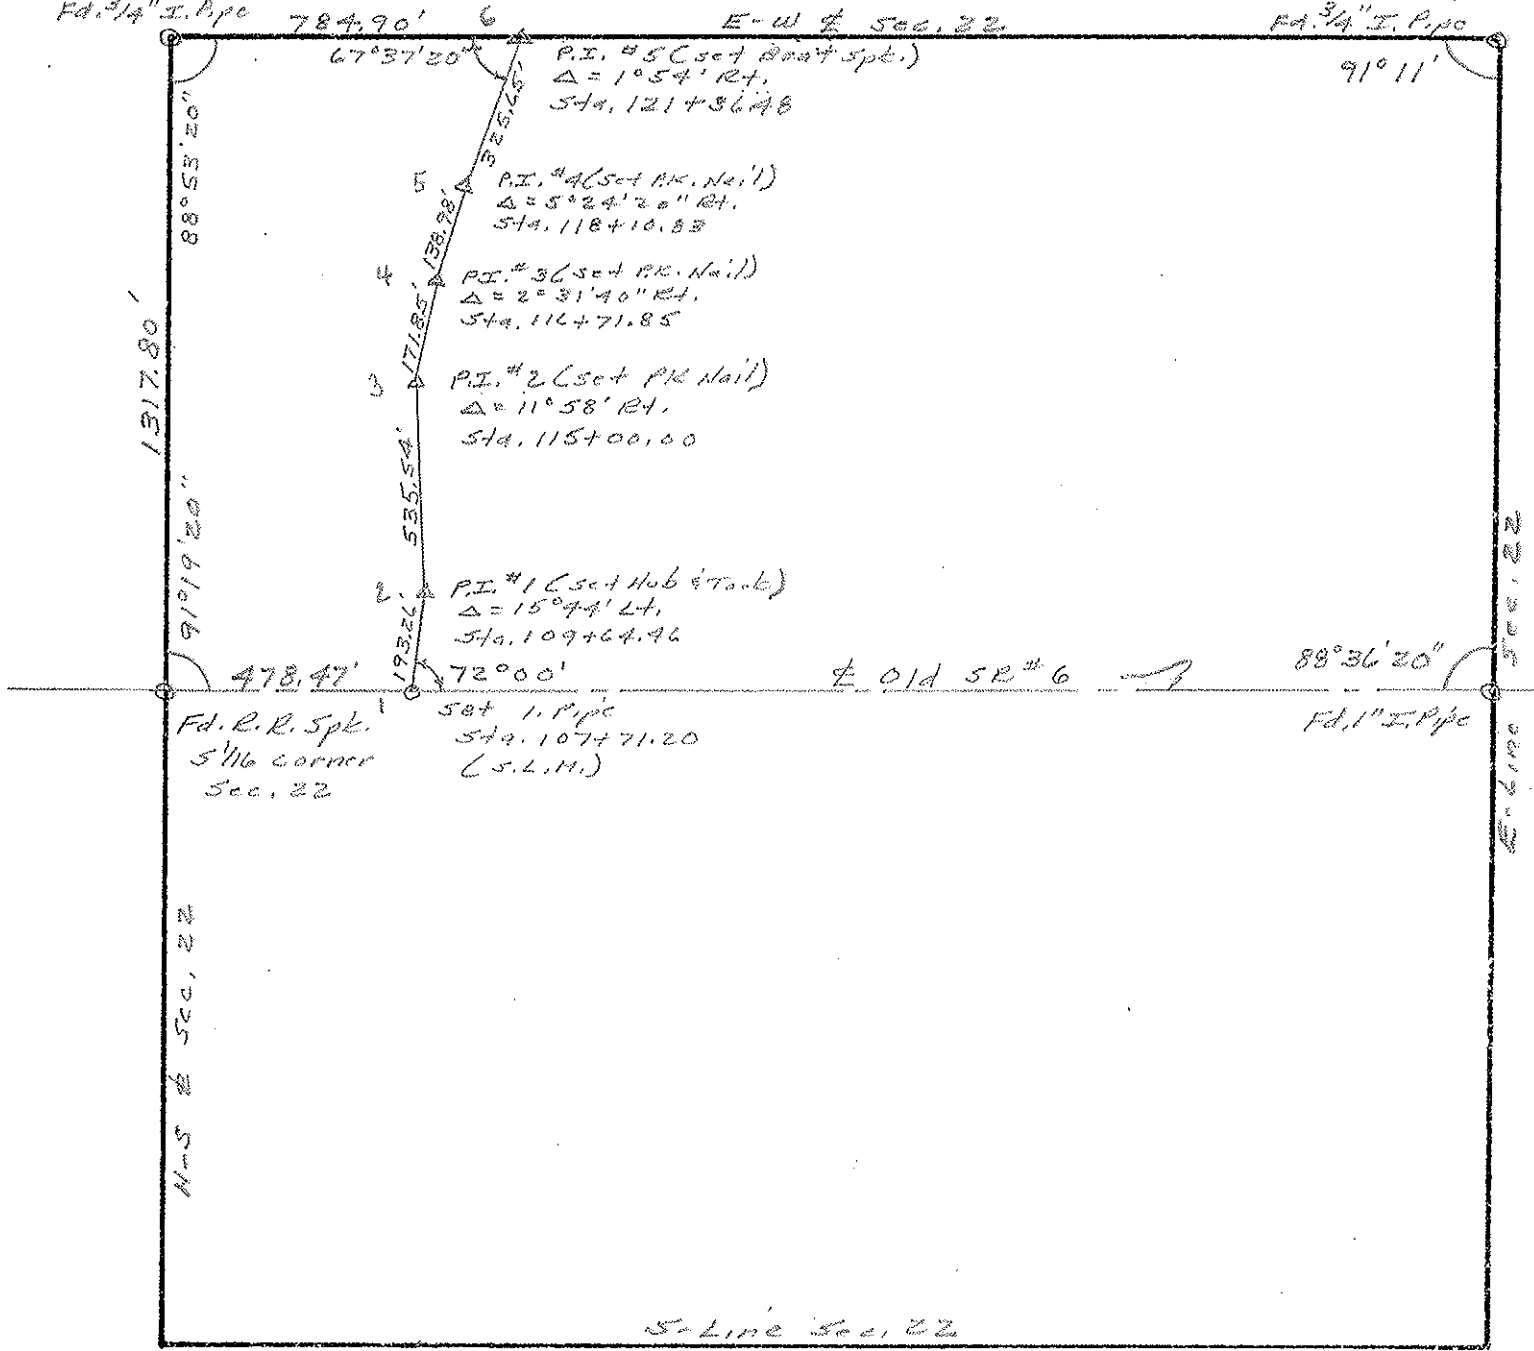

S-Line Sec. 22

PERSONNEL	TITLE	COUNTY	SHEET NO.
Stone	Notes	Wood	2-A
Michalak	" "	S.R. 105	DATE 29 Aug. 72
Danno	H.C.	SECTION 22	WEATHER clear
Curtis	P.E.	TWP Center	TEMP. 80°
Brewer	RA	RANGE 11-E	JOB NO.
		TOWN 5-N	

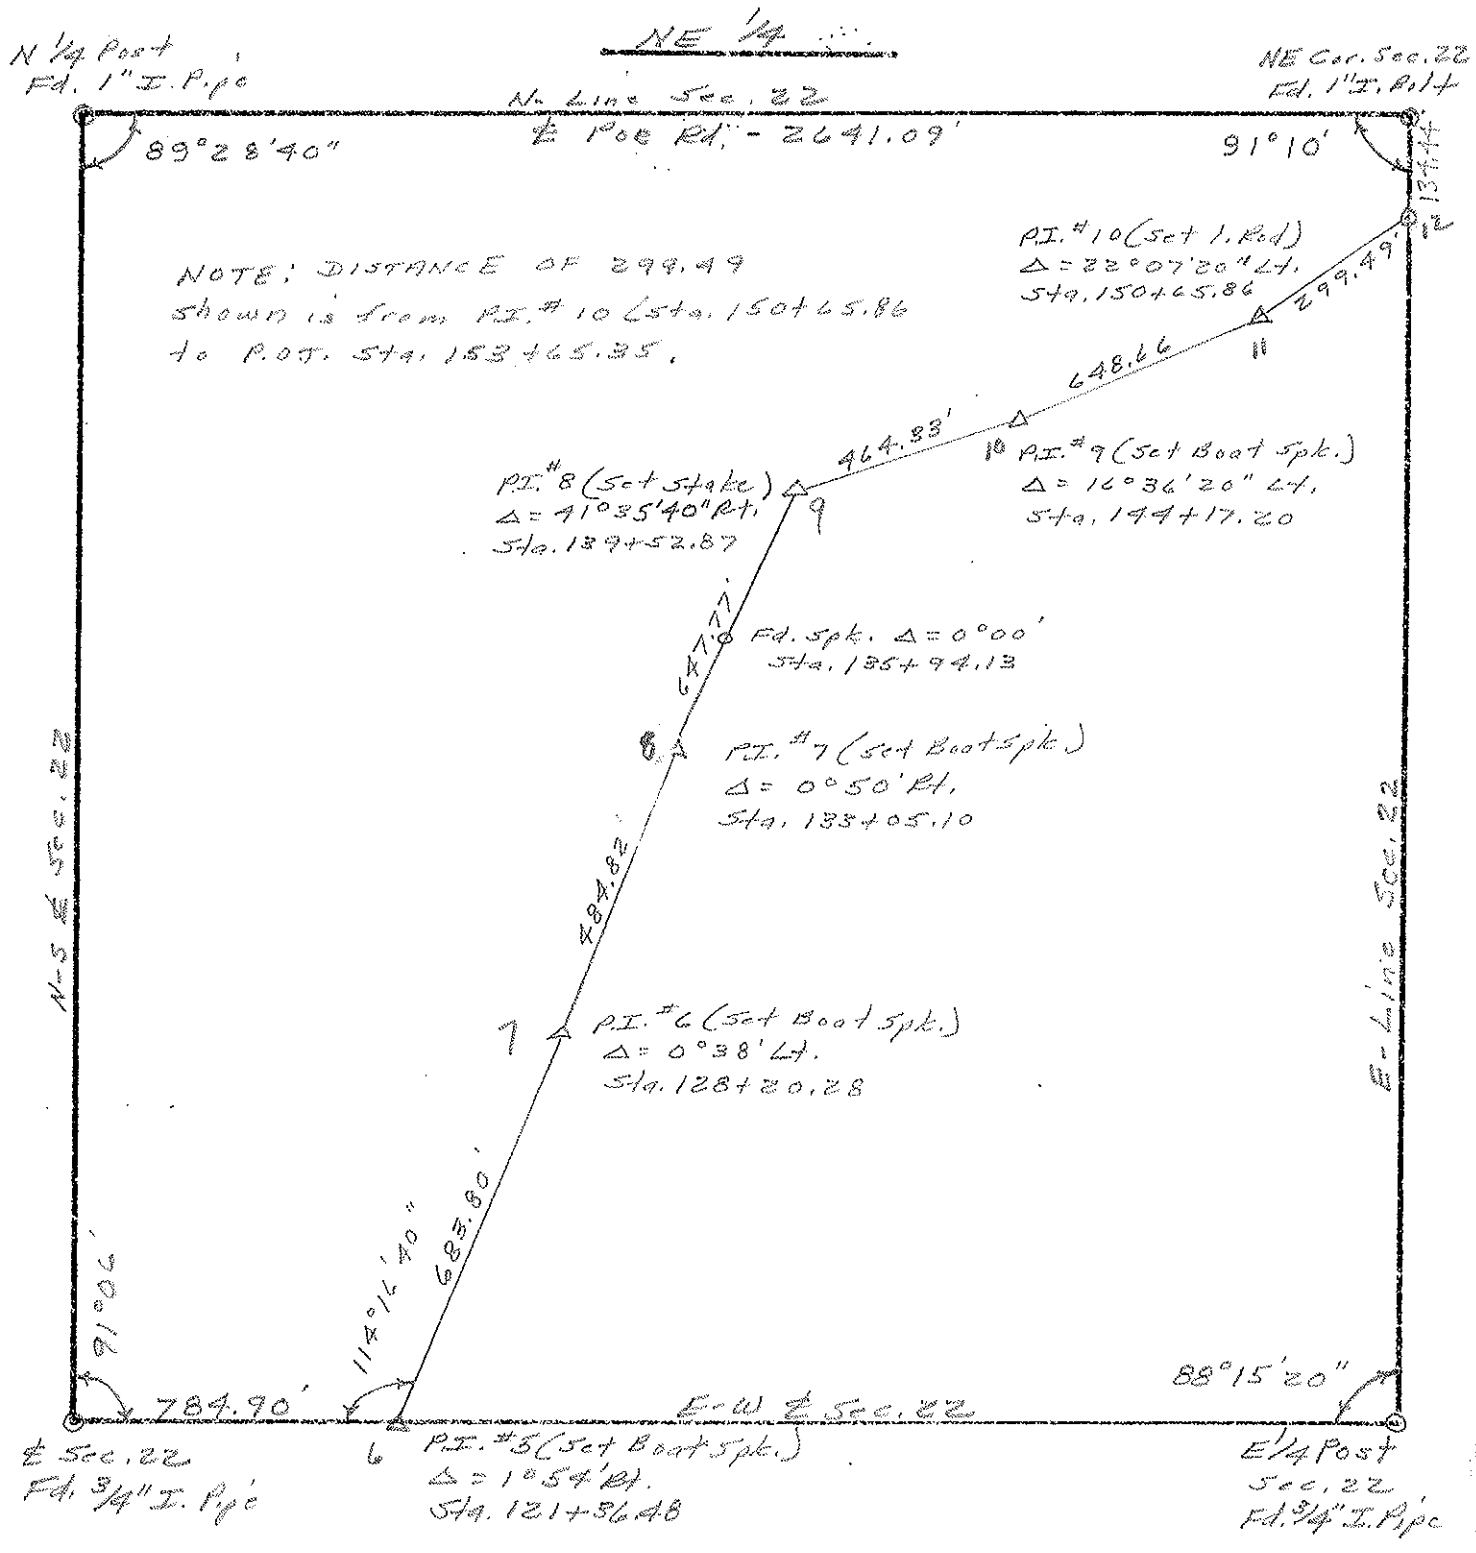


PERSONNEL	TITLE
Stone	Notes
Draco	H.E.
Curtis	RE
Michalak	A

COUNTY Wood SHEET NO. 3-A
 S.R. # 105 DATE 22 Sept. 72
 SECTION 23 WEATHER cool
 TWP center TEMP. 60°
 RANGE 11-E JOB NO.
 TOWN 5-N

Fd. 1" Bolt
 NE Cor. Sec 22 =
 NW Cor. Sec. 23

NW 1/4
 S-Line Sec 19

N 1/4 Post Sec. 23
 Fd. Stone

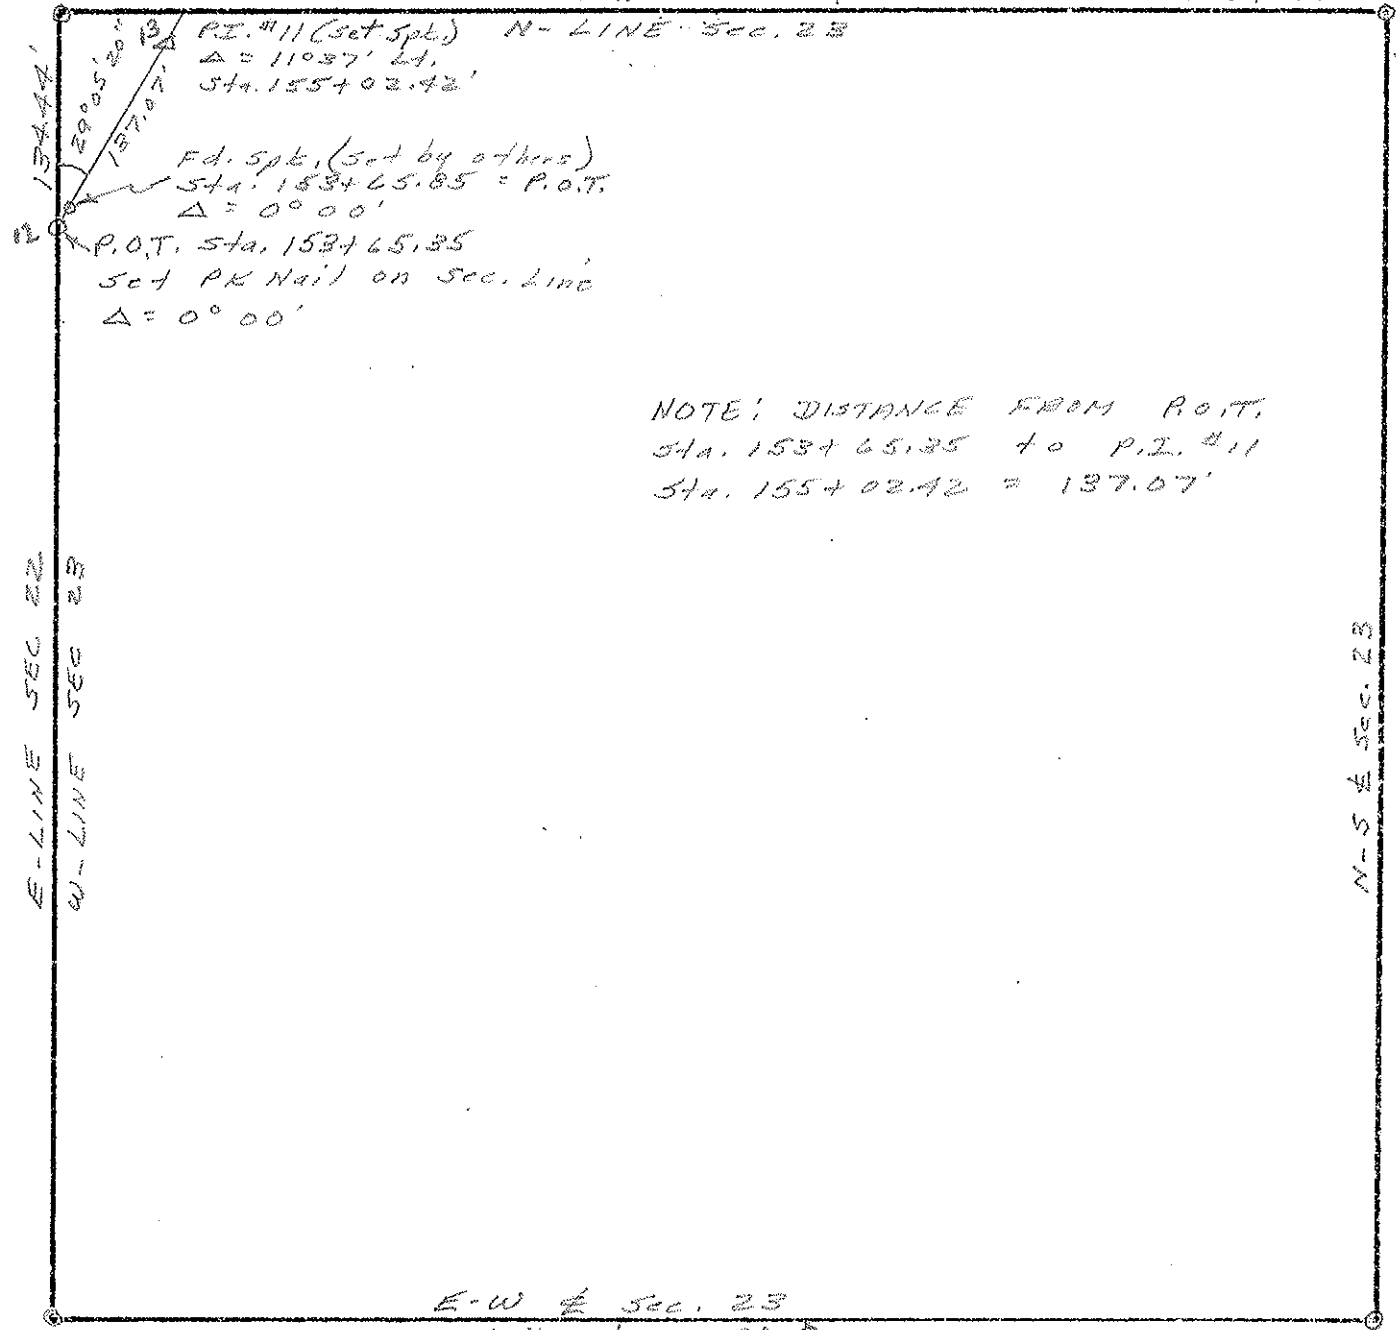

W 1/4 Post Sec. 23
 Fd. 3/4" I. Pipe


E-W SEC 23
 E Housekeeper Rd. S

E Sec. 23
 Fd. 1" I. Pin

PERSONNEL	TITLE
Stone	Notes
Mihalak	T
Denno	H.C.
Curtis	R.C.


COUNTY	Wood	SHEET NO.	7-A
S.R.	#105	DATE	17 Oct, 72
SECTION	14	WEATHER	Cool
TWP	WEBSTER	TEMP.	39°
RANGE	11-E	JOB NO.	
TOWN	5-N		

SW 1/4

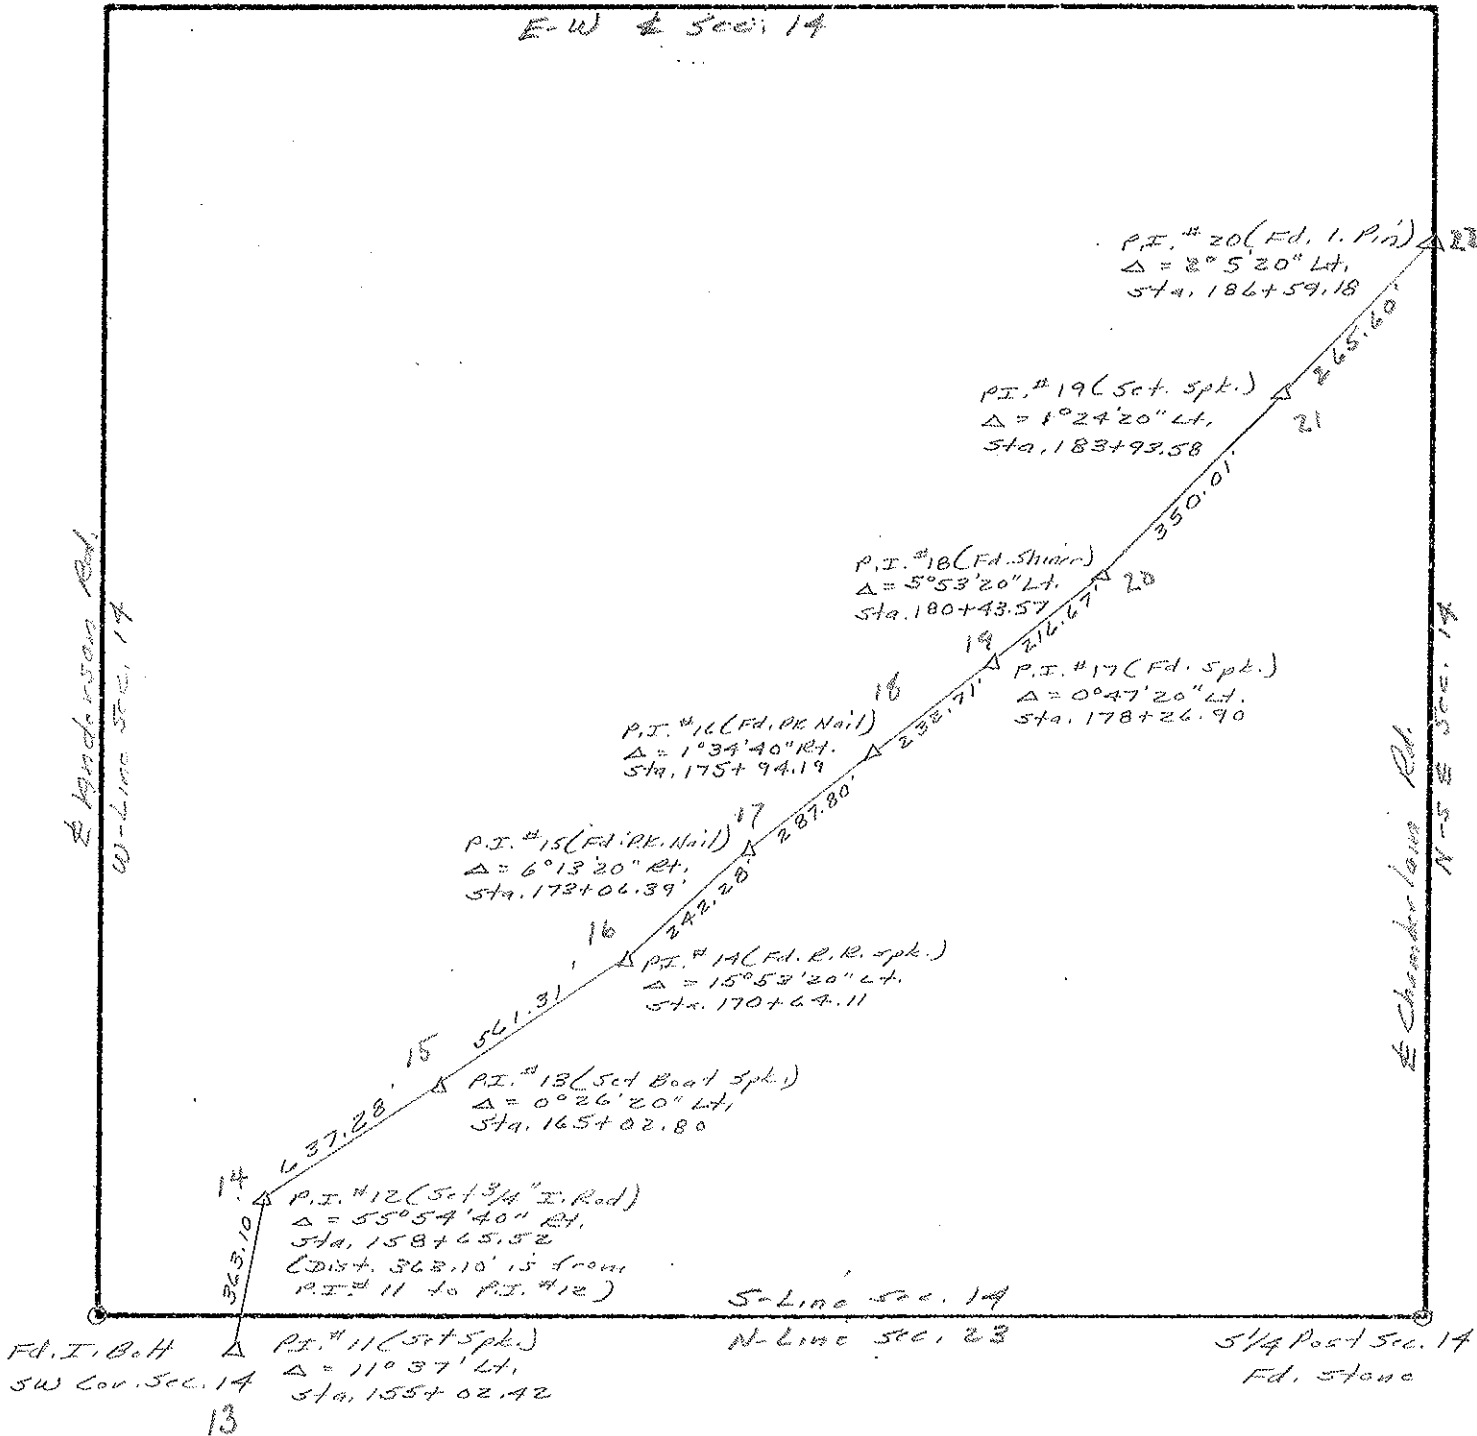

PERSONNEL	TITLE
<u>I. Stone</u>	<u>Notes</u>
<u>W. Deaga</u>	<u>H.C.</u>
<u>R. Michalok</u>	<u>T</u>
<u>D. Curtis</u>	<u>R.C.</u>

COUNTY Wood SHEET NO. 5-A
 S.R. 105 DATE 30 Oct. 72
 SECTION 14 WEATHER Cool
 TWP WEBSTER TEMP. 37°
 RANGE 11-E JOB NO. _____
 TOWN 5-N

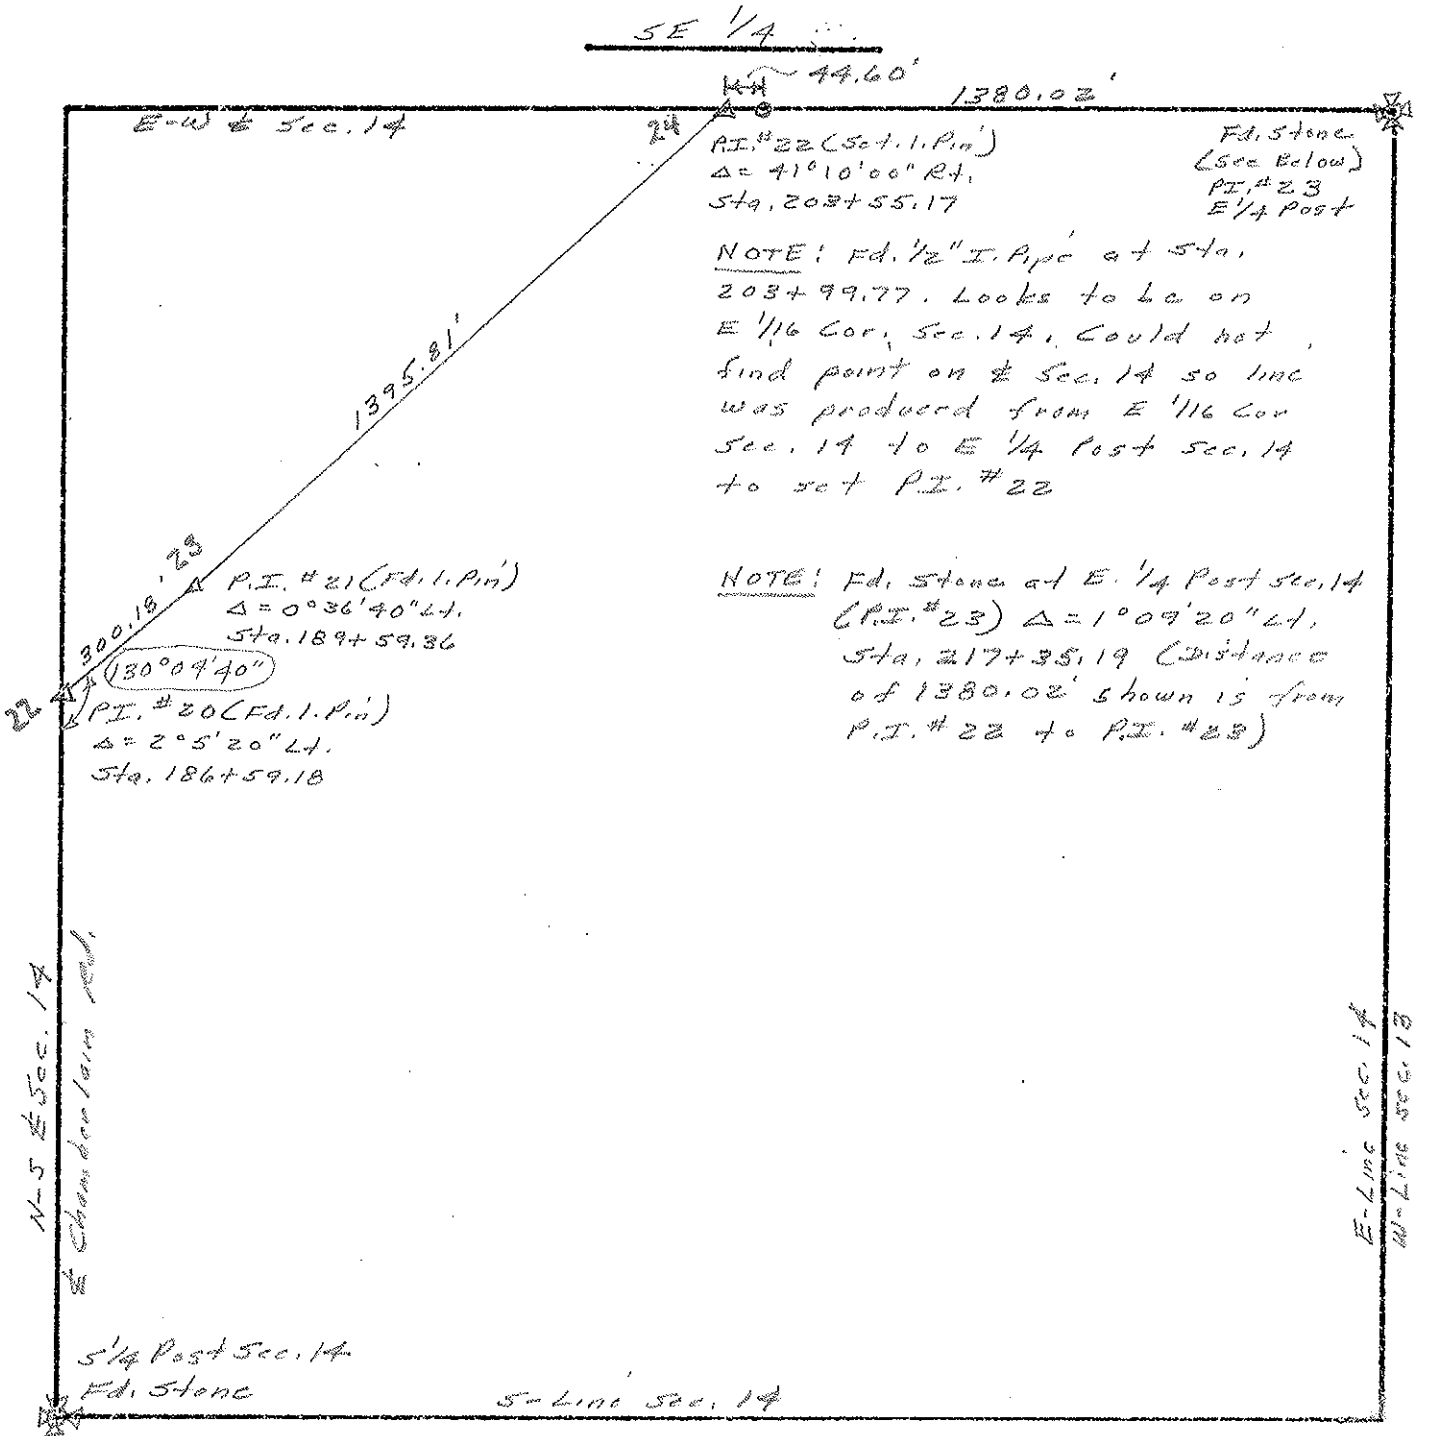


PERSONNEL
I. Stone
W. Deppa
R. Michalak
D. Curtis

TITLE
Notes
H.C.
T.
R.C.

COUNTY Wood
 S.R. 105
 SECTION 13
 TWP WEBSTER
 RANGE 11-E
 TOWN 5-N

SHEET NO. 6-A
 DATE 30 Oct, 78
 WEATHER Cool
 TEMP. 58°
 JOB NO. _____

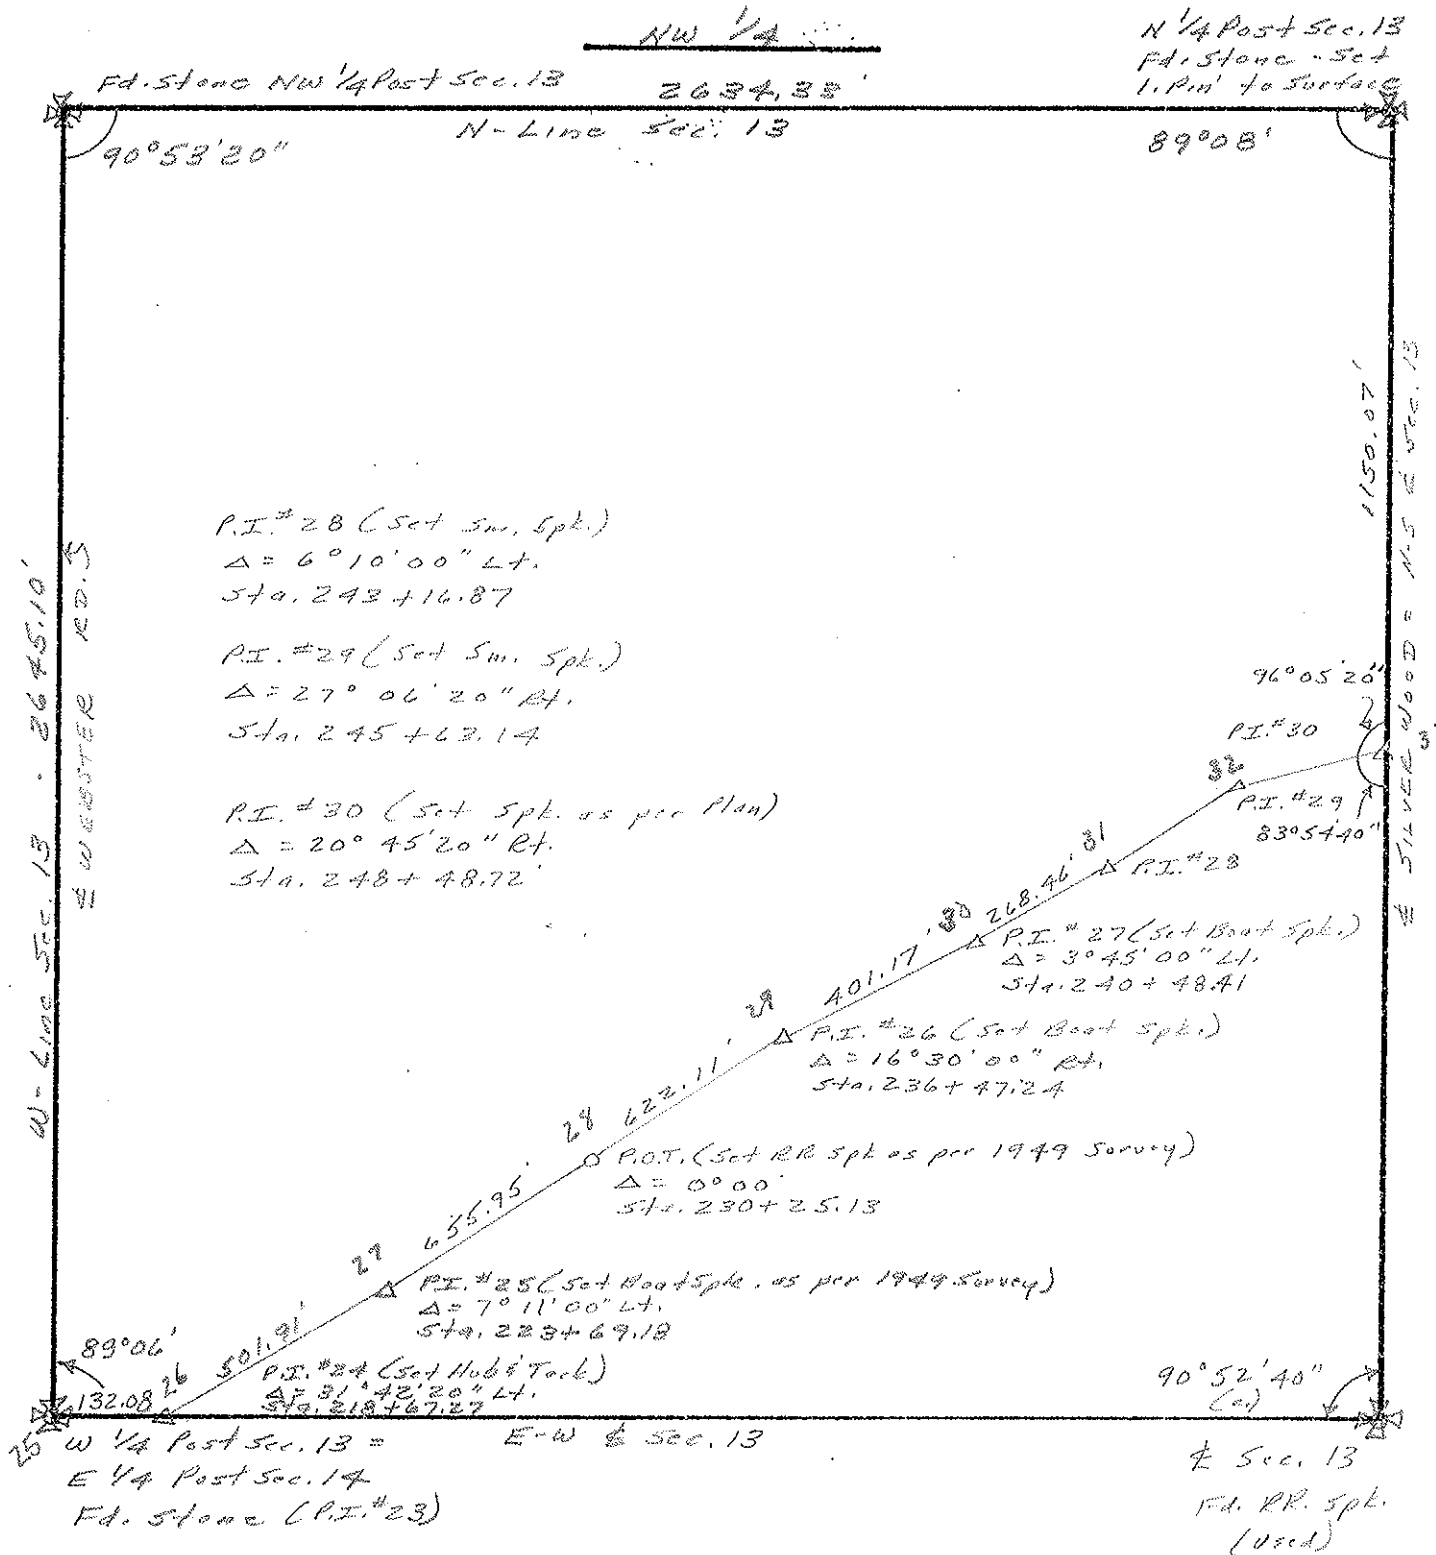


PERSONNEL	TITLE	COUNTY <u>Wood</u>	SHEET NO. <u>7-A</u>
<u>I. Stone</u>	_____	S.R. <u># 105</u>	DATE <u>10 Sept. 73</u>
<u>R. Michalak</u>	_____	SECTION <u>13</u>	WEATHER <u>Fair</u>
<u>W. Dwyer</u>	_____	TWP <u>Webster</u>	TEMP. <u>72°</u>
<u>D. Curtis</u>	_____	RANGE <u>11-E</u>	JOB NO. _____
_____	_____	TOWN <u>5-N</u>	

N 1/4 Post Sec 13
 Fd Stone - Set 1. Pins to surface

NE 1/4

NE Cor. Sec. 13

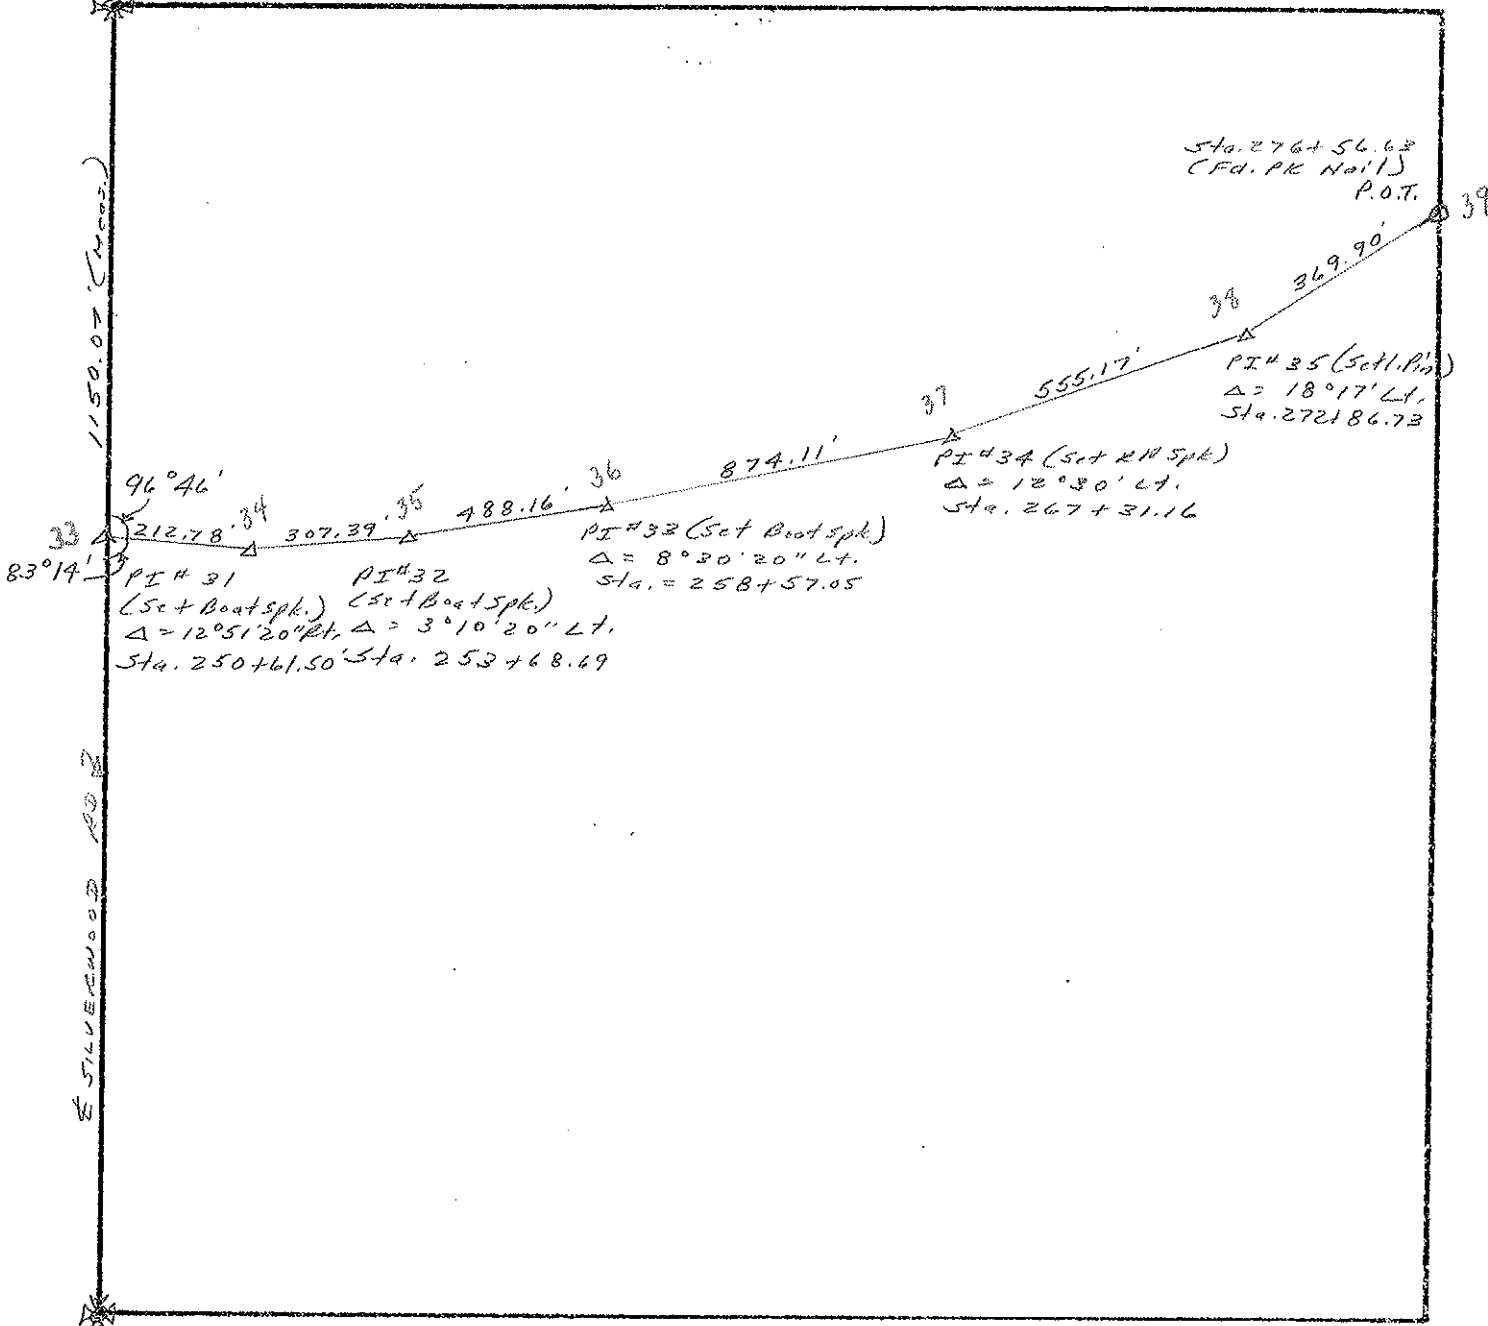

E Sec. 13
 Fd. RR. Spk.
 (Used)

E 1/4 Post
 Sec. 13


PERSONNEL	TITLE
<u>I. Stone</u>	<u> </u>
<u>E. Michalak</u>	<u> </u>
<u>W. Deane</u>	<u> </u>
<u>D. Curtis</u>	<u> </u>
<u> </u>	<u> </u>
<u> </u>	<u> </u>

COUNTY <u>Wood</u>	SHEET NO. <u>8-A</u>
S.R. <u>#105</u>	DATE <u>10 Sept. 73</u>
SECTION <u>18</u>	WEATHER <u>Fair</u>
TWP <u>Webster</u>	TEMP. <u>72°</u>
RANGE <u>12-E</u>	JOB NO. <u> </u>
TOWN <u>S-N</u>	

NW Cor Sec. 18

NW 1/4

N 1/4 Post Sec. 18

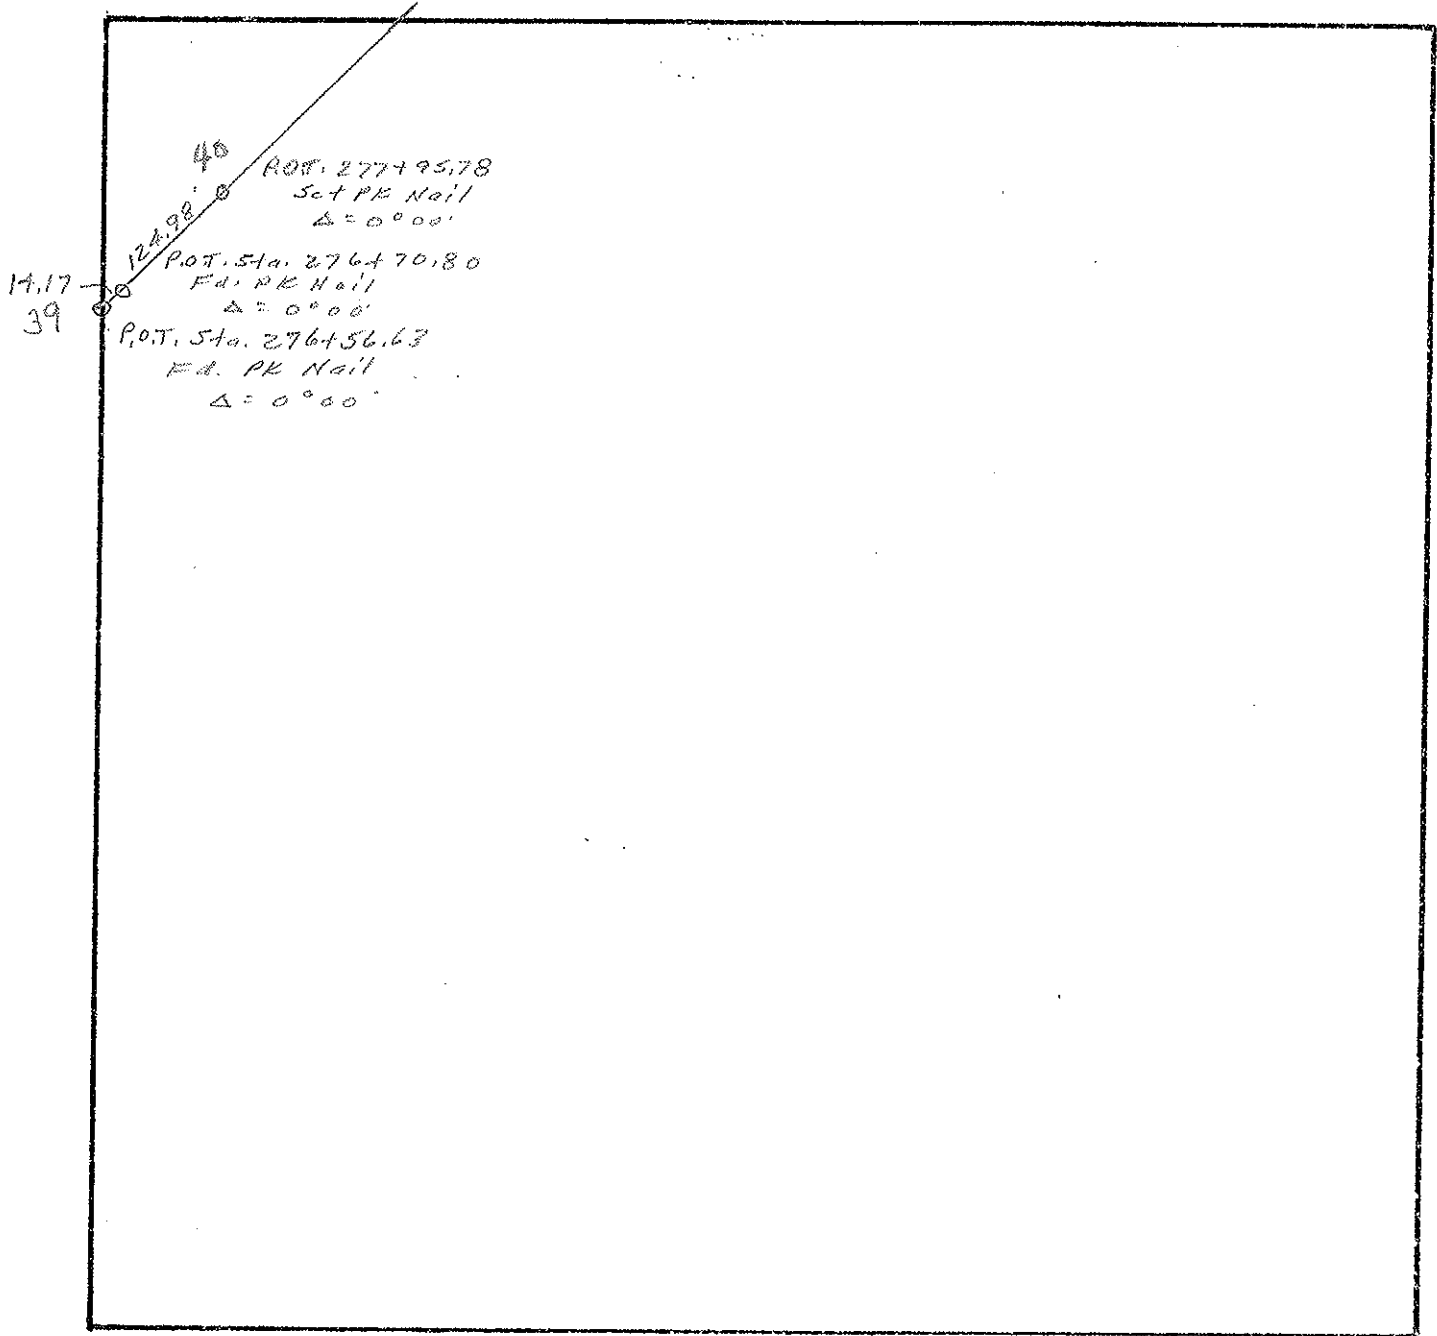

W 1/4 Post
Sec. 18


E Sec. 18

PERSONNEL	TITLE	COUNTY	SHEET NO.
<u>I. Stone</u>		<u>Wood</u>	<u>9-A</u>
<u>R. Michael</u>		<u>S.R. 105</u>	<u>DATE 29 Oct. 73</u>
<u>W. Denny</u>		<u>SECTION 7</u>	<u>WEATHER Rain</u>
<u>D. Curtis</u>		<u>TWP Webster</u>	<u>TEMP. 44°</u>
		<u>RANGE 12-E</u>	<u>JOB NO.</u>
		<u>TOWN 5-N</u>	

W 1/4 Post Sec. 7
Ed. Stone

SW 1/4

Ed. Stone
& Sec. 7

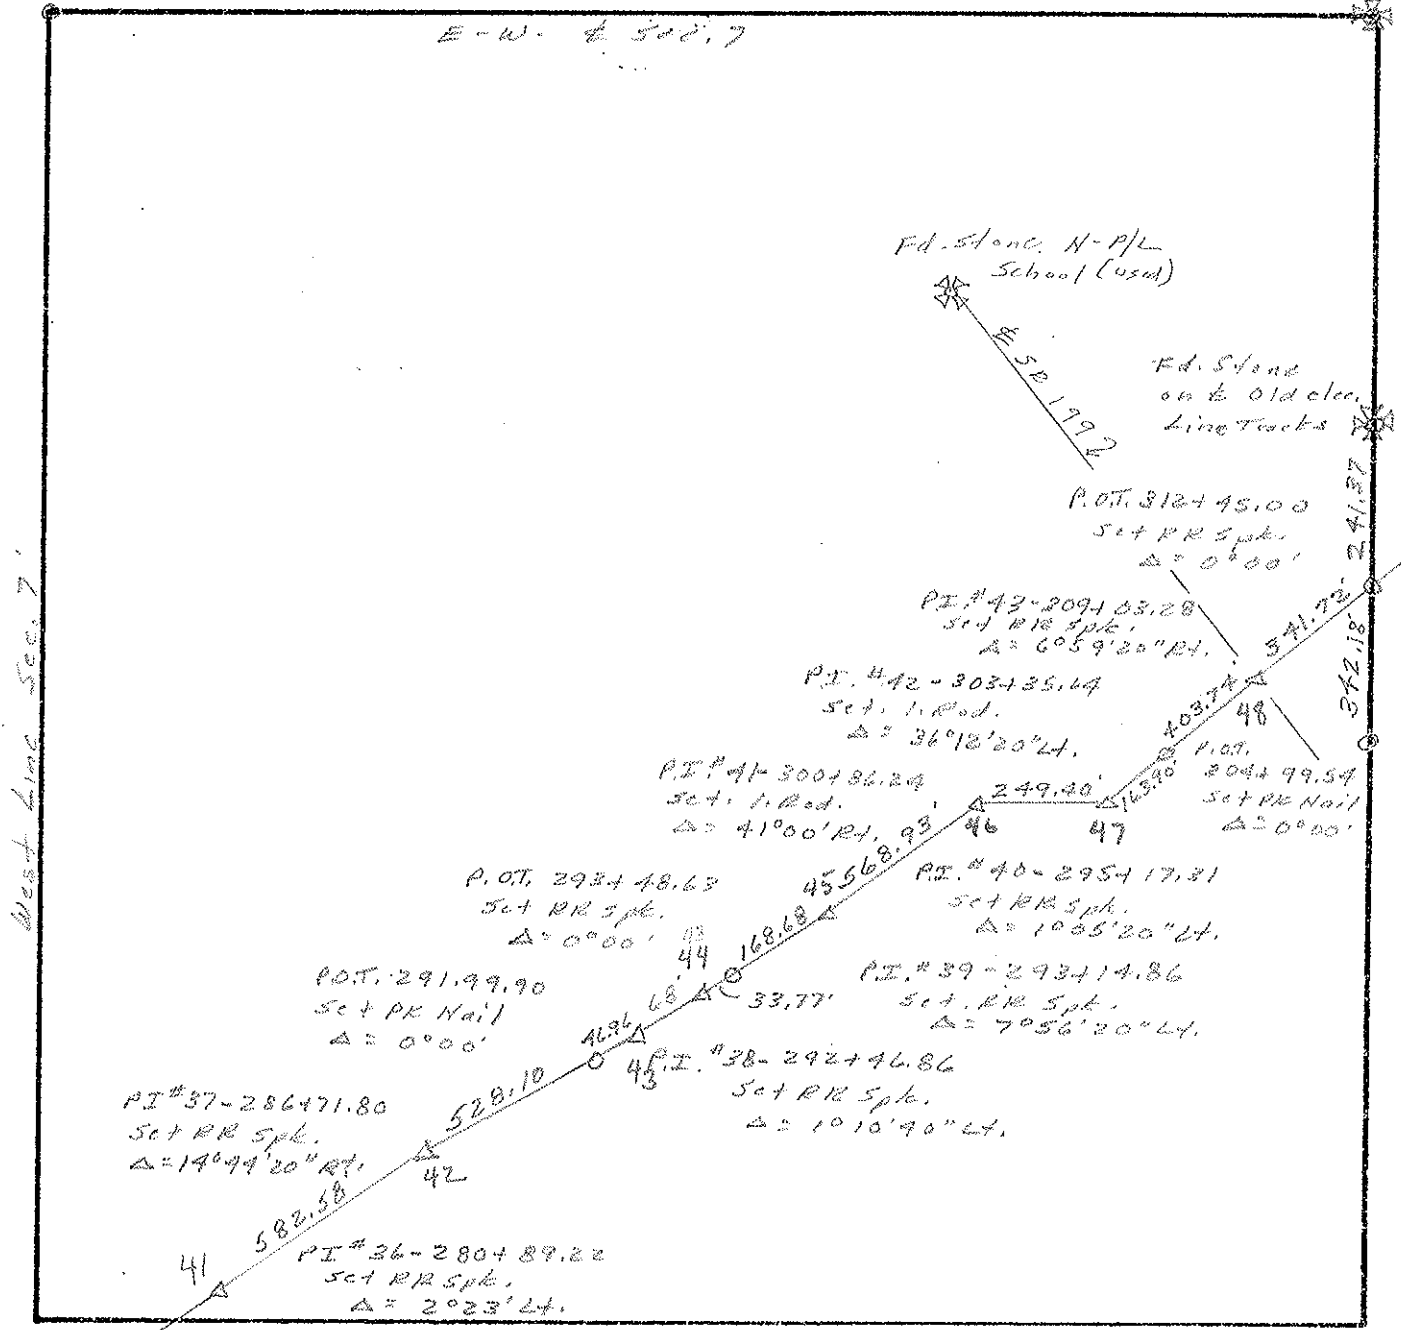


SW cor Sec. 7

S. 1/4 Post
Sec. 7

PERSONNEL	TITLE	PERSONNEL	TITLE
<u>Stone</u>			
<u>Dennis</u>			
<u>Michaelak</u>			
<u>Curtis</u>			

COUNTY Wood DATE 13 March 74
 S. R. 105 WEATHER Cool
 SEC. Webster Twp. TEMP. 32°

DESCRIPTION Alignment Section Lines JOB NO. 02999(0)
 LEFT CENTER LINE RIGHT

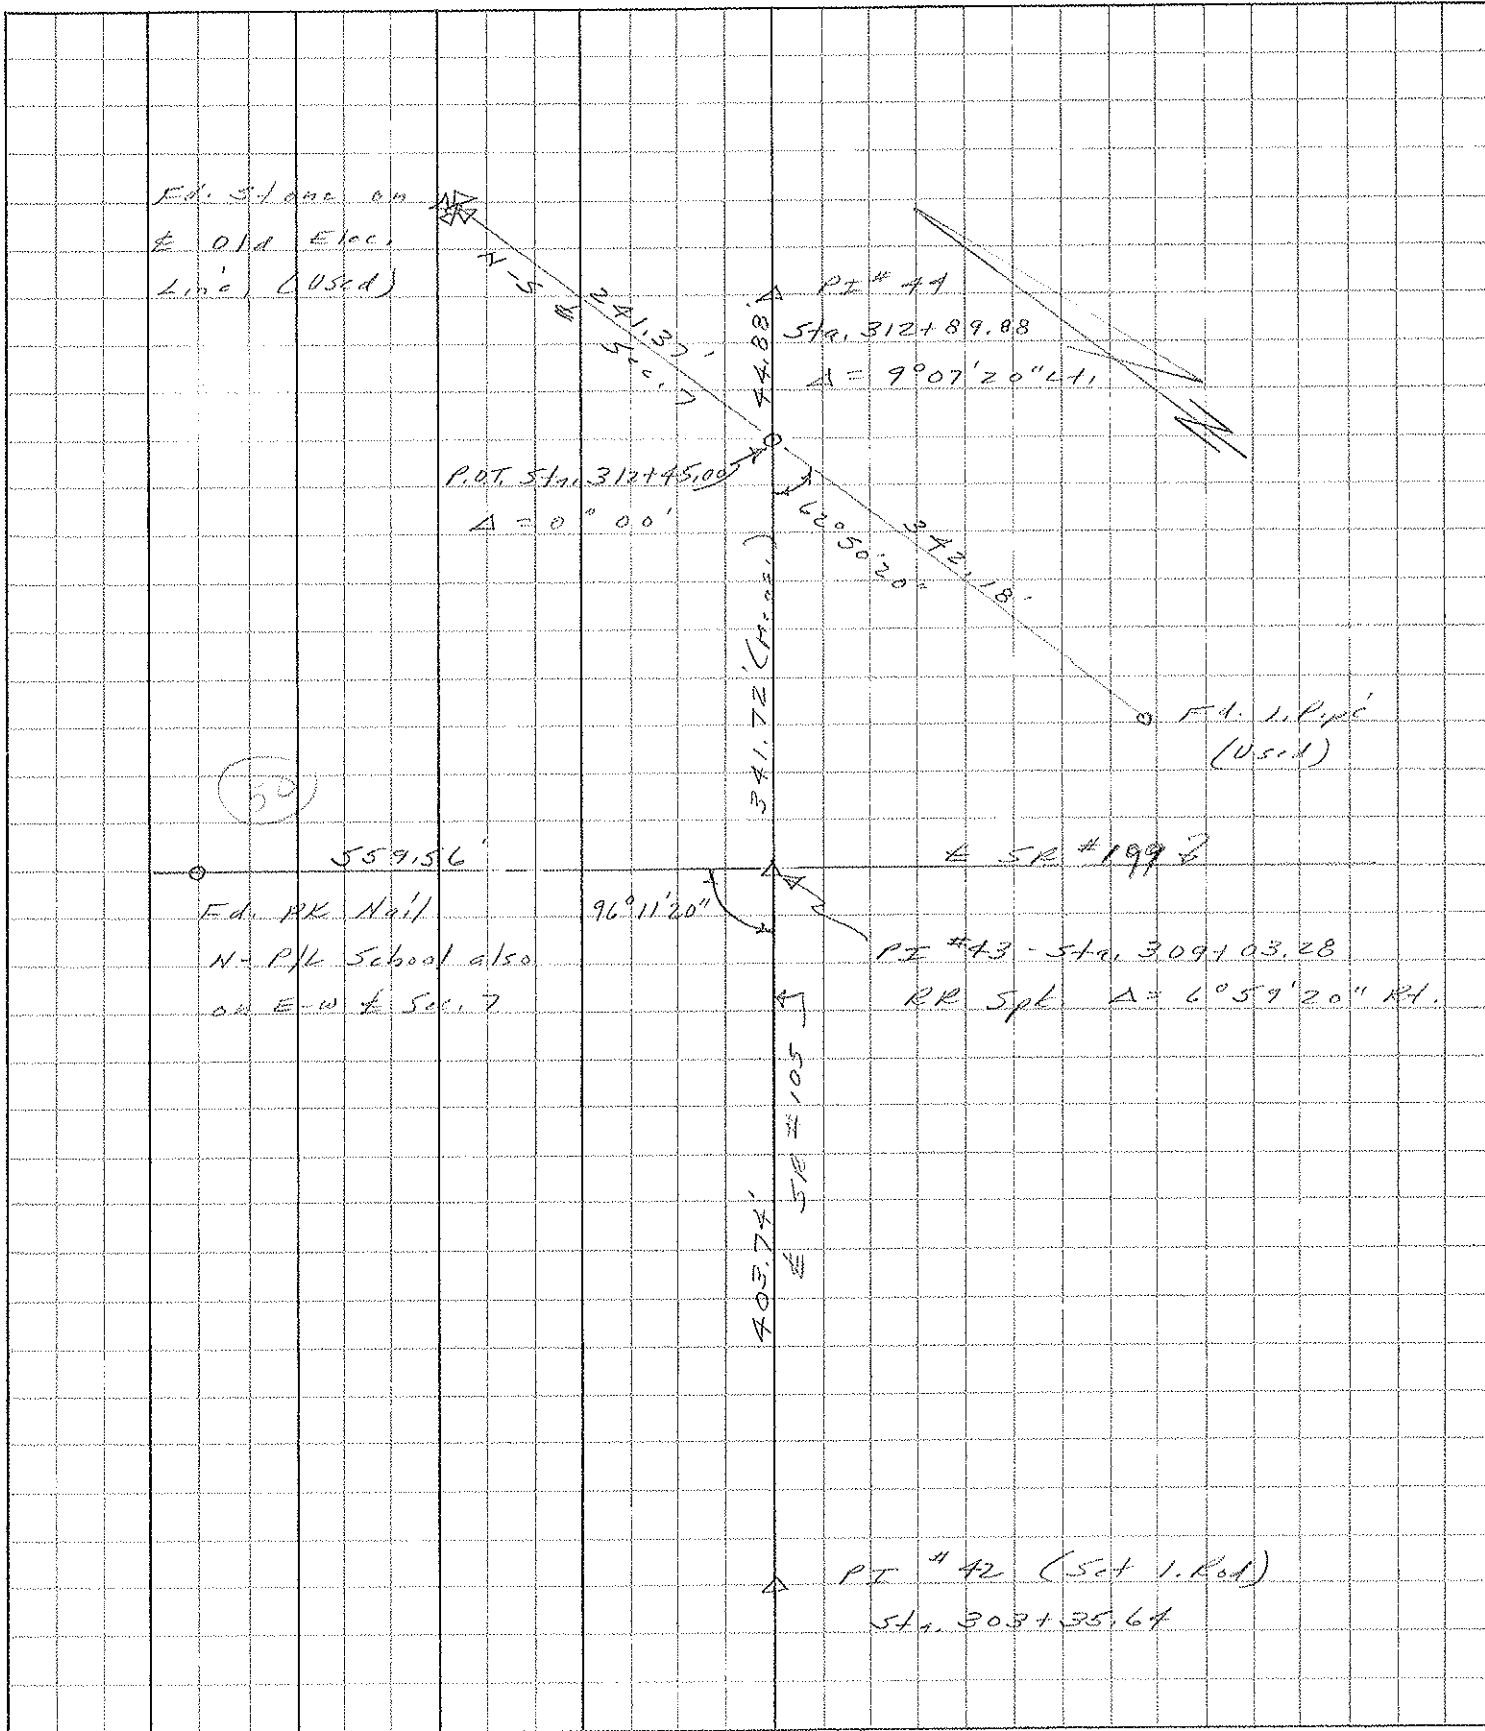


PERSONNEL	TITLE	COUNTY	SHEET NO.
Stear	Notes	Ward	10-A
Miehalata	T	S.R. #105	DATE 29 Oct. 73
Deanna	H.C.	SECTION 7	WEATHER Rain
Curtis	R.C.	TWP Webster	TEMP. 47°
		RANGE 12-E	JOB NO.
		TOWN S-N	

SE 1/4

Sec. 7
Stone

E 1/4 Post Sec. 7
Ed. Stone

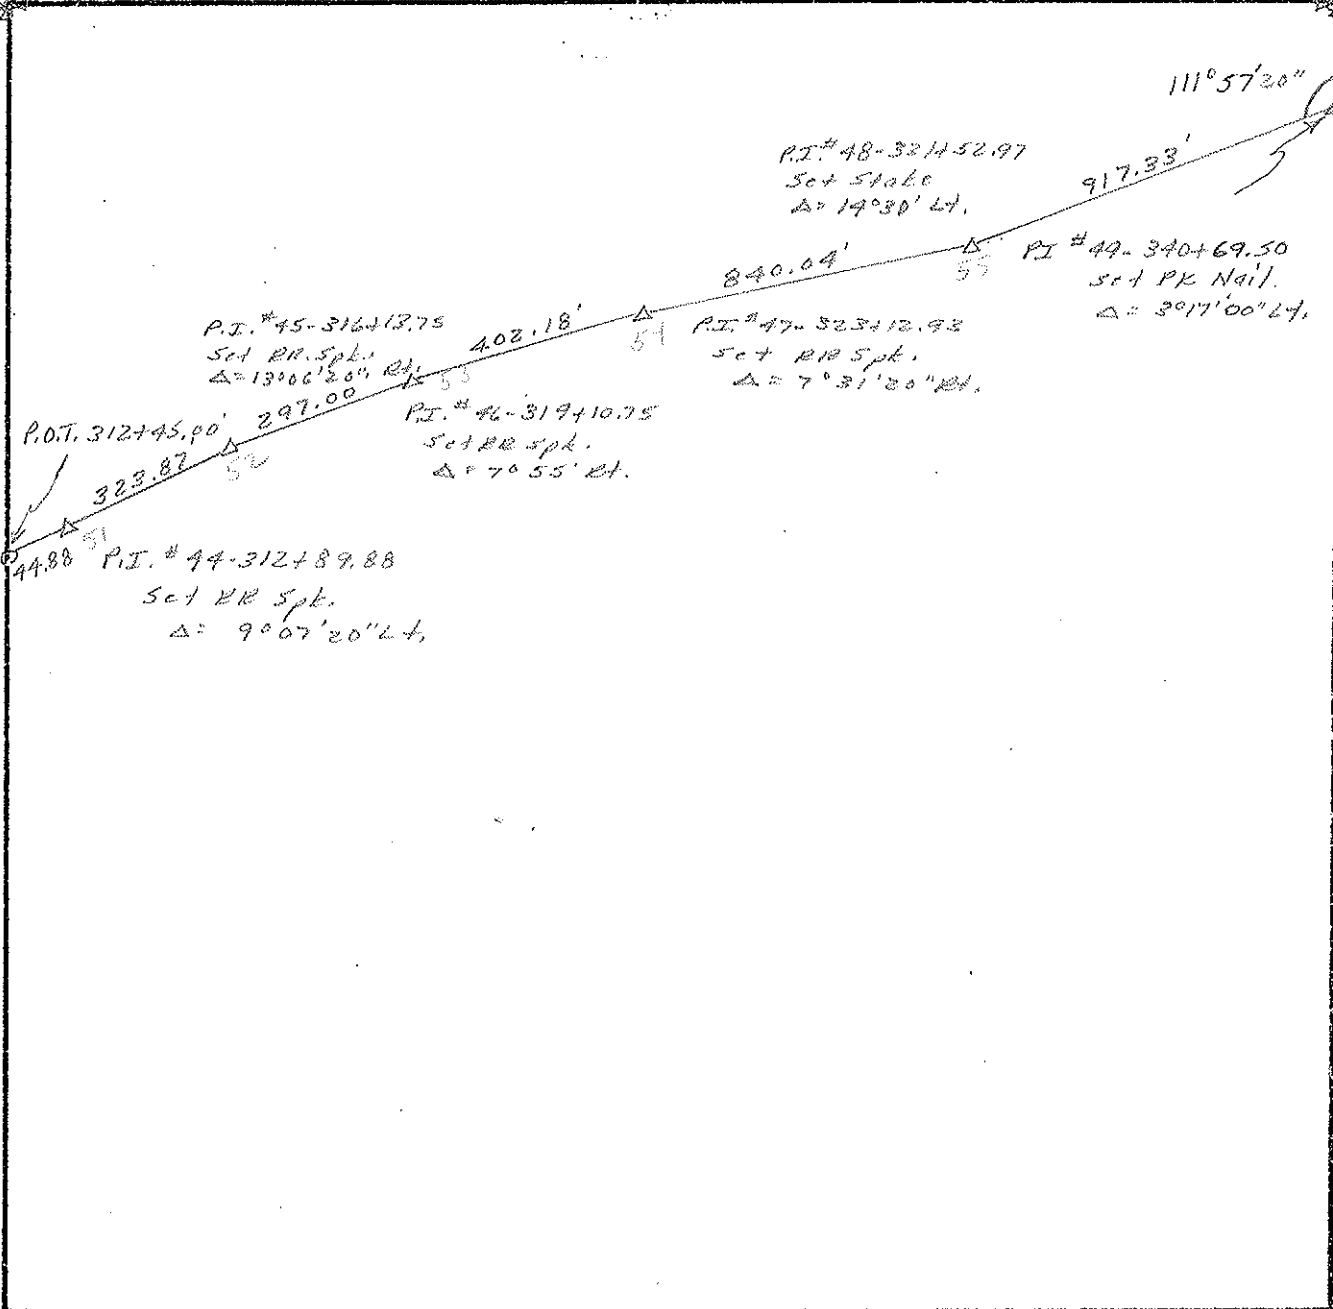


N-S
Sec. 7

S 1/4 Post Sec. 7

SE Corner
Sec. 7

PERSONNEL	TITLE
L. S. Stone	
D. Michalak	
W. D. Dunn	
D. Curtis	

COUNTY	Wood	SHEET NO.	11-A
S.R.	#105	DATE	29 Oct. 73
SECTION	8	WEATHER	Clear
TWP	Webster	TEMP.	47°
RANGE	12-E	JOB NO.	
TOWN	S-N		

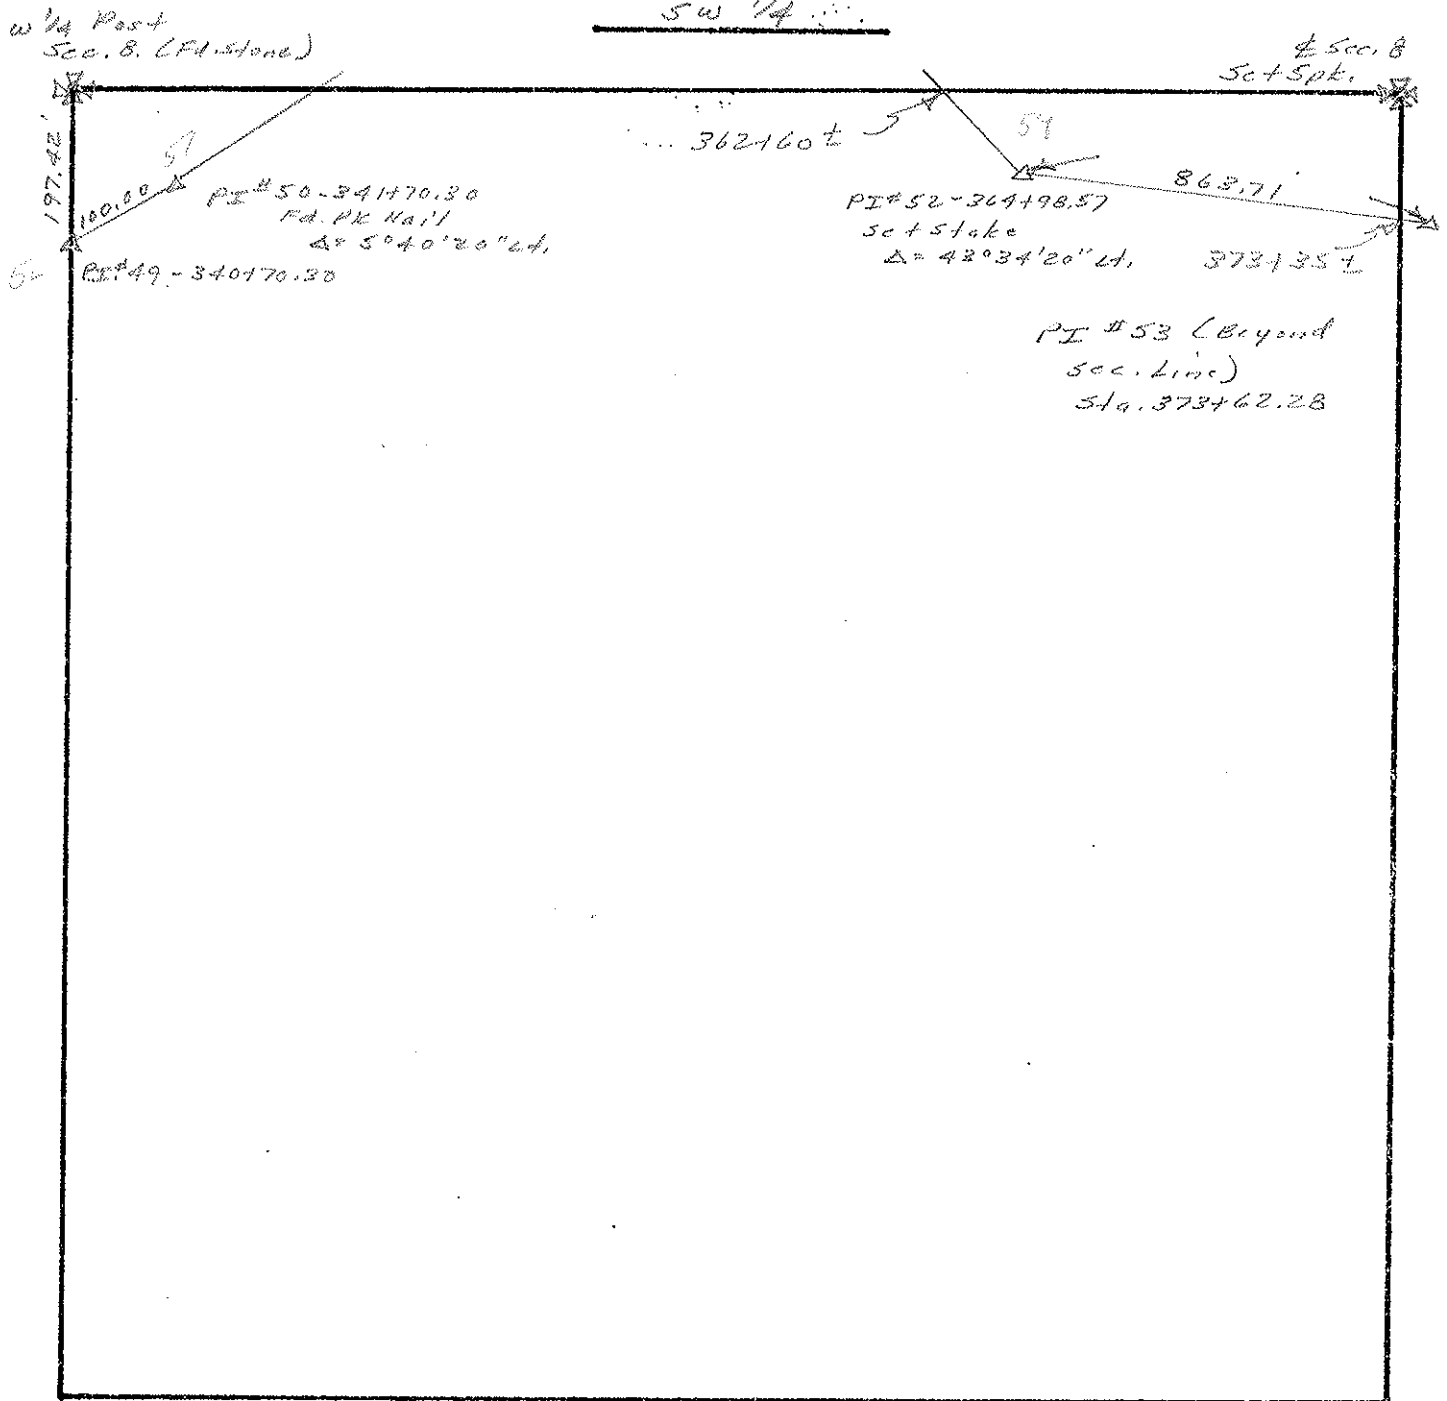


SW Cor.
Sec. 8

S 1/4 Post
Sec. 8


PERSONNEL	TITLE	COUNTY	Wood	SHEET NO.	12-A
Stone		S.R.	105	DATE	29 Oct. 73
Michalak		SECTION	8	WEATHER	Clear
Dennis		TWP	Webster	TEMP.	77°
Curtis		RANGE	12-E	JOB NO.	
		TOWN	S-N		

NW 1/4 Sec. 8

NW 1/4 Post Sec. 8

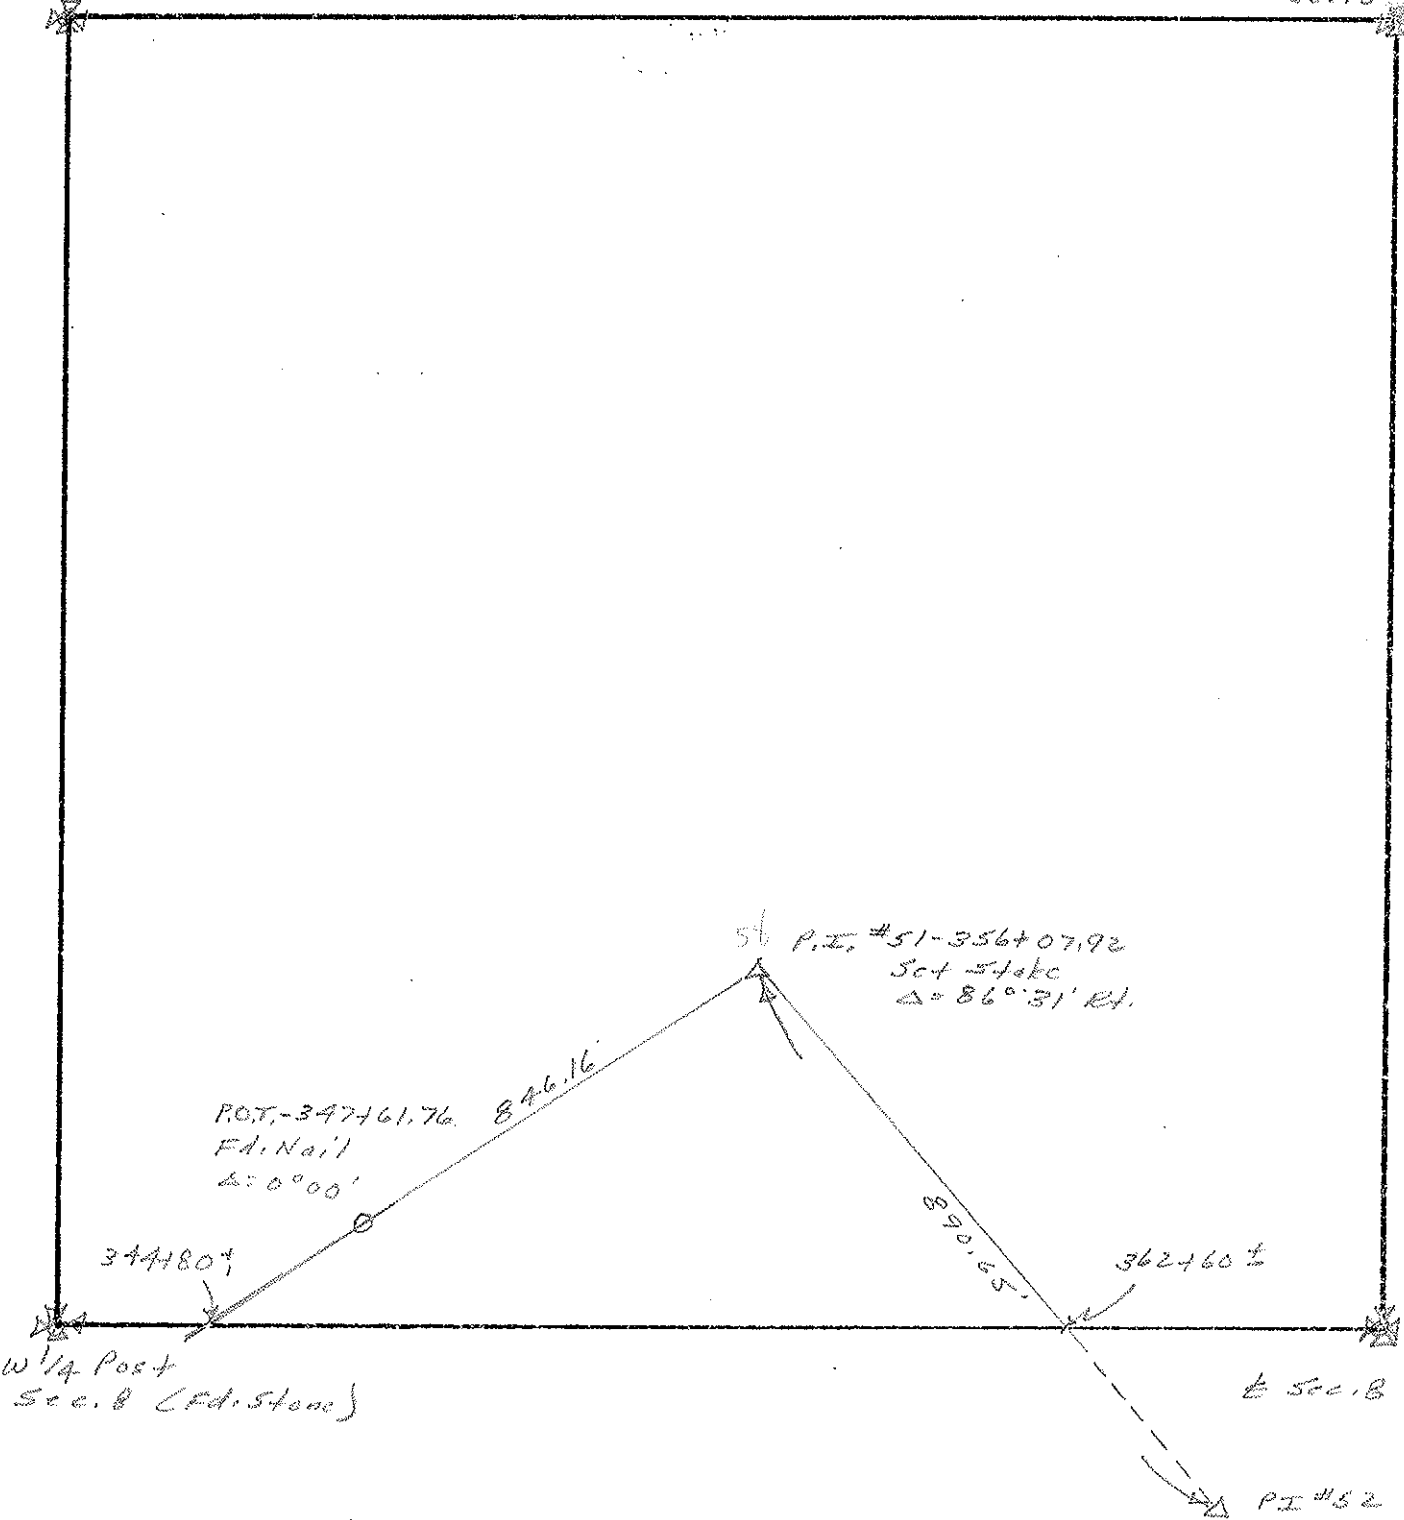

PERSONNEL	TITLE	COUNTY <u>Wood</u>	SHEET NO. <u>13-A</u>
<u>L. Stone</u>	_____	S.R. <u>105</u>	DATE <u>29 Oct, 73</u>
<u>R. Michalale</u>	_____	SECTION <u>8</u>	WEATHER <u>Rain</u>
<u>W. Deering</u>	_____	TWP <u>Webster</u>	TEMP. <u>48°</u>
<u>D. Curtis</u>	_____	RANGE _____	JOB NO. _____
_____	_____	TOWN _____	

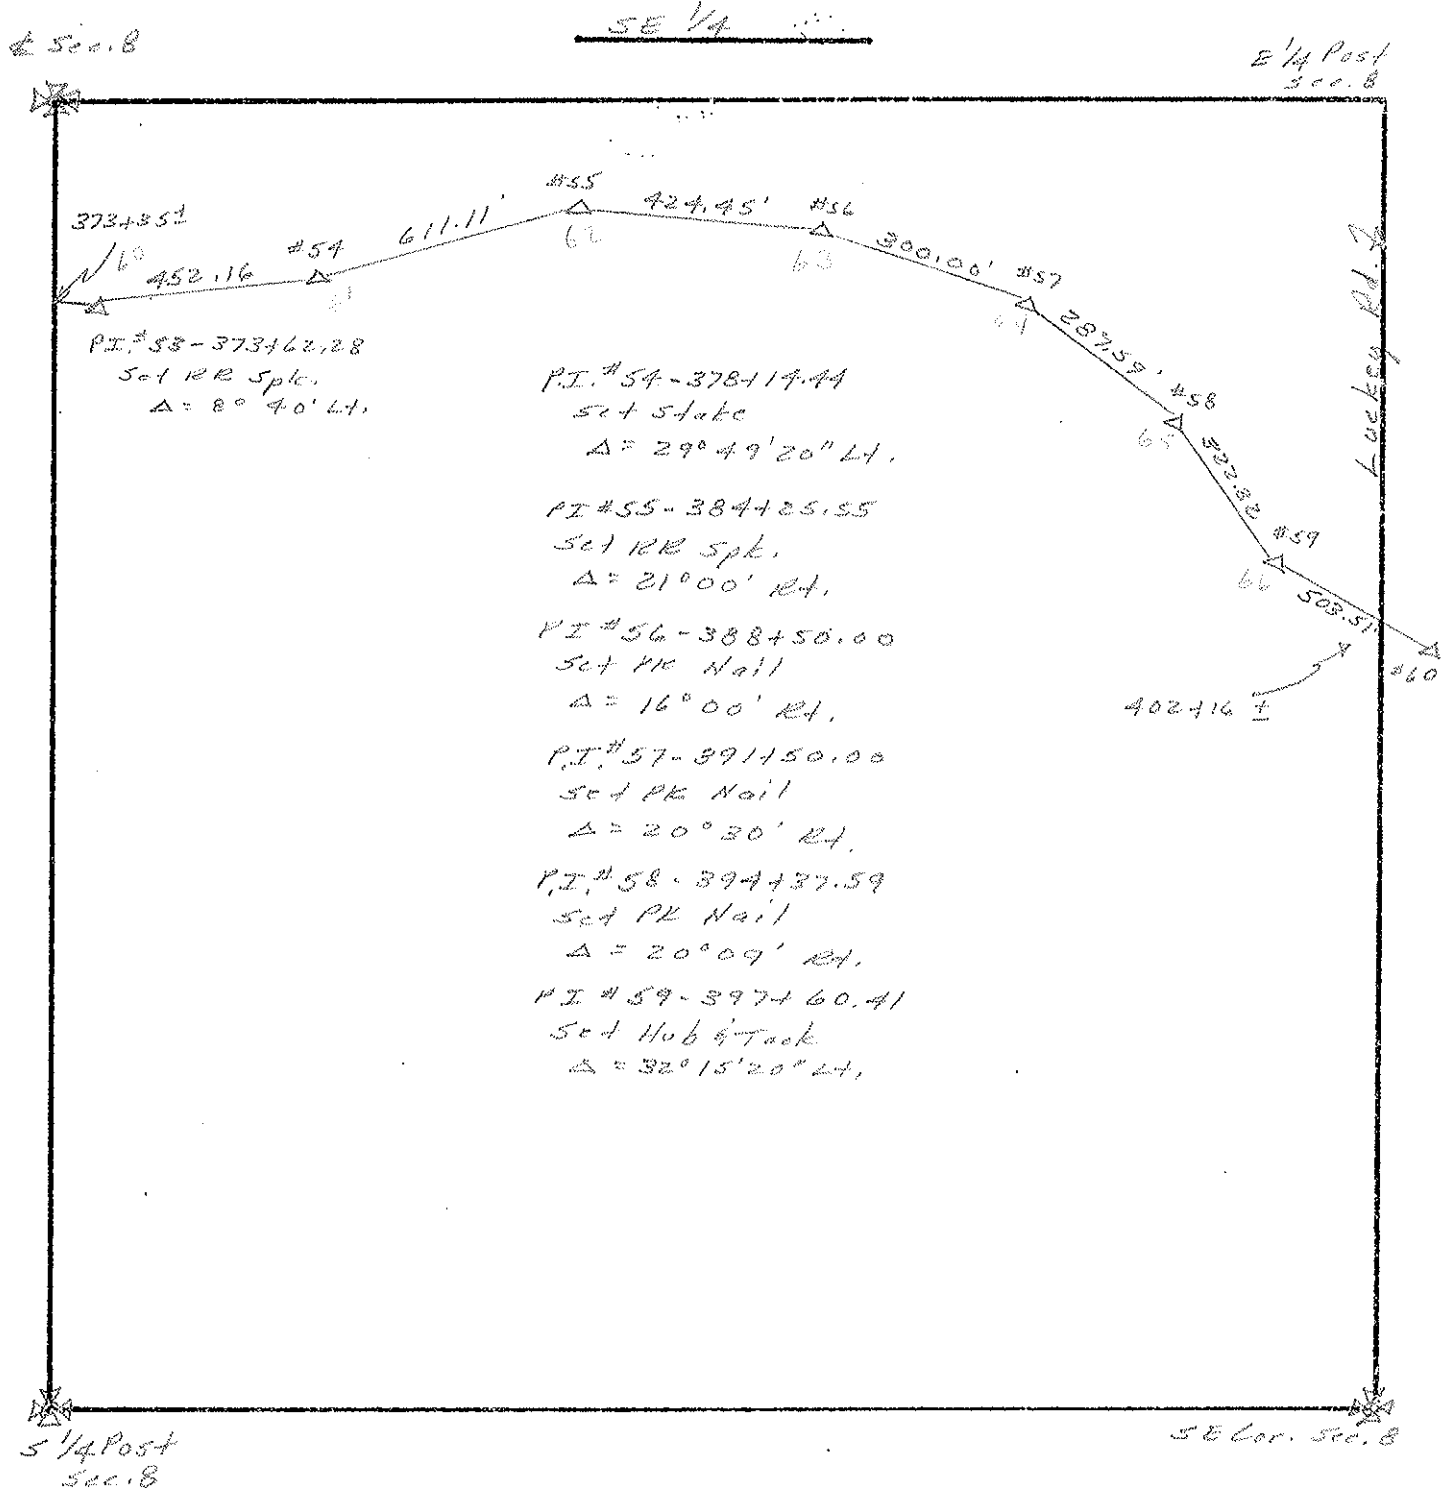


PERSONNEL	TITLE
Stone	
Michalok	
Deana	
Curtis	

COUNTY Wood SHEET NO. 14-A
 S.R. 105 DATE 30 Oct. 73
 SECTION 9 WEATHER Rain
 TWP Freedom TEMP. 47°
 RANGE 12-E JOB NO. _____
 TOWN S-N

W 1/4 Post Sec. 9

SW 1/4


Sec. 9

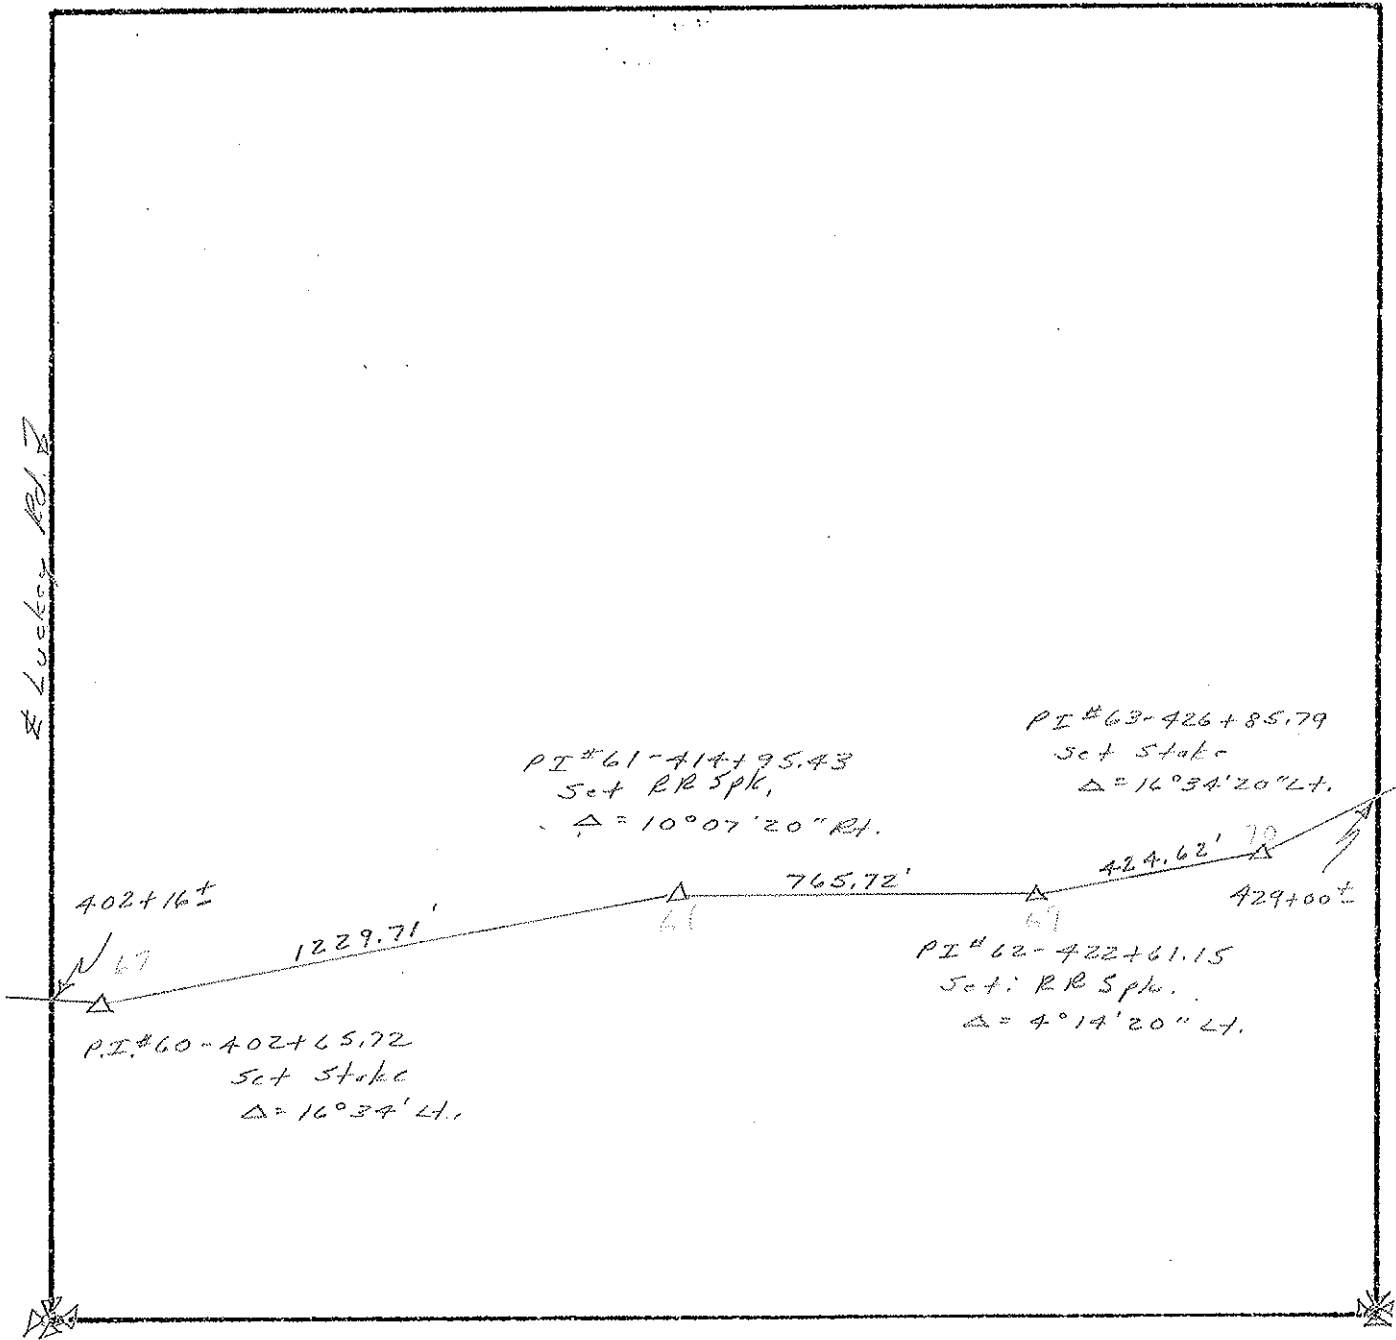


SW Cor. Sec. 9

SW 1/4 Post Sec. 9


PERSONNEL	TITLE	COUNTY <u>Wood</u>	SHEET NO. <u>15-A</u>
<u>Stone</u>	_____	S.R. <u>105</u>	DATE <u>30 Oct. 73</u>
<u>Michelak</u>	_____	SECTION <u>9</u>	WEATHER <u>Rain</u>
<u>Dennis</u>	_____	TWP <u>Freedom</u>	TEMP. <u>47°</u>
<u>Curtis</u>	_____	RANGE <u>12-E</u>	JOB NO. _____
_____	_____	TOWN <u>5-N</u>	

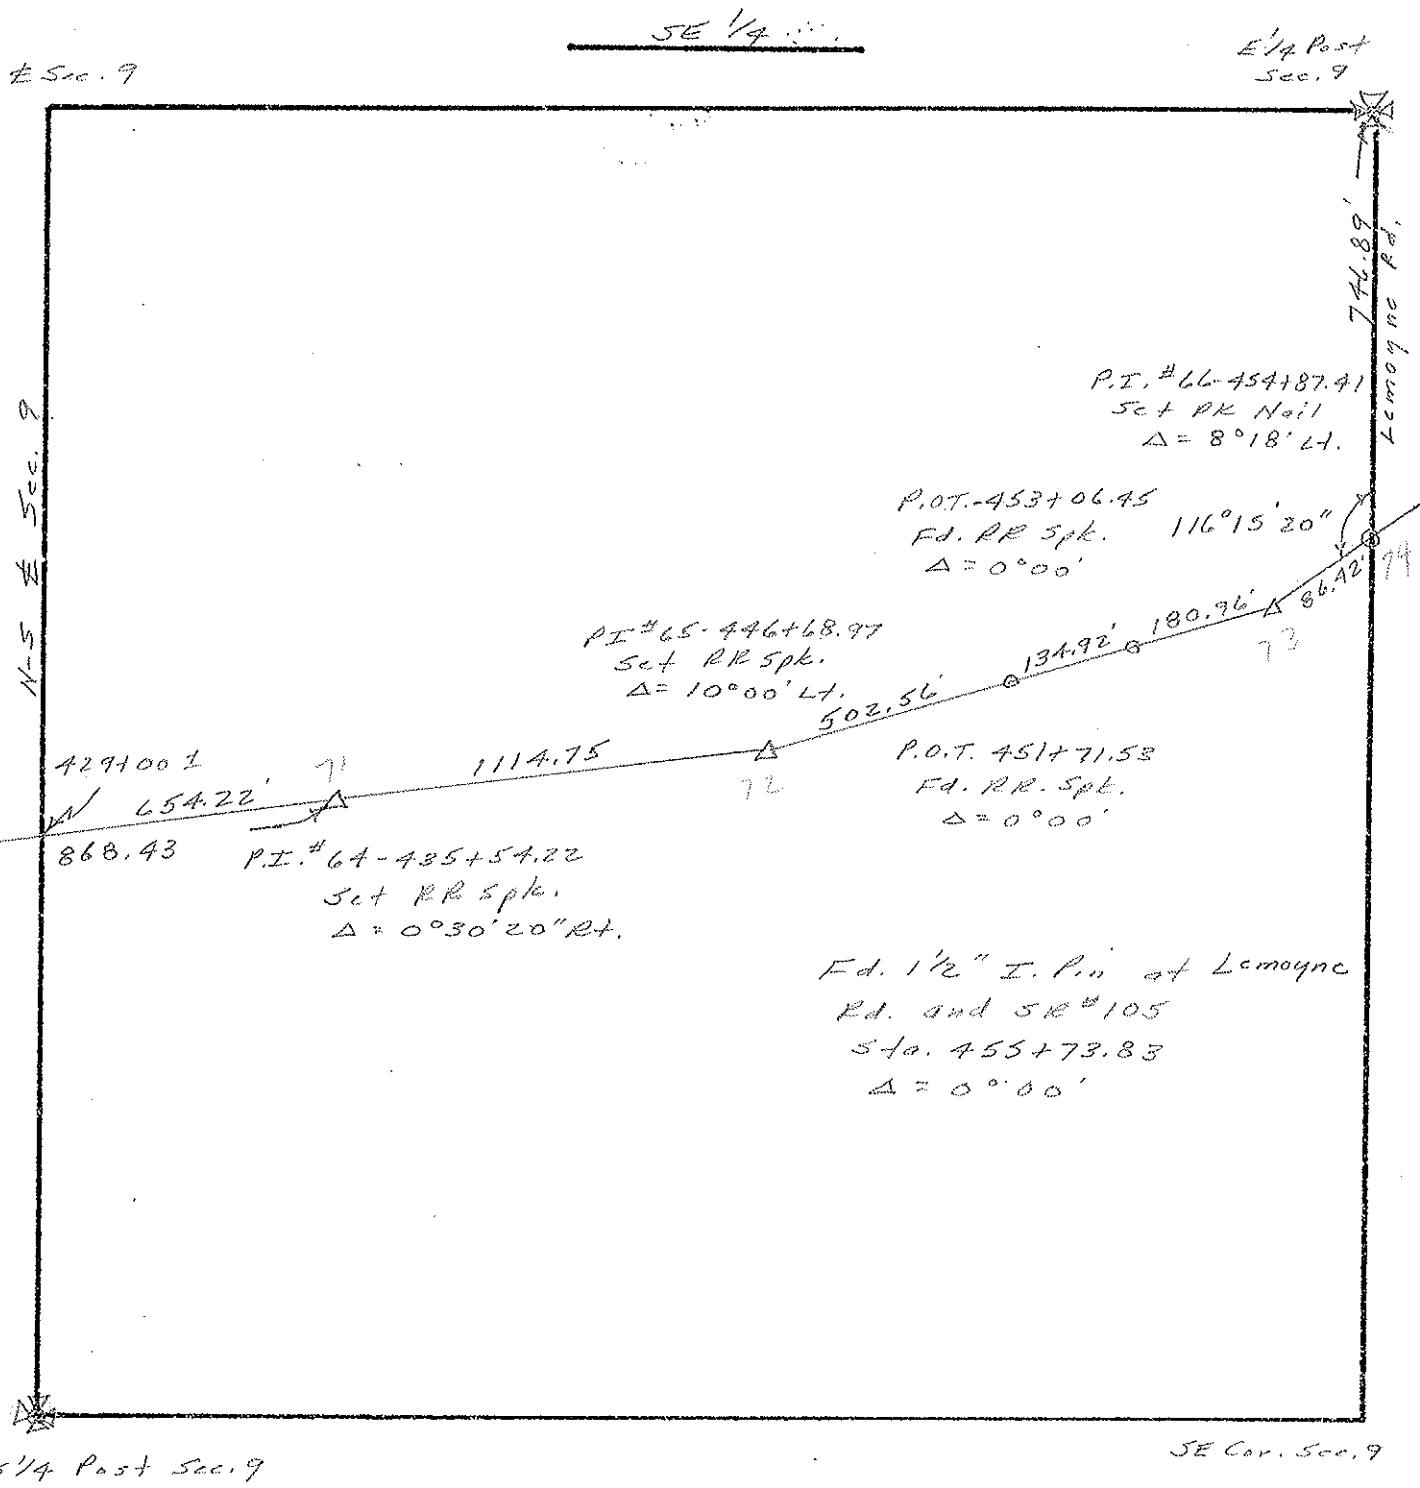

PERSONNEL	TITLE	COUNTY <u>Wood</u>	SHEET NO. <u>16-A</u>
<u>Stone</u>	_____	S.R. <u>105</u>	DATE <u>30 Oct 73</u>
<u>Michaelak</u>	_____	SECTION <u>10</u>	WEATHER <u>Clear</u>
<u>Dunn</u>	_____	TWP <u>Freedom</u>	TEMP. <u>47°</u>
<u>Quadis</u>	_____	RANGE <u>12-E</u>	JOB NO. _____
_____	_____	TOWN <u>5-N</u>	

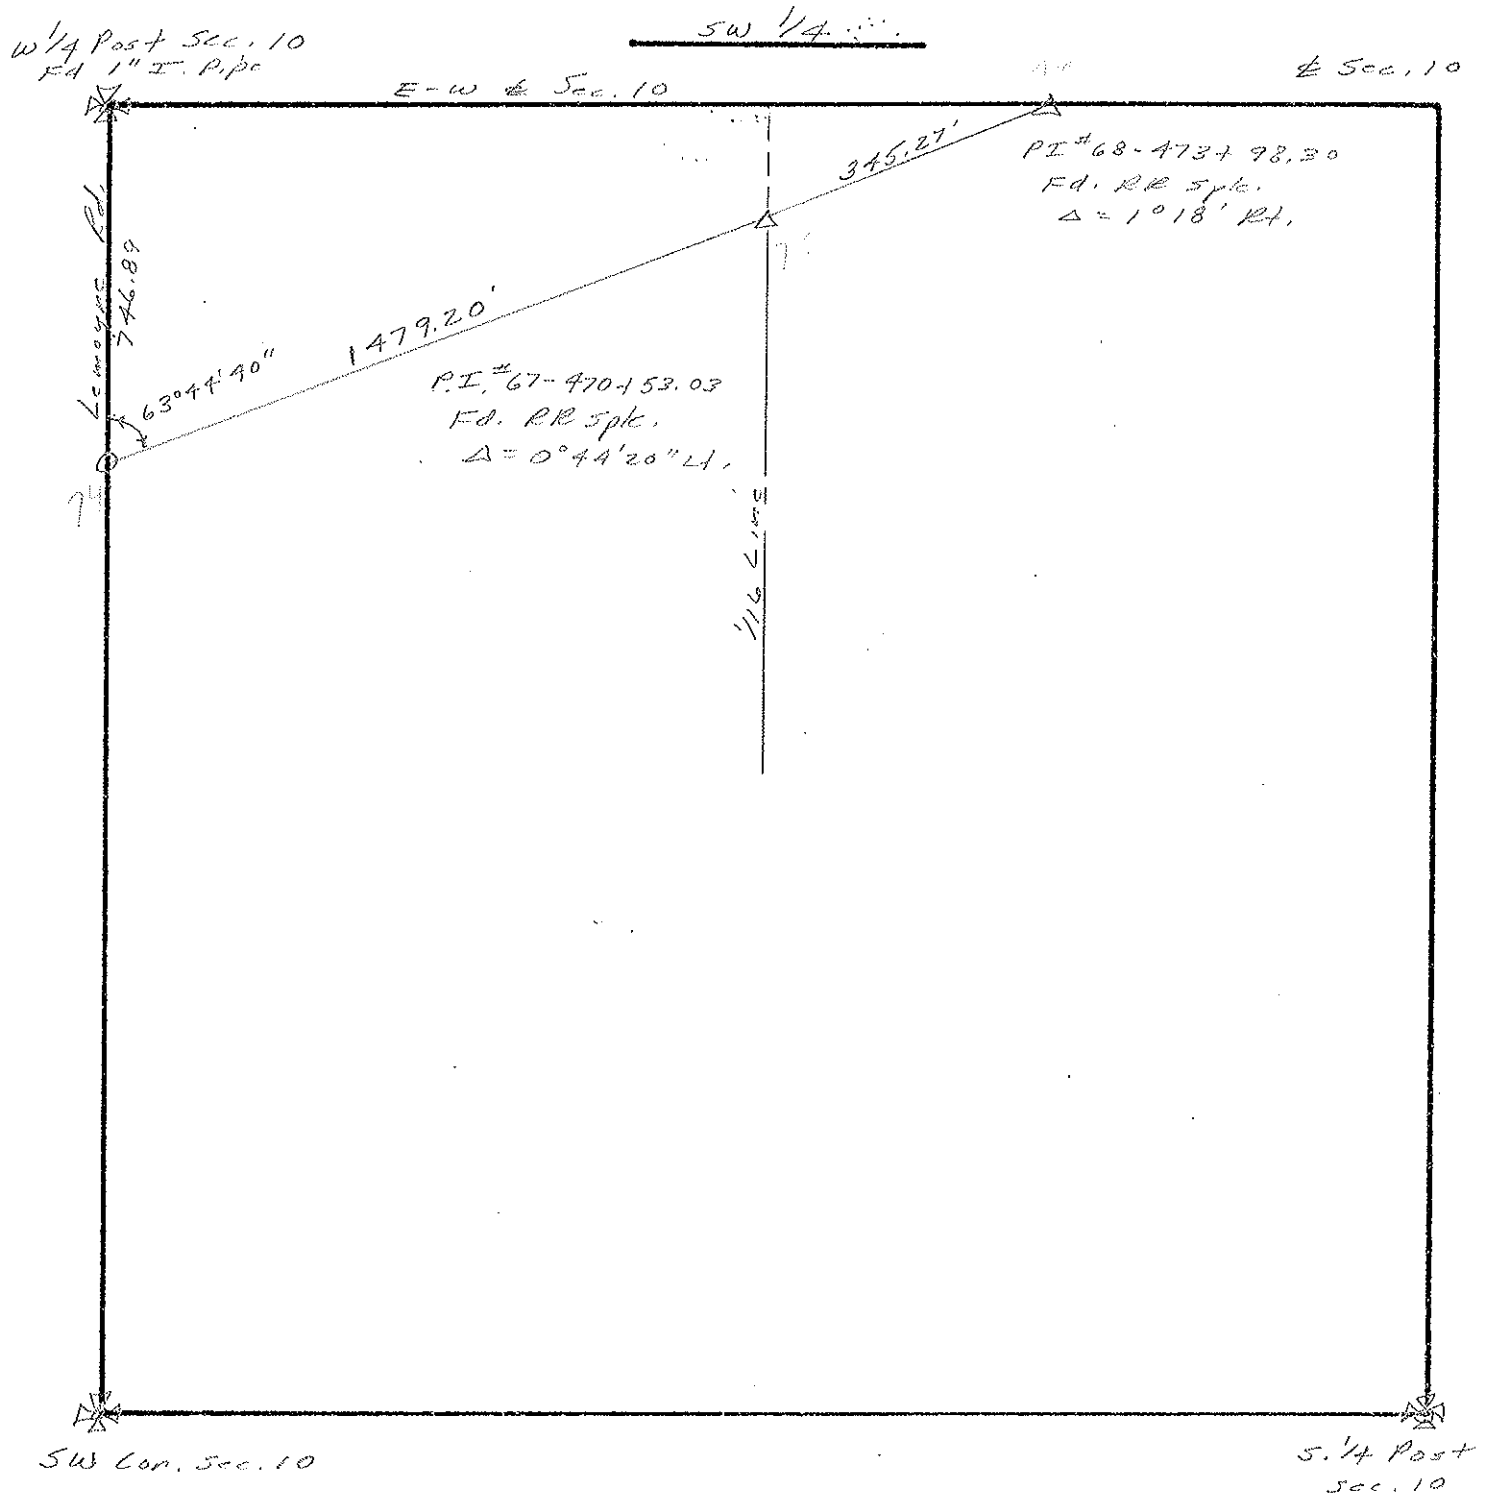


PERSONNEL	TITLE	COUNTY <u>Wood</u>	SHEET NO. <u>17-A</u>
<u>Stone</u>	_____	S.R. <u>105</u>	DATE <u>30 Oct 78</u>
<u>Michaelake</u>	_____	SECTION <u>10</u>	WEATHER <u>Rain</u>
<u>Dunn</u>	_____	TWP <u>Freedom</u>	TEMP. <u>48°</u>
<u>Curtis</u>	_____	RANGE <u>13-E</u>	JOB NO. _____
_____	_____	TOWN <u>5-N</u>	

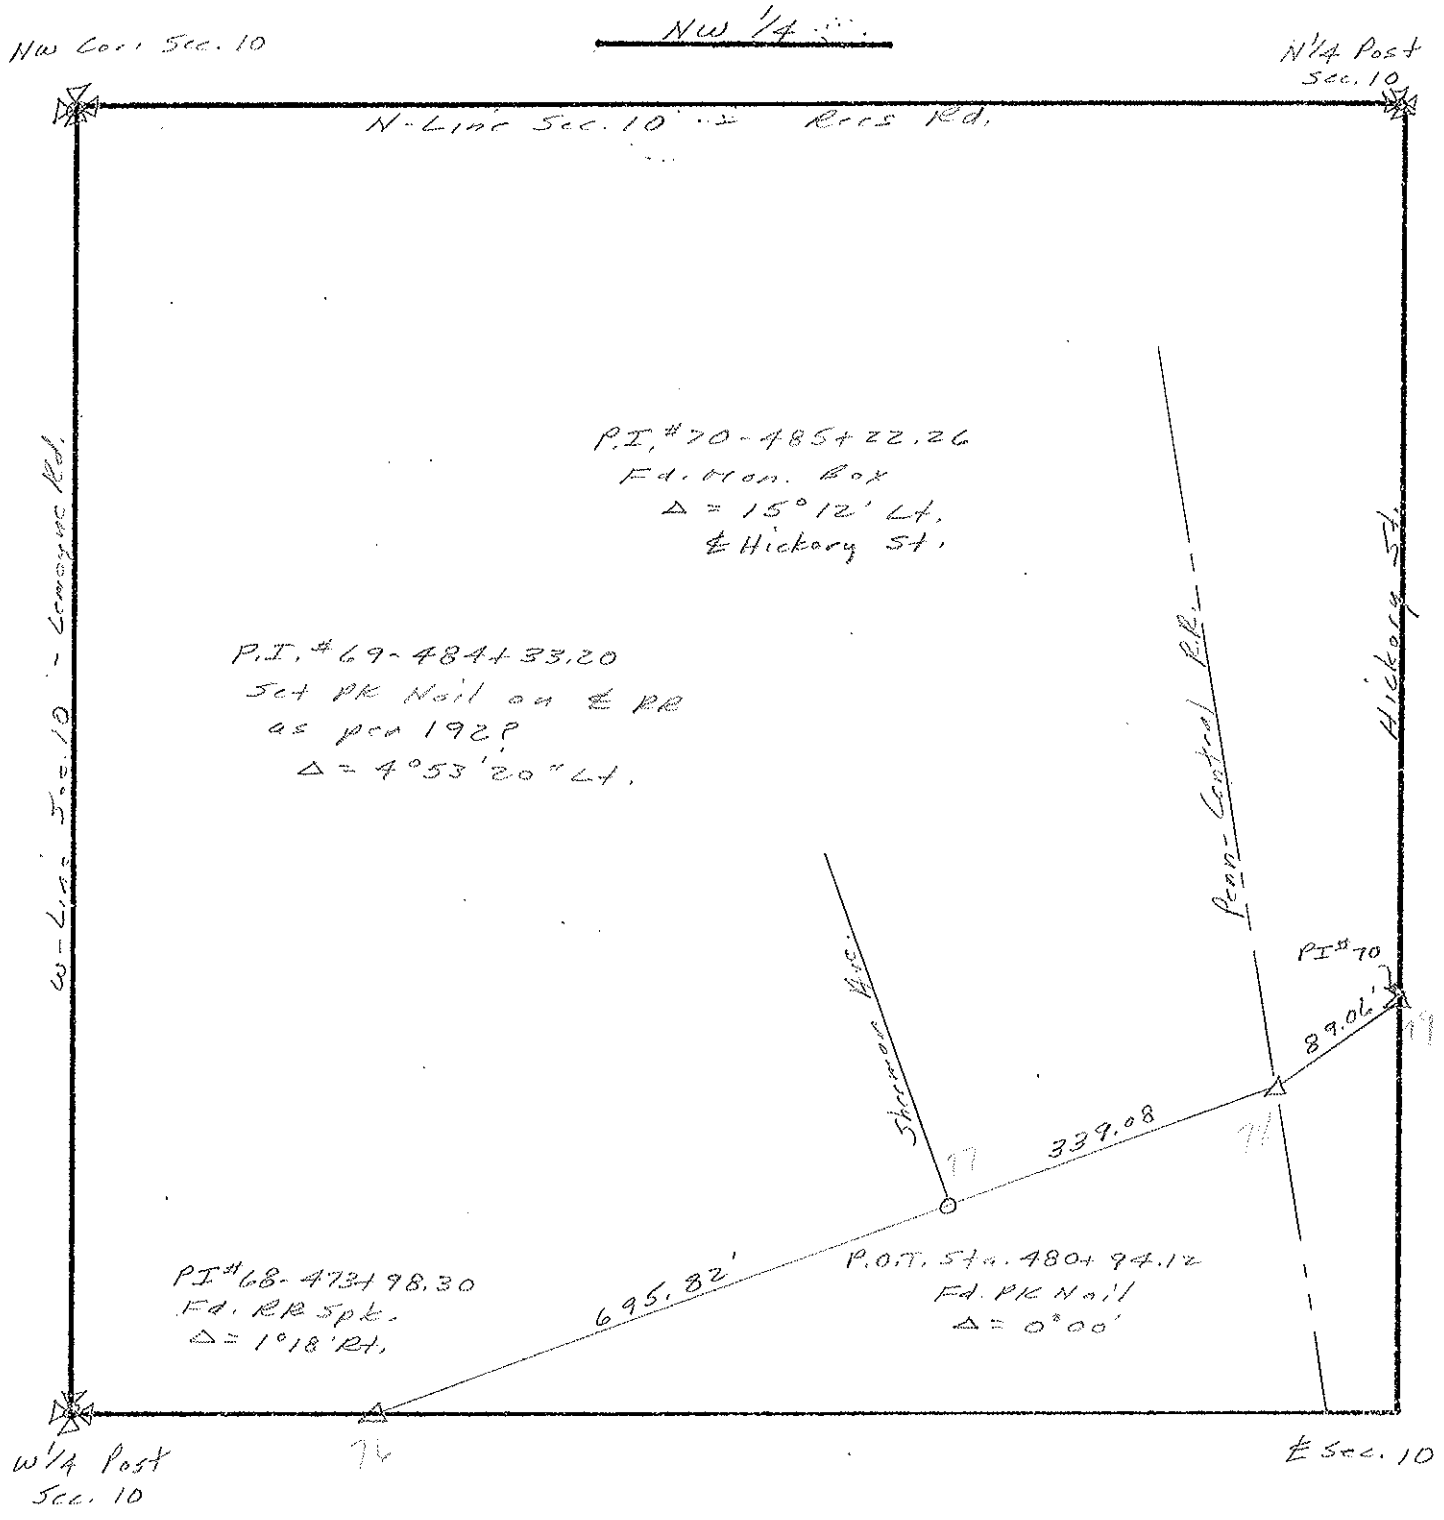


PERSONNEL	TITLE
<u>I. Stone</u>	<u> </u>
<u>W. Deana</u>	<u> </u>
<u>D. Michalek</u>	<u> </u>
<u>D. Curtis</u>	<u> </u>
<u> </u>	<u> </u>
<u> </u>	<u> </u>


COUNTY <u>Wood</u>	SHEET NO. <u>19-A</u>
S.R. <u>105</u>	DATE <u>13 Feb. 79</u>
SECTION <u>11</u>	WEATHER <u>Fair</u>
TWP <u>Freedom</u>	TEMP. <u>37°</u>
RANGE <u>12-E</u>	JOB NO. <u> </u>
TOWN <u>5-N</u>	

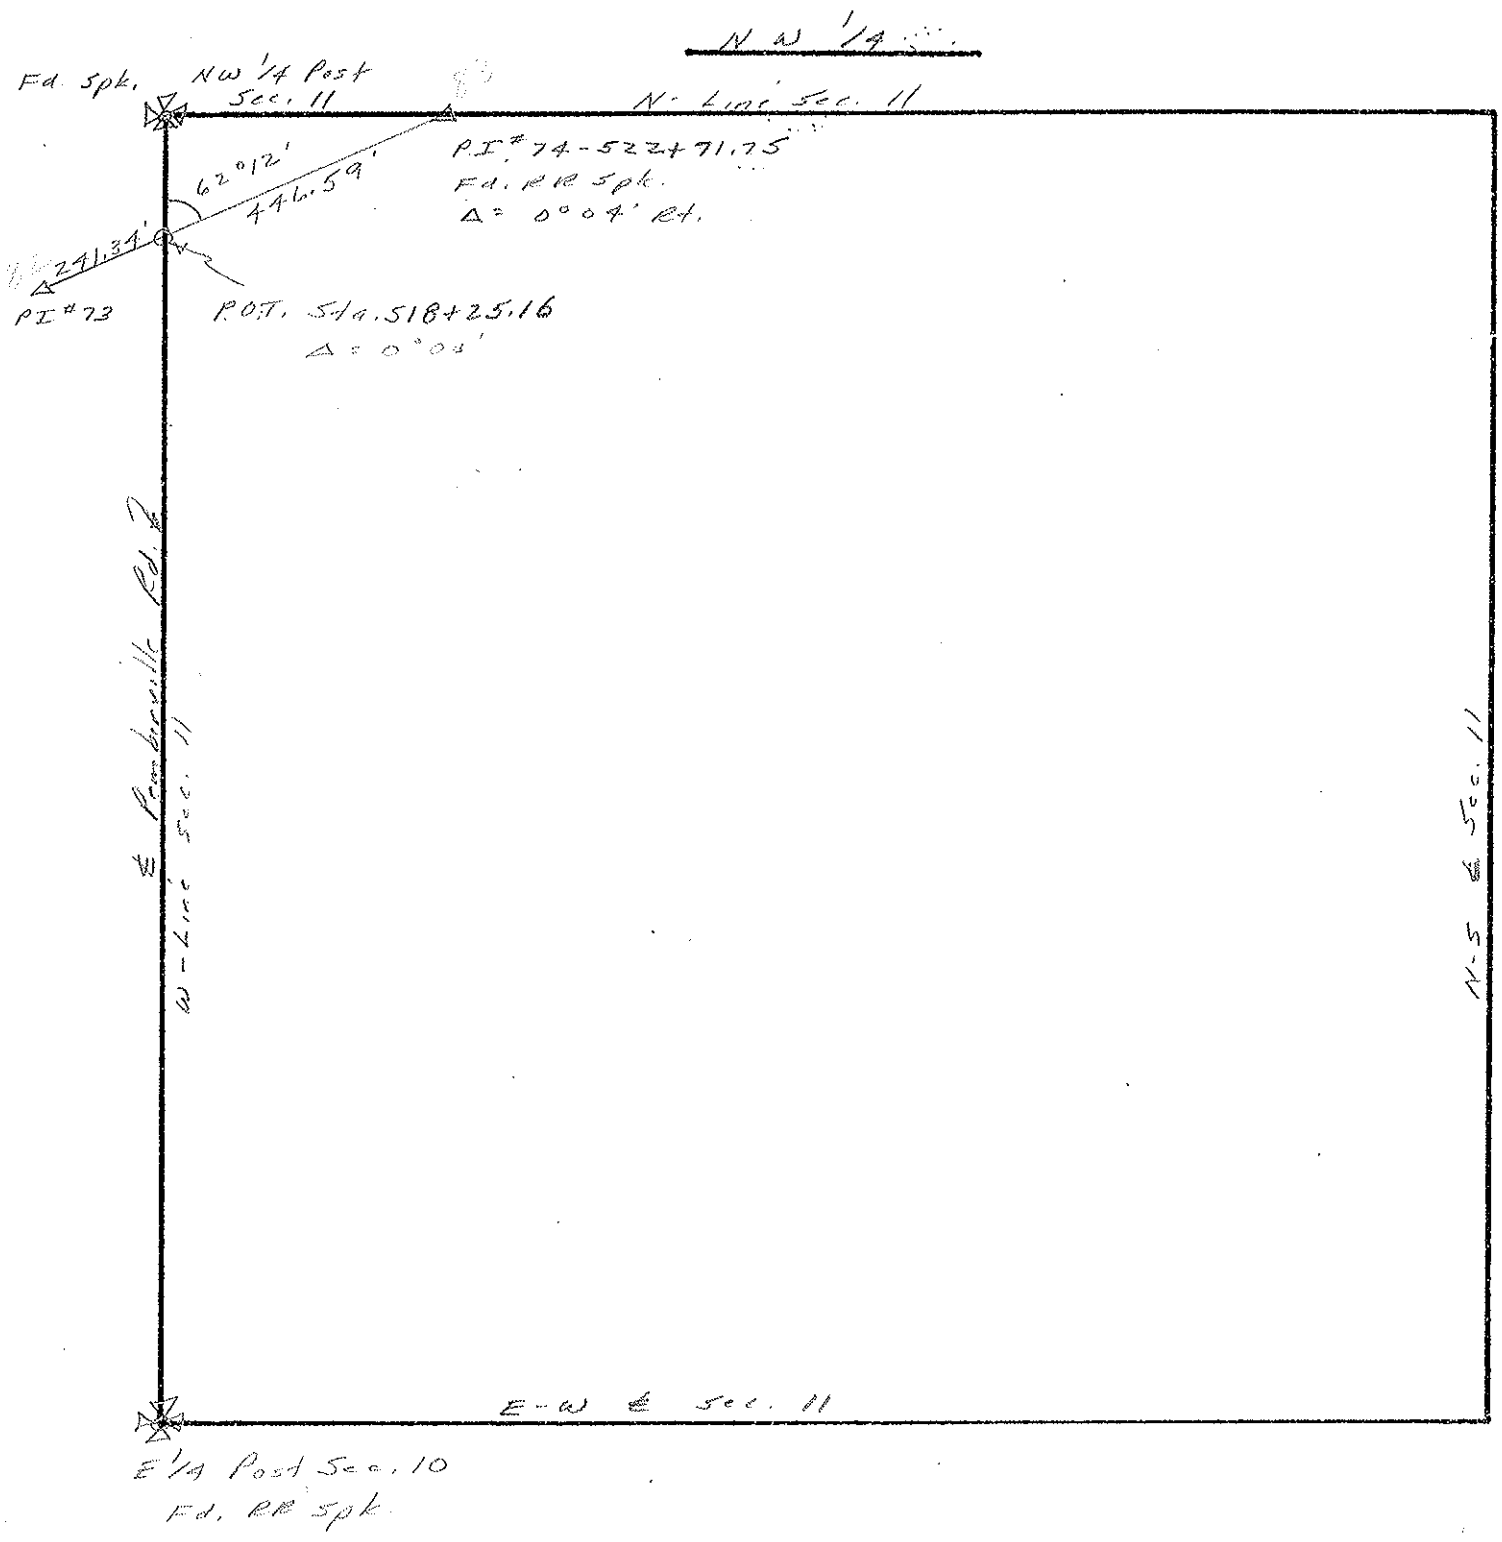

PERSONNEL	TITLE	COUNTY <u>Wood</u>	SHEET NO. <u>20-A</u>
<u>I. Stone</u>	_____	S.R. <u>105</u>	DATE <u>13 Feb. 74</u>
<u>R. Michalak</u>	_____	SECTION <u>2</u>	WEATHER <u>Fair</u>
<u>W. Drape</u>	_____	TWP <u>Freedom</u>	TEMP. <u>38°</u>
<u>J. Curtis</u>	_____	RANGE <u>12-E</u>	JOB NO. _____
_____	_____	TOWN <u>5-N</u>	

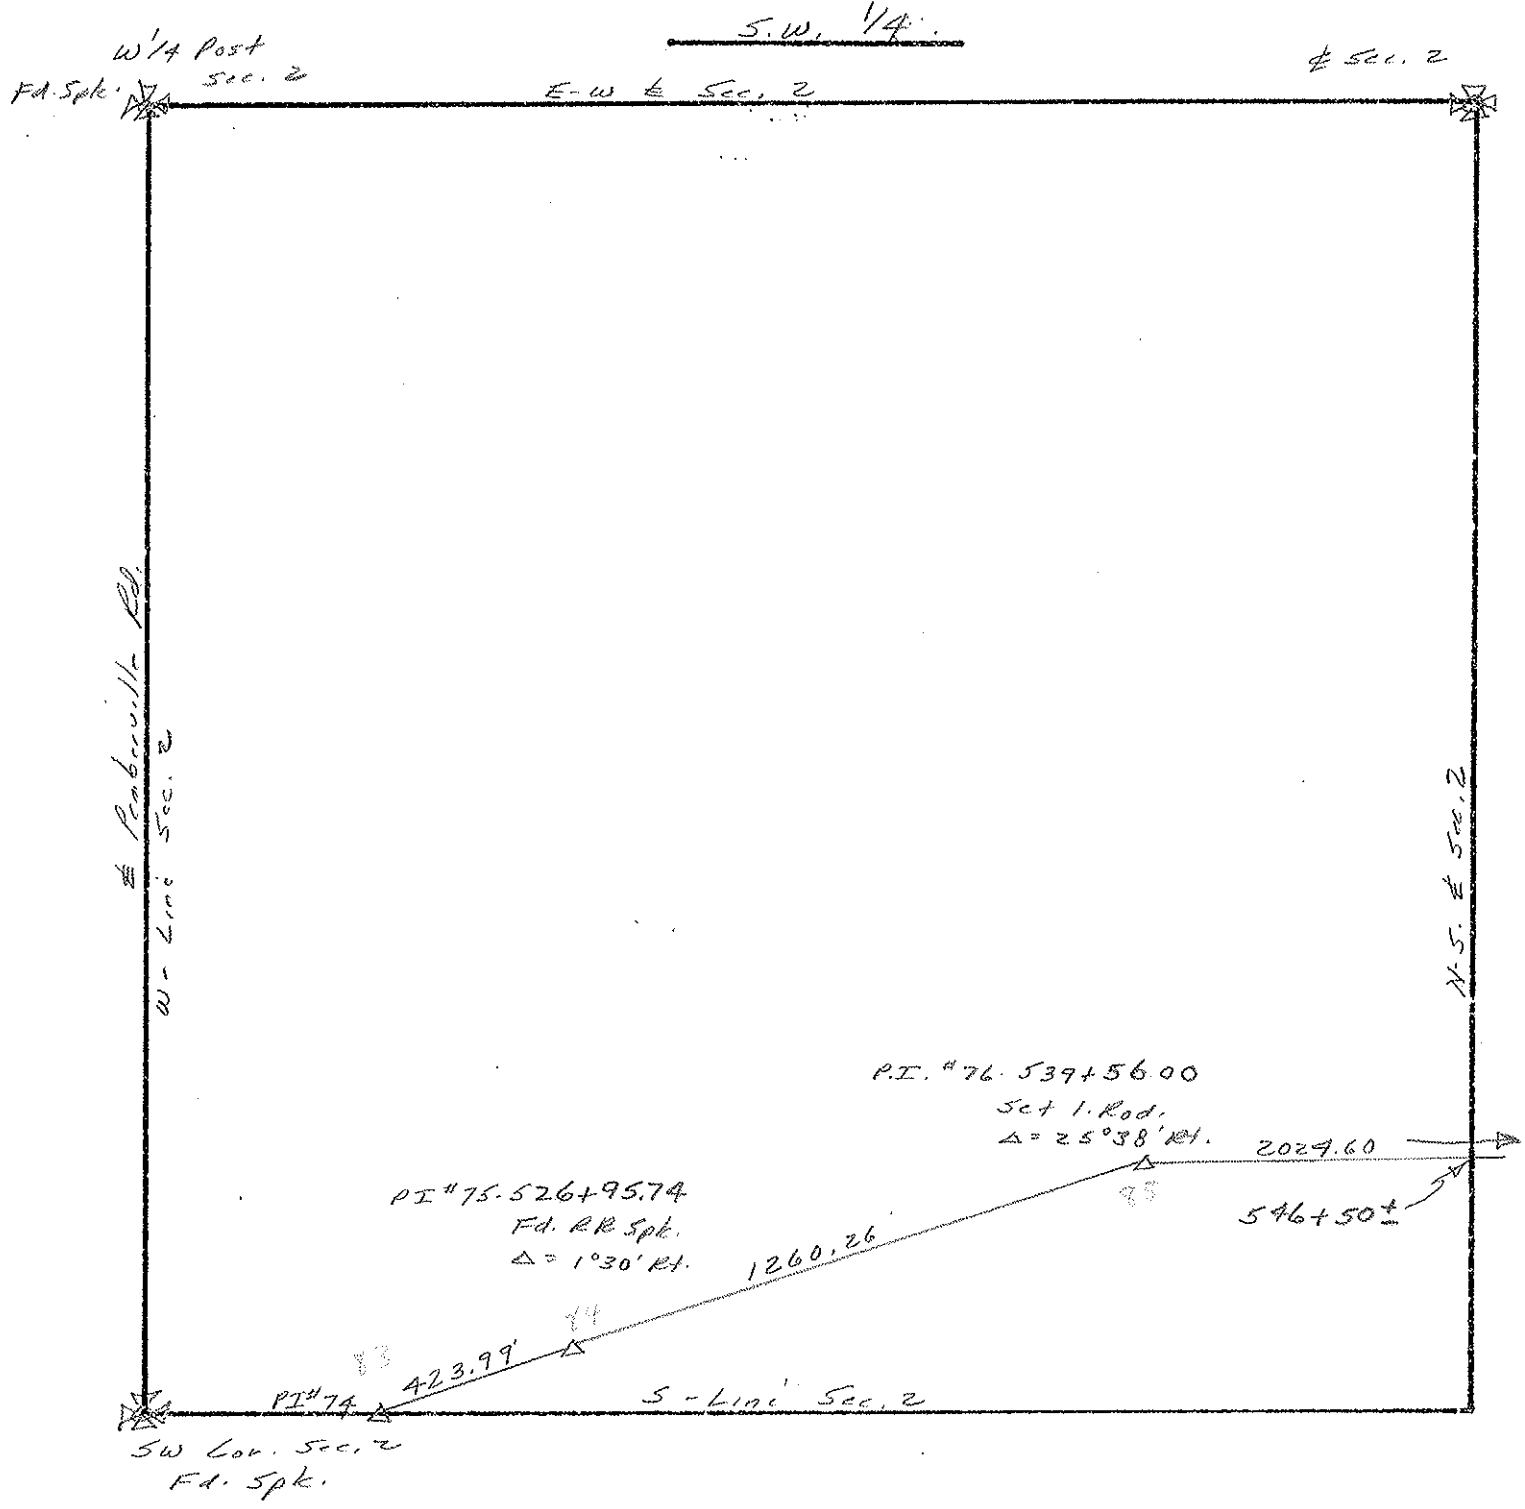


PERSONNEL	TITLE	COUNTY <u>Wood</u>	SHEET NO. <u>21-A</u>
<u>L. Stone</u>	_____	S.R. <u>105</u>	DATE <u>13 Feb. 74</u>
<u>R. Michalok</u>	_____	SECTION <u>2</u>	WEATHER <u>Fair</u>
<u>W. Deming</u>	_____	TWP <u>Freedom</u>	TEMP. <u>40°</u>
<u>D. Curtis</u>	_____	RANGE <u>12-E</u>	JOB NO. _____
_____	_____	TOWN <u>5-N</u>	

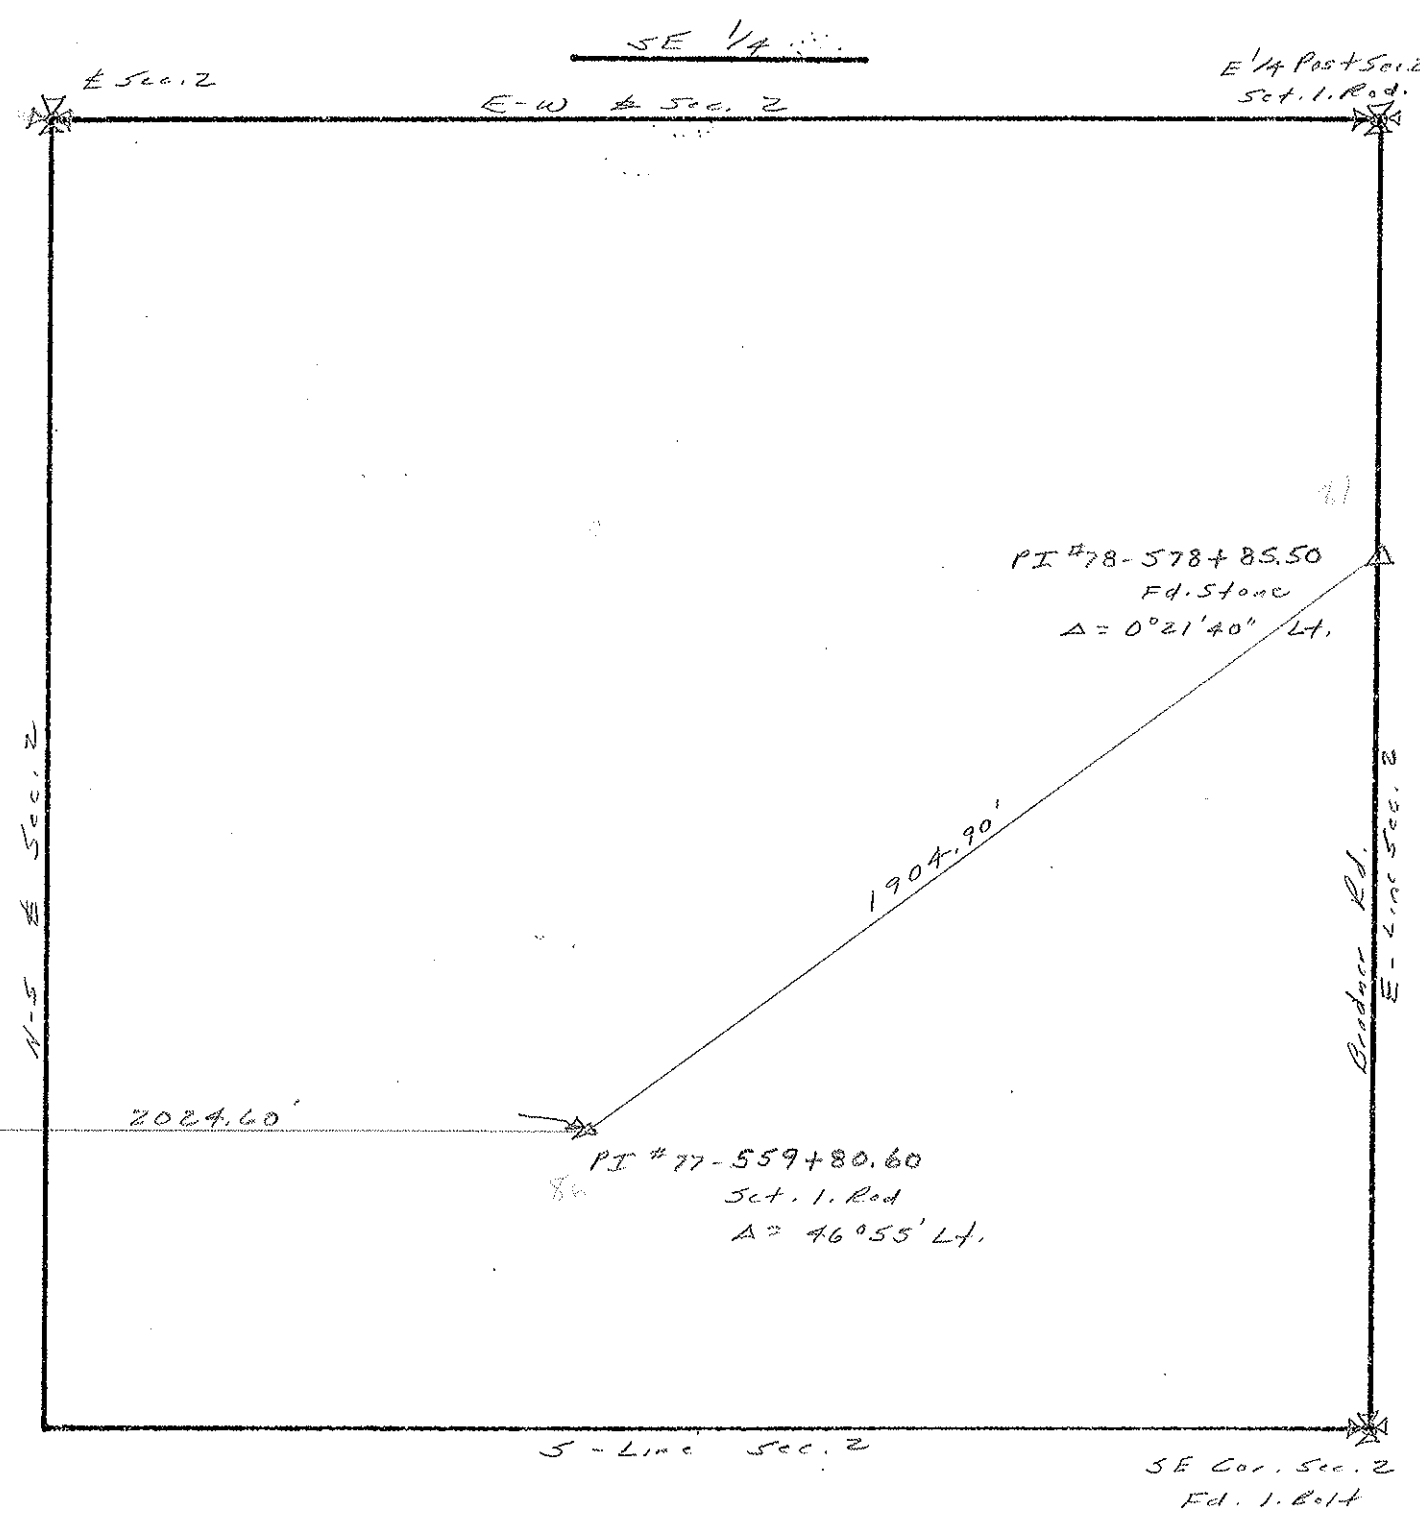


PERSONNEL	TITLE
<u>L. Stone</u>	_____
<u>R. Michalak</u>	_____
<u>W. Dennis</u>	_____
<u>D. Curtis</u>	_____
_____	_____
_____	_____

COUNTY <u>Wood</u>	SHEET NO. <u>22-A</u>
S.R. <u>105</u>	DATE <u>13 Feb. 74</u>
SECTION <u>1</u>	WEATHER <u>Fair</u>
TWP <u>Freedom</u>	TEMP. <u>40°</u>
RANGE <u>12-E</u>	JOB NO. _____
TOWN <u>5-N.</u>	

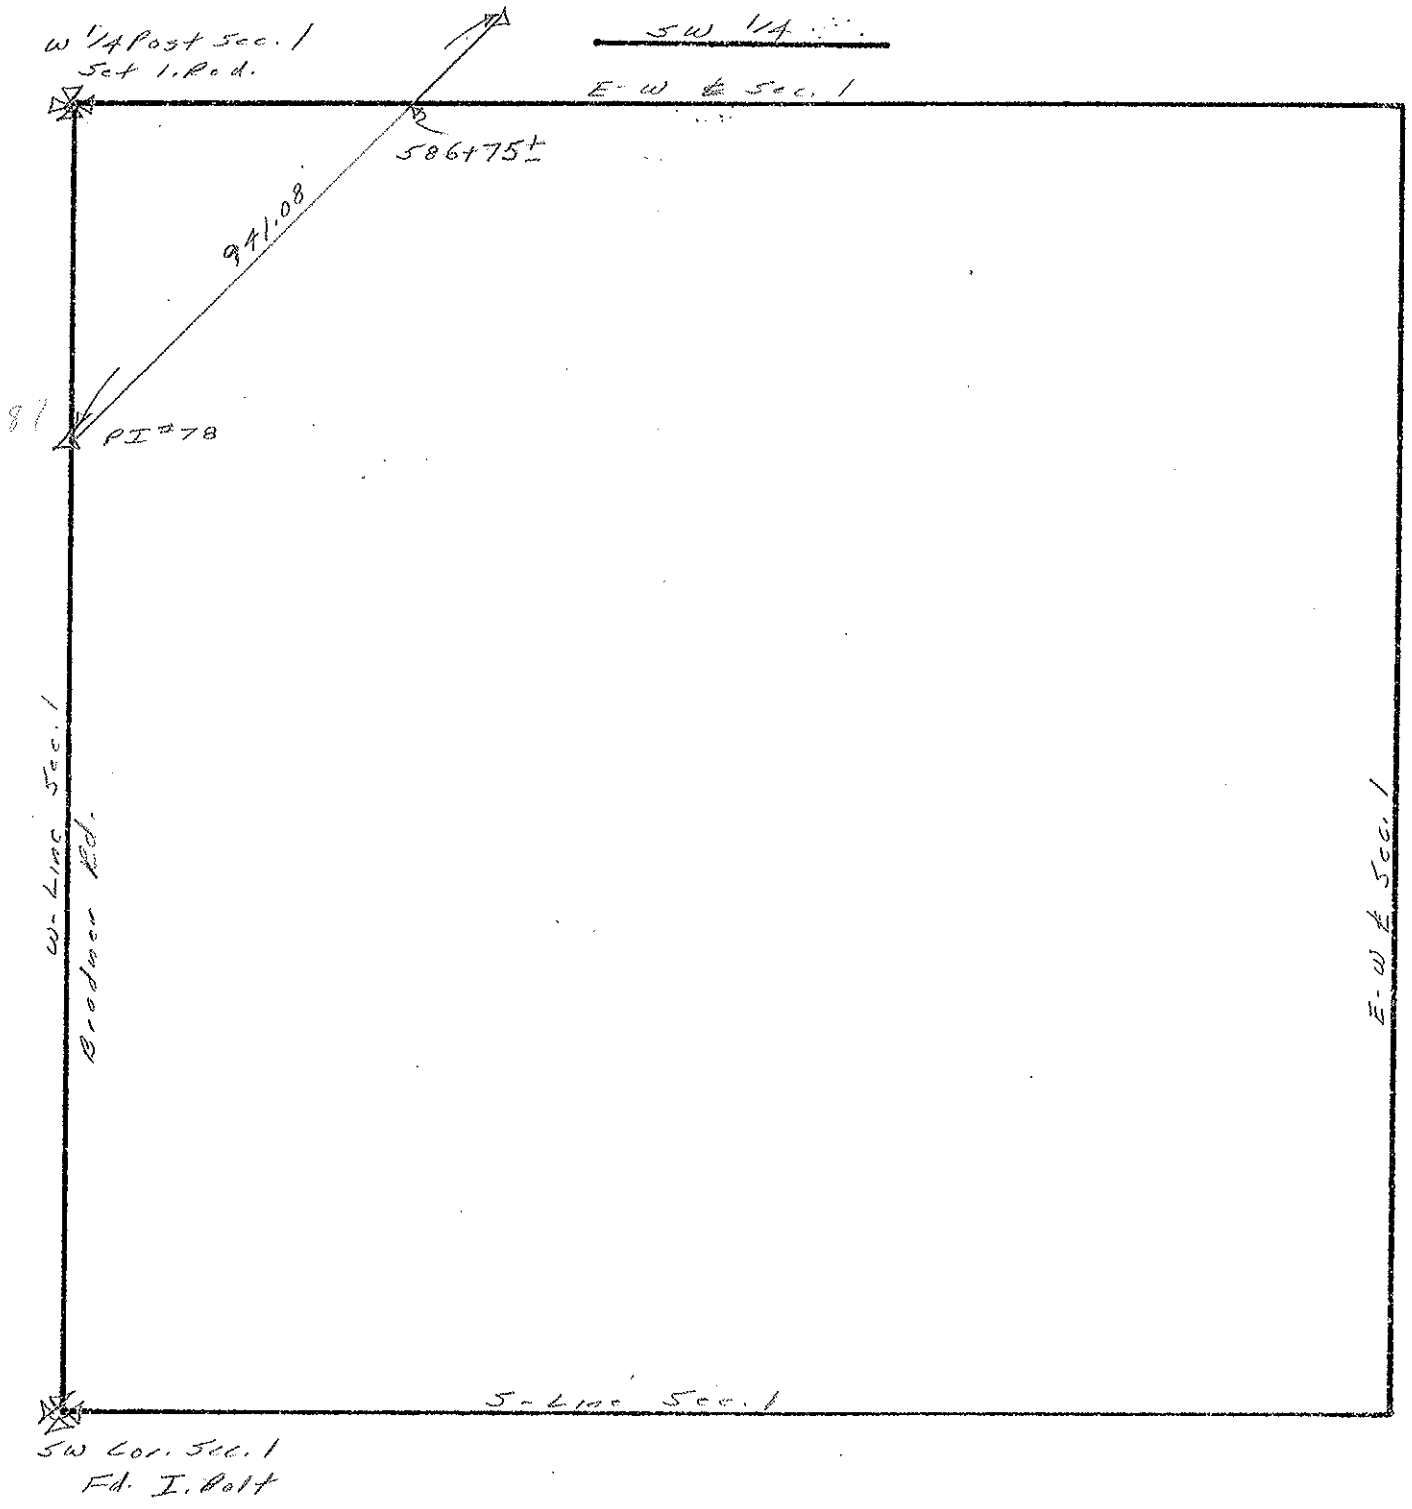


PERSONNEL	TITLE	COUNTY <u>Wood</u>	SHEET NO. <u>23-A</u>
<u>I. Stone</u>	_____	S.R. <u>105</u>	DATE <u>13 Feb. 79</u>
<u>P. Micholok</u>	_____	SECTION <u>1</u>	WEATHER <u>Fair</u>
<u>W. Drenge</u>	_____	TWP <u>Freeborn</u>	TEMP. <u>40°</u>
<u>D. Cordis</u>	_____	RANGE <u>12-E</u>	JOB NO. _____
_____	_____	TOWN <u>5-N</u>	

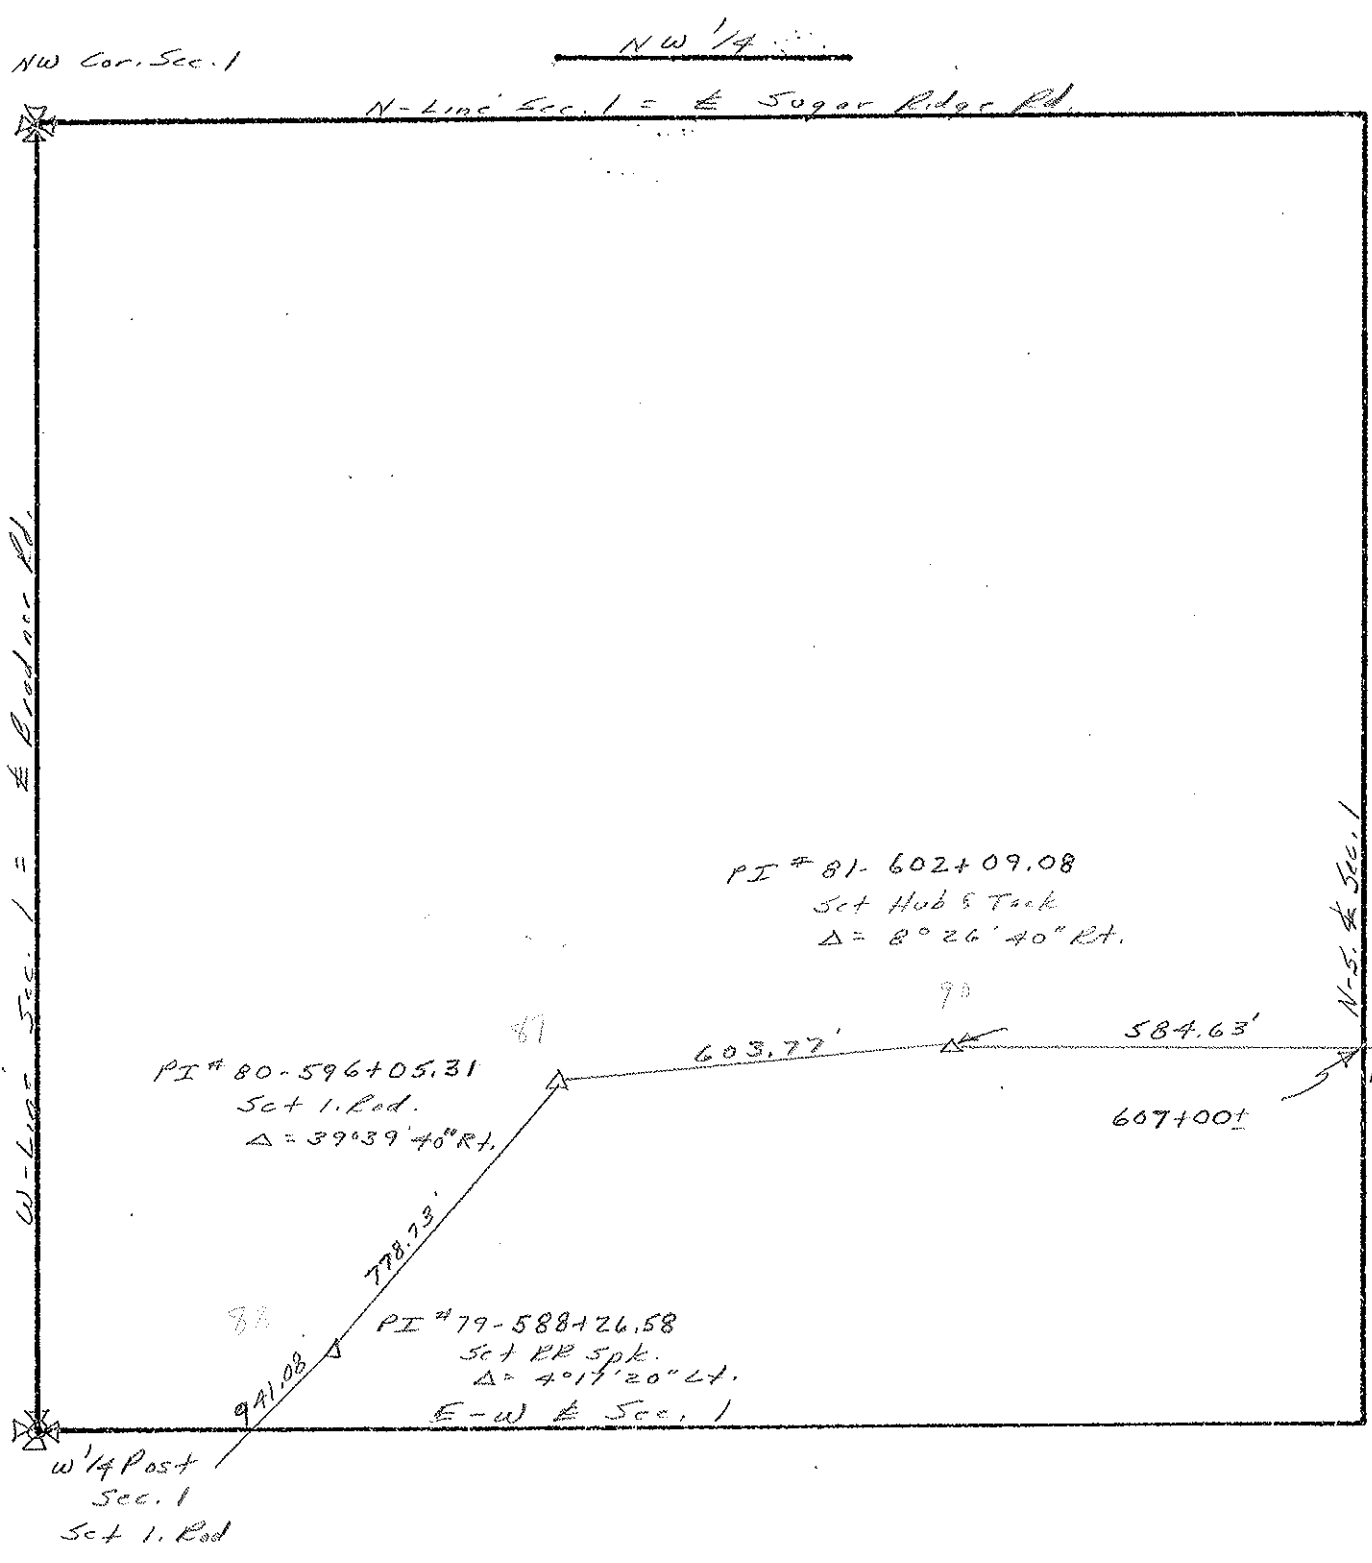

607

PERSONNEL	TITLE	COUNTY <u>Wood</u>	SHEET NO. <u>24-A</u>
<u>L. Stone</u>	_____	S.R. <u>105</u>	DATE <u>13 Feb. 74</u>
<u>R. Micholok</u>	_____	SECTION <u>1</u>	WEATHER <u>Fair</u>
<u>W. Danna</u>	_____	TWP <u>Freedom</u>	TEMP. <u>40°</u>
<u>D. Curtis</u>	_____	RANGE <u>12-E</u>	JOB NO. _____
_____	_____	TOWN <u>5-N</u>	

NE 1/4

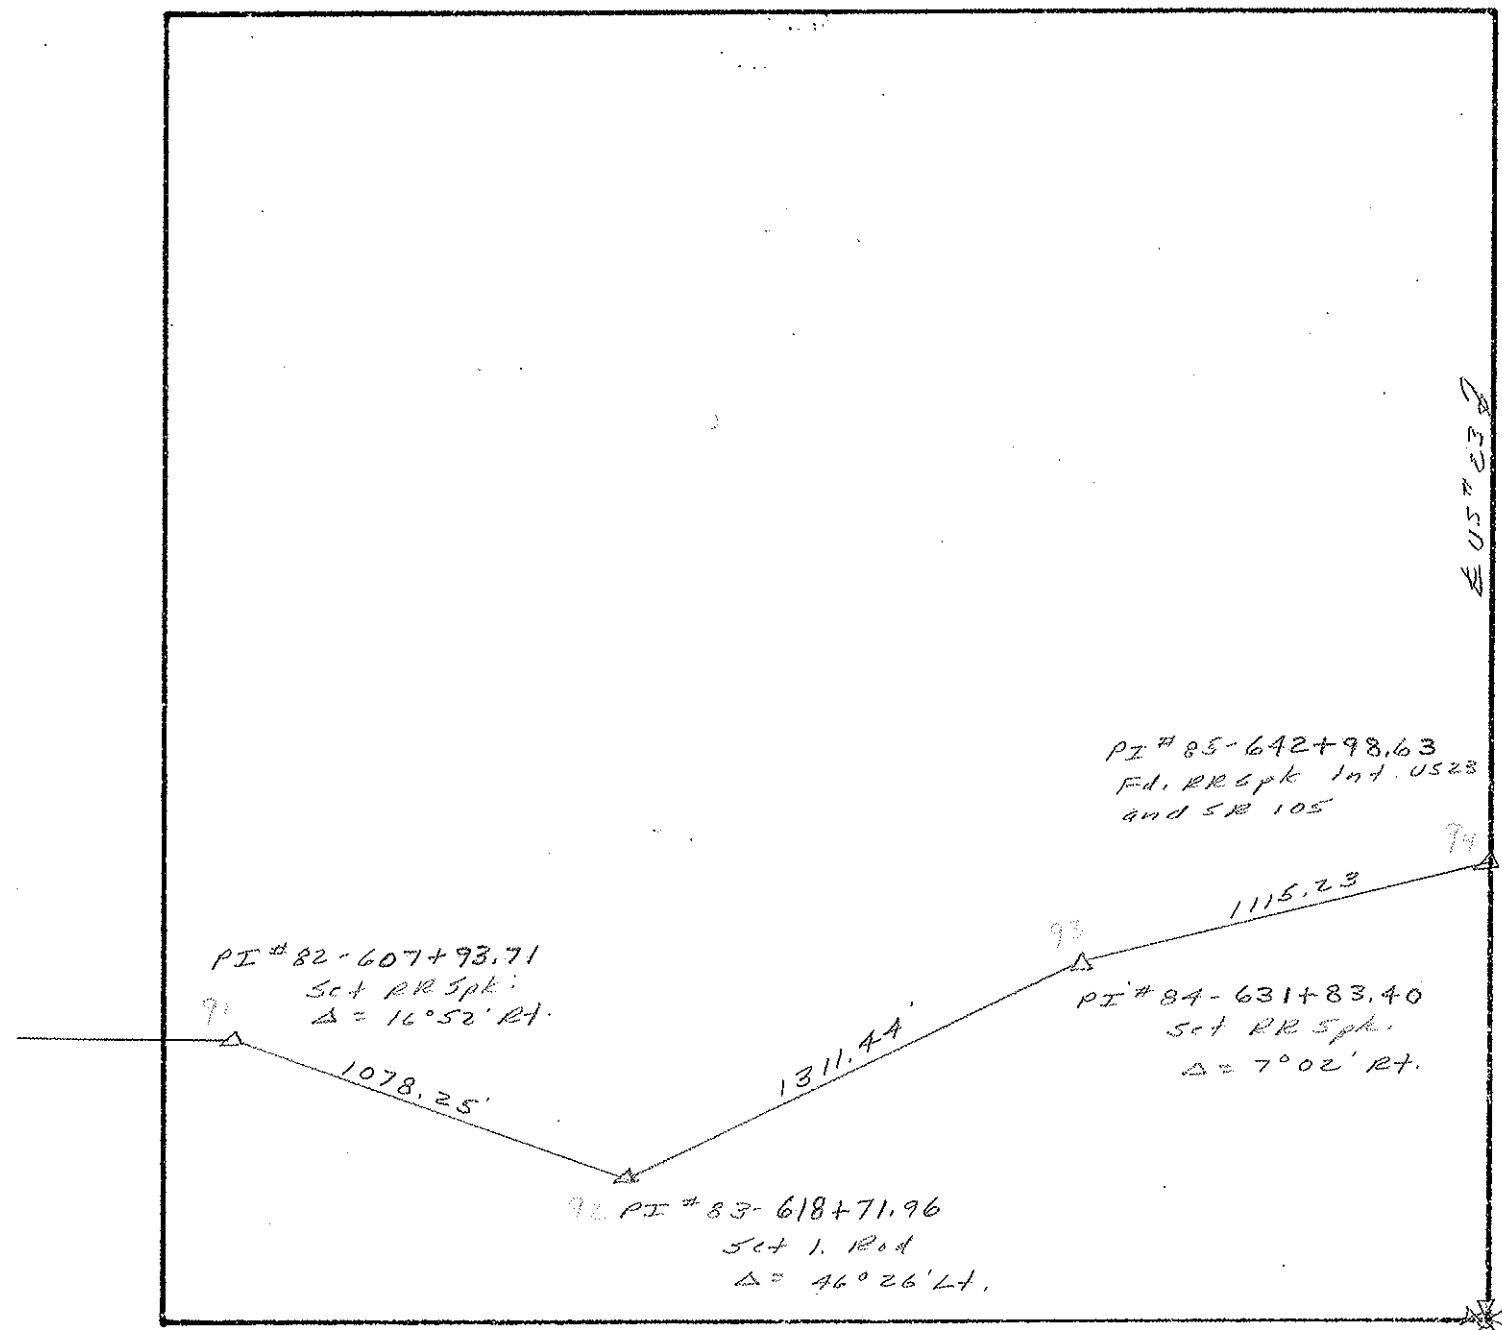

E 1/4 Past Sec. 1
Ed. RR Nail