


O.D.O.T. DISTRICT 2 SURVEY OFFICE (USE ONLY)

PERSONNEL \_\_\_\_\_ REFERENCE NO. C 1 SHEET 3 OF 28


NOTES RHOADES DATE 9/9/16 ROUTE SR 105  
 H.C. O'DONNELL WEATHER FAIR COUNTY WOOD  
 R.C. RHOADES TEMP. 76° TOWNSHIP CENTER  
 SECTION 21  
T 5 N R 11 E

TYPE MONUMENT P.K./WASHER  
 ON SURFACE - ~~BELOW~~ ON  
~~LEFT~~ - CL PAV'T - RIGHT 4.6'  
7' TO RT EDGE PAVEMENT  
 S.L.M. 49+11

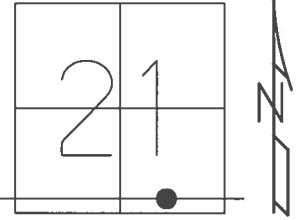

GRID: NORTHING: 624058.634 EASTING: 1666391.349

RECORD:  
 ORIGIN UNKNOWN  
 FD P.K./WASHER  
 4/6/02, DCH  
 SET P.K./WASHER  
 5/31/02, DCH  
 FD P.K./WASHER  
 REFC1  
 6/2/16, JFO

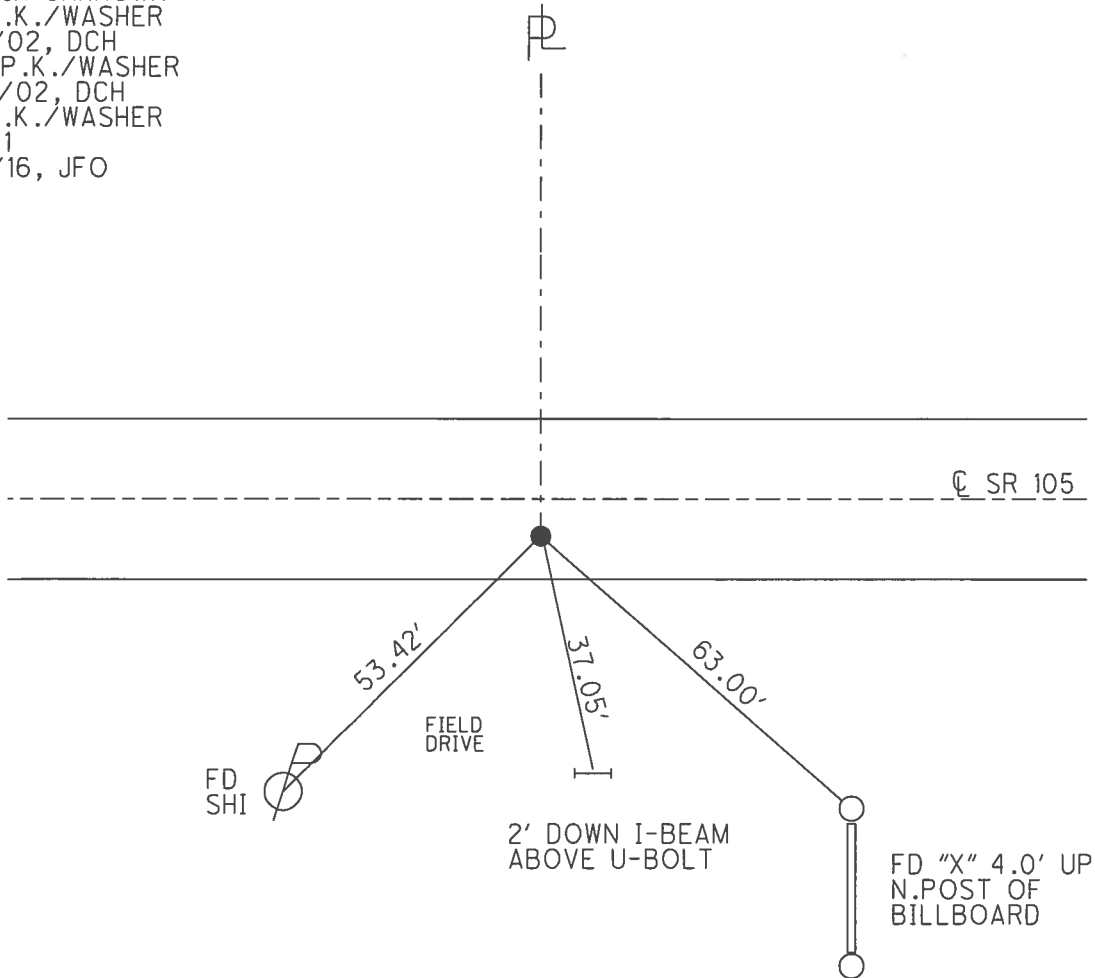


FD "X" 4.0' UP  
 N.POST OF  
 BILLBOARD


**O.D.O.T. DISTRICT 2 SURVEY OFFICE (USE ONLY)**

PERSONNEL \_\_\_\_\_ REFERENCE NO. C 1 SHEET 3 OF 21  
 NOTES MOSER DATE 4/6/02 ROUTE SR 105  
 H.C. HOMAN WEATHER PT CLOUDY COUNTY WOOD  
 R.C. ROUSOS TEMP. 40° TOWNSHIP CENTER  
CANTERBURY SECTION 21  
T 5 N R 11 E

TYPE MONUMENT P.K./WASHER  
 ON SURFACE - ~~BELOW~~ ON  
~~LEFT~~ - CL PAV'T - RIGHT 4.6'  
7' TO RT EDGE PAVEMENT  
 S.L.M. 49+11  
 GRID: NORTHING: \_\_\_\_\_ EASTING: \_\_\_\_\_

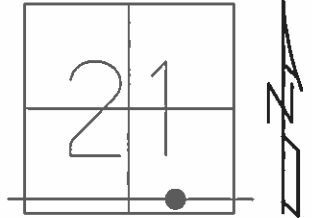

RECORD:  
 ORIGIN UNKNOWN  
 SET P.K./WASHER  
 5/31/02, DCH

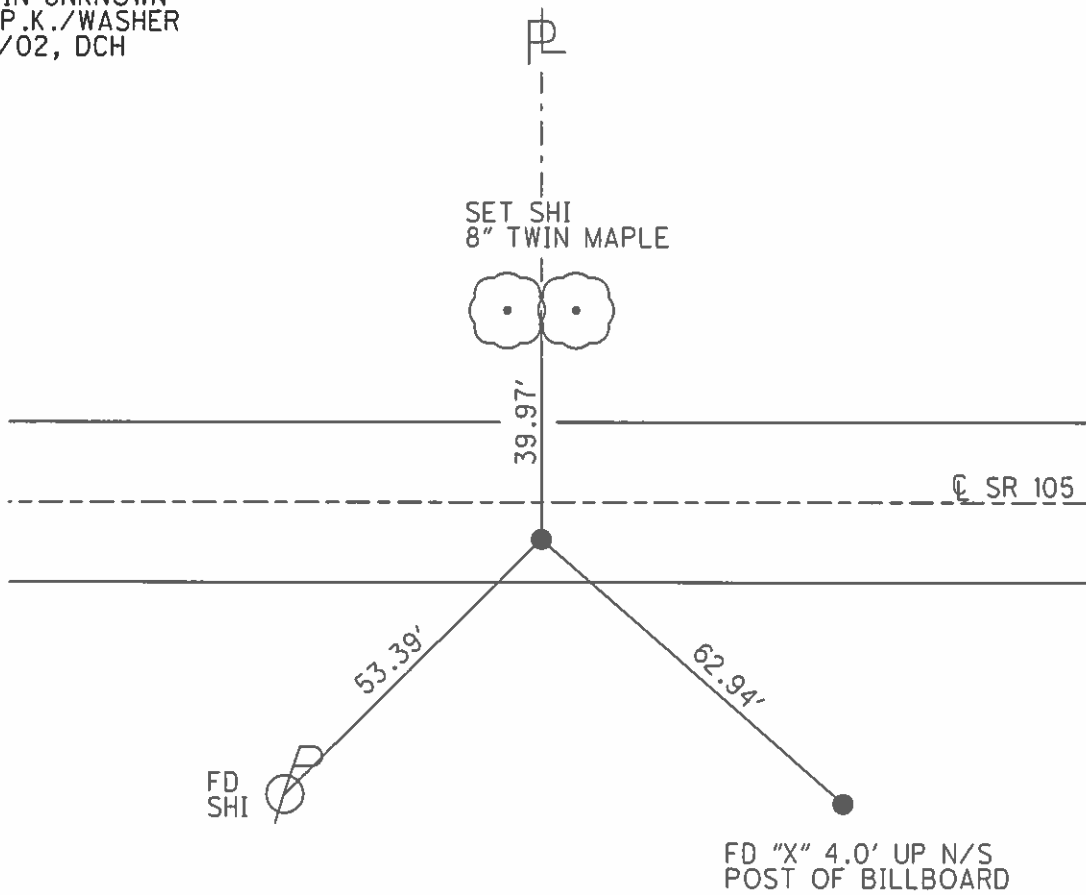

# O.D.O.T. DISTRICT 2 SURVEY OFFICE

PERSONNEL

REFERENCE NO. C-1

SHEET 2 OF 57

NOTES LONG

H.C. VAN DUSEN

R.C. BARNHISEL

DATE 8-12-91

WEATHER SUNNY

TEMP. 88°

ROUTE 105

COUNTY WOOD

TOWNSHIP CENTER

SECTION 21

T 5 N R 11 E


TYPE MONUMENT PK&WASHER

ON SURFACE - BELOW YES

LEFT- & PAV'T. - RIGHT 4.6'


7.0' TO RT. EDGE PAVEMENT

S.L.M. 49+11

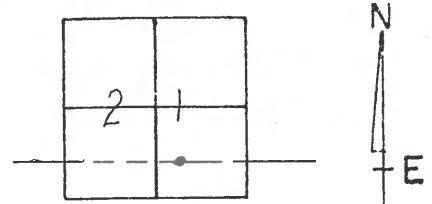

SET PK&WASHER  
 4-8-92  
 BVD

RECORD: ORIGINAL UNKNOWN

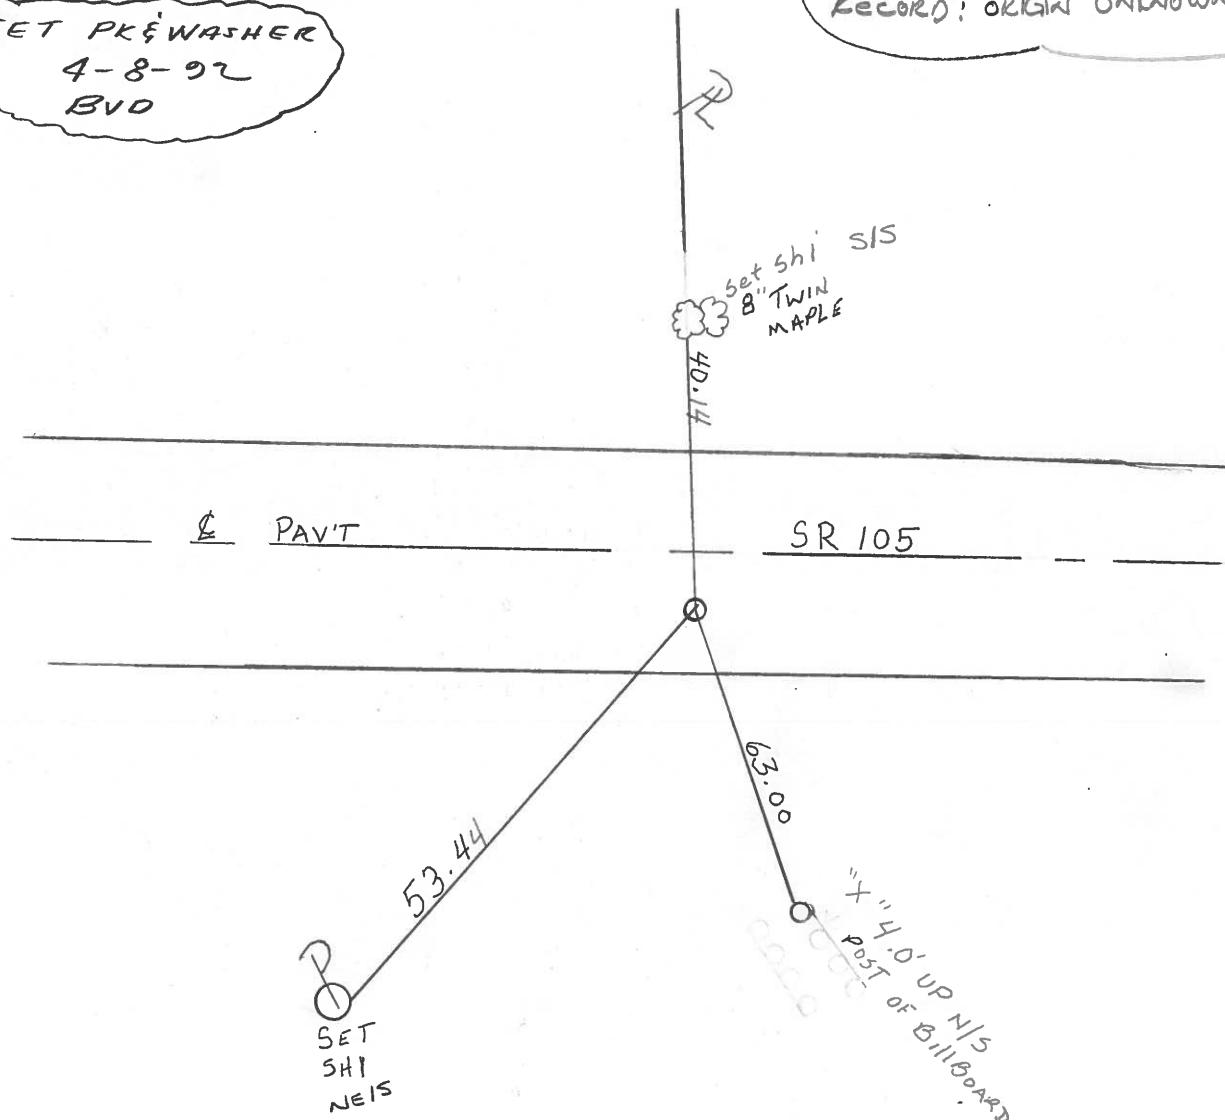

County WOOD S.R. 105

Township CENTER

Section 21

T&N, R11E

Personnel Hoffman

LOSHKOE H.C.

Housholder R.C.


Barnhisel A

Date 8-16-84

Weather CLEAR

Temp. 75°

C1

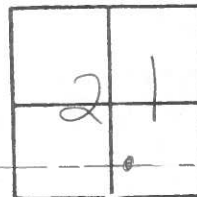

Fd. P.K.'s @ surface ORIGIN UNKNOWN

SLM 51+11

Set P.K. / washer  
9-27-84  
SWS

4.5' RT of & Pavt  
6.3' TO RT EP  
15.4' TO LT. EP

