


O.D.O.T. DISTRICT 2 SURVEY OFFICE (USE ONLY)


PERSONNEL _____ REFERENCE NO. G SHEET 7 OF 28
 NOTES MOSE DATE 4/6/02 ROUTE SR 105
 H.C. HOMAN WEATHER PT CLOUDY COUNTY WOOD
 R.C. ROUSOS TEMP. 40 TOWNSHIP CENTER
CANTERBURY SECTION 22
 T 5 N R 11 E

TYPE MONUMENT P.K./WASHER
 ON SURFACE - ~~BELOW~~ ON _____
~~LEFT~~ - CL PAV'T - RIGHT 0.5'
11.2' TO RT EDGE PAVEMENT
 S.L.M. 107+49

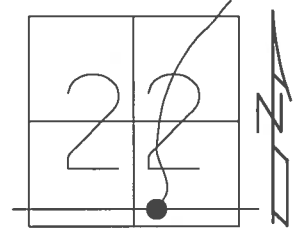

GRID: NORTHING: _____ EASTING: _____

RECORD:
 SET P.K./WASHER
 5-31-02, DCH
 D.N.F.
 6/2/16, JFO

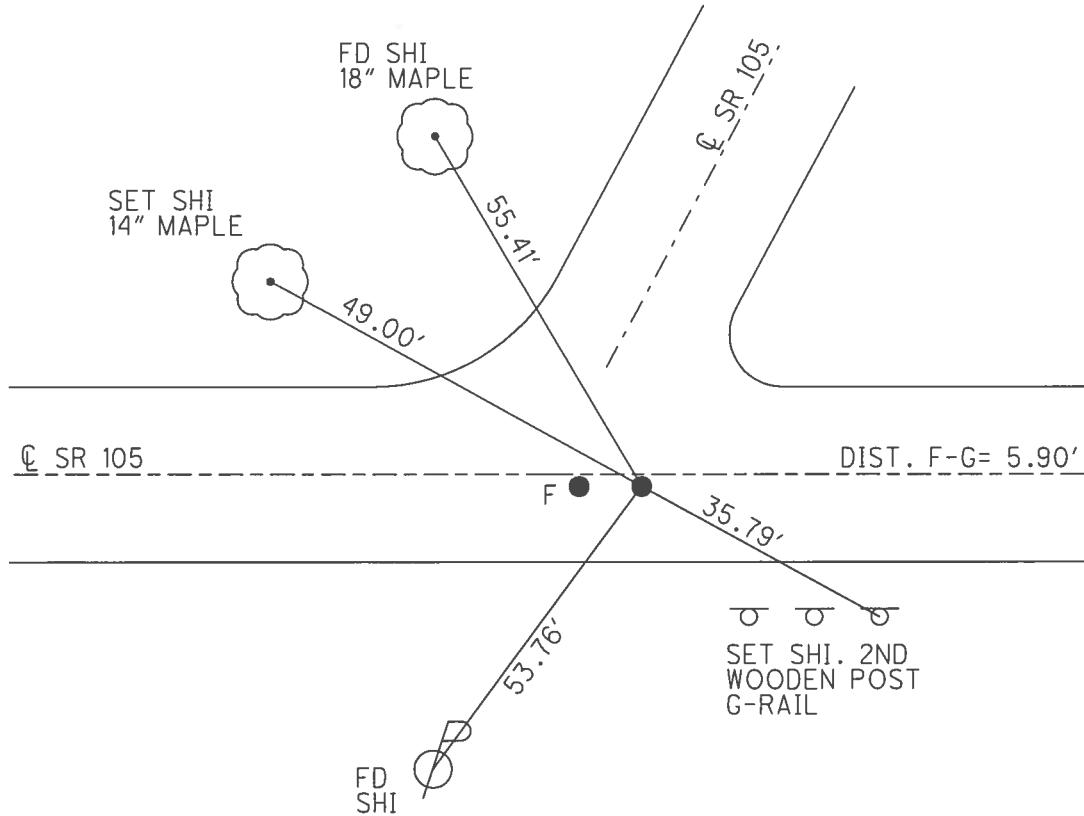


O.D.O.T. DISTRICT 2 SURVEY OFFICE (USE ONLY)

PERSONNEL _____ REFERENCE NO. G SHEET 7 OF 21

NOTES MOSER DATE 4/6/02 ROUTE SR 105
 H.C. HOMAN WEATHER PT CLOUDY COUNTY WOOD
 R.C. ROUSOS TEMP. 40 TOWNSHIP CENTER
CANTERBURY SECTION 22
T 5 N R 11 E

TYPE MONUMENT P.K./WASHER
 ON SURFACE - ~~BELOW~~ ON
~~LEFT~~ - Q PAV'T - RIGHT 0.5'
11.2' TO RT EDGE PAVEMENT
 S.L.M. 107+49

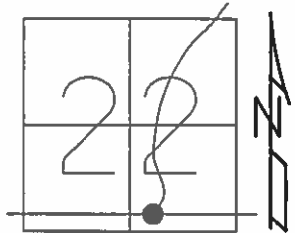

GRID: NORTHING: _____ EASTING: _____

RECORD:
 SET P.K./WASHER
 5-31-02, DCH

