


O.D.O.T. DISTRICT 2 SURVEY OFFICE (USE ONLY)


PERSONNEL _____ REFERENCE NO. 1 SHEET 8 OF 28
 NOTES MOSER DATE 4/6/02 ROUTE SR 105
 H.C. HOMAN WEATHER PT CLOUDY COUNTY WOOD
 R.C. ROUSOS TEMP. 40° TOWNSHIP CENTER
CANTERBURY SECTION 22
 T 5 N R 11 E

TYPE MONUMENT 1" IPIPE
~~ON SURFACE~~ - BELOW 8"
~~LEFT~~ - CL PAV'T - RIGHT 20.7'
9.1' TO RT EDGE PAVEMENT
 S.L.M. 107+44

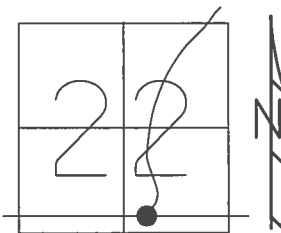

GRID: NORTHING: 623898.247 EASTING: 1672232.362


RECORD: 1972
 SET 1" IPIPE
 AS PER PLAN
 STA: 107+71.20
 FD 1" IPIPE
 6" DOWN
 REF1
 6/2/16, JFO

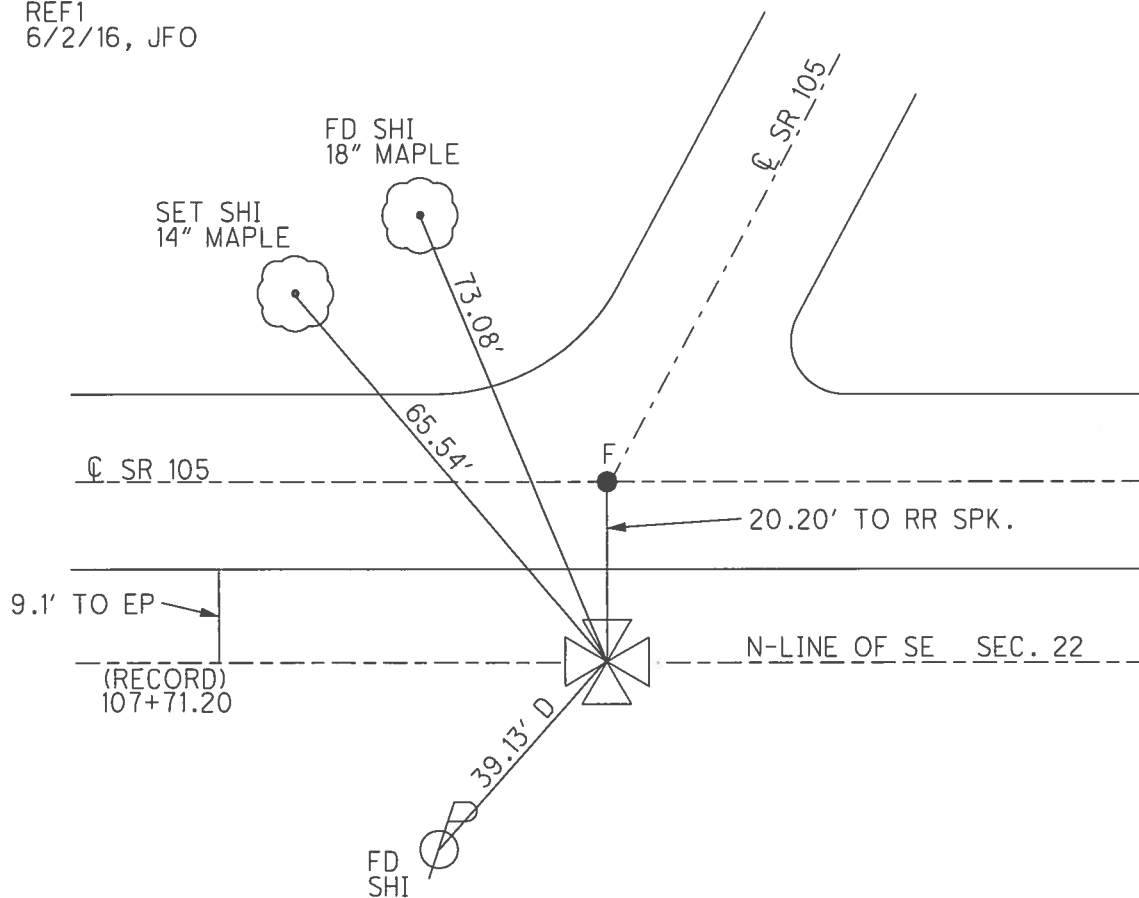

O.D.O.T. DISTRICT 2 SURVEY OFFICE (USE ONLY)


PERSONNEL	REFERENCE NO. <u>1</u>	SHEET <u>8</u> OF <u>21</u>
NOTES <u>MOSER</u>	DATE <u>4/6/02</u>	ROUTE <u>SR 105</u>
H.C. <u>HOMAN</u>	WEATHER <u>PT CLOUDY</u>	COUNTY <u>WOOD</u>
R.C. <u>ROUSOS</u>	TEMP. <u>40°</u>	TOWNSHIP <u>CENTER</u>
<u>CANTERBURY</u>		SECTION <u>22</u>
		<u>T 5 N R 11 E</u>

TYPE MONUMENT 1" IPIPE
~~ON SURFACE~~ - **BELOW** 8"
~~LEFT~~ - **CL PAV'T** - **RIGHT** 20.7'
9.1' **TO RT** **EDGE PAVEMENT**
S.L.M. 107+44

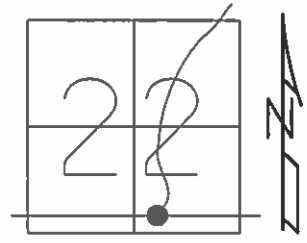

GRID: NORTHING: _____ **EASTING:** _____

RECORD: 1972
 SET 1" IPIPE
 AS PER PLAN
 STA: 107+71.20

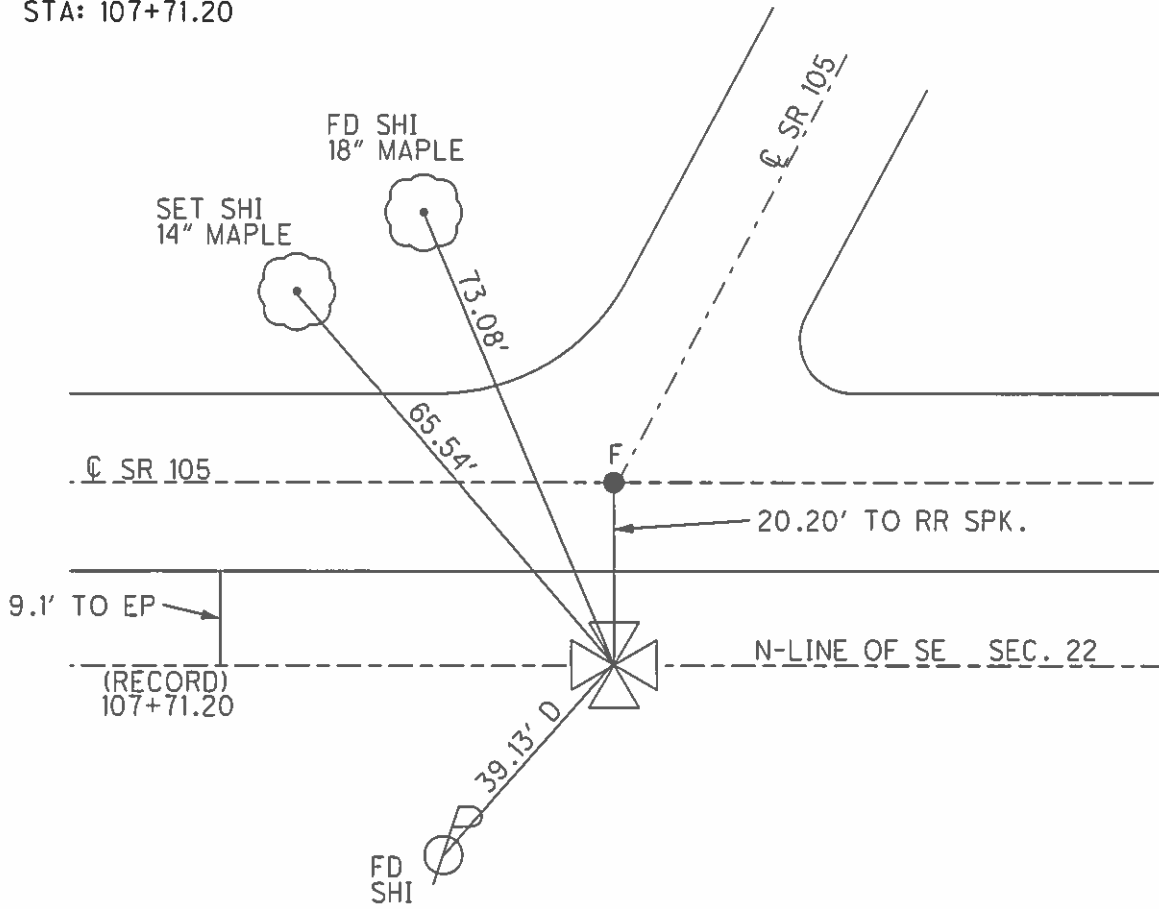

O.D.O.T. DISTRICT 2 SURVEY OFFICE

PERSONNEL _____

REFERENCE NO. 1

SHEET 6 OF 57

NOTES LONG

H.C. VAN DUSEN

R.C. BARNHISEL

DATE 8-12-91

WEATHER SUNNY

TEMP. 85°

ROUTE 105

COUNTY WOOD

TOWNSHIP CENTER

SECTION 22

T 5 N R 11 E



TYPE MONUMENT 1" IRON PIPE

ON SURFACE - ~~BELOW~~ YES

LEFT - ~~C~~ PAV'T. - RIGHT 20.7

9.1 ~~TO~~ RT OF EDGE PAVEMENT

S.L.M. 107+44

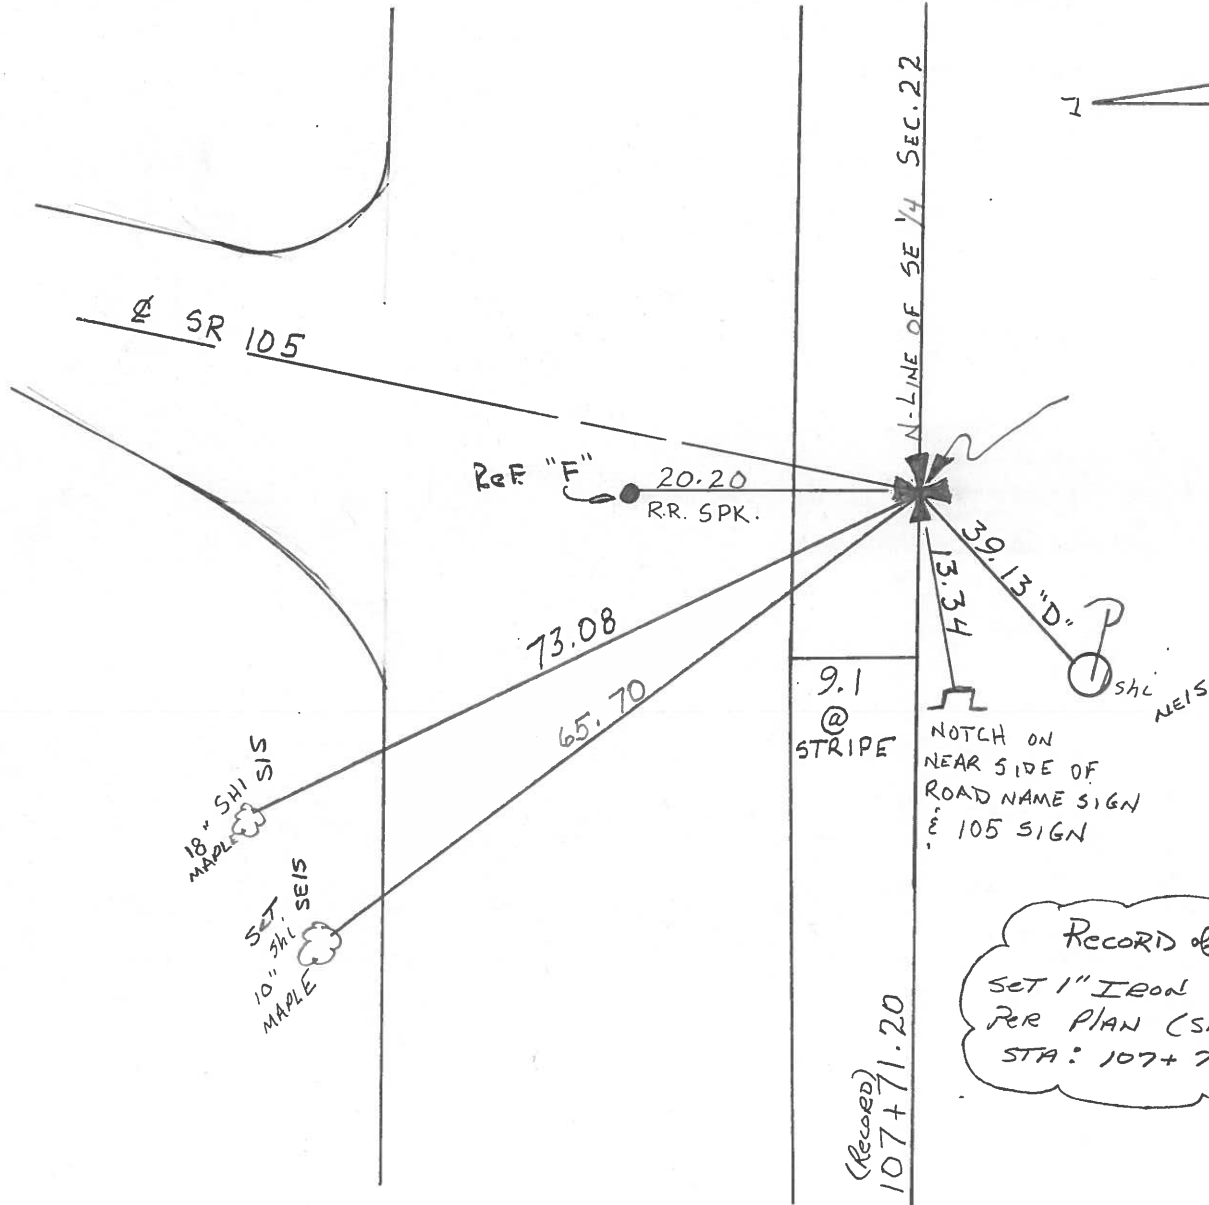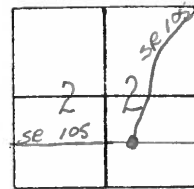

RECORD of 1972
 SET 1" IRON PIPE AS
 PER PLAN (SLM)
 STA: 107+71.20

Q.D.O.T. DISTRICT 2 SURVEY OFFICE

SHEET _____ OF _____

County WOOD S.R. 105

Date 4-19-82

Township CENTER

Weather CLEAR

Section 22


Temp. +65°

T_N, R_E


Personnel HOFFMAN

LOEHRKE

HOUSEHOLDER

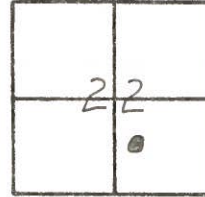

#1

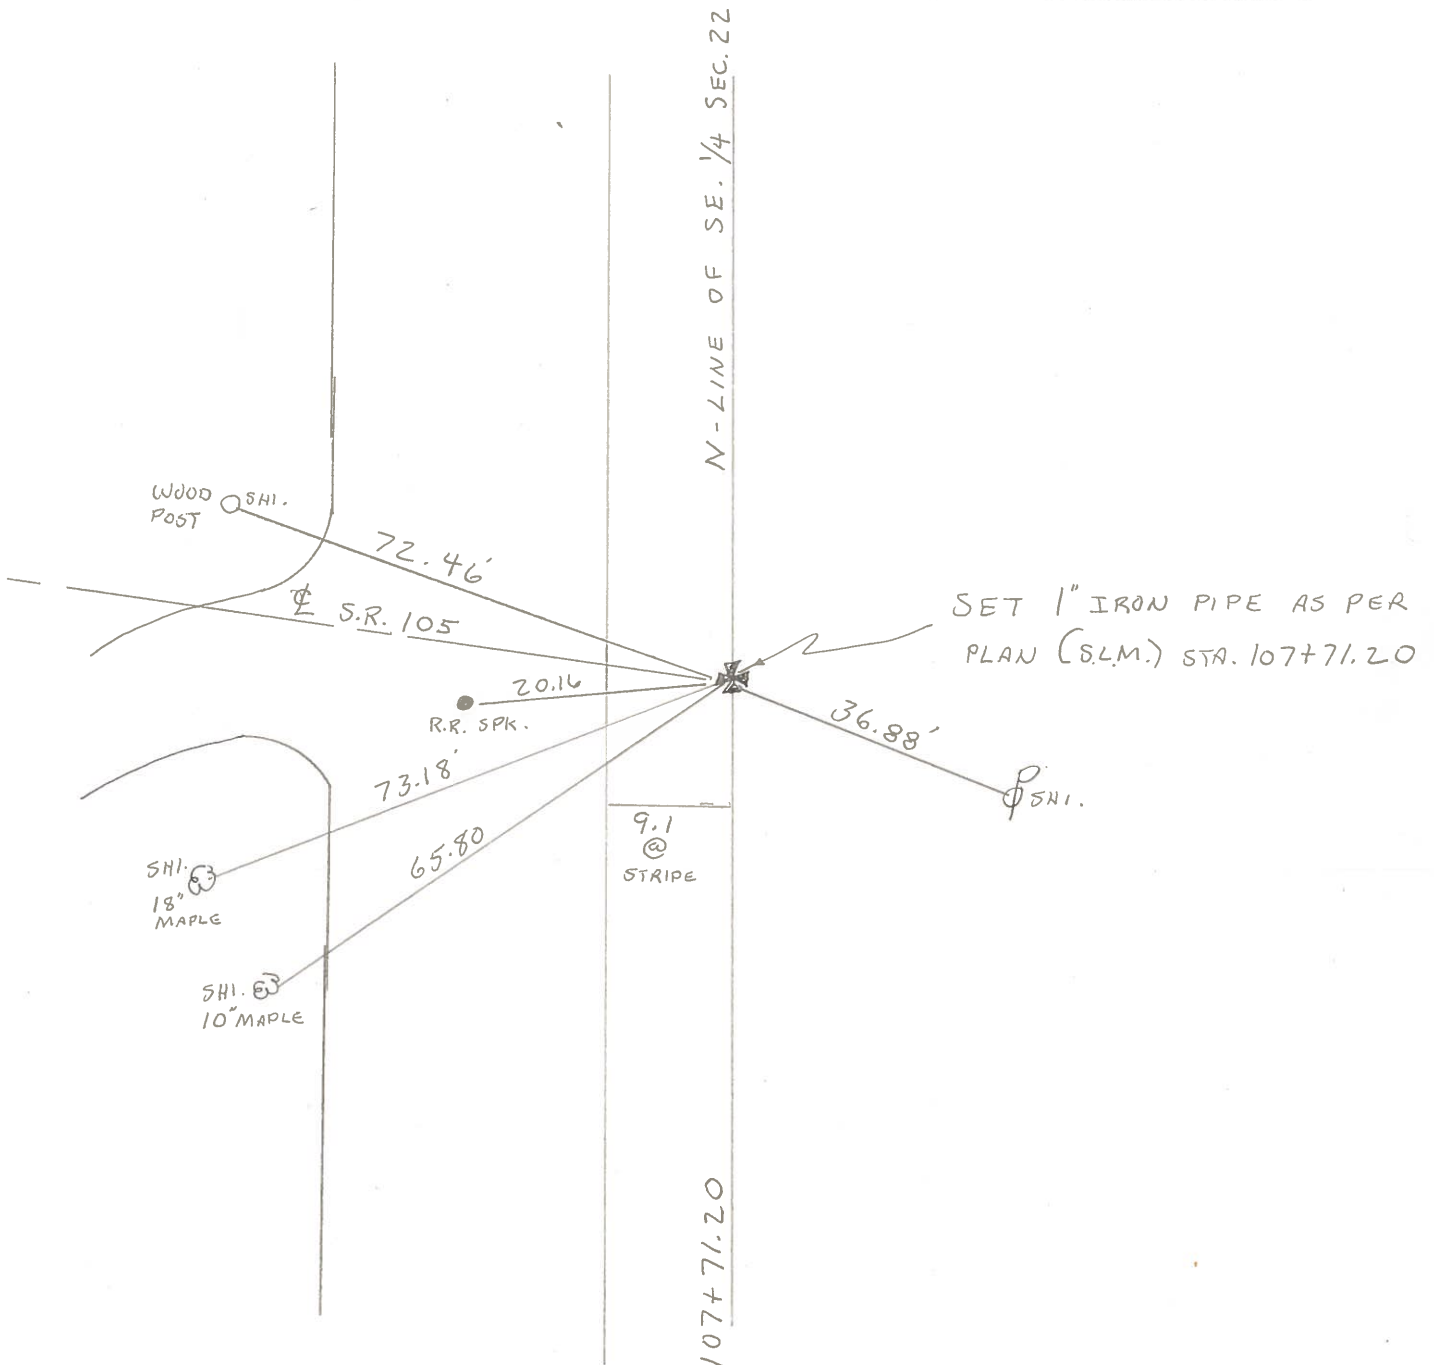

PERSONNEL	TITLE	PERSONNEL	TITLE	COUNTY	DATE
<u>Stone</u>	<u>Notes</u>			<u>Wood</u>	<u>25 Aug, 72</u>
<u>Michalak</u>	<u>R.C.</u>			<u># 105</u>	<u>Humid</u>
<u>Danno</u>	<u>H.C.</u>			<u>22</u>	<u>85°</u>
<u>Curtis</u>	<u>R</u>				

DESCRIPTION References to Control Points JOB NO. _____

