


O.D.O.T. DISTRICT 2 SURVEY OFFICE (USE ONLY)


PERSONNEL _____ REFERENCE NO. 6 SHEET 13 OF 28
 NOTES RHOADES DATE 9/9/16 ROUTE SR 105
 H.C. O'DONNELL WEATHER CLOUDY COUNTY WOOD
 R.C. RHOADES TEMP. 82° TOWNSHIP CENTER
 SECTION 22
T 5 N R 11 E

TYPE MONUMENT P.K./WASHER
 ON SURFACE - ~~BELOW~~ ON
~~LEFT~~ - CL PAV'T - RIGHT 0.6'
9.5' TO RT EDGE PAVEMENT
 S.L.M. 120+91

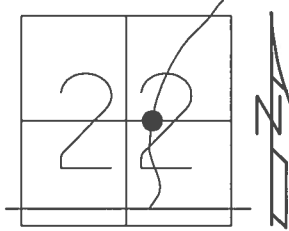

GRID: NORTHING: 625206.738 EASTING: 1672567.627

RECORD: P.I.
 STA. 121+36.38
 $\Delta = 1^\circ 54' RT$
 FD P.K./WASHER
 4/15/02, MB
 SET P.K./WASHER
 6/12/02, DCH
 FD
 P.K./WASHER
 REF6
 6/2/16, JFO
 SET 1" MAG/WASHER
 NEWREF6
 6/20/17, JFO

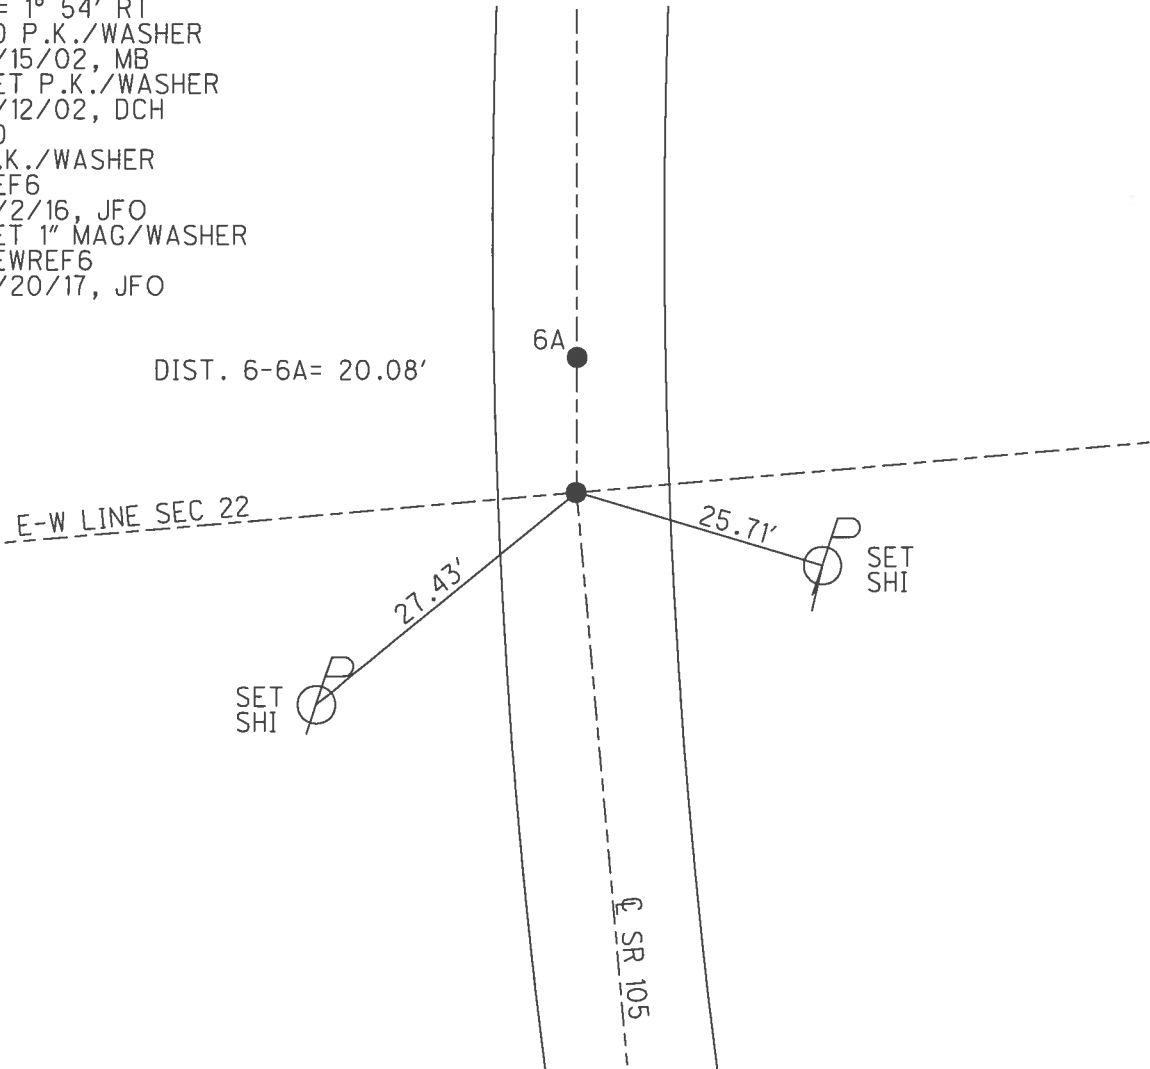


O.D.O.T. DISTRICT 2 SURVEY OFFICE (USE ONLY)

PERSONNEL _____ REFERENCE NO. 6 SHEET 13 OF 21


NOTES MOSE DATE 4/15/02 ROUTE SR 105
 H.C. CANTERBURY WEATHER CLEAR COUNTY WOOD
 R.C. BARNHISEL TEMP. 65° TOWNSHIP CENTER
 SECTION 22
T 5 N R 11 E

TYPE MONUMENT P.K./WASHER
 ON SURFACE - ~~BELOW~~ ON
~~LEFT~~ - CL PAV'T - RIGHT 0.6'
9.5' TO RT EDGE PAVEMENT
 S.L.M. 120+91

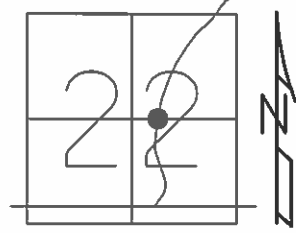

GRID: NORTHING: _____ EASTING: _____

RECORD: P.I.
 STA. 121+36.38
 $\Delta = 1^\circ 54' \text{ RT}$
 SET P.K./WASHER
 6/12/02, DCH

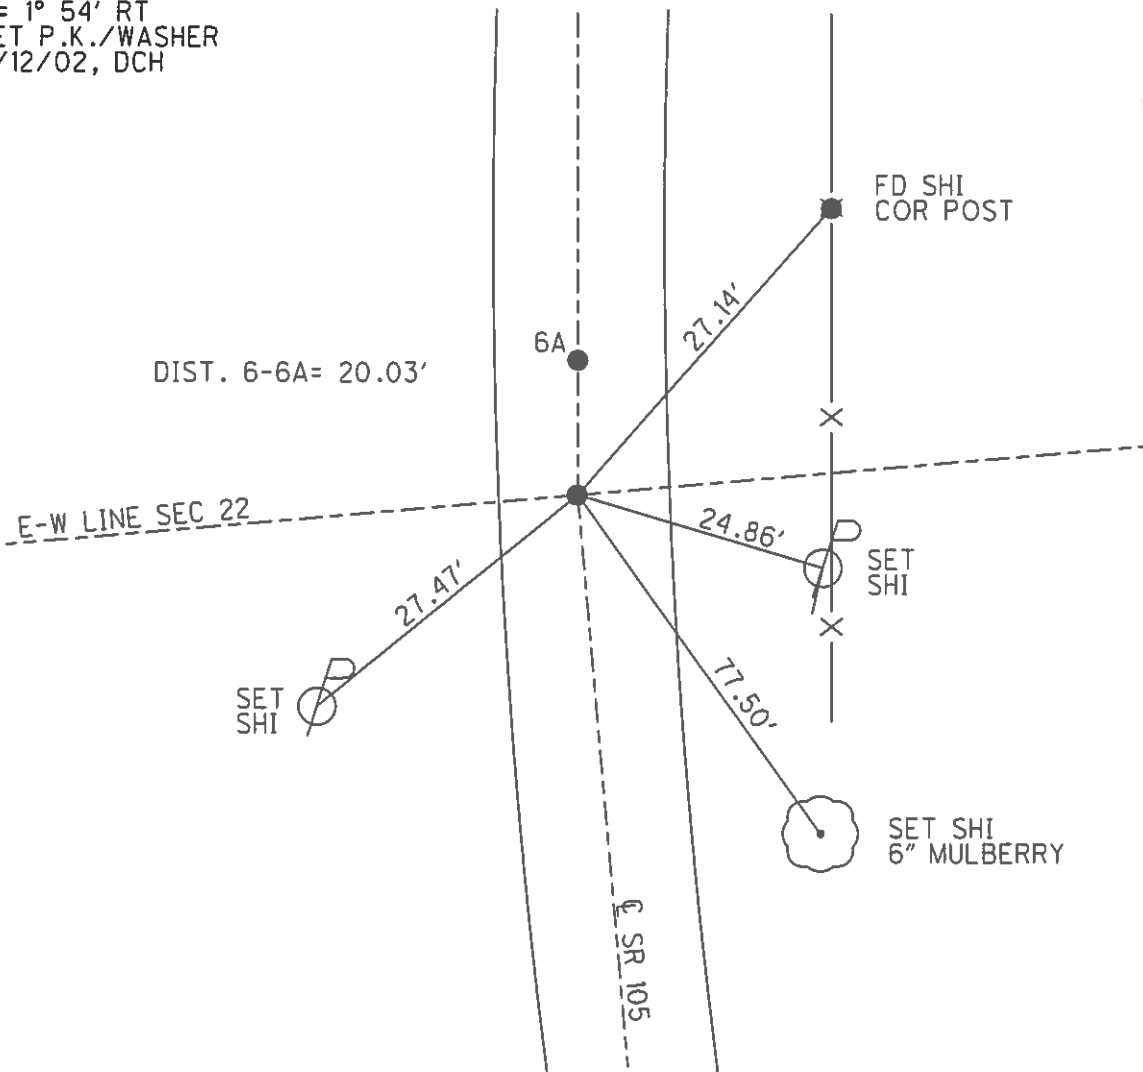

O.D.O.T. DISTRICT 2 SURVEY OFFICE

PERSONNEL _____

REFERENCE NO. 6

SHEET 11 OF 57

NOTES LONG

H.C. VAN DUSEN

R.C. _____

DATE 8-15-91

WEATHER CLEAR

TEMP. 85°

ROUTE 105

COUNTY WOOD

TOWNSHIP CENTER

SECTION 22

T 5 N R 11 E


TYPE MONUMENT P.K.'S & WASHER'S

ON SURFACE - ~~BELOW~~ YES

LEFT - 0.7' PT RIGHT - 1.0' B"

9.5 TO RT EDGE PAVEMENT

S.L.M. 120+91

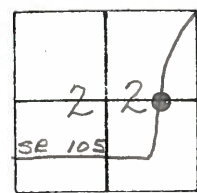


SET PK & WASHER
4-8-92
BVD

A=6
B=6A

RECORD
PI.#5
121+36.38
Δ=1°54'00" RT

POINT "B"
ORIGINAL UNKNOWN
POSSIBLE OFFSETS

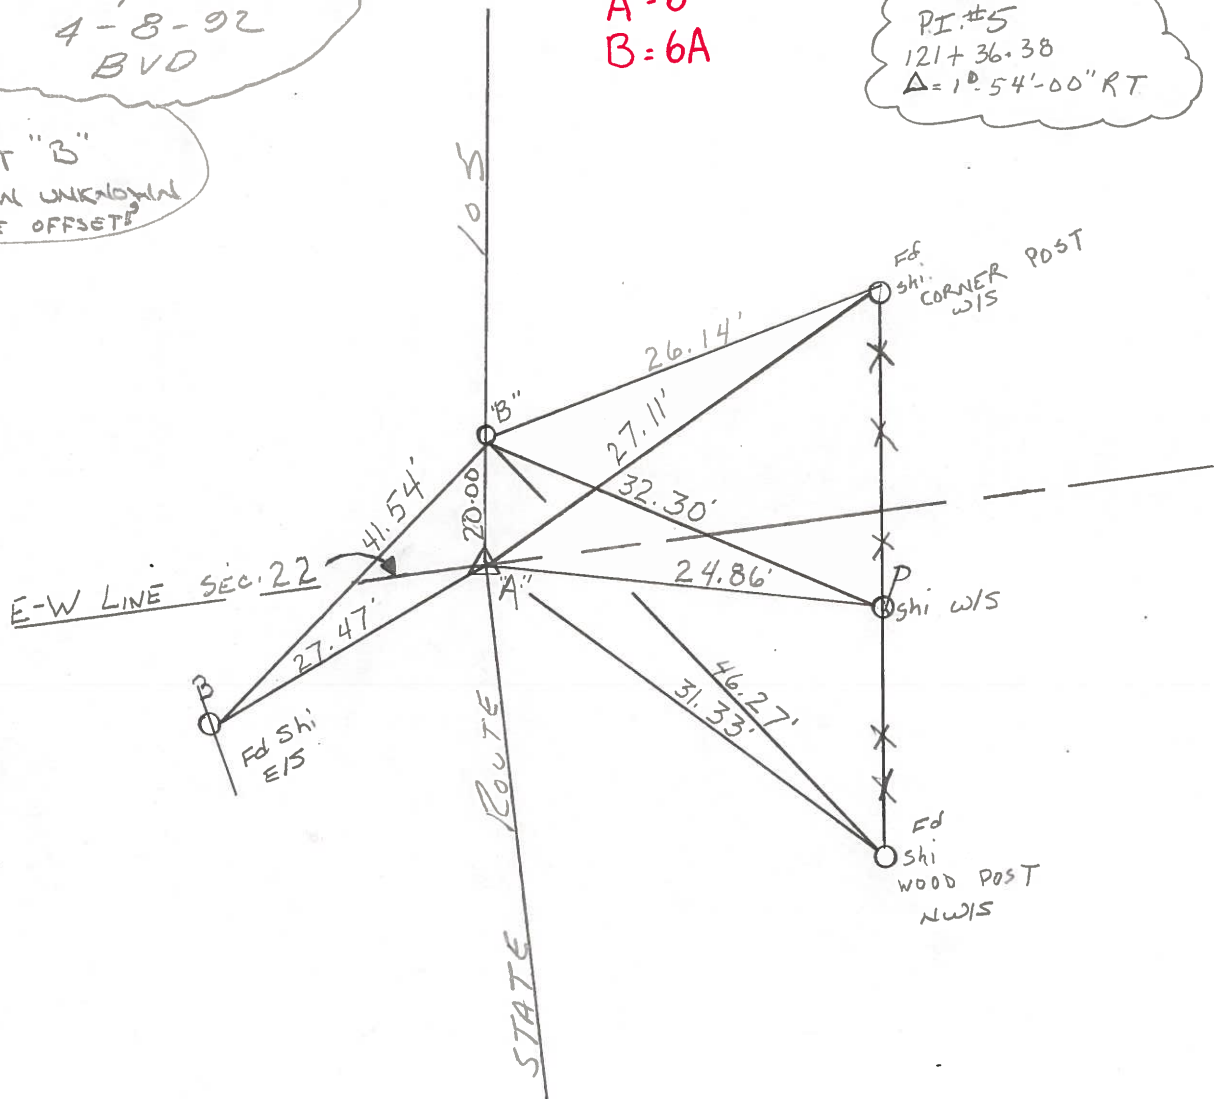

County WOOD S.R. 105

Township CENTER

Section 22

T, N, R, E

Personnel HOFFMAN

HOUSEHOLDER


LOEHRKE

#6

Date 4-19-82

Weather CLEAR

Temp. +65°

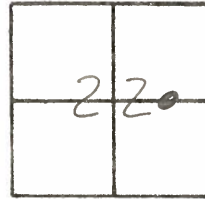

P.I. #5


121 + 36.38

A = 1°-54'-00" RT.

Pt. "A" - SET P.K. / WASHER
5-24-82 S.W.H.

DID NOT RESET PT. "B"
BELIEVE IT TO BE AN
OFFSET LINE

A = 6
B = 6A

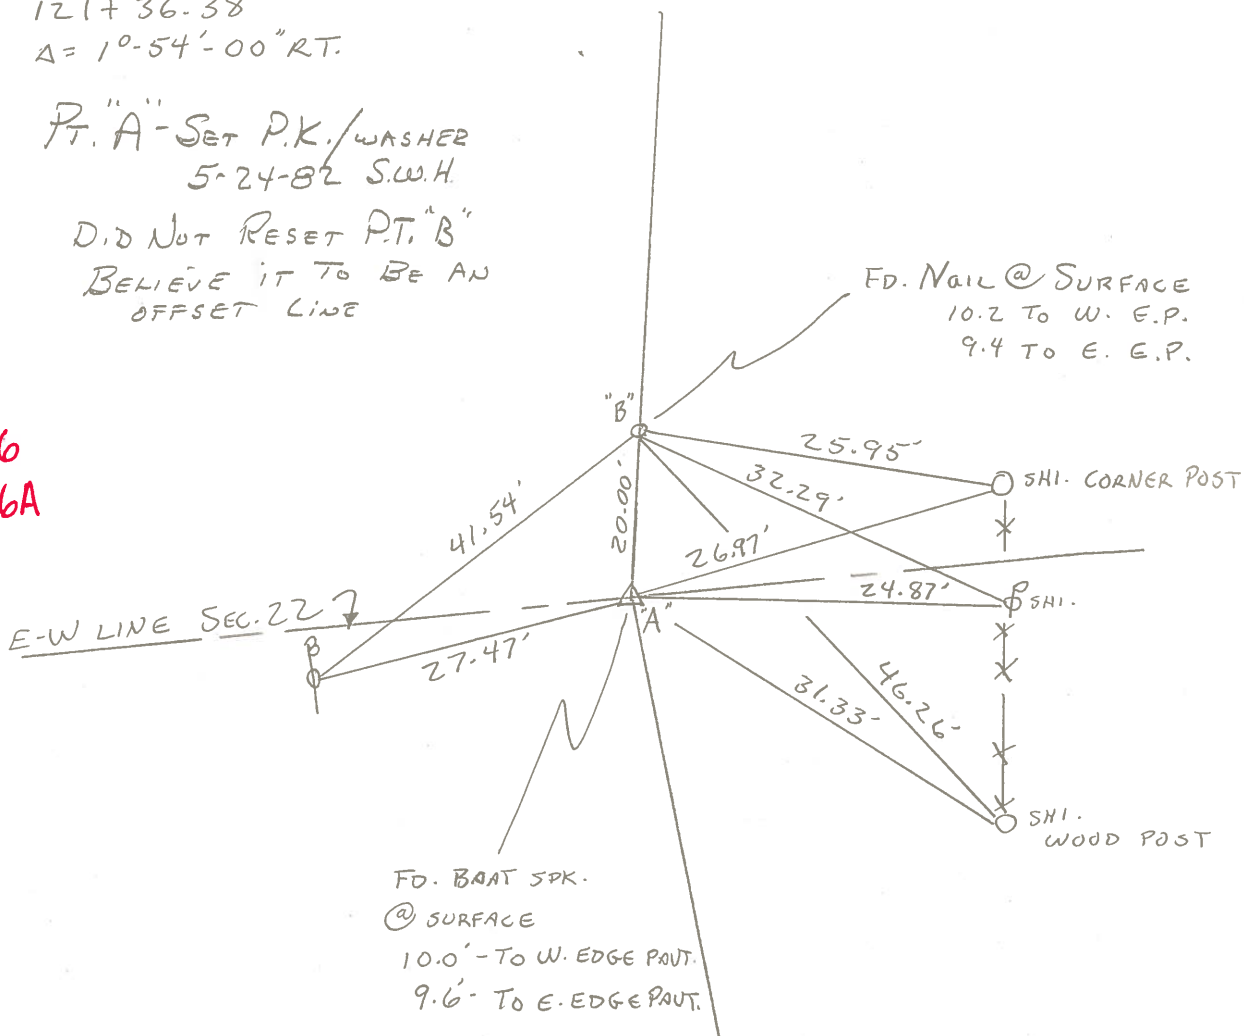

PERSONNEL	TITLE	PERSONNEL	TITLE	COUNTY	DATE
<u>Stone</u>	<u>Notes</u>			<u>Wood</u>	<u>28 Aug. 72</u>
<u>Deno</u>	<u>H.C.</u>			<u>S. R. #105</u>	<u>WEATHER</u> <u>Woods</u>
<u>Curtis</u>	<u>R.C.</u>			<u>SEC. 22</u>	<u>TEMP.</u> <u>78°</u>
<u>Brannon</u>	<u>PS</u>				

DESCRIPTION References to Control Points JOB NO. _____
 LEFT CENTER LINE RIGHT

