


O.D.O.T. DISTRICT 2 SURVEY OFFICE (USE ONLY)

PERSONNEL \_\_\_\_\_ REFERENCE NO. 9 SHEET 17 OF 28


NOTES BARNHISEL DATE 8/19/91 ROUTE SR 105  
 H.C. VAN DUSEN WEATHER CLOUDY COUNTY WOOD  
 R.C. BARNHISEL TEMP. 70° TOWNSHIP CENTER  
 SECTION 22  
T 5 N R 11 E

TYPE MONUMENT IPIPE  
~~ON SURFACE~~ - BELOW 18"  
 LEFT - ☉ PAV'T - ~~RIGHT~~ 44.2'  
 - TO - EDGE PAVEMENT  
 S.L.M. 139+05

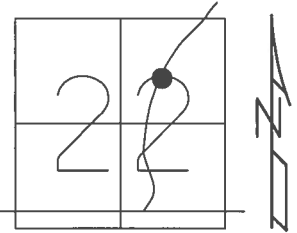

GRID: NORTHING: \_\_\_\_\_ EASTING: \_\_\_\_\_


RECORD: P.I.  
 STA. 139+52.87  
 $\Delta = 41^\circ 35' 40''$  RT  
 FD 1.5" IPIPE  
 18" DOWN  
 D.N.F.  
 6/2/16, JFO

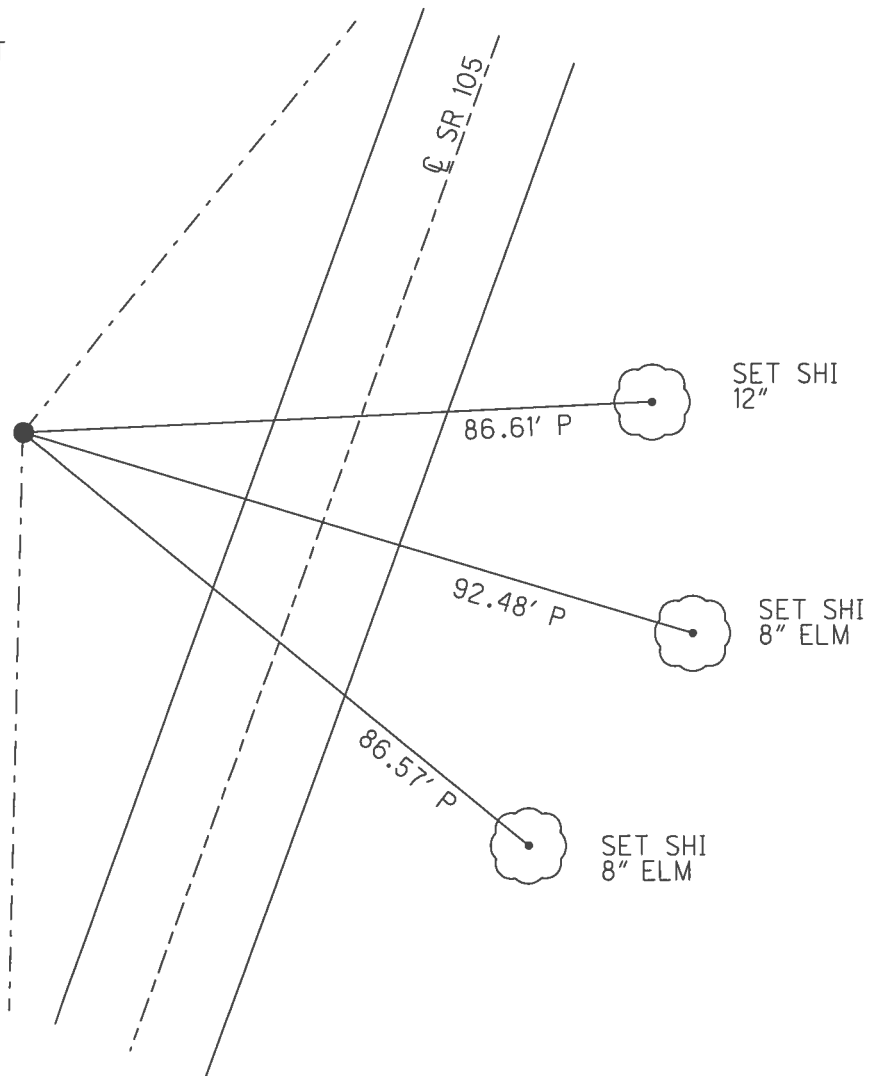

**O.D.O.T. DISTRICT 2 SURVEY OFFICE (USE ONLY)**


PERSONNEL \_\_\_\_\_ REFERENCE NO. 9 SHEET 17 OF 21  
 NOTES BARNHISEL DATE 8/19/91 ROUTE SR 105  
 H.C. VAN DUSEN WEATHER CLOUDY COUNTY WOOD  
 R.C. BARNHISEL TEMP. 70° TOWNSHIP CENTER  
 SECTION 22  
T 5 N R 11 E

TYPE MONUMENT IPIPE  
~~ON SURFACE~~ - BELOW 18"  
 LEFT - ☉ PAV'T - ~~RIGHT~~ 44.2'  
- TO - EDGE PAVEMENT  
 S.L.M. 139+05

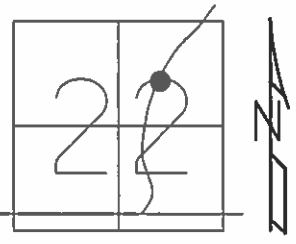

GRID: NORTHING: \_\_\_\_\_ EASTING: \_\_\_\_\_

RECORD: P.I.  
 STA. 139+52.87  
 $\Delta = 41^\circ 35' 40''$  RT  
 FD 1.5" IPIPE  
 18" DOWN

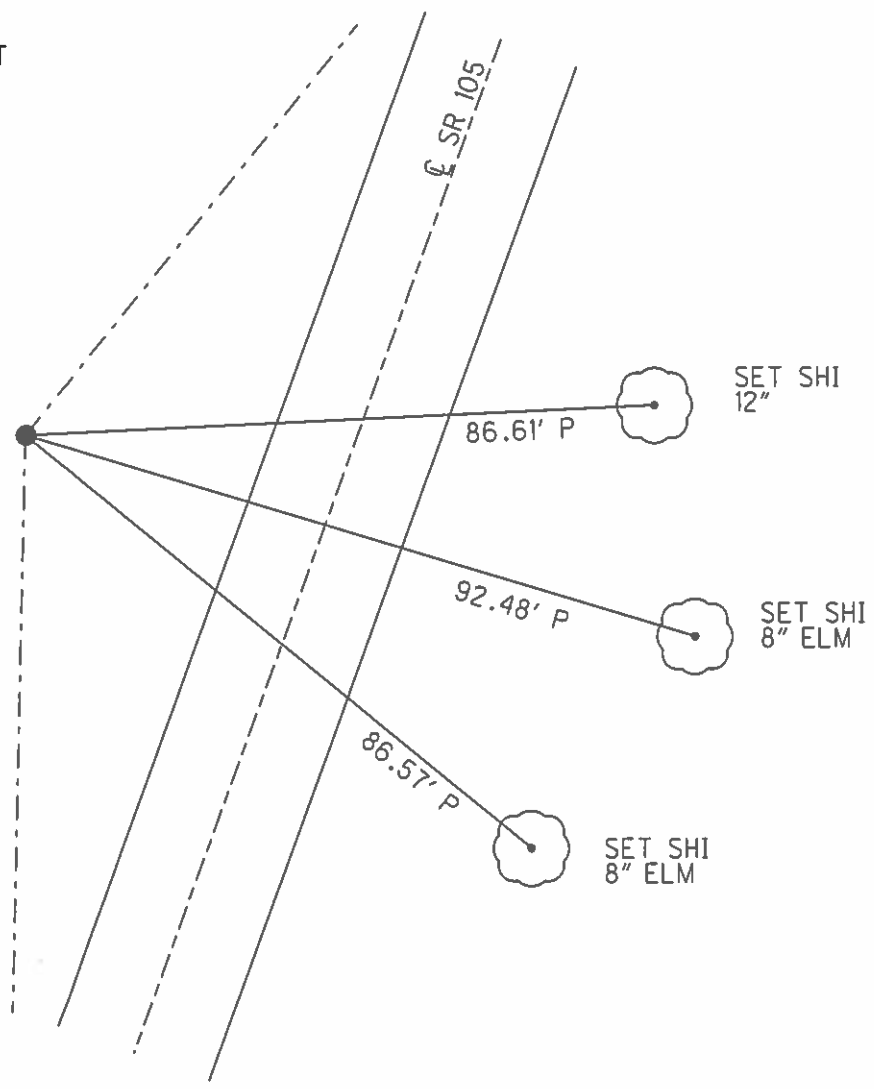

# O.D.O.T. DISTRICT 2 SURVEY OFFICE

PERSONNEL

REFERENCE NO. 9

SHEET 14 OF 57

NOTES BARNHISEL

H.C. VAN DUSEN

R.C. BARNHISEL

DATE 8-19-91

WEATHER cloudy

TEMP. +70°

ROUTE 105

COUNTY WOOD

TOWNSHIP CENTER

SECTION 22

T. 5 N R. 11 E


TYPE MONUMENT IRON PIPE

~~ON~~ SURFACE - BELOW 18"


LEFT- & PAV'T. - ~~RIGHT~~ 44.2'

- TO - EDGE PAVEMENT

S.L.M. 139+05

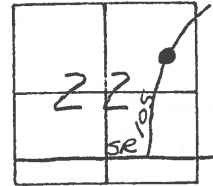

RECORD:  
 P.I. #8  
 STA = 139+52.87  
 $\Delta = 41^\circ - 35' - 40''$  RT  
 1 1/2" IRON PIPE  
 18" Down

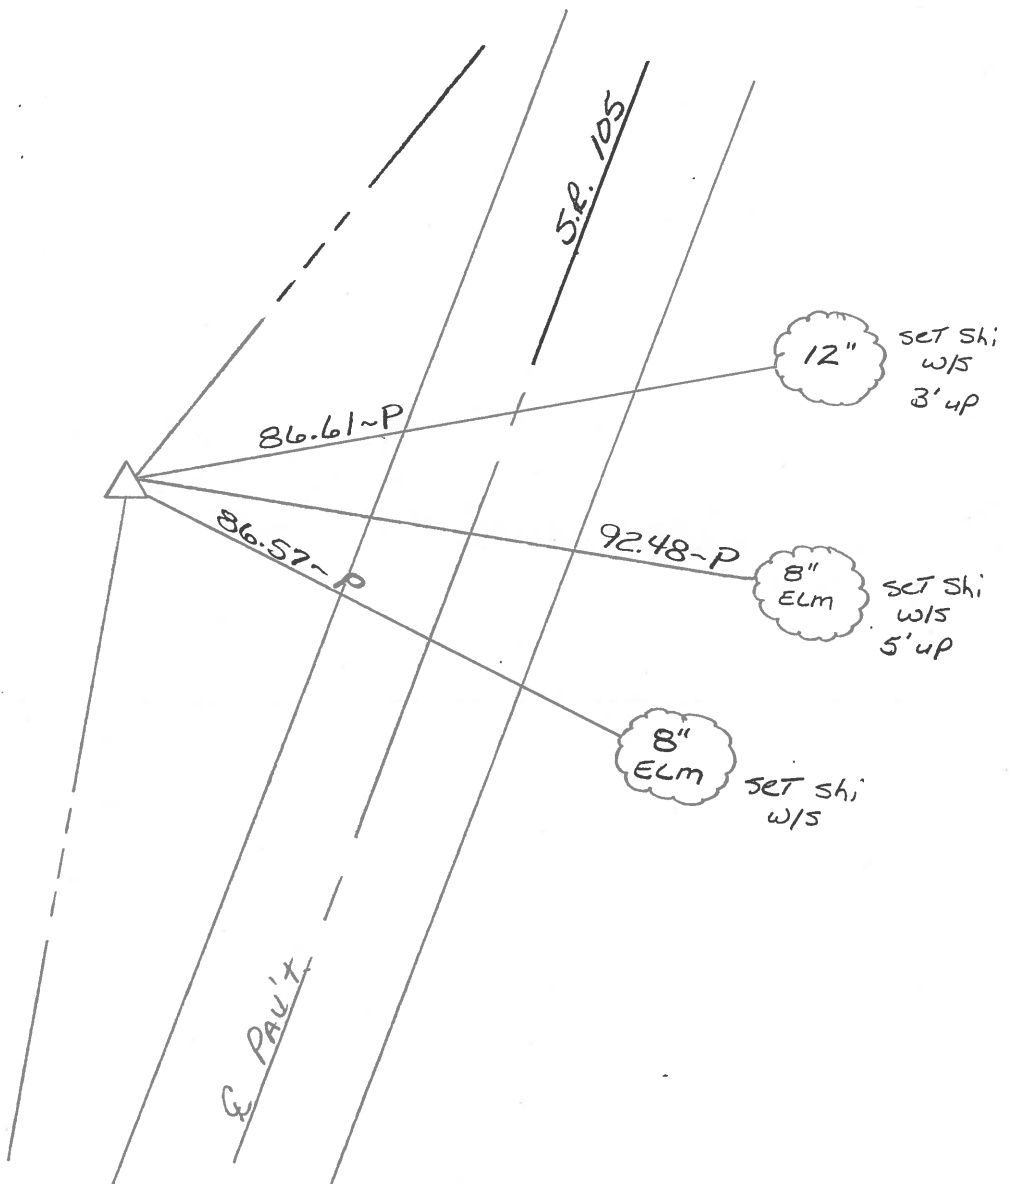

Q.D.O.T. DISTRICT 2 SURVEY OFFICE

SHEET \_\_\_\_\_ OF \_\_\_\_\_

County WOOD S.R. 105

Date 4-19-82

Township CENTER

Weather CLEAR

Section 22

Temp. +65°


T N, R E

Personnel HOFFMAN

LOEHRKE

HOUSEHOLDER


#9

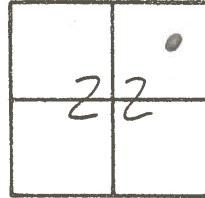

P.I. #8

139+52.87

$\Delta = 41^{\circ}-35'-40''$  RT.

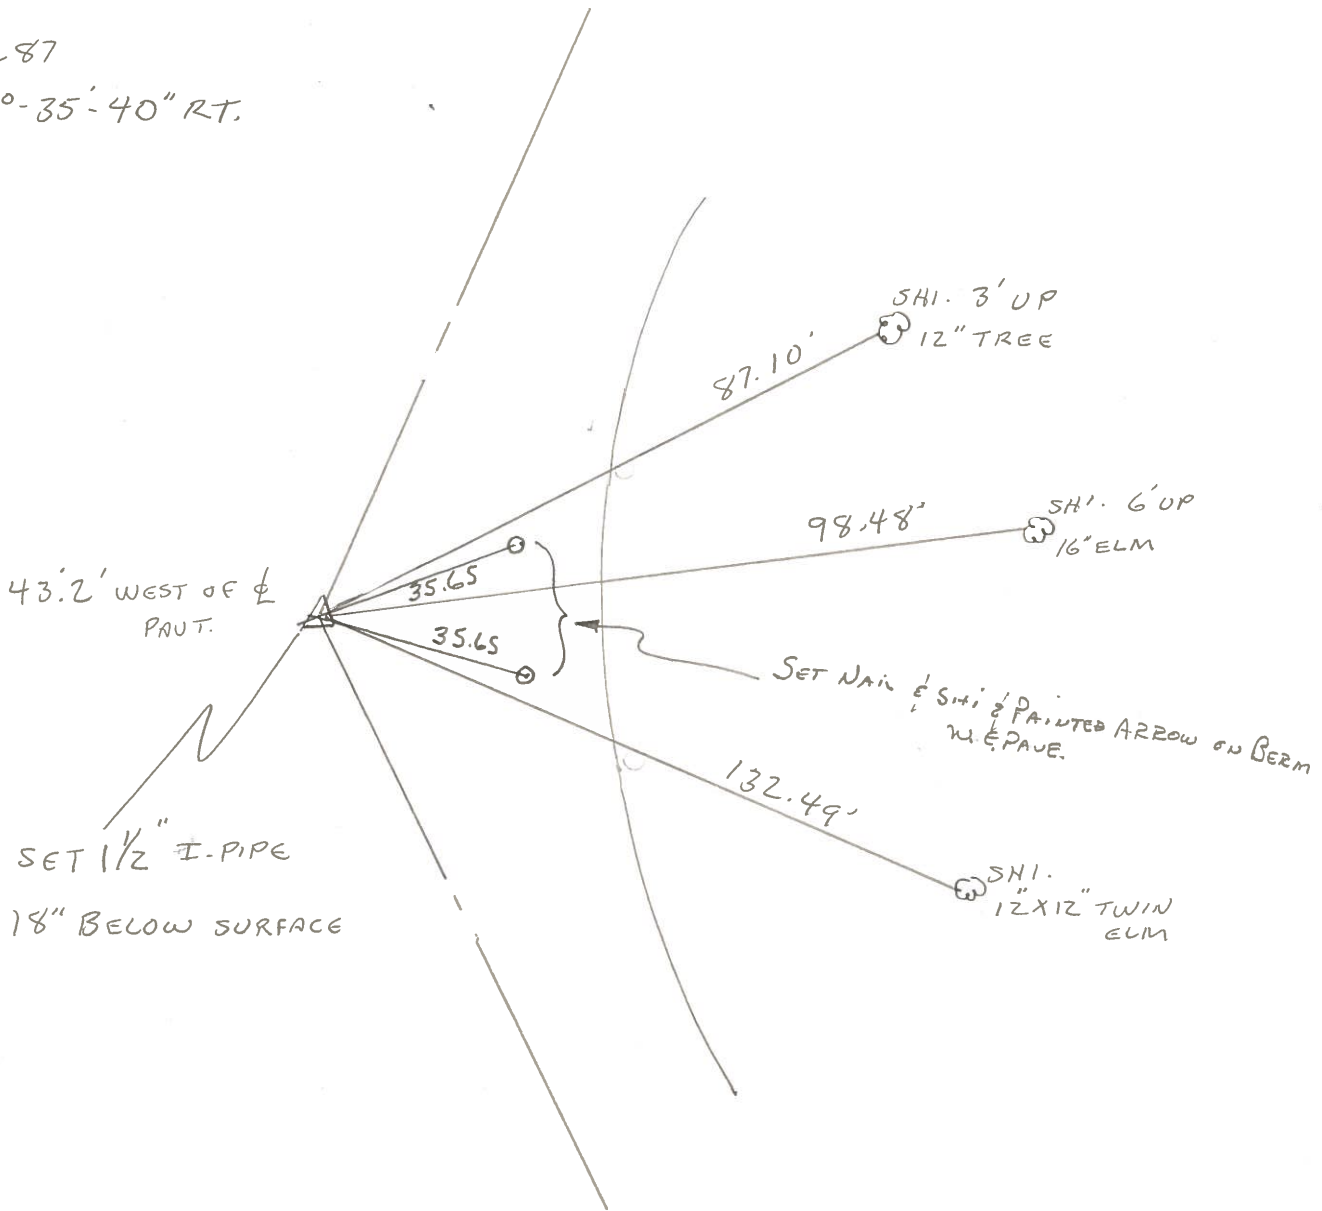

PERSONNEL	TITLE	PERSONNEL	TITLE	COUNTY	DATE
Stone	Notes			Wood	28 Aug. 72
Drano	H.C.			S. R. 105	WEATHER Warm
Curtis	R.C.			SEC. 22	TEMP. 80°
Branner	As				

DESCRIPTION References to Control Points JOB NO. \_\_\_\_\_

