


O.D.O.T. DISTRICT 2 SURVEY OFFICE (USE ONLY)


PERSONNEL _____ REFERENCE NO. 11 SHEET 19 OF 28
 NOTES RHOADES DATE 9/12/16 ROUTE SR 105
 H.C. O'DONNELL WEATHER SUNNY COUNTY WOOD
 R.C. RHOADES TEMP. 55° TOWNSHIP CENTER
 SECTION 22
 T 5 N R 11 E

TYPE MONUMENT P.K./WASHER
 ON SURFACE - ~~BELOW~~ ON _____
~~LEFT~~ - CL PAV'T - RIGHT 11.8'
1.5' TO RT EDGE PAVEMENT
 S.L.M. 149+98

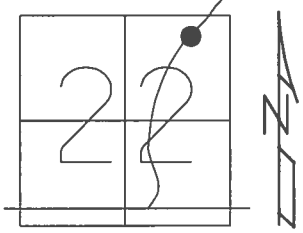

GRID: NORTHING: 627416.352 EASTING: 1674304.651


RECORD: P.I.
 STA. 150+65.86
 $\Delta = 22^\circ 07' 20''$ LT
 FD P.K./WASHER
 4/15/02, MB
 SET P.K./WASHER
 5/28/02, DCH
 FD P.K./WASHER
 REF11
 6/2/16, JFO
 SET 1" MAG/WASHER
 NEWREF11
 6/20/17, JFO

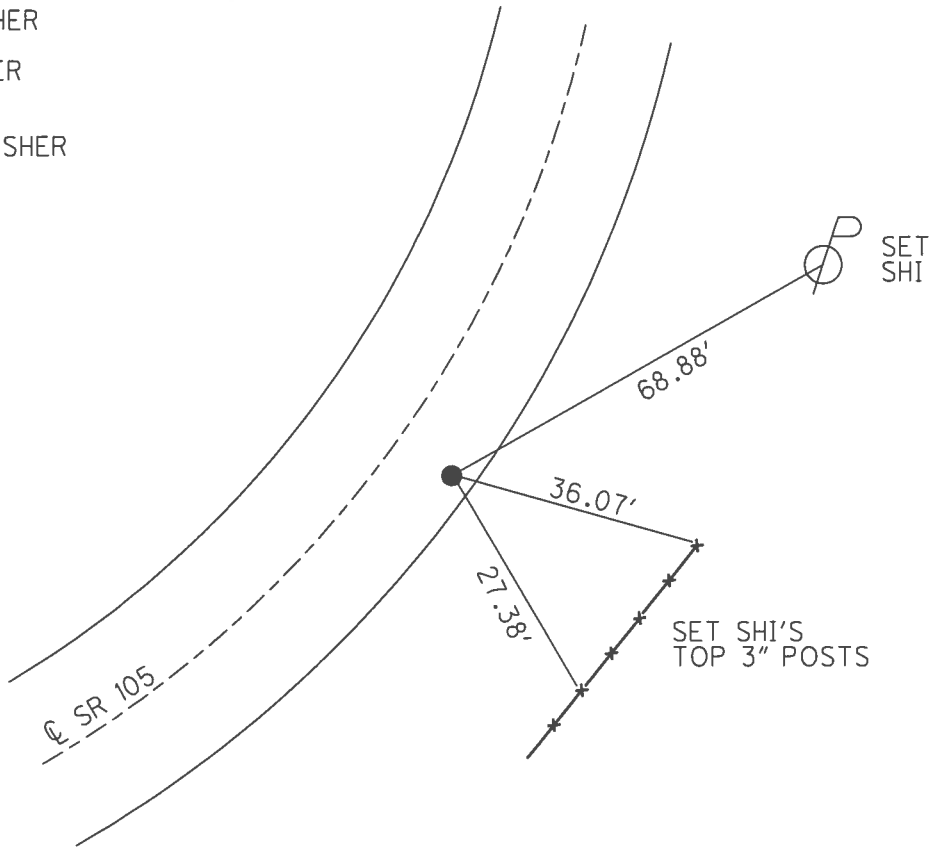

O.D.O.T. DISTRICT 2 SURVEY OFFICE (USE ONLY)


PERSONNEL _____ REFERENCE NO. 11 SHEET 19 OF 21
 NOTES MOSER DATE 4/15/02 ROUTE SR 105
 H.C. CANTERBURY WEATHER SUNNY COUNTY WOOD
 R.C. BARNHISEL TEMP. 70° TOWNSHIP CENTER
 _____ SECTION 22
 _____ T 5 N R 11 E

TYPE MONUMENT P.K./WASHER
 ON SURFACE - ~~BELOW~~ ON
~~LEFT~~ - CL PAV'T - RIGHT 11.8'
2.1' TO RT EDGE PAVEMENT
 S.L.M. 149+98

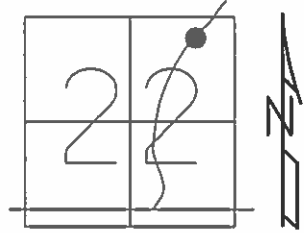

GRID: NORTHING: _____ EASTING: _____

RECORD: P.I.
 STA. 150+65.86
 $\Delta = 22^\circ 07' 20''$ LT
 SET P.K./WASHER
 5/28/02, DCH

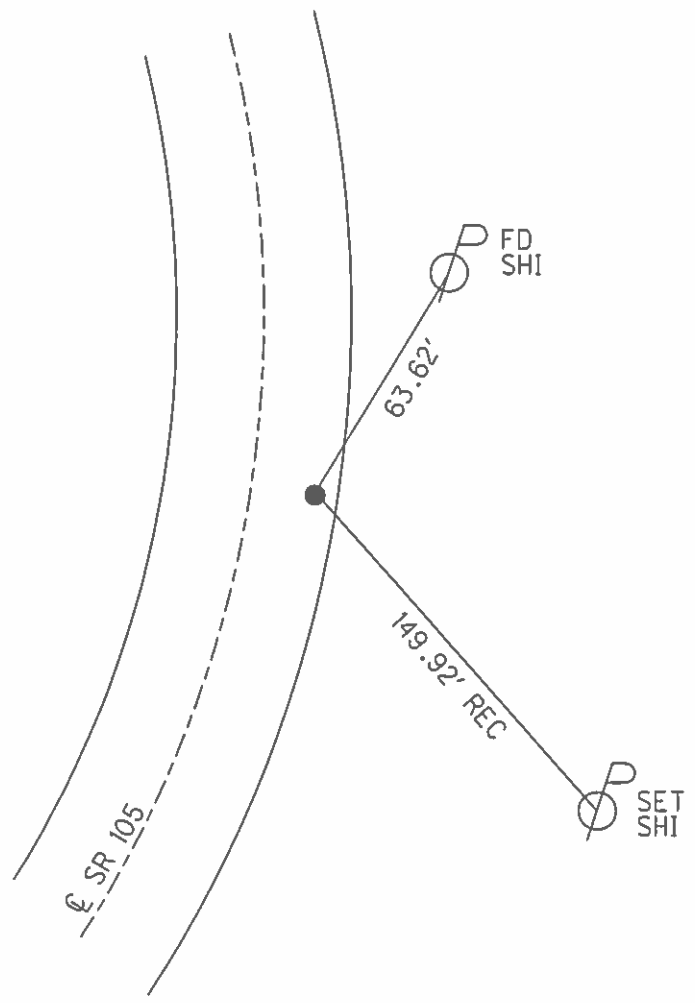

O.D.O.T. DISTRICT 2 SURVEY OFFICE

PERSONNEL _____

REFERENCE NO. 11

SHEET 16 OF 57

NOTES LONG

H.C. VAN DUSEN

R.C. BARNHISEL

DATE 8-19-91

WEATHER cloudy

TEMP. 70°

ROUTE 105

COUNTY WOOD

TOWNSHIP CENTER

SECTION 22

T5 N R 11 E


TYPE MONUMENT PK & WASHER

ON SURFACE - ~~BELOW~~ YES

~~LEFT~~ - C PAV'T. - RIGHT 11.4' RT.


1.6 TO RT EDGE PAVEMENT

S.L.M. 149+98

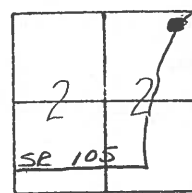

SET PK & WASHER
 4-8-92
 BVD

RECORD
 P.I. #10
 STA: 150+65.86
 Δ = 22°-07'-20" LT.

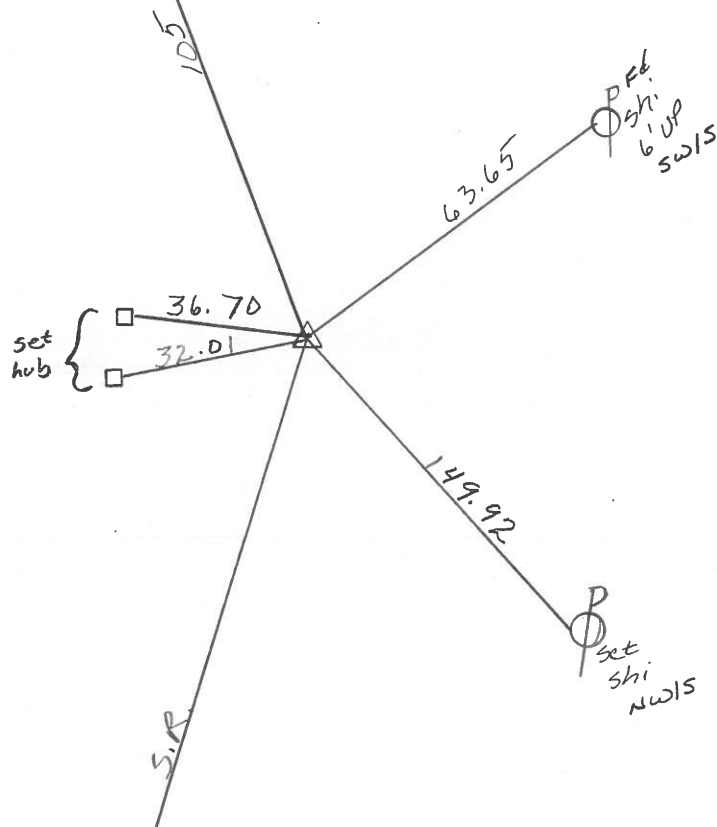

County WOOD S.R. 105

Date 4-19-82

Township CENTER


Weather CLEAR

Section 22

Temp. +65°

T N, R E

Personnel HOFFMAN

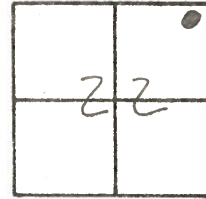

HOUSEHOLDER

LOEHRKE


11

P.I. #10

150+65.86

$\Delta = 22^{\circ} - 07' - 20''$ LT.

SET P.K./WASHER
5-24-82 S.W.H.

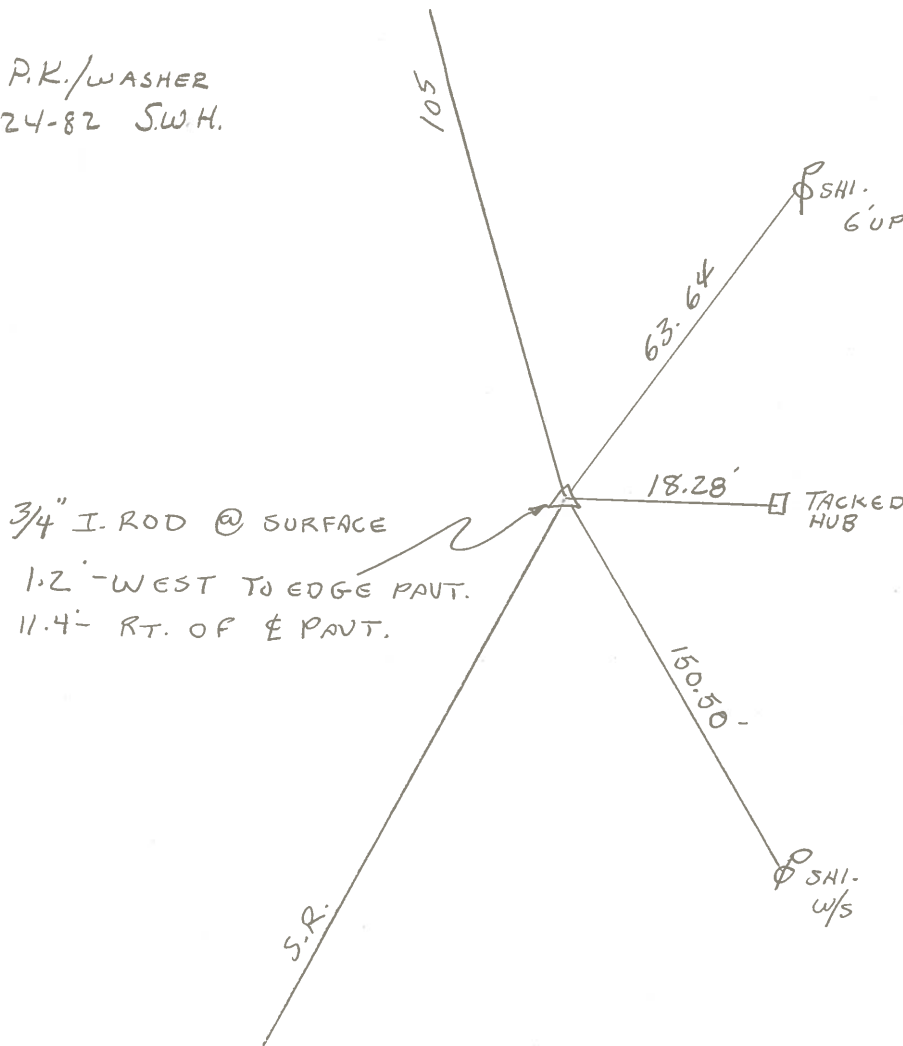

PERSONNEL	TITLE	PERSONNEL	TITLE	COUNTY	DATE
Stone	Notes			Wood	11 Sept. 72
Michalak	H.C.			S. R. #105	WEATHER Fair
Denno	P.C.			SEC. 22	TEMP. 75°
Curtis	RT				

DESCRIPTION References to Control Points JOB NO. _____
 LEFT CENTER LINE RIGHT

