


O.D.O.T. DISTRICT 2 SURVEY OFFICE (USE ONLY)


PERSONNEL _____ REFERENCE NO. 12 SHEET 20 OF 28
 NOTES RHOADES DATE 9/12/16 ROUTE SR 105
 H.C. O'DONNELL WEATHER SUNNY COUNTY WOOD
 R.C. RHOADES TEMP. 55° TOWNSHIP CENTER
 SECTION 22
 T 5 N R 11 E

TYPE MONUMENT P.K./WASHER
 ON SURFACE - ~~BELOW~~ ON
~~LEFT~~ - CL PAV'T - RIGHT 0.45'
9.4' TO LT EDGE PAVEMENT
 S.L.M. 152+86

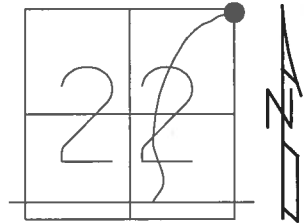

GRID: NORTHING: 627677.637 EASTING: 1674451.107


RECORD: P.O.T.
 STA. 153+65.35
 FD P.K./WASHER
 4/15/02, MB
 SET P.K./WASHER
 6/12/02, DCH
 FD P.K./WASHER
 REF12
 6/2/16, JFO
 SET MAG/WASHER
 NEWREF12
 6/20/17, JFO

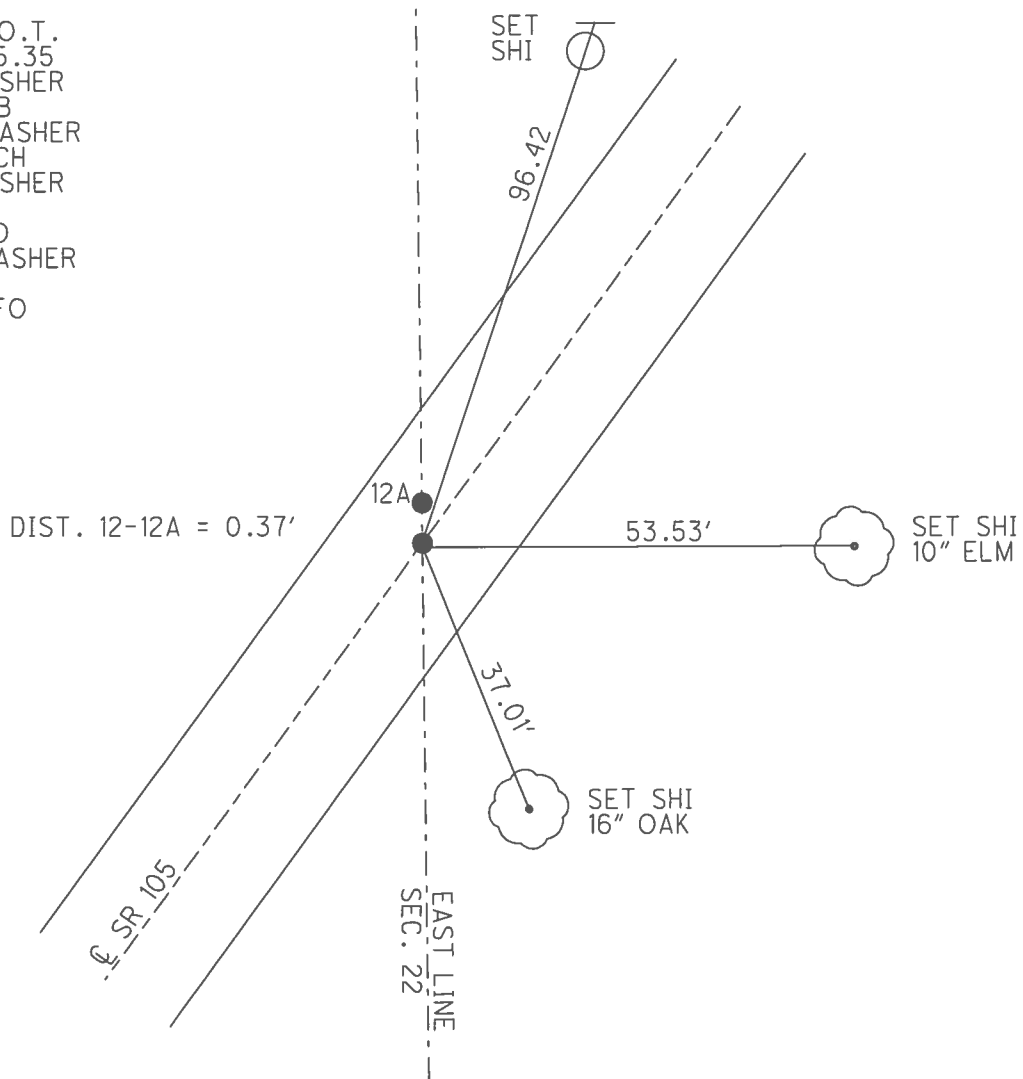

O.D.O.T. DISTRICT 2 SURVEY OFFICE (USE ONLY)


PERSONNEL _____ REFERENCE NO. 12 SHEET 20 OF 21
 NOTES MOSER DATE 4/15/02 ROUTE SR 105
 H.C. CANTERBURY WEATHER SUNNY COUNTY WOOD
 R.C. BARNHISEL TEMP. 70° TOWNSHIP CENTER
 SECTION 22
T 5 N R 11 E

TYPE MONUMENT P.K./WASHER
 ON SURFACE - ~~BELOW~~ ON _____
~~LEFT~~ - CL PAV'T - RIGHT 0.45'
9.4' TO LT EDGE PAVEMENT
 S.L.M. 152+96

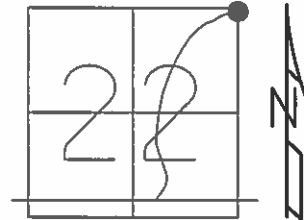

GRID: NORTHING: _____ EASTING: _____

RECORD: P.O.T.
 STA. 153+65.35
 SET P.K./WASHER
 6/12/02, DCH

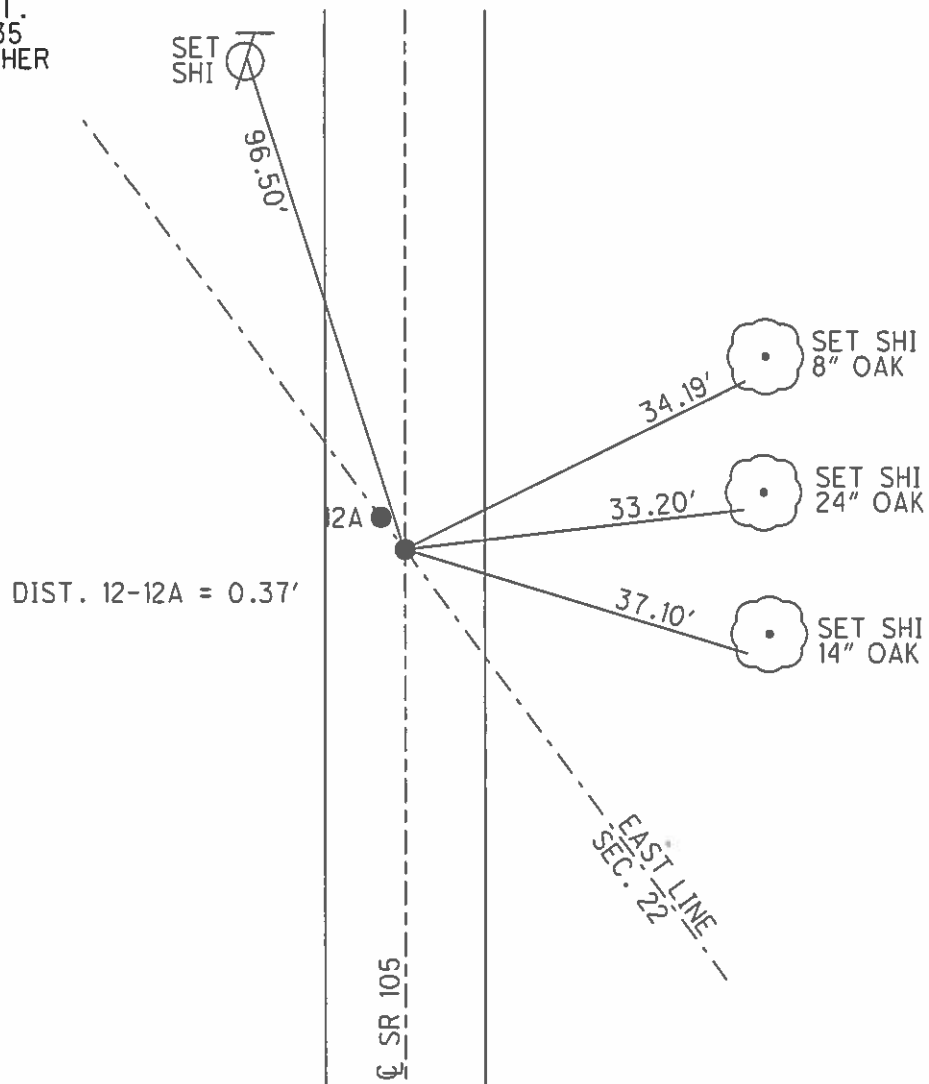

O.D.O.T. DISTRICT 2 SURVEY OFFICE

PERSONNEL

REFERENCE NO. 12

SHEET 17 OF 57

NOTES LONG

H.C. VANDUSEN

DATE 8-19-91

ROUTE 105

R.C. BARNHISEL

WEATHER cloudy

COUNTY WOOD

TEMP. 70°

TOWNSHIP CENTER

SECTION 22

T5 N R 11 E

TYPE MONUMENT PK & WASHER



ON SURFACE - BELOW YES

~~LEFT~~ - C PAV'T. - RIGHT yes

10.5 TO RT EDGE PAVEMENT

S.L.M. 152+96

0.39 BETWEEN PTS

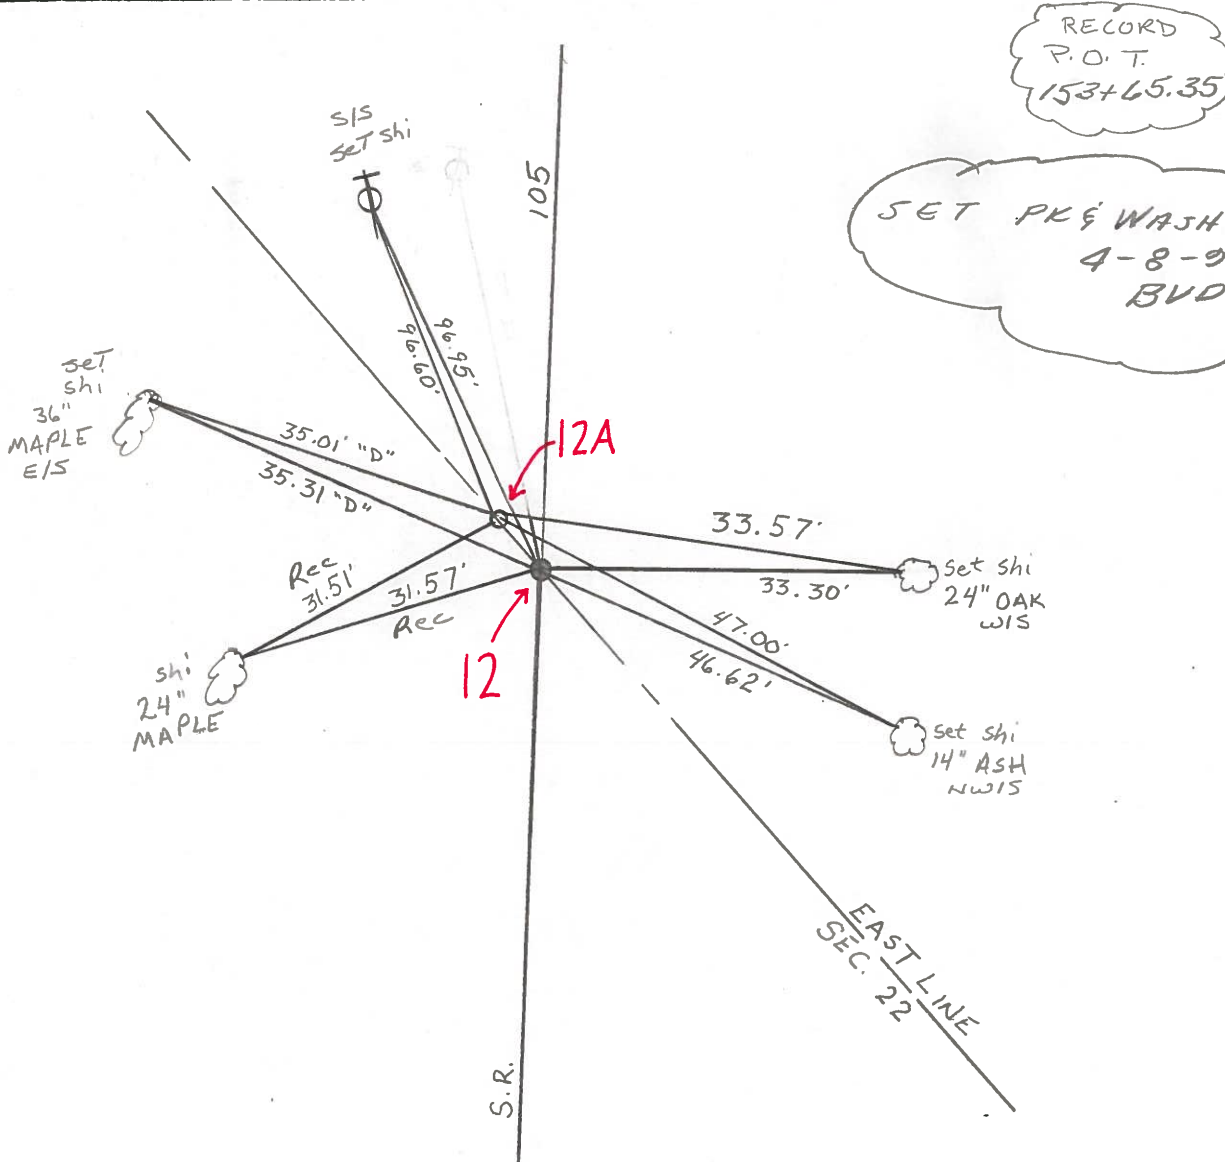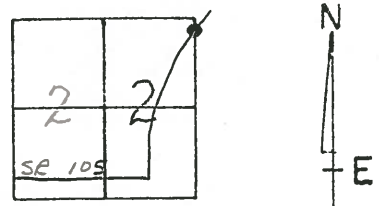

County WOOD S.R. 105

Date 4-19-82

Township CENTER

Weather CLEAR

Section 22

Temp. +72°


T. N, R. E

Personnel HOFFMAN

HOUSEHOLDER

LOEHRKE

12

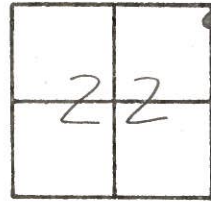

P.O.T.

153+65.35

12A
SET CONC. NAIL
5-25-82
S.W.H.

12
FD. P.K. NAIL @ SURFACE
9.7' - TO E. EDGE PAVT.
10.0' - TO W. EDGE PAVT.
SET P.K./WASHER
5-25-82 S.W.H.

SHI. 36" MAPLE

SHI. 24" MAPLE

SHI. 18" TREE

SHI. 14" TREE

SHI. ϕ
57.00'

34.59'

34.82'

31.51'

31.57'

33.67'

33.39'

47.03'

46.65'

105

S.R.

EAST LINE
SEC. 22

PERSONNEL	TITLE	PERSONNEL	TITLE	COUNTY	DATE
Stone	Notes			Wood	11 Sept. 72
Michalak	H.C.			S. R. #105	WEATHER Fair
Denno	P.C.			SEC. 22	TEMP. 75°
Curtis	FD				

DESCRIPTION References to Control Points JOB NO. _____
 LEFT CENTER LINE RIGHT

