


O.D.O.T. DISTRICT 2 SURVEY OFFICE (USE ONLY)


PERSONNEL \_\_\_\_\_ REFERENCE NO. 12 A SHEET 21 OF 28  
 NOTES RHOADES DATE 9/12/16 ROUTE SR 105  
 H.C. O'DONNELL WEATHER SUNNY COUNTY WOOD  
 R.C. RHOADES TEMP. 55° TOWNSHIP CENTER  
 SECTION 22  
 T 5 N R 11 E

TYPE MONUMENT P.K./WASHER  
 ON SURFACE - ~~BELOW~~ ON \_\_\_\_\_  
 LEFT - ☉ PAV'T - ~~RIGHT~~ 0.7'  
9.1' TO LT EDGE PAVEMENT  
 S.L.M. 153+00

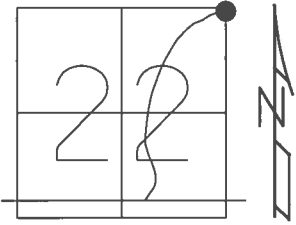

GRID: NORTHING: 627678.020 EASTING: 1674450.970


RECORD:  
 FD P.K./WASHER  
 4/15/02, MB  
 SET P.K./WASHER  
 6/12/02, DCH  
 FD P.K./WASHER  
 REFA12  
 6/2/16, JFO  
 SET MAG/WASHER  
 NEWREFA12  
 6/20/17, JFO

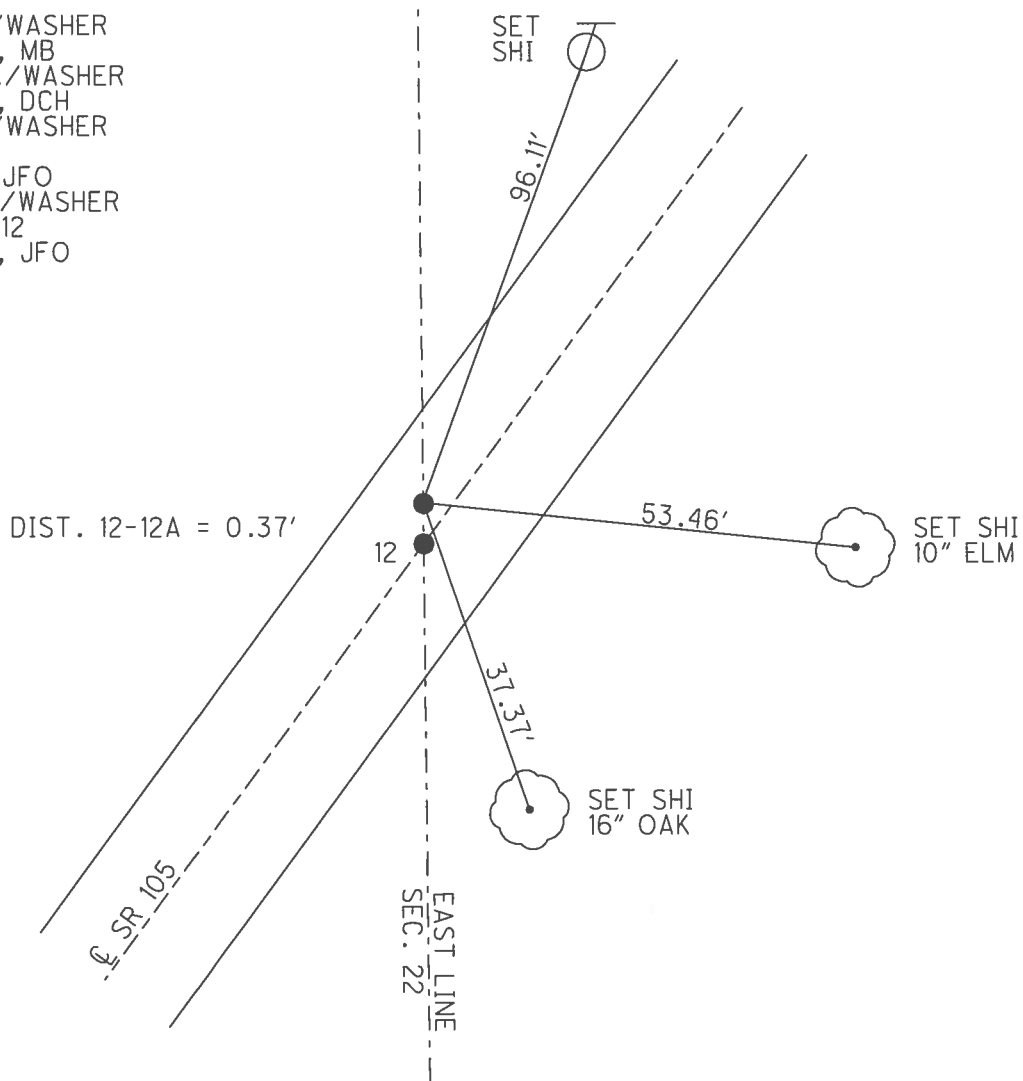

**O.D.O.T. DISTRICT 2 SURVEY OFFICE (USE ONLY)**


PERSONNEL \_\_\_\_\_ REFERENCE NO. 12 A SHEET 21 OF 21  
 NOTES MOSER DATE 4/15/02 ROUTE SR 105  
 H.C. CANTERBURY WEATHER SUNNY COUNTY WOOD  
 R.C. BARNHISEL TEMP. 70° TOWNSHIP CENTER  
 SECTION 22  
 T 5 N R 11 E

TYPE MONUMENT P.K./WASHER  
 ON SURFACE - ~~BELOW~~ ON \_\_\_\_\_  
 LEFT - ☉ PAV'T - RIGHT ON \_\_\_\_\_  
9.1' TO LT EDGE PAVEMENT  
 S.L.M. 153+00

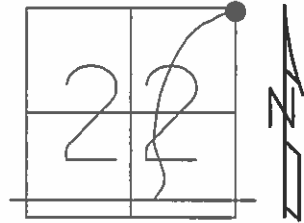

GRID: NORTHING: \_\_\_\_\_ EASTING: \_\_\_\_\_

SET P.K./WASHER  
 6/12/02, DCH

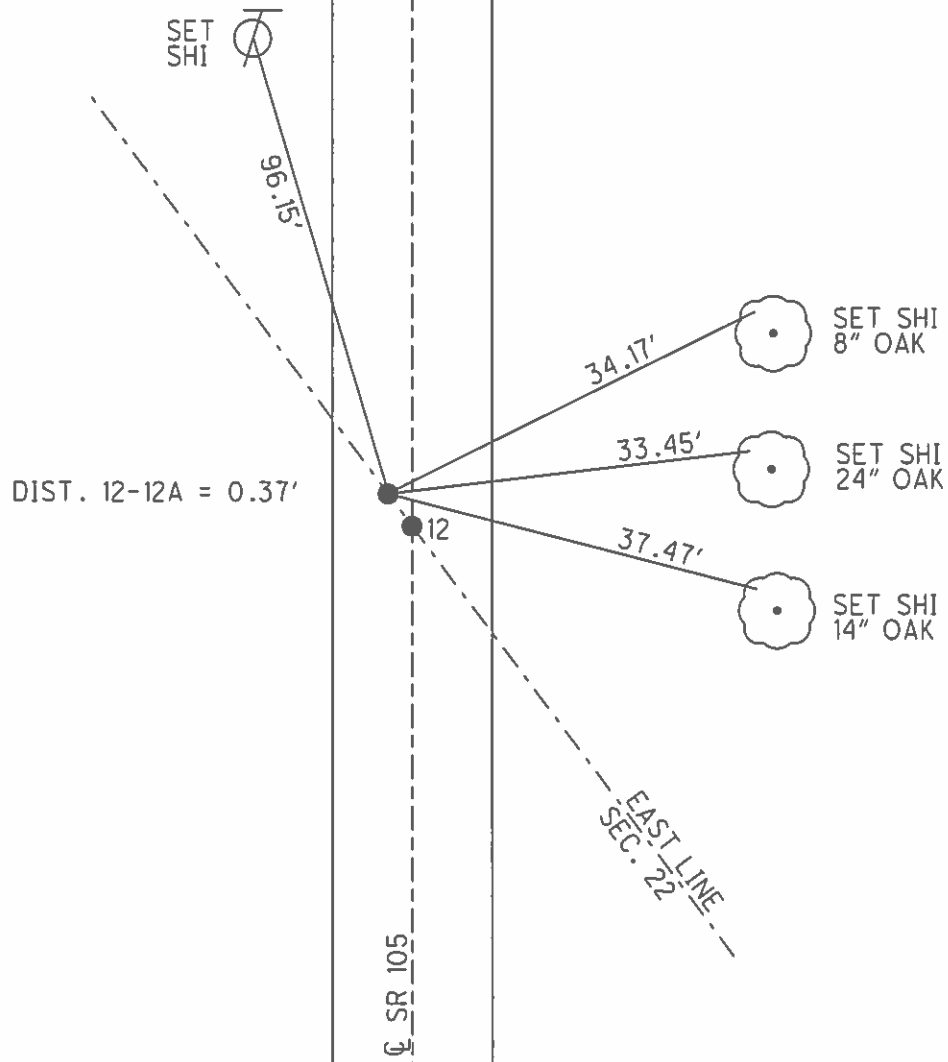


O.D.O.T. DISTRICT 2 SURVEY OFFICE (USE ONLY)

PERSONNEL \_\_\_\_\_ REFERENCE NO. 12 A SHEET 21 OF 21


NOTES MOSE DATE 4/15/02 ROUTE SR 105  
 H.C. CANTERBURY WEATHER SUNNY COUNTY WOOD  
 R.C. BARNHEISEL TEMP. 70° TOWNSHIP CENTER  
 SECTION 22  
 T 5 N R 11 E

TYPE MONUMENT P.K./WASHER  
 ON SURFACE - ~~BELOW~~ ON \_\_\_\_\_  
 LEFT - Q PAV'T - RIGHT ON  
9.1' TO LT EDGE PAVEMENT  
 S.L.M. 153+00

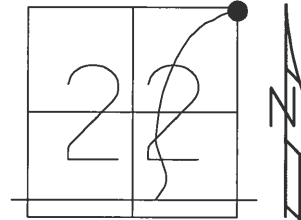

GRID: NORTHING: \_\_\_\_\_ EASTING: \_\_\_\_\_

SET P.K./WASHER  
 6/12/02, DCH

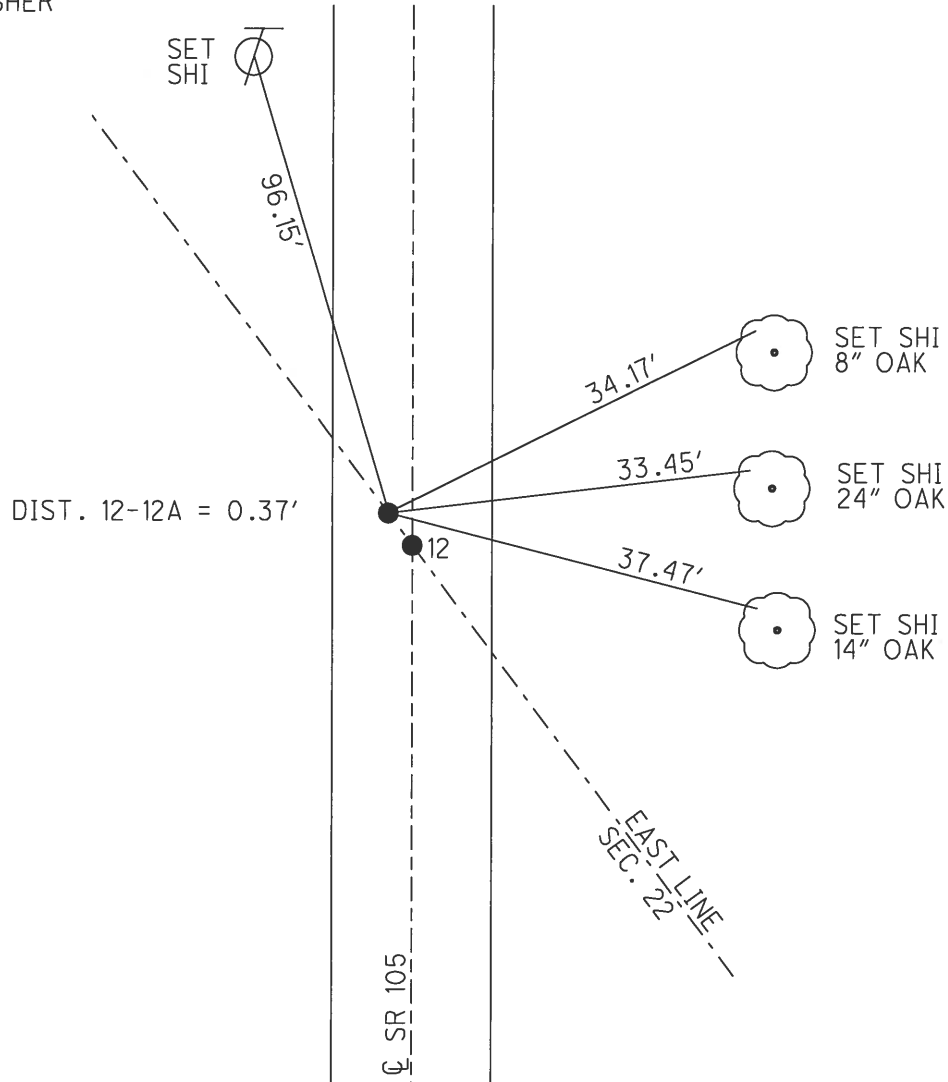

# O.D.O.T. DISTRICT 2 SURVEY OFFICE

PERSONNEL

REFERENCE NO. 12

SHEET 17 OF 57

NOTES LONG

H.C. VANDUSEN

R.C. BARNHISEL

DATE 8-19-91

WEATHER cloudy

TEMP. 70°

ROUTE 105

COUNTY WOOD

TOWNSHIP CENTER

SECTION 22

T5 N R 11 E

TYPE MONUMENT PK & WASHER


ON SURFACE - ~~BELOW~~ YES

~~LEFT - C~~ PAV'T. - ~~RIGHT~~ yes

10.5 TO RT EDGE PAVEMENT


S.L.M. 152+96

0+39 BETWEEN PTS

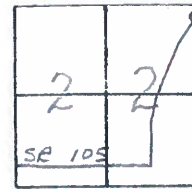

RECORD  
P.O.T.  
153+65.35

SET PK & WASHER  
4-8-92  
BVD

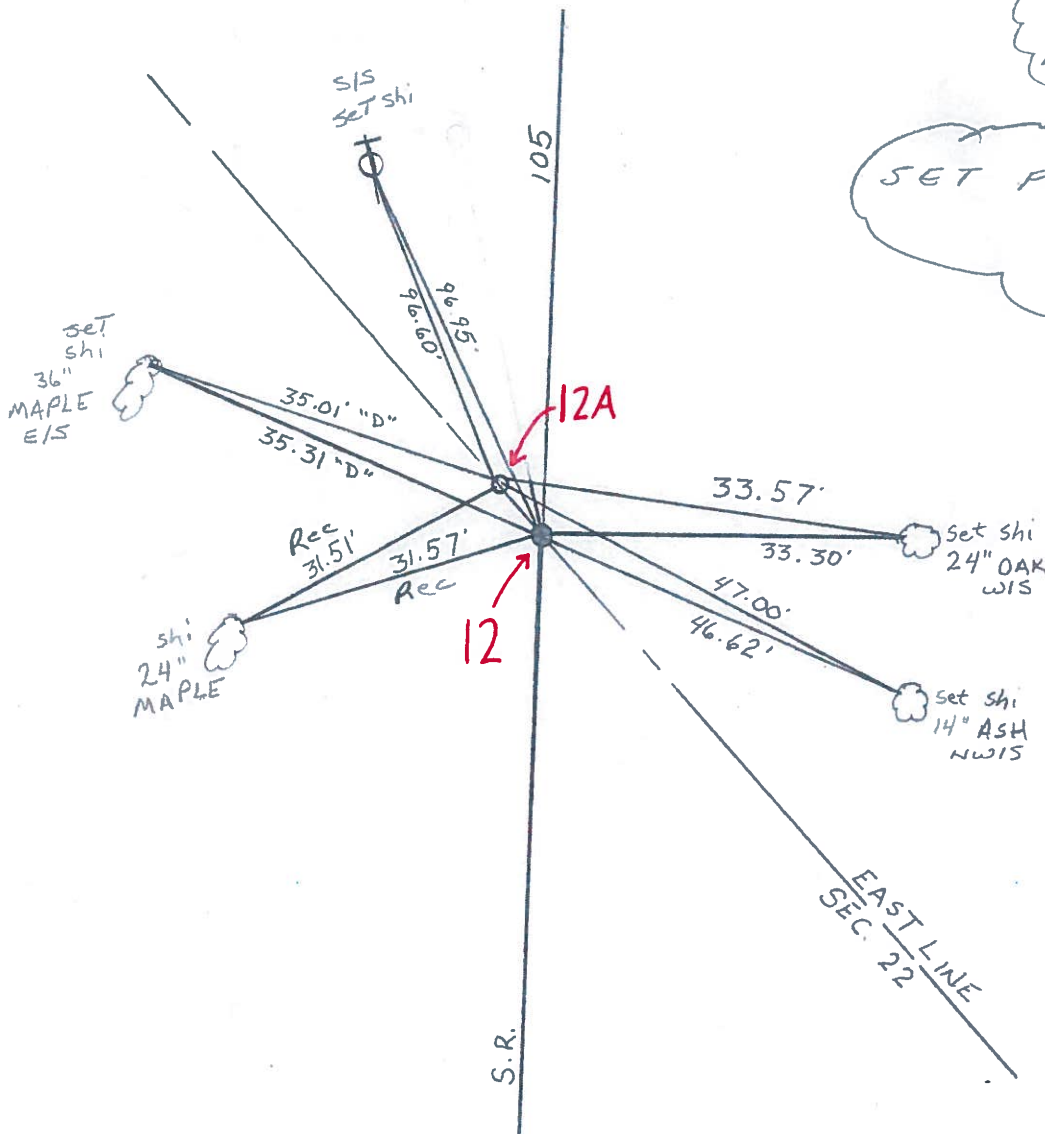

County WOOD S.R. 105

Date 4-19-82

Township CENTER

Weather CLEAR

Section 22

Temp. +72°


T    N, R    E

Personnel HOFFMAN

HOUSEHOLDER

LOEHRKE

# 12

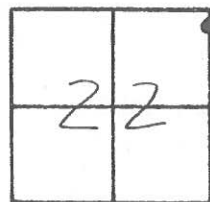

P.O.T.

153+65.35

