


O.D.O.T. DISTRICT 2 SURVEY OFFICE (USE ONLY)


PERSONNEL	REFERENCE NO.	14	SHEET	26	OF	28
NOTES	CODER	DATE	7/25/12	ROUTE	SR 105	
H.C.	RHOADES	WEATHER	CLEAR	COUNTY	WOOD	
R.C.	COUTCHER	TEMP.	80°	TOWNSHIP	WEBSTER	
				SECTION	14	
				T	5	N
				R	11	E

TYPE MONUMENT 1/2" IPIPE
~~ON SURFACE~~ - BELOW 6"
 LEFT - ☉ PAV'T - RIGHT -
22.05' TO LT EDGE PAVEMENT
 S.L.M. 158+65.29

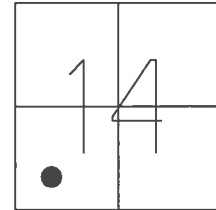

GRID: NORTHING: 628143.166 EASTING: 1674628.281

RECORD:
 P.I. #12
 STA. 158+65.52
 $\Delta = 55^\circ 54' 40''$ RT
 FD 1/2" IPIPE
 6" DOWN
 SV110
 7/25/12, SDC
 FD IPIN
 REF14
 6/3/16, JFO


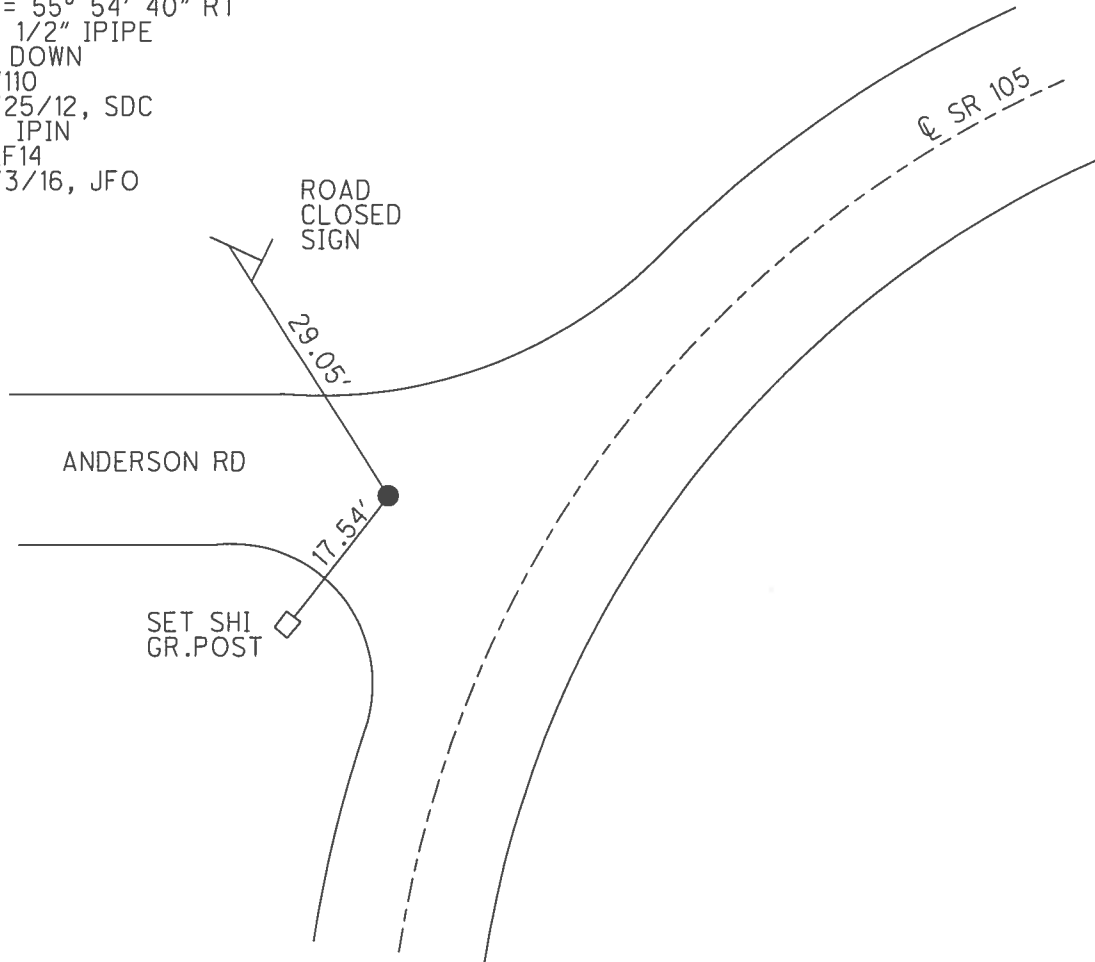


O.D.O.T. DISTRICT 2 SURVEY OFFICE (USE ONLY)

PERSONNEL _____ REFERENCE NO. 14 SHEET 5 OF 7
 NOTES CODER _____ DATE 7/25/12 ROUTE SR 105
 H.C. RHOADES _____ WEATHER CLEAR COUNTY WOOD
 R.C. COUTCHER _____ TEMP. 80° TOWNSHIP WEBSTER
 _____ SECTION 14
 _____ T 5 N R 11 E

TYPE MONUMENT 1/2" IPIPE
~~ON SURFACE~~ - BELOW 6"
 LEFT - ☉ PAV'T - RIGHT -
22.05' TO LT EDGE PAVEMENT
 S.L.M. 158+53.87

GRID: NORTHING: 628143.194 EASTING: 1674628.161

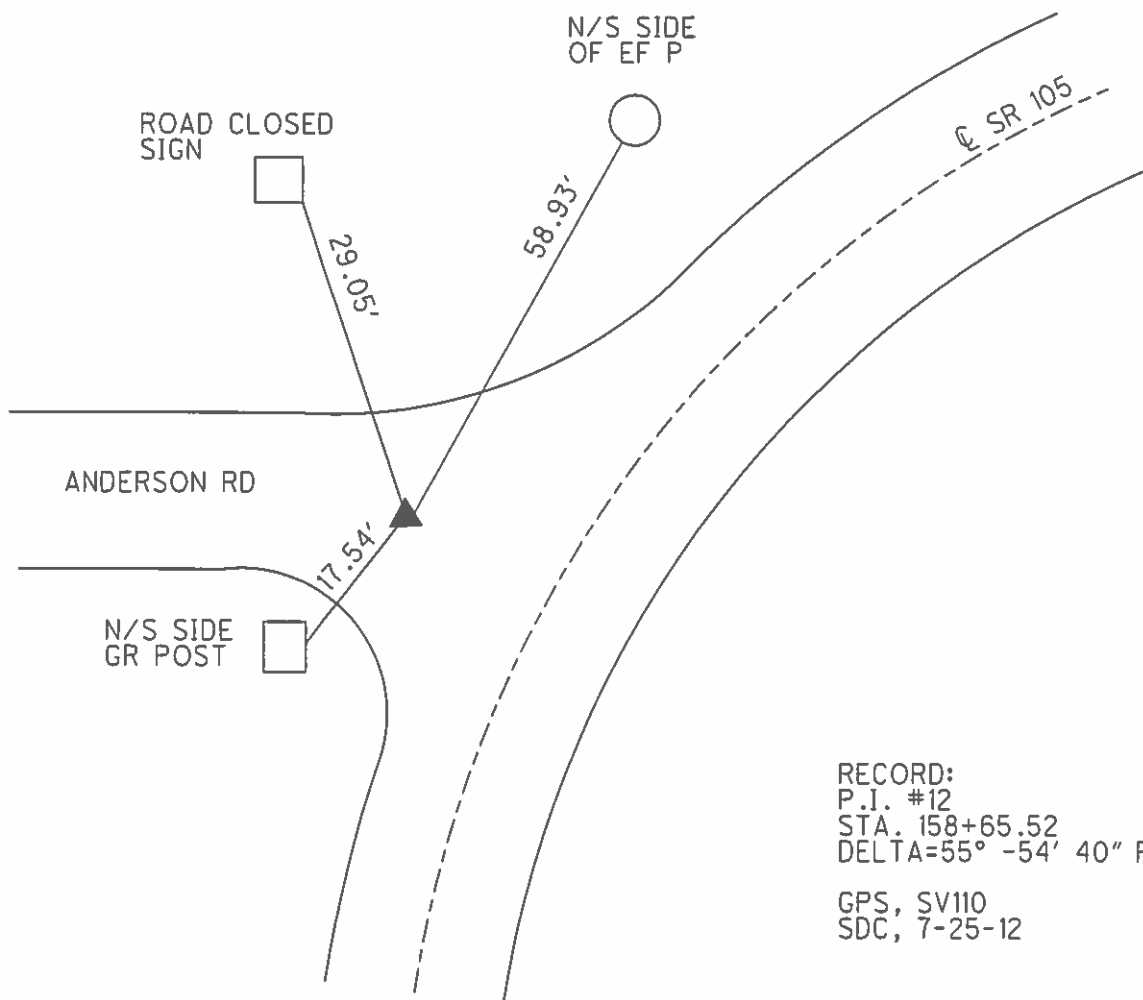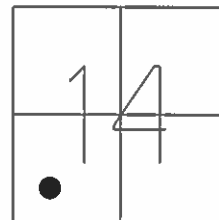

RECORD:
 P.I. #12
 STA. 158+65.52
 DELTA=55° -54' 40" RT.
 GPS, SV110
 SDC, 7-25-12

O.D.O.T. DISTRICT 2 SURVEY OFFICE

PERSONNEL

REFERENCE NO. 14

SHEET 20 OF 63

NOTES MOSE

DATE 4-15-02

ROUTE 105

H.C. CANTERBURY

WEATHER SUNNY

COUNTY WOOD

R.C. BARNHISEL

TEMP. +75°

TOWNSHIP WEBSTER

SECTION 14

T 5 N R 11 E


~~TYPE MONUMENT~~ 3/4" IRON ROD

~~ON SURFACE - BELOW~~ 6" BELOW


~~LEFT - Q PAV'T - RIGHT~~ 34.1' LT.

TO EDGE PAVEMENT

S.L.M. 157+84

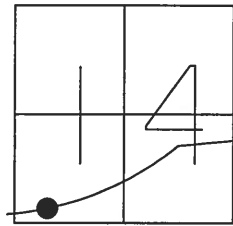

RECORD:
P.I. #12
STA. 158+65.52
DELTA=55°-54'-40" RT.

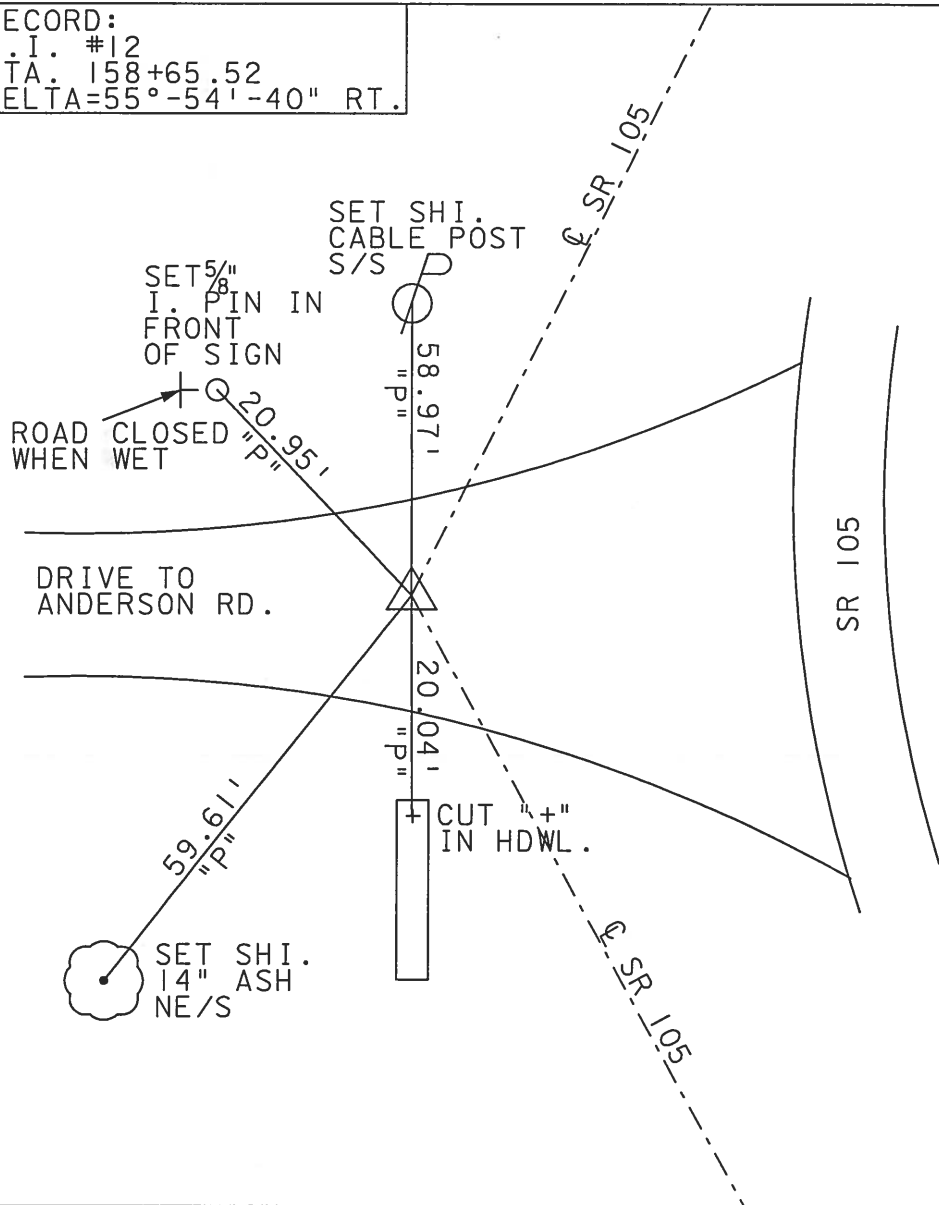

O.D.O.T. DISTRICT 2 SURVEY OFFICE

PERSONNEL _____

REFERENCE NO. 14

SHEET 19 OF 57

NOTES LONG

H.C. VANDUSEN

R.C. BARNHISEL

DATE 8-19-91

WEATHER cloudy

TEMP. 70°

ROUTE 105

COUNTY WOOD

TOWNSHIP WEBSTER

SECTION 14

T5 N R 11 E


TYPE MONUMENT 3/4" IRON ROD

ON SURFACE - BELOW 6"


LEFT- & PAV'T. - RIGHT 35.0'

— TO — EDGE PAVEMENT

S.L.M. 157+84

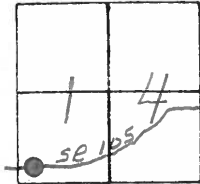

RECORDS
 P.I. #12
158+65.52
 $\Delta = 55^\circ - 54' - 40''$ RT

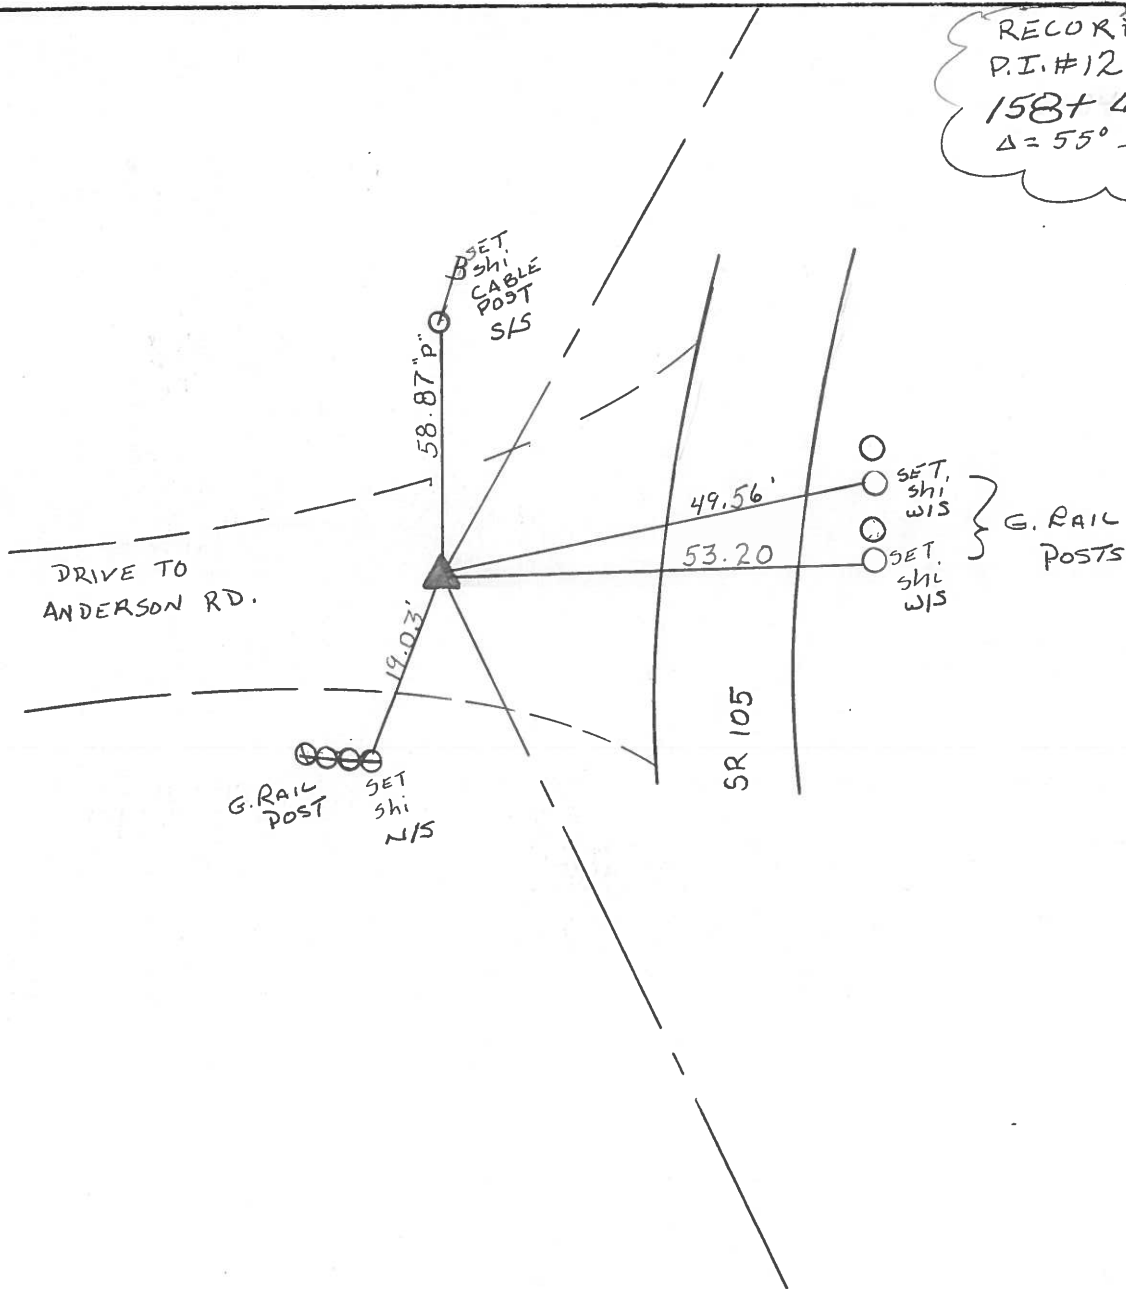

County WOOD S.R. 105

Date 4-19-82

Township WEBSTER

Weather CLEAR

Section 14

Temp. 72°


T, N, R, E

Personnel HOFFMAN

HOUSEHOLDER

LOEHRKE

#14

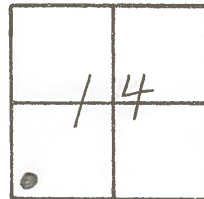

P.I. #12


158+65.52

$\Delta = 55^{\circ}-54'-40''$ RT.

PAINTED ARROW
ON W.E.P.
5-25-82
S.W.H.

DRIVE TO
ANDERSON RD.

FD. BENT 3/4" IRON ROD
1" BELOW SURFACE
36.2' N.W. OF ϵ PAUT.

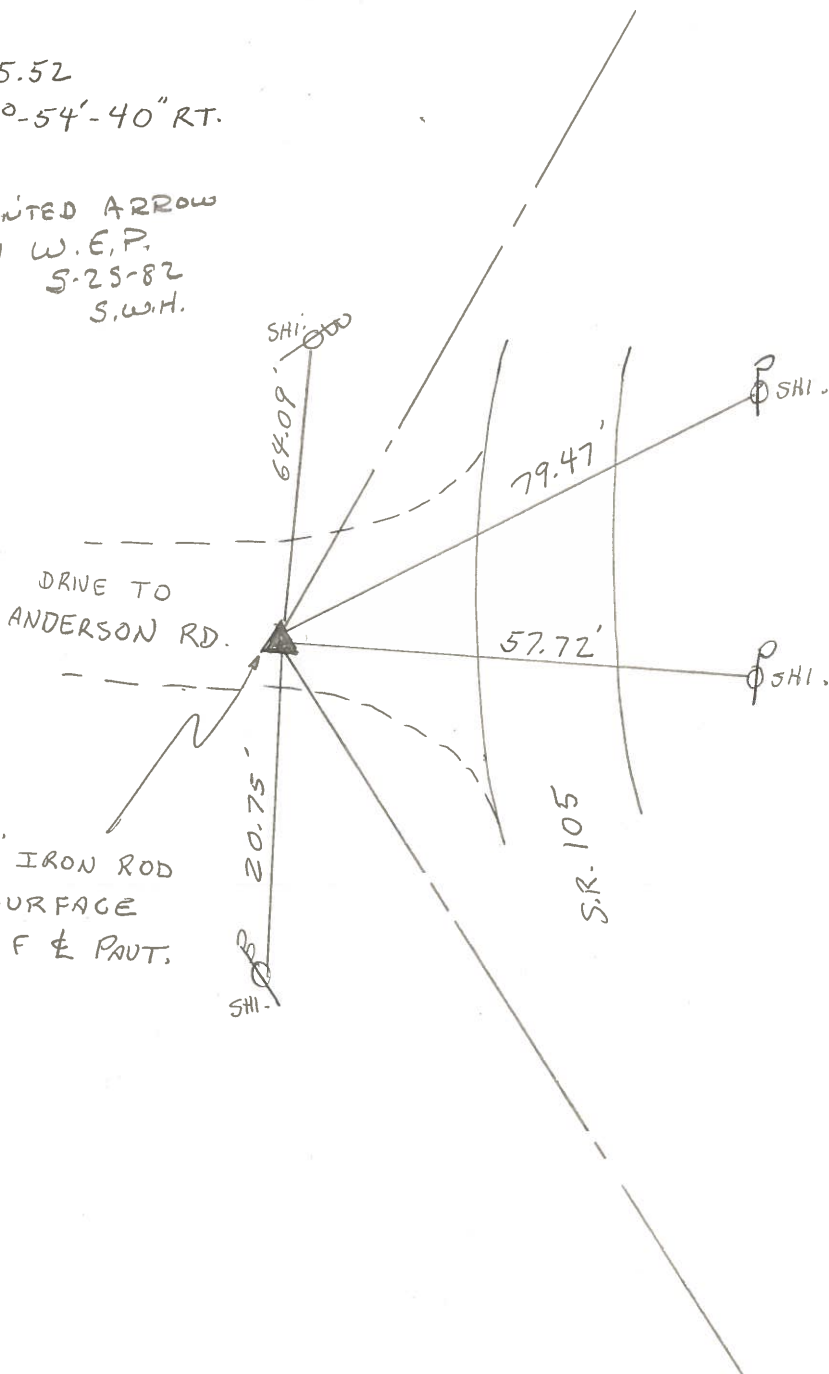

PERSONNEL	TITLE	PERSONNEL	TITLE	COUNTY	DATE
Stone	Notes			Wood	22 Sept. 72
Michalak	FI			S. R. #105	WEATHER Cool
Denno	H.C.			SEC. 14	TEMP. 61°
Curtis	R.C.				

DESCRIPTION References to Control Points JOB NO. _____

LEFT CENTER LINE RIGHT

