


O.D.O.T. DISTRICT 2 SURVEY OFFICE (USE ONLY)


PERSONNEL	REFERENCE NO.	15	SHEET	1	OF	54
NOTES	RHOADES	DATE	9/12/16	ROUTE	SR 105	
H.C.	O'DONNELL	WEATHER	SUNNY	COUNTY	WOOD	
R.C.	RHOADES	TEMP.	55°	TOWNSHIP	WEBSTER	
				SECTION	14	
				T 5 N	R 11 E	

TYPE MONUMENT P.K.NAIL
 ON SURFACE - ~~BELOW~~ ON _____
 LEFT - \odot PAV'T - ~~RIGHT~~ 0.3'
10.3' TO RT EDGE PAVEMENT
 S.L.M. 162+23

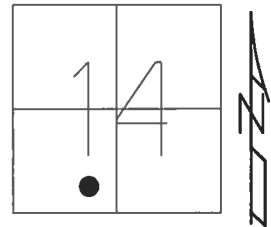

GRID: NORTHING: 628270.741 EASTING: 1675060.884


RECORD:
 SET P.K./WASHER
 6/12/02, DCH
 FD P.K.NAIL
 REF15
 6/2/16, JFO
 SET 1" MAG/WASHER
 6/2/17, JFO

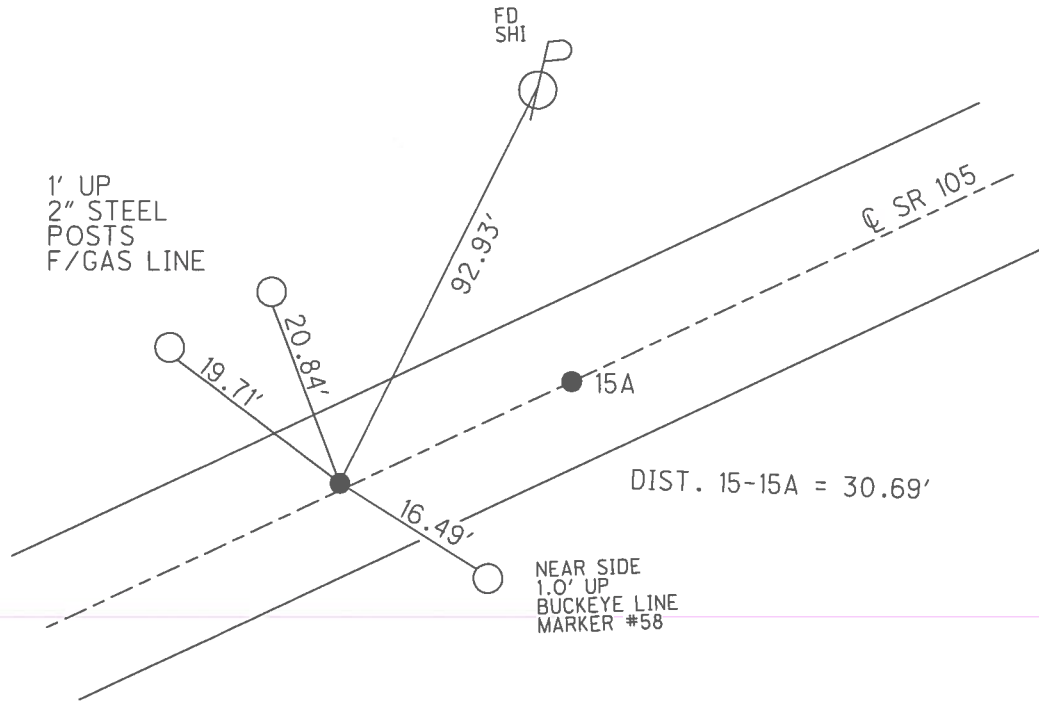


O.D.O.T. DISTRICT 2 SURVEY OFFICE (USE ONLY)

PERSONNEL _____ REFERENCE NO. 15 SHEET 1 OF 54
 NOTES MOSER DATE 4/15/02 ROUTE SR 105
 H.C. CANTERBURY WEATHER SUNNY COUNTY WOOD
 R.C. BARNHISEL TEMP. 75° TOWNSHIP WEBSTER
 _____ SECTION 14
 _____ T 5 N R 11 E

TYPE MONUMENT P.K./WASHER
 ON SURFACE - ~~BELOW~~ ON _____
 LEFT - ☉ PAV'T - ~~RIGHT~~ 0.3'
10.3' TO RT EDGE PAVEMENT
 S.L.M. 162+23
 GRID: NORTHING: _____ EASTING: _____

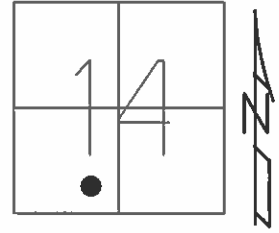

RECORD:
 SET P.K./WASHER
 6/12/02, DCH

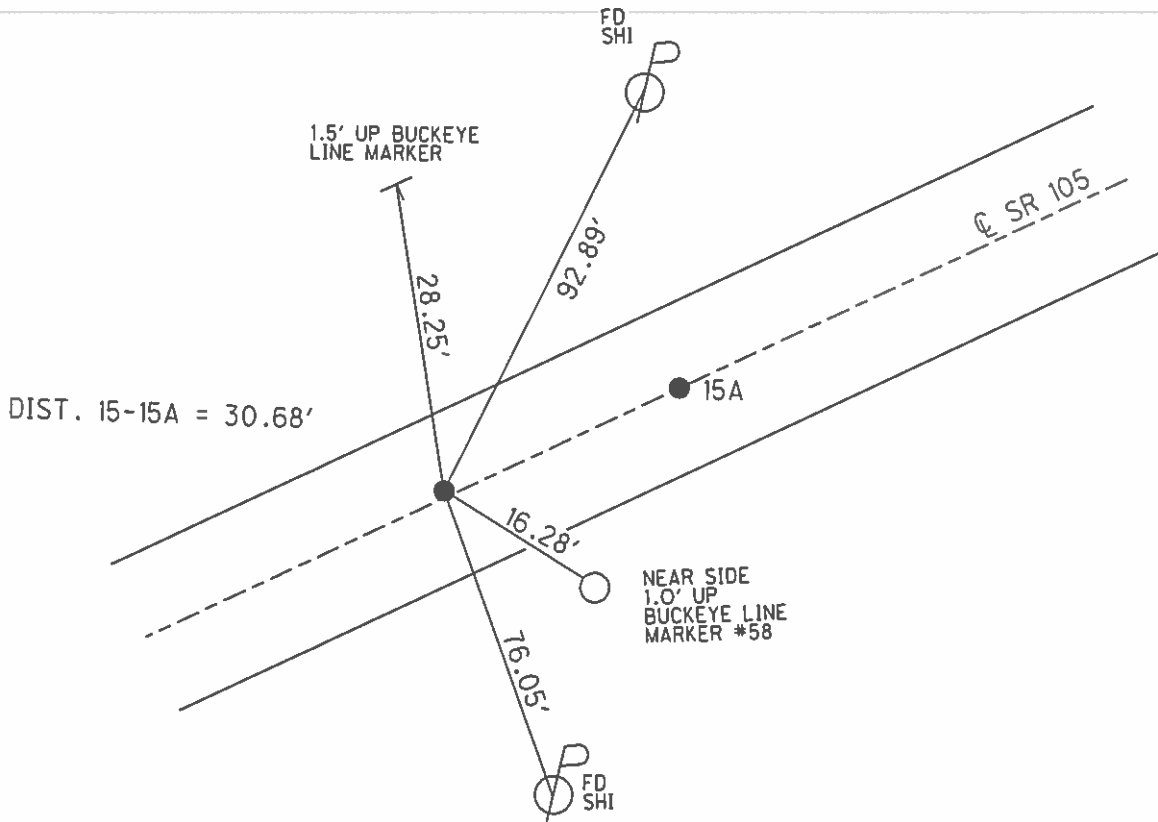

O.D.O.T. DISTRICT 2 SURVEY OFFICE

PERSONNEL _____

REFERENCE NO. 15

SHEET 20 OF 57

NOTES LONG

H.C. VANDUSEN

DATE 8-19-91

ROUTE 105

R.C. BARNHISEL

WEATHER cloudy

COUNTY WOOD

TEMP. 75°

TOWNSHIP WEBSTER

SECTION 14

T 5 N R 11 E


TYPE MONUMENT PK & WASHER

ON SURFACE - ~~BELOW~~ YES


LEFT- & PAV'T. - RIGHT 0.7'

10.4' TO LT EDGE PAVEMENT

S.L.M. 164+09 "A"

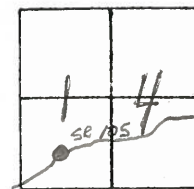

A=15B
B=15A
C=15

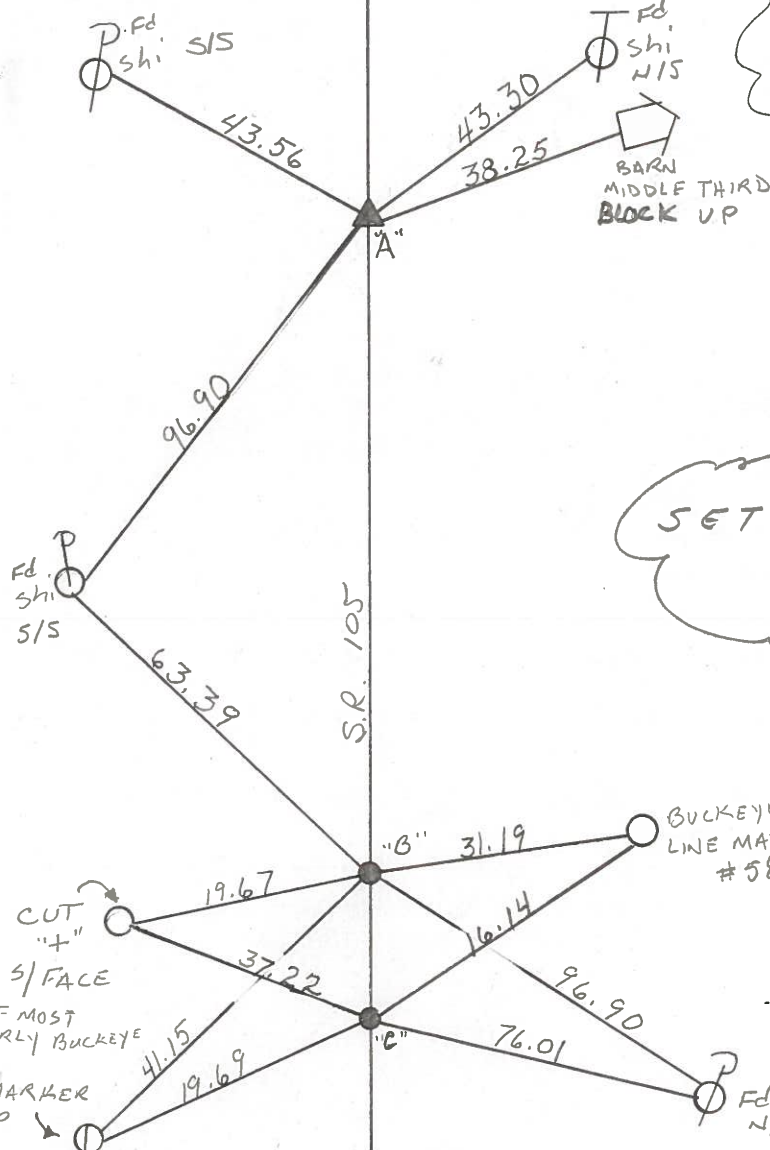

RECORD
P.I. #13
STA:
166+02.80
 $\Delta = 0^\circ - 26' - 20''$ LT,

SET PK & WASHER
4-8-92
BVD

PT. "B"
162+68

PT "C"
162+23

County WOOD S.R. 105

Date 4-20-82

Township WEBSTER

Weather RAIN

Section 14

Temp. +50°


T, N, R, E

Personnel HOFFMAN

HOUSEHOLDER

LOEHRKE


15

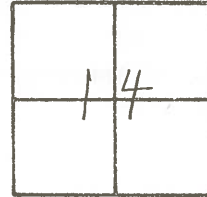

P.I. #13
165+02.80
A = 0°-26'-20" LT.

SET P.K.^s & WASHERS @ ALL
POINTS 5-25-82 S.W.H.

A=15B
B=15A
C=15

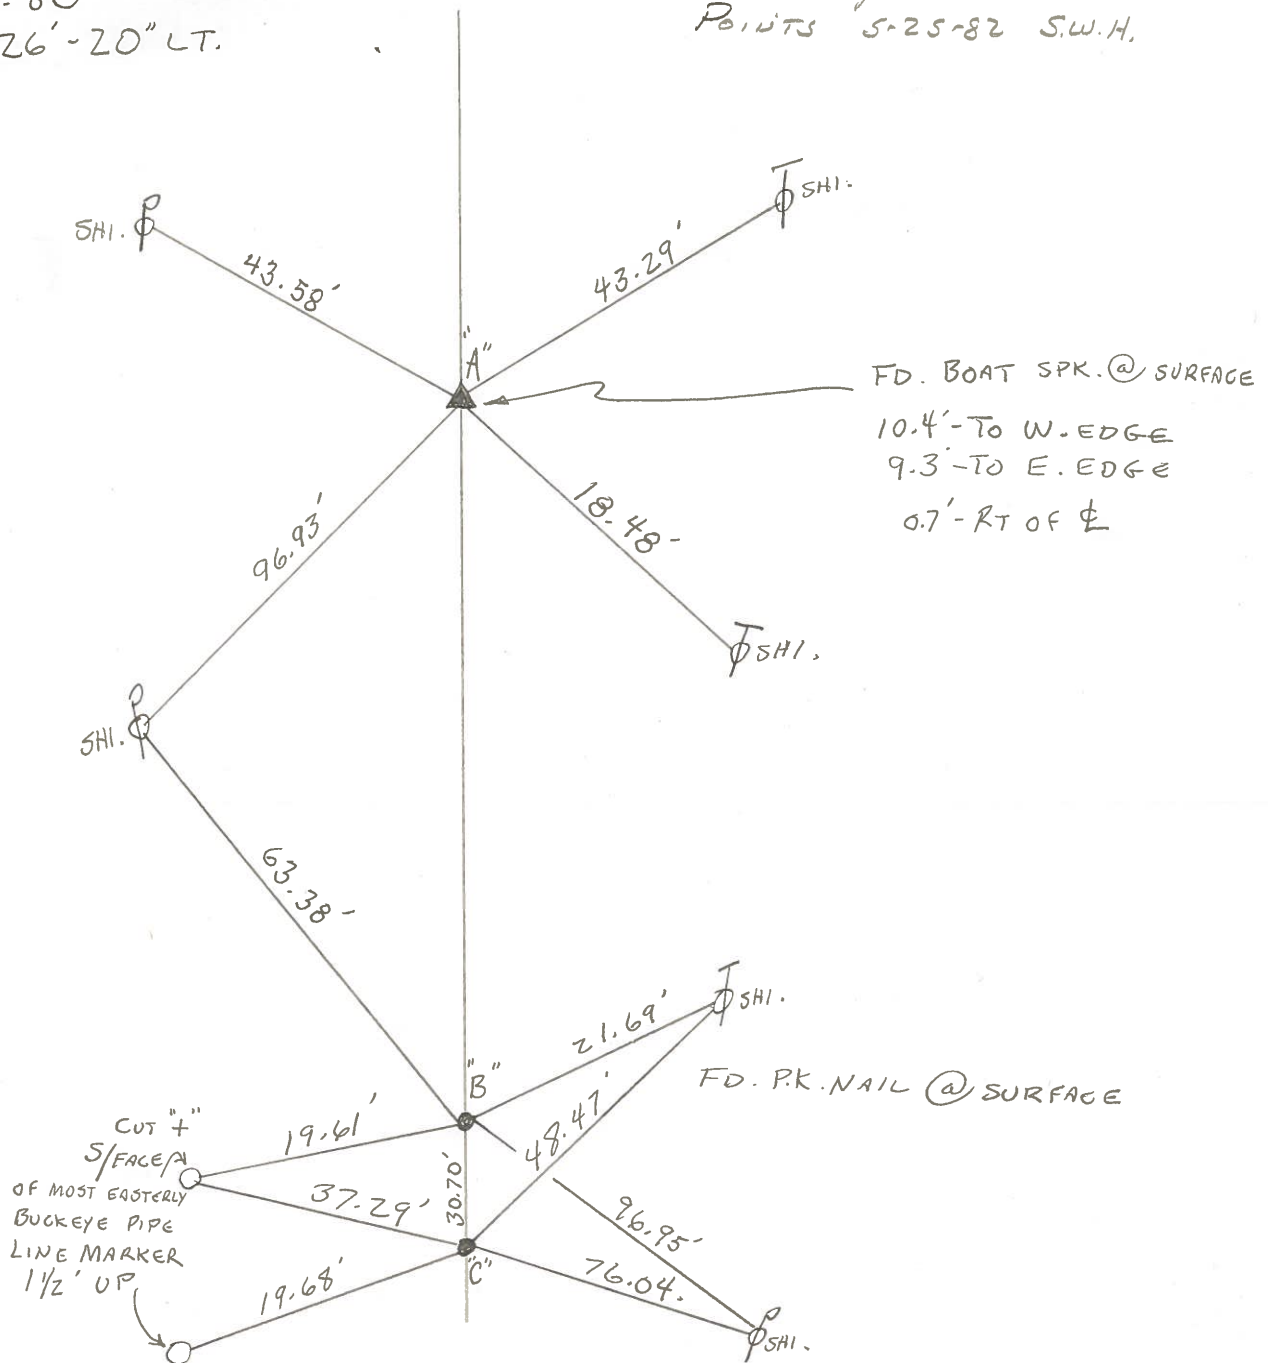

PERSONNEL	TITLE	PERSONNEL	TITLE	COUNTY	DATE
Stone	Notes			Wood	22 Sept. 72
Donna	H.C.			S. R. #105	WEATHER Cool
Michalak	P.C.			SEC. 14	TEMP. 65°
Curtis	AD				

DESCRIPTION References to Control Points JOB NO. _____

