


O.D.O.T. DISTRICT 2 SURVEY OFFICE (USE ONLY)


PERSONNEL \_\_\_\_\_ REFERENCE NO. 15 B SHEET 3 OF 54  
 NOTES RHOADES DATE 9/12/16 ROUTE SR 105  
 H.C. O'DONNELL WEATHER SUNNY COUNTY WOOD  
 R.C. RHOADES TEMP. 55° TOWNSHIP WEBSTER  
 \_\_\_\_\_ SECTION 14  
 \_\_\_\_\_ T 5 N R 11 E

TYPE MONUMENT P.K.NAIL  
 ON SURFACE - ~~BELOW~~ ON \_\_\_\_\_  
~~LEFT~~ - CL PAV'T - RIGHT 0.6'  
9.3' TORT EDGE PAVEMENT  
 S.L.M. 164+09

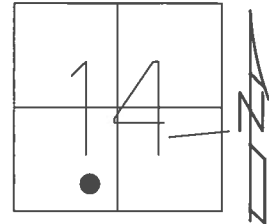

GRID: NORTHING: 628323.579 EASTING: 1675239.559


RECORD: P.I.  
 STA. 165+02.80  
 $\Delta = 0^\circ 26' 20''$  LT  
 SET P.K./WASHER  
 6/12/02, DCH  
 FD P.K.NAIL  
 REFB15  
 6/2/16, JFO  
 SET 1" MAG/WASHER  
 6/2/17, JFO

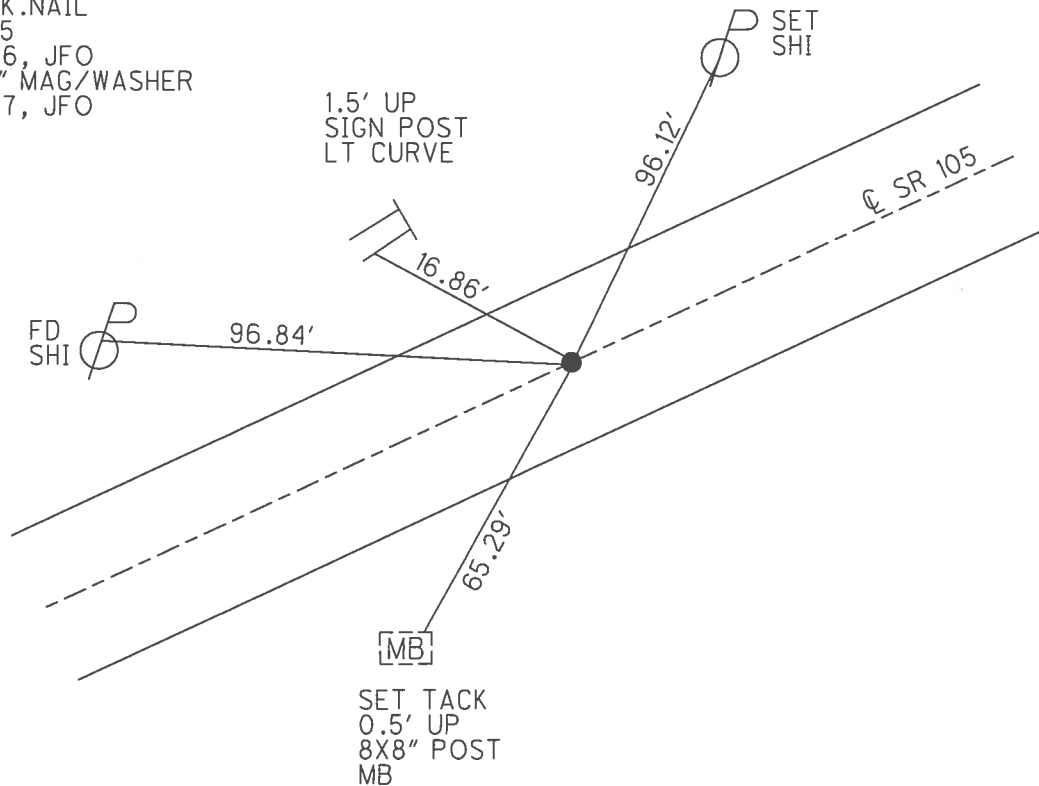

**O.D.O.T. DISTRICT 2 SURVEY OFFICE (USE ONLY)**


PERSONNEL \_\_\_\_\_ REFERENCE NO. 15 B SHEET 3 OF 54  
 NOTES MOSER DATE 4/15/02 ROUTE SR 105  
 H.C. CANTERBURY WEATHER SUNNY COUNTY WOOD  
 R.C. BARNISEL TEMP. 75° TOWNSHIP WEBSTER  
 SECTION 14  
 T 5 N R 11 E

TYPE MONUMENT P.K./WASHER  
 ON SURFACE - ~~BELOW~~ ON \_\_\_\_\_  
~~LEFT~~ - Q PAV'T - RIGHT 0.6'  
9.3' TORT EDGE PAVEMENT  
 S.L.M. 164+09

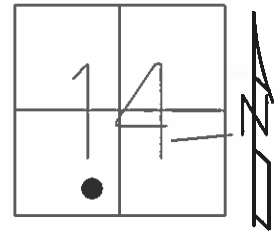

GRID: NORTHING: \_\_\_\_\_ EASTING: \_\_\_\_\_

RECORD: P.I.  
 STA. 165+02.80  
 $\Delta = 0^\circ 26' 20''$  LT  
 SET P.K./WASHER  
 6/12/02, DCH

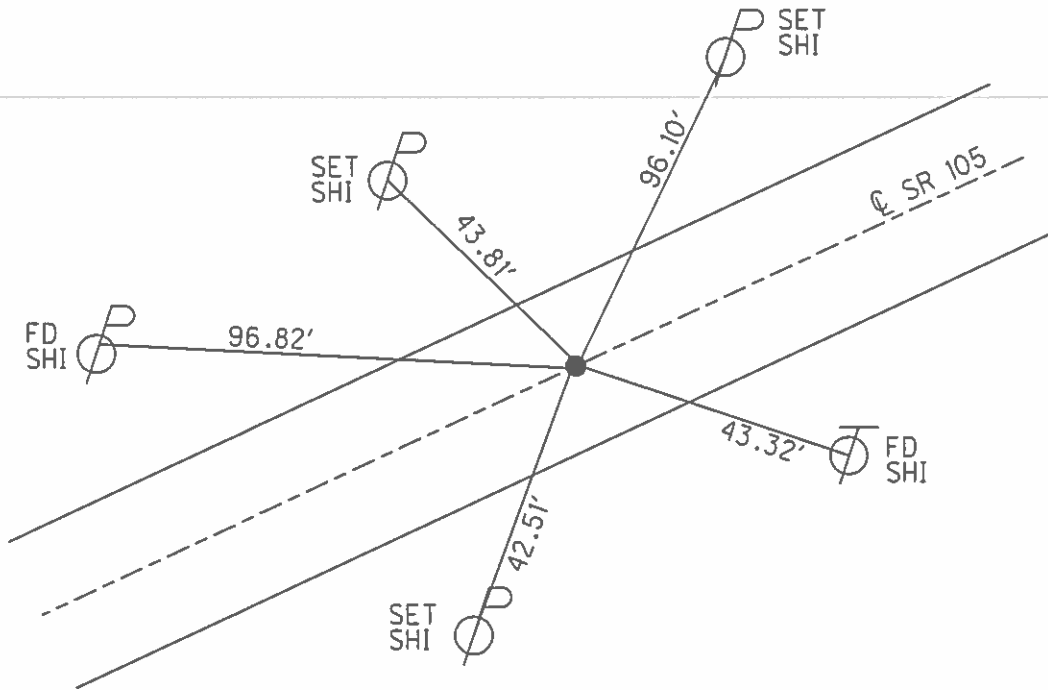

# O.D.O.T. DISTRICT 2 SURVEY OFFICE

PERSONNEL

REFERENCE NO. 15

SHEET 20 OF 57

NOTES LONG

H.C. VANDUSEN

DATE 8-19-91

ROUTE 105

R.C. BARNHISEL

WEATHER Cloudy

COUNTY WOOD

TEMP. 75°

TOWNSHIP WEBSTER

SECTION 14

T5 N R 11 E


TYPE MONUMENT PK & WASHER

ON SURFACE - ~~BELOW~~ YES


LEFT-C PAV'T. - RIGHT 0.7

10.4 TO LT EDGE PAVEMENT

S.L.M. 164+09 "A"

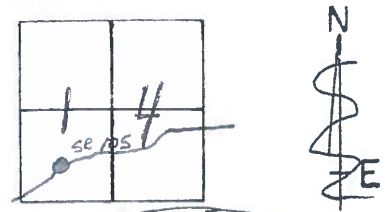

A=15B  
B=15A  
C=15

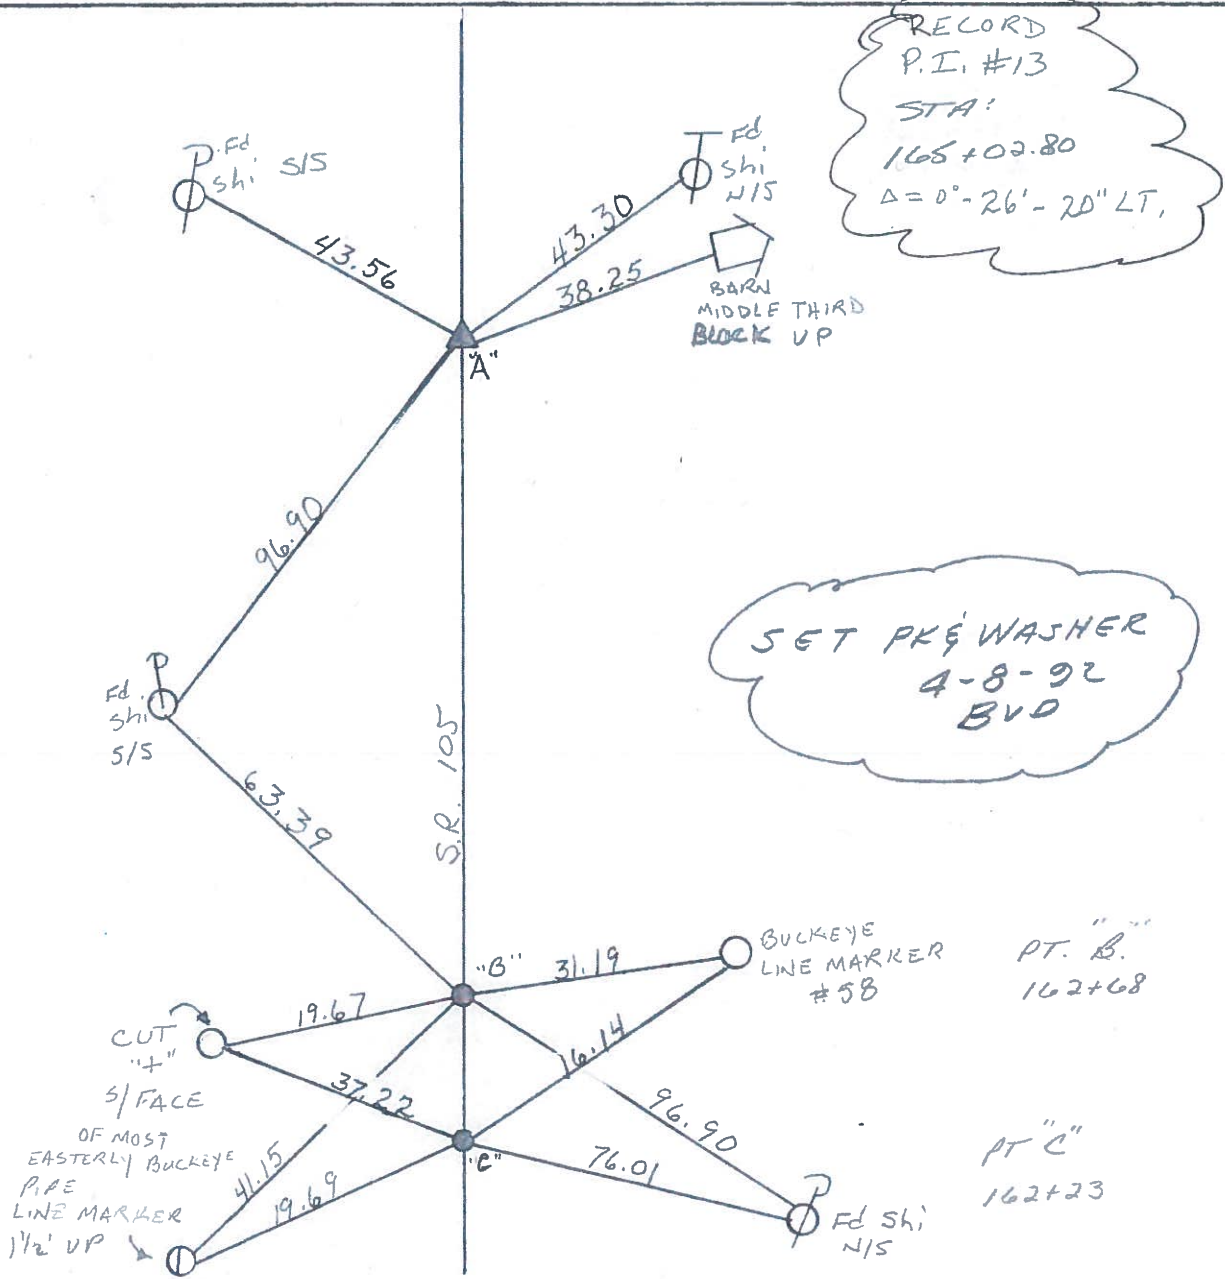

RECORD  
 P.I. #13  
 STA:  
 166+02.80  
 $\Delta = 0^{\circ}-26'-20''$  LT.

SET PK & WASHER  
 4-8-92  
 BVD

PT. "B"  
162+68

PT "C"  
162+23

County WOOD S.R. 105

Date 4-20-82

Township WEBSTER


Weather RAIN

Section 14

Temp. +50°

T N, R E

Personnel HOFFMAN

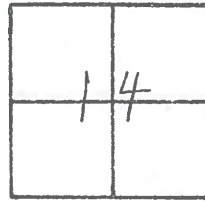

# 15

HOUSEHOLDER  
LOEHRKE

P.I. #13

165+02.80

A = 0°-26'-20" LT.

SET P.K.<sup>s</sup> & WASHERS @ ALL POINTS 5-25-82 S.W.H.

A=15B  
B=15A  
C=15

