


O.D.O.T. DISTRICT 2 SURVEY OFFICE (USE ONLY)


PERSONNEL \_\_\_\_\_ REFERENCE NO. 18 A SHEET 8 OF 54  
 NOTES RHOADES DATE 9/12/16 ROUTE SR 105  
 H.C. O'DONNELL WEATHER SUNNY COUNTY WOOD  
 R.C. RHOADES TEMP. 55° TOWNSHIP WEBSTER  
 SECTION 14  
T 5 N R 11 E

TYPE MONUMENT P.K./WASHER  
 ON SURFACE - ~~BELOW~~ ON \_\_\_\_\_  
 LEFT - ☉ PAV'T - RIGHT ON \_\_\_\_\_  
9.8' TO RT EDGE PAVEMENT  
 S.L.M. 174+91

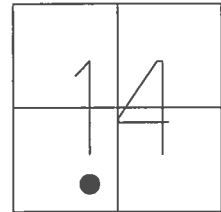

GRID: NORTHING: 628749.693 EASTING: 1676236.094


RECORD: P.I.  
 STA. 175+94.19  
 $\Delta = 1^{\circ}-34'-40''$  LT  
 FD P.K./WASHER  
 4/15/02, MB  
 SET P.K./WASHER  
 6/12/02, DCH  
 FD P.K./WASHER  
 REFA18  
 6/6/16, JFO  
 SET 1" MAG/WASHER  
 NEWREFA18  
 6/20/17, JFO

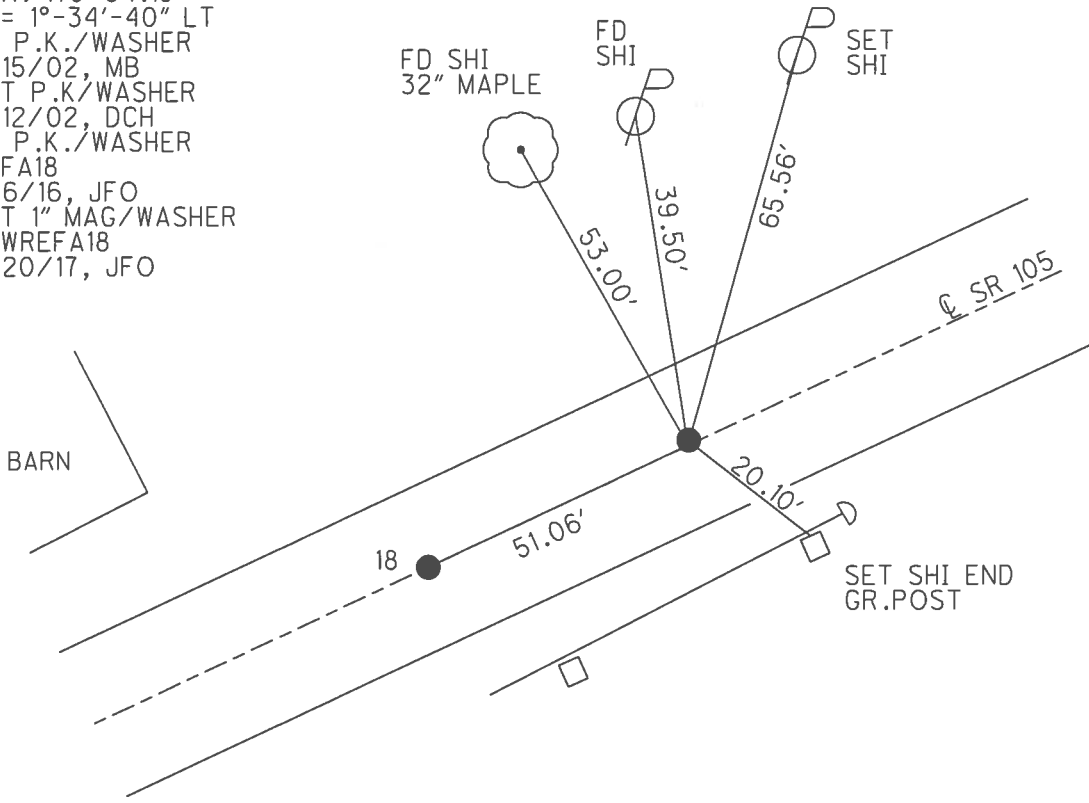


**O.D.O.T. DISTRICT 2 SURVEY OFFICE (USE ONLY)**

PERSONNEL \_\_\_\_\_ REFERENCE NO. 18 A SHEET 8 OF 54  
 NOTES MOSE DATE 4/15/02 ROUTE SR 105  
 H.C. CANTERBURY WEATHER SUNNY COUNTY WOOD  
 R.C. BARNHISEL TEMP. 80° TOWNSHIP WEBSTER  
 SECTION 14  
T 5 N R 11 E

TYPE MONUMENT P.K./WASHER  
 ON SURFACE - ~~BELOW~~ ON \_\_\_\_\_  
 LEFT - C PAV'T - RIGHT ON \_\_\_\_\_  
9.8' TO RT EDGE PAVEMENT  
 S.L.M. 174+91  
 GRID: NORTHING: \_\_\_\_\_ EASTING: \_\_\_\_\_

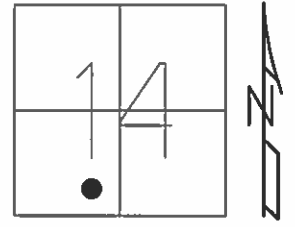

RECORD: P.I.  
 STA. 175+94.19  
 $\Delta = 1^{\circ}-34'-40''$  LT  
 SET P.K./WASHER  
 6/12/02, DCH

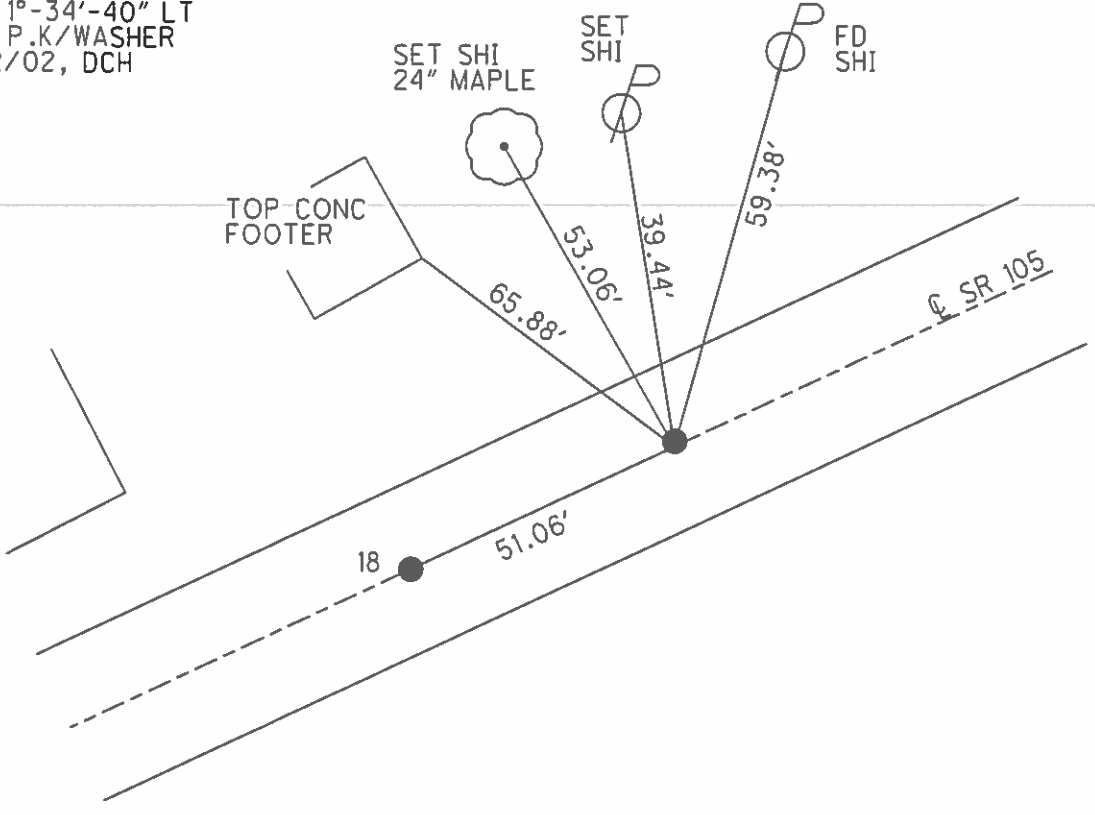

# O.D.O.T. DISTRICT 2 SURVEY OFFICE

PERSONNEL \_\_\_\_\_

REFERENCE NO. 18

SHEET 23 OF 57

NOTES LONG

H.C. VAN DUSEN

R.C. BARNHISEL

DATE 8-19-91

WEATHER cloudy

TEMP. 70°

ROUTE 105

COUNTY WOOD

TOWNSHIP WEBSTER

SECTION 14

T5 N R 11 E


TYPE MONUMENT P.K. / WASHER (BOTH)

ON SURFACE - BELOW YES (BOTH)

~~LEFT~~ - C. PAV'T. - RIGHT YES (BOTH)

30TH 9.8' TO RT EDGE PAVEMENT


S.L.M. 174+91 ~ PT "A"

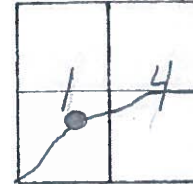

SET PK & WASHER  
4-8-92  
BVD

A=18A  
B=18

PT. "A"  
RECORD  
PT. # 16  
175+94.19  
Δ=1°-34'-40" LT.

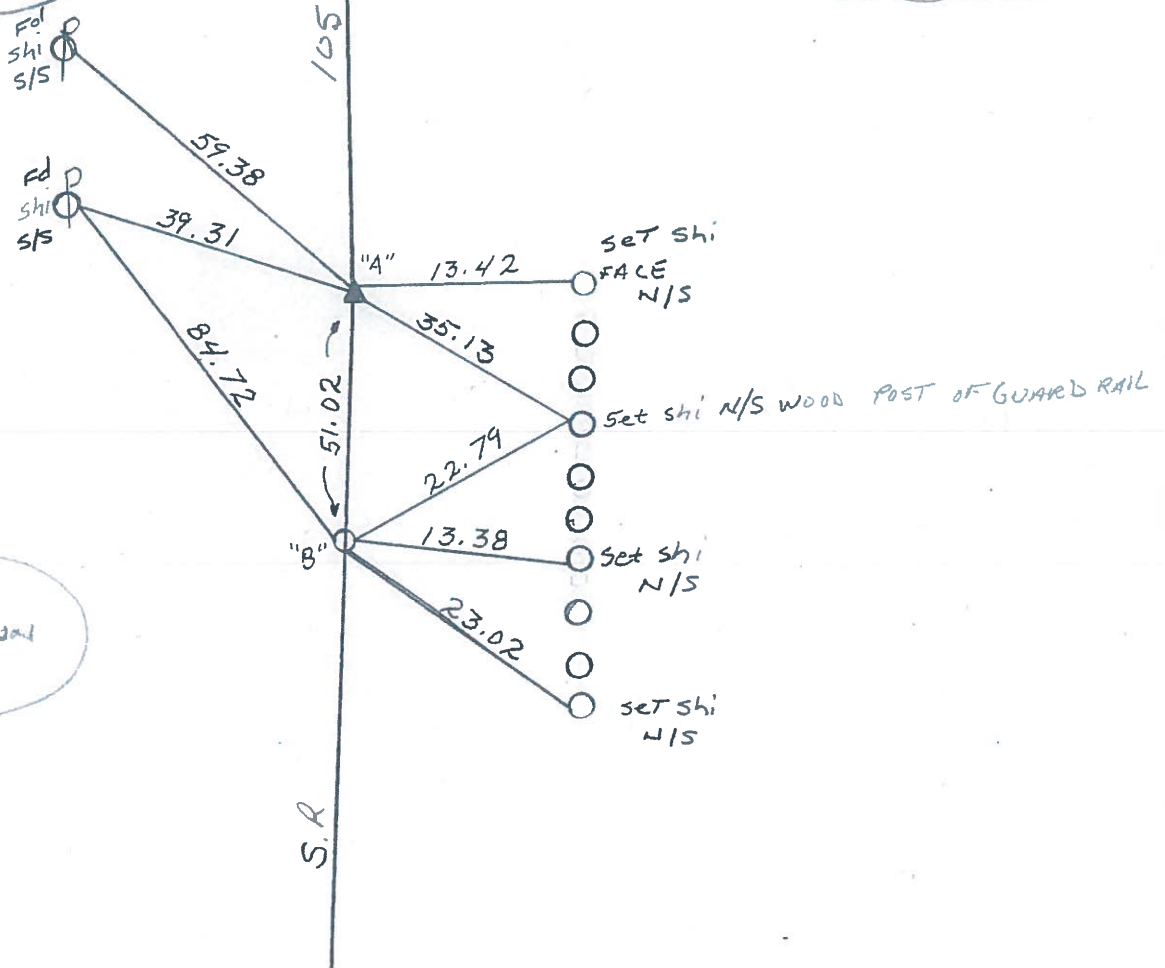

POINT "B"  
ORIGIN UNKNOWN

County Wood S.R. 105

Date 4-20-82

Township WEBSTER

Weather CLOUDY

Section 14

Temp. +50°


T, N, R, E

Personnel HOFFMAN

HOUSEHOLDER

LOEHRKE

#18

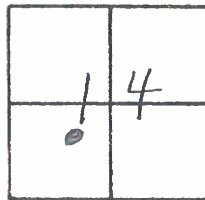

P.I. #16

A" 175+94.19  
 $\Delta = 1^{\circ} - 34' - 40''$  Lt.

A=18A  
 B=18

