


O.D.O.T. DISTRICT 2 SURVEY OFFICE (USE ONLY)


PERSONNEL	REFERENCE NO.	19	SHEET	9	OF	54
NOTES	RHOADES	DATE	10/113/17	ROUTE	SR 105	
H.C.	O'DONNELL	WEATHER	HAZE	COUNTY	WOOD	
R.C.	FARKAS	TEMP.	59°	TOWNSHIP	WEBSTER	
				SECTION	14	
				T	5	N
				R	11	E

TYPE MONUMENT 1" MAG/WASHER
 ON SURFACE - ~~BELOW~~ ON
~~LEFT~~ - C PAV'T - RIGHT 0.4'
9.5' TOLT EDGE PAVEMENT
 S.L.M. 177+31

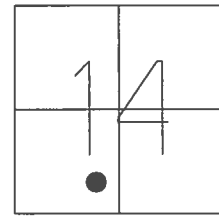

GRID: NORTHING: 628862.395 EASTING: 1676439.562

RECORD: P.I.
 STA. 178+26.90
 $\Delta = 0^\circ - 47' - 20''$ LT
 FD P.K./WASHER
 4/15/02, MB
 SET P.K./WASHER
 6/12/02, DCH
 SET MAG/WASHER
 REF 19
 6/6/16, JFO
 SET 1" MAG/WASHER
 10/13/17, JFO

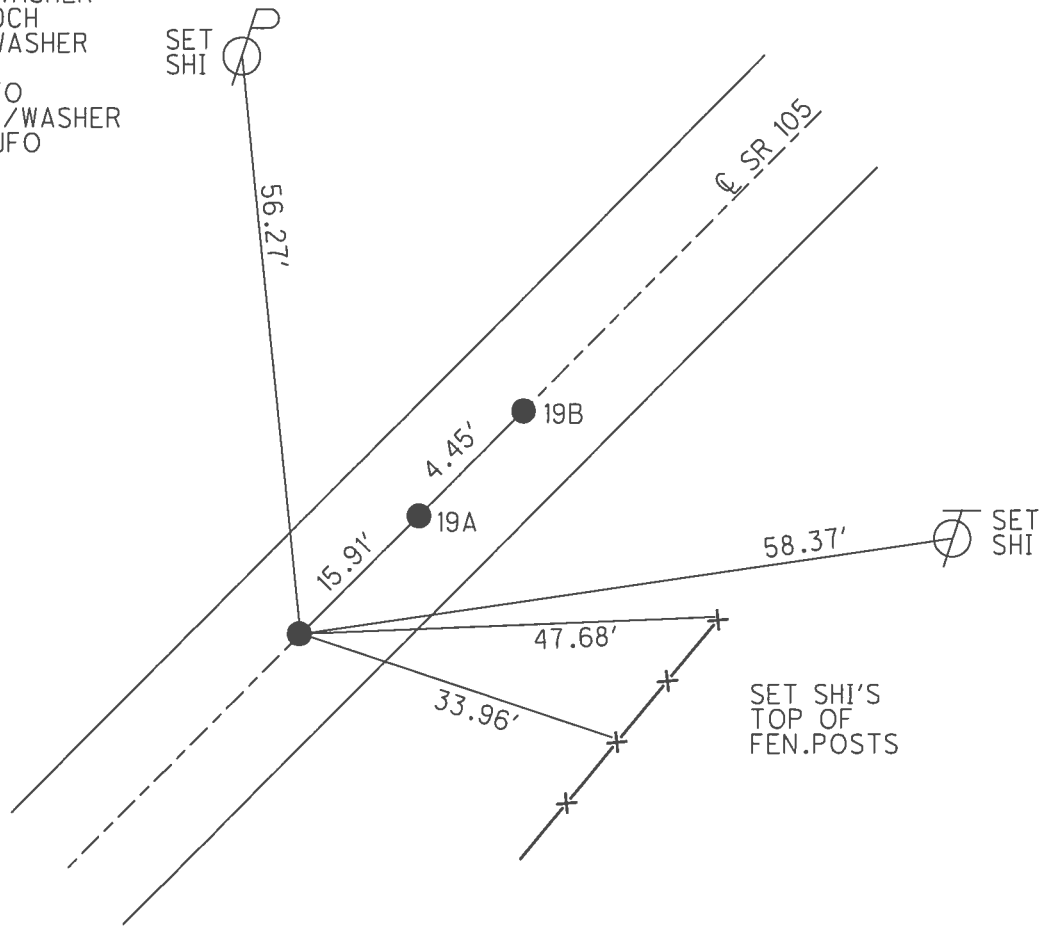


SET SHI'S
 TOP OF
 FEN.POSTS

O.D.O.T. DISTRICT 2 SURVEY OFFICE (USE ONLY)

PERSONNEL _____ REFERENCE NO. 19 SHEET 9 OF 54


NOTES	<u>MOSE</u>	DATE	<u>4/15/02</u>	ROUTE	<u>SR 105</u>
H.C.	<u>CANTERBURY</u>	WEATHER	<u>SUNNY</u>	COUNTY	<u>WOOD</u>
R.C.	<u>BARNISEL</u>	TEMP.	<u>80°</u>	TOWNSHIP	<u>WEBSTER</u>
				SECTION	<u>14</u>
				<u>T 5 N R 11 E</u>	

TYPE MONUMENT P.K./WASHER
 ON SURFACE - ~~BELOW~~ ON _____
~~LEFT~~ - CL PAV'T - RIGHT 0.4'
9.5' TOLT EDGE PAVEMENT
 S.L.M. 177+31

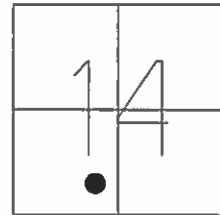

GRID: NORTHING: _____ EASTING: _____

RECORD: P.I.
 STA. 178+26.90
 $\Delta = 0^\circ - 47' - 20''$ LT
 SET P.K./WASHER
 6/12/02, DCH

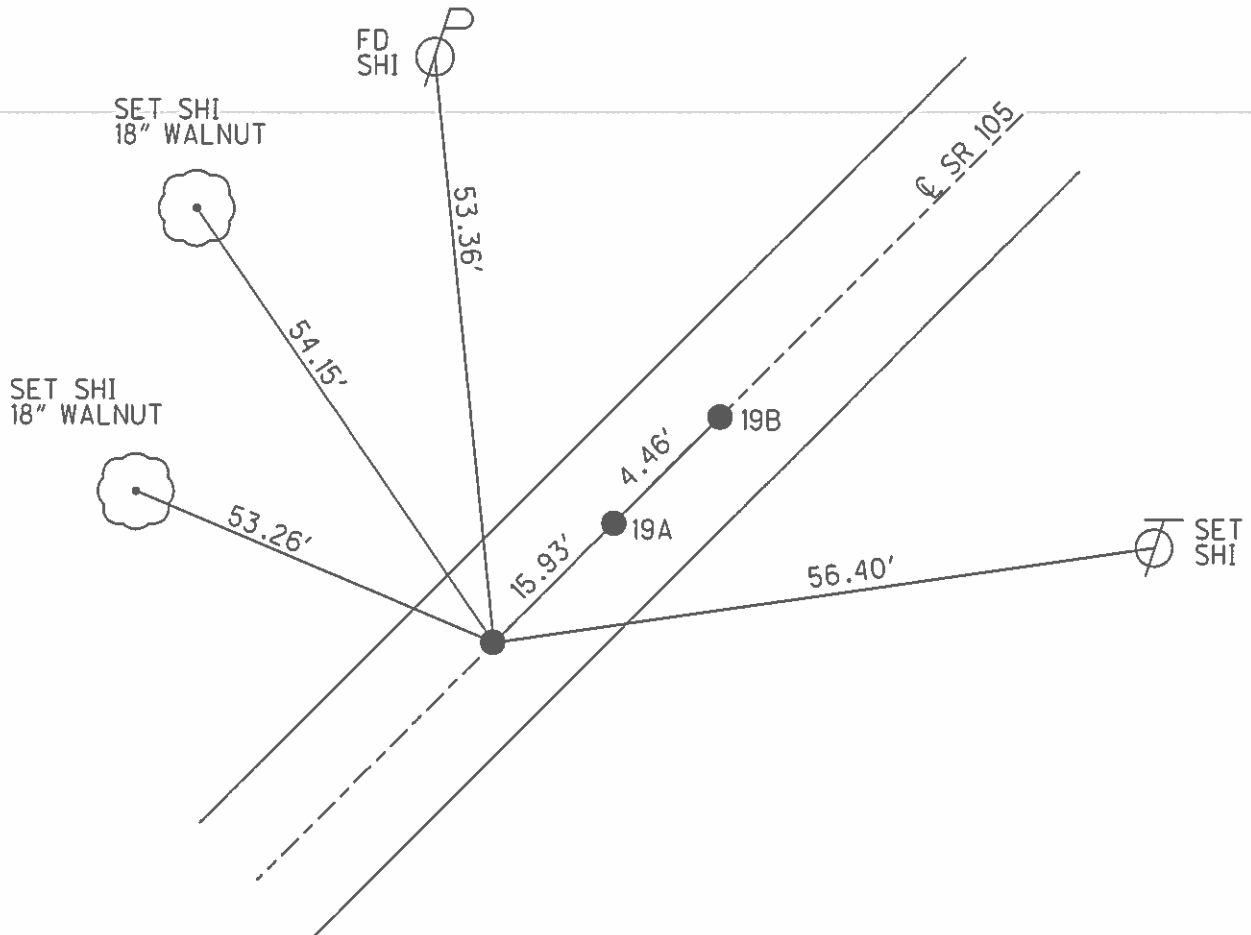

O.D.O.T. DISTRICT 2 SURVEY OFFICE

PERSONNEL

REFERENCE NO. 19

SHEET 24 OF 57

NOTES BARNHISEL

H.C. VAN DUSEN

R.C. BARNHISEL

DATE 8-19-91

WEATHER cloudy

TEMP. +75°

ROUTE 105

COUNTY WOOD

TOWNSHIP Webster

SECTION 14

T 5 N R 11 E


TYPE MONUMENT P.K. & WASHER ~ P.I.

ON SURFACE - BELOW yes

LEFT - C PAV'T. - RIGHT yes

10.6 TO RT EDGE PAVEMENT


S.L.M. 177+31

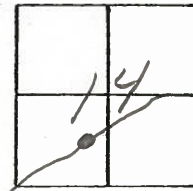

PT: "A"
 RECORD:
 P.I. #17
 STA: 178+26.90
 $\Delta = 0^\circ - 47' - 20''$ LT

SET P.K.'S & WASHERS
 4-8-92
 BUD

A = 19B 19
 B = 19A
 C = 19B

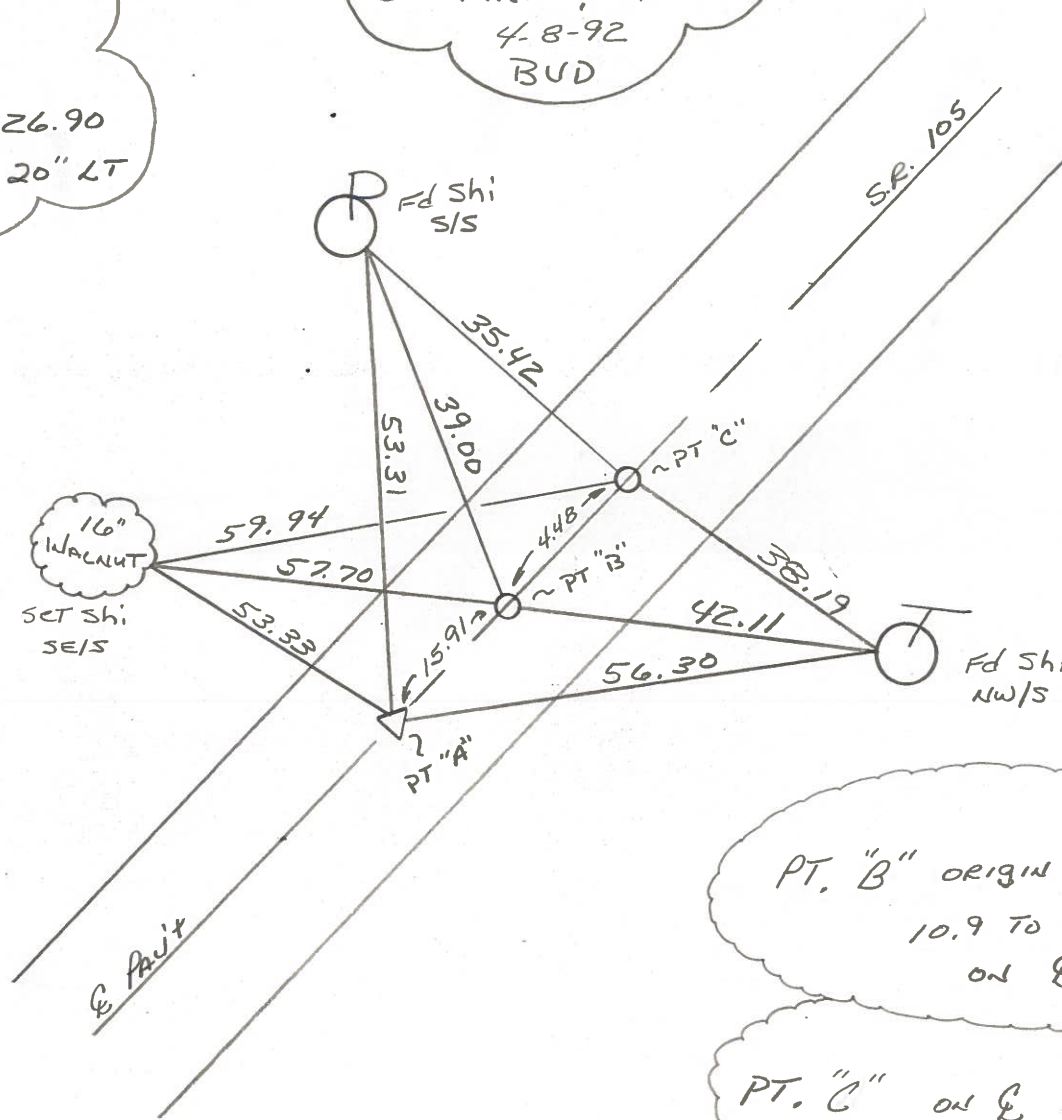

PT. "B" ORIGIN UNKNOWN
 10.9 TO RT Edge
 ON E

PT. "C" ON E
 10.6 TO RT Edge

County Wood S.R. 105

Date 4-20-82

Township Webster

Weather LT. Rain

Section 14

Temp. +50°


T, N, R, E

Personnel HOFFMAN

Loehrke

Householder

#19

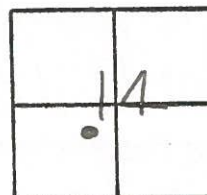

PT. "A" Fd. R.R. SPK. @ surface
(Set by others)

P.I. #17 178+26.90

$\Delta = 0^\circ - 47' - 20''$ LT.



10.5 TO E. EP.

9.5 TO W. EP.

0.4' LT. of ϕ PAUT

Project start $\pm 177+59$

SET P.K./WASHER
@ ALL 3 POINTS
5-25-82 S.W.H.

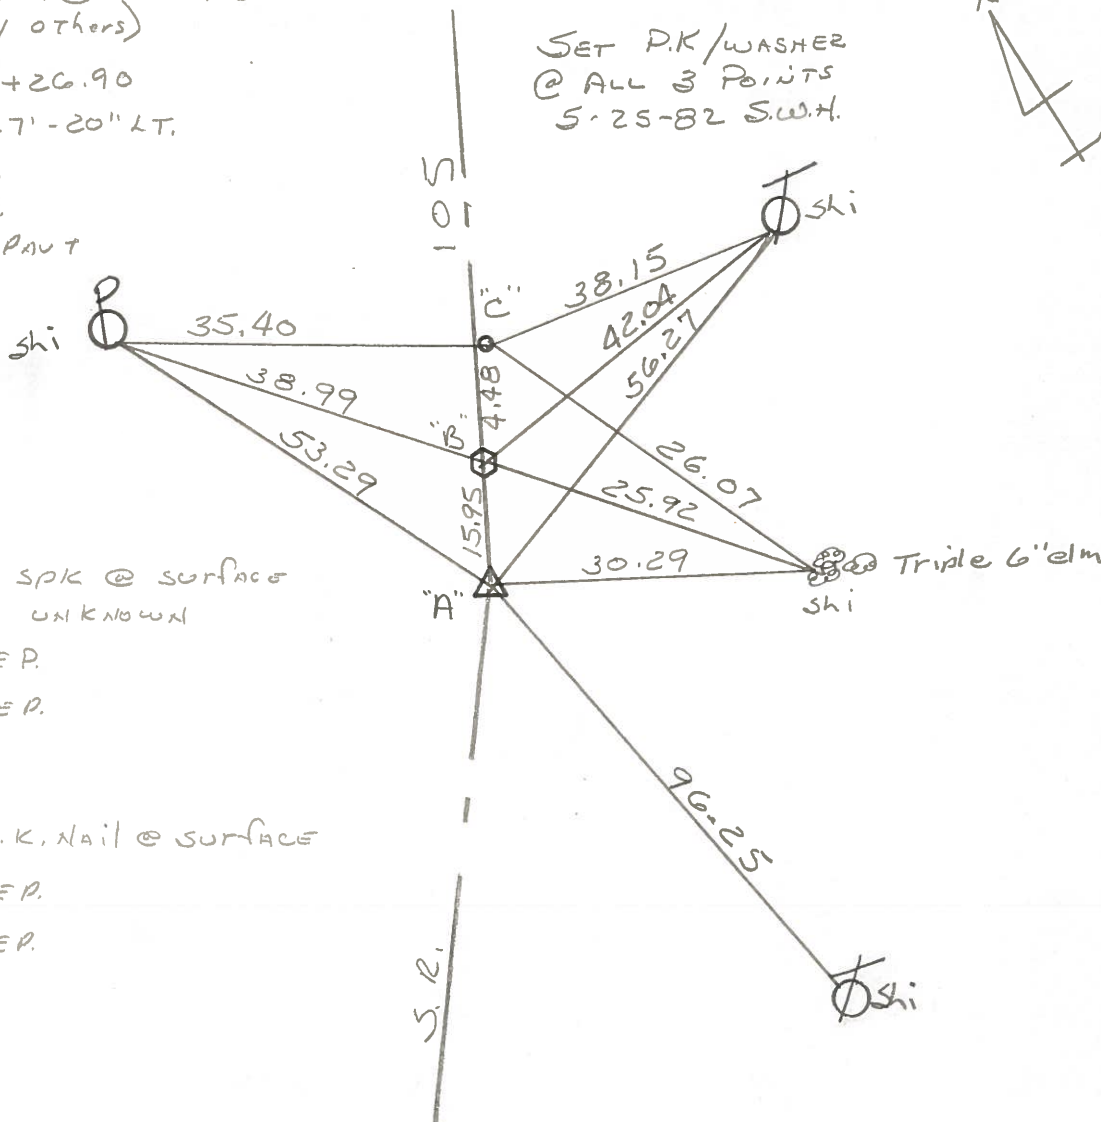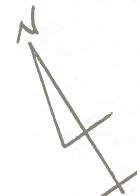

PT. "B" Fd. R.R. SPK @ surface
SOURCE UNKNOWN

9.5 TO W. EP.

10.6 TO E. EP.

PT. "C" Fd P.K. Nail @ surface

9.9 TO W. EP.

10.4 TO E. EP.

A = 19

B = 19A

C = 19B

PERSONNEL	TITLE	PERSONNEL	TITLE	COUNTY	DATE
Stone	Notes			Wood	22 Sept. 72
Michalak	PI			S. R. #105	WEATHER Cool
Denno	H.C.			SEC. 14	TEMP. 65°
Curtis	R.C.				

DESCRIPTION: References to Control Points LEFT CENTER LINE RIGHT JOB NO.

