


O.D.O.T. DISTRICT 2 SURVEY OFFICE (USE ONLY)


PERSONNEL _____ REFERENCE NO. 20 SHEET 12 OF 54
 NOTES RHOADES DATE 9/12/16 ROUTE SR 105
 H.C. O'DONNELL WEATHER SUNNY COUNTY WOOD
 R.C. TODD TEMP. 55° TOWNSHIP WEBSTER
 _____ SECTION 14
 _____ T 5 N R 11 E

TYPE MONUMENT P.K.NAIL
 ON SURFACE - ~~BELOW~~ ON
~~LEFT~~ - C PAV'T - RIGHT 4.5'
5.1' TO RT EDGE PAVEMENT
 S.L.M. 179+51

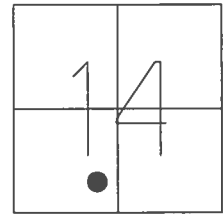

GRID: NORTHING: 628969.895 EASTING: 1676627.702


RECORD: P.I.
 STA. 180+43.57
 $\Delta = 5^{\circ}-53'-20''$ LT
 FD P.K./WASHER
 4/13/02, MB
 SET P.K./WASHER
 6/12/02, DCH
 FD P.K.NAIL
 REF20
 6/6/16, JFO
 SET 1" MAG/WASHER
 10/13/17, JFO

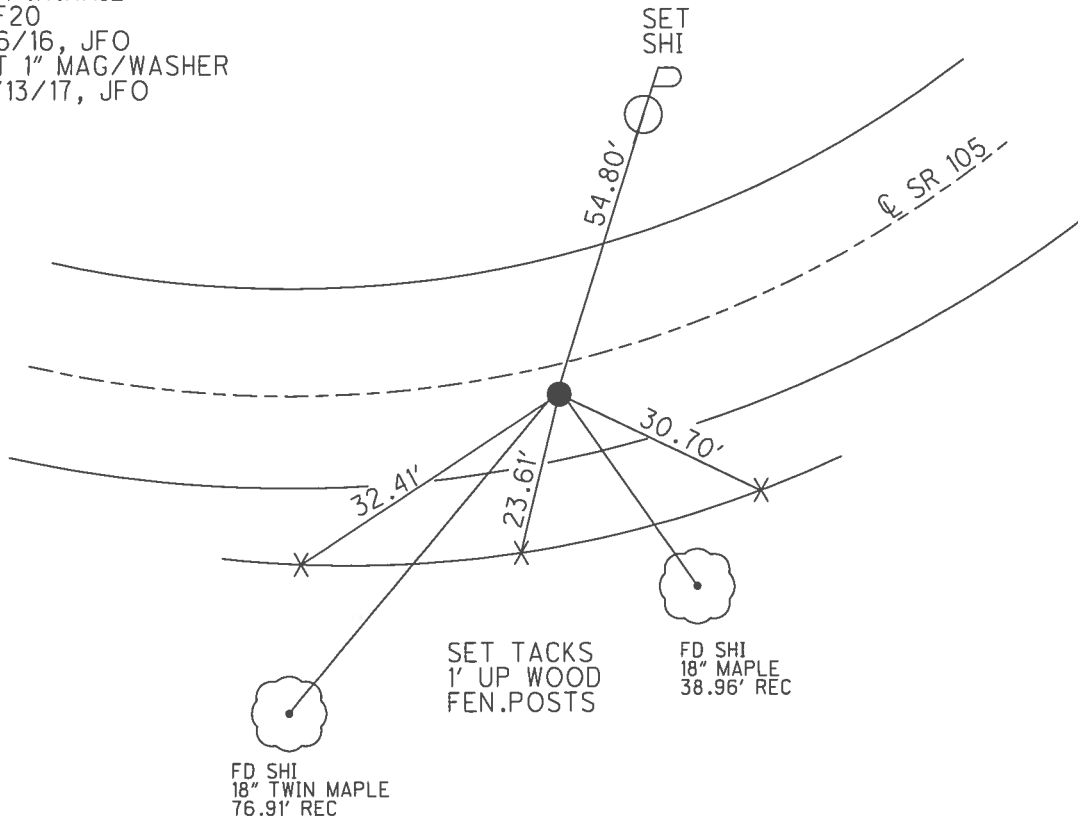

O.D.O.T. DISTRICT 2 SURVEY OFFICE (USE ONLY)


PERSONNEL _____ REFERENCE NO. 20 SHEET 12 OF 54
 NOTES _____ DATE 4/13/02 ROUTE SR 105
 H.C. ROUSOS WEATHER CLOUDY COUNTY WOOD
 R.C. BROWN TEMP. 50° TOWNSHIP WEBSTER
 SECTION 14
 T 5 N R 11 E

TYPE MONUMENT P.K./WASHER
 ON SURFACE - ~~BELOW~~ ON _____
~~LEFT~~ - CL PAV'T - RIGHT 4.5'
5.1' TO RT EDGE PAVEMENT
 S.L.M. 179+51

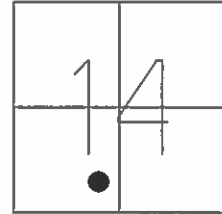

GRID: NORTHING: _____ EASTING: _____

RECORD: P.I.
 STA. 180+43.57
 $\Delta = 5^{\circ}-53'-20''$ LT
 SET P.K./WASHER
 6/12/02, DCH

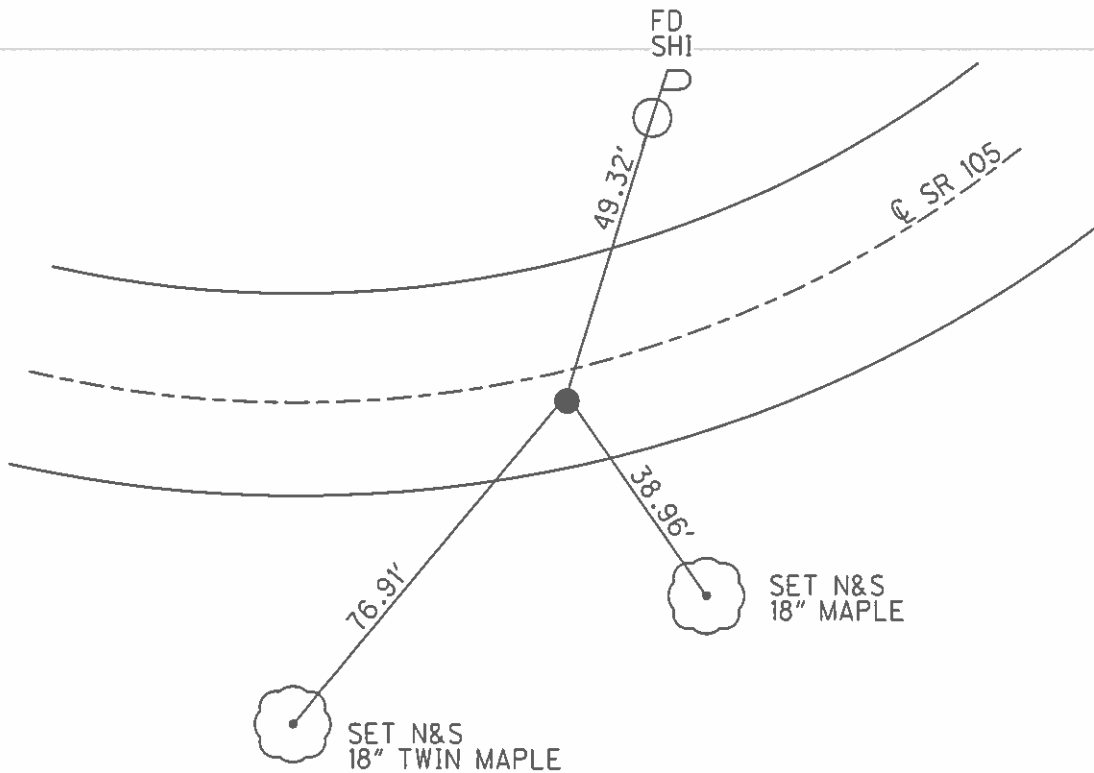

O.D.O.T. DISTRICT 2 SURVEY OFFICE

PERSONNEL

REFERENCE NO. 20

SHEET 25 OF 57

NOTES LONG

H.C. VAN DUSEN

DATE 8-19-91

ROUTE 105

R.C. BARNHISEL

WEATHER CLOUDY

COUNTY WOOD

TEMP. 75°

TOWNSHIP WEBSTER

SECTION 14

T 5 N R 11 E


TYPE MONUMENT P.K. / WASHER

ON SURFACE - BELOW YES

~~LEFT~~ - C PAV'T. - RIGHT 4.5'


5.1' TO RT EDGE PAVEMENT

S.L.M. 179+51

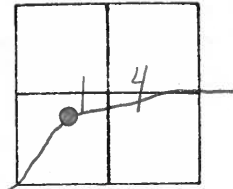

SET PK & WASHER
4-8-92
BVD

RECORD
P.I. #18
180+43.57
 $\Delta = 5^{\circ} 53' - 20''$ LT.

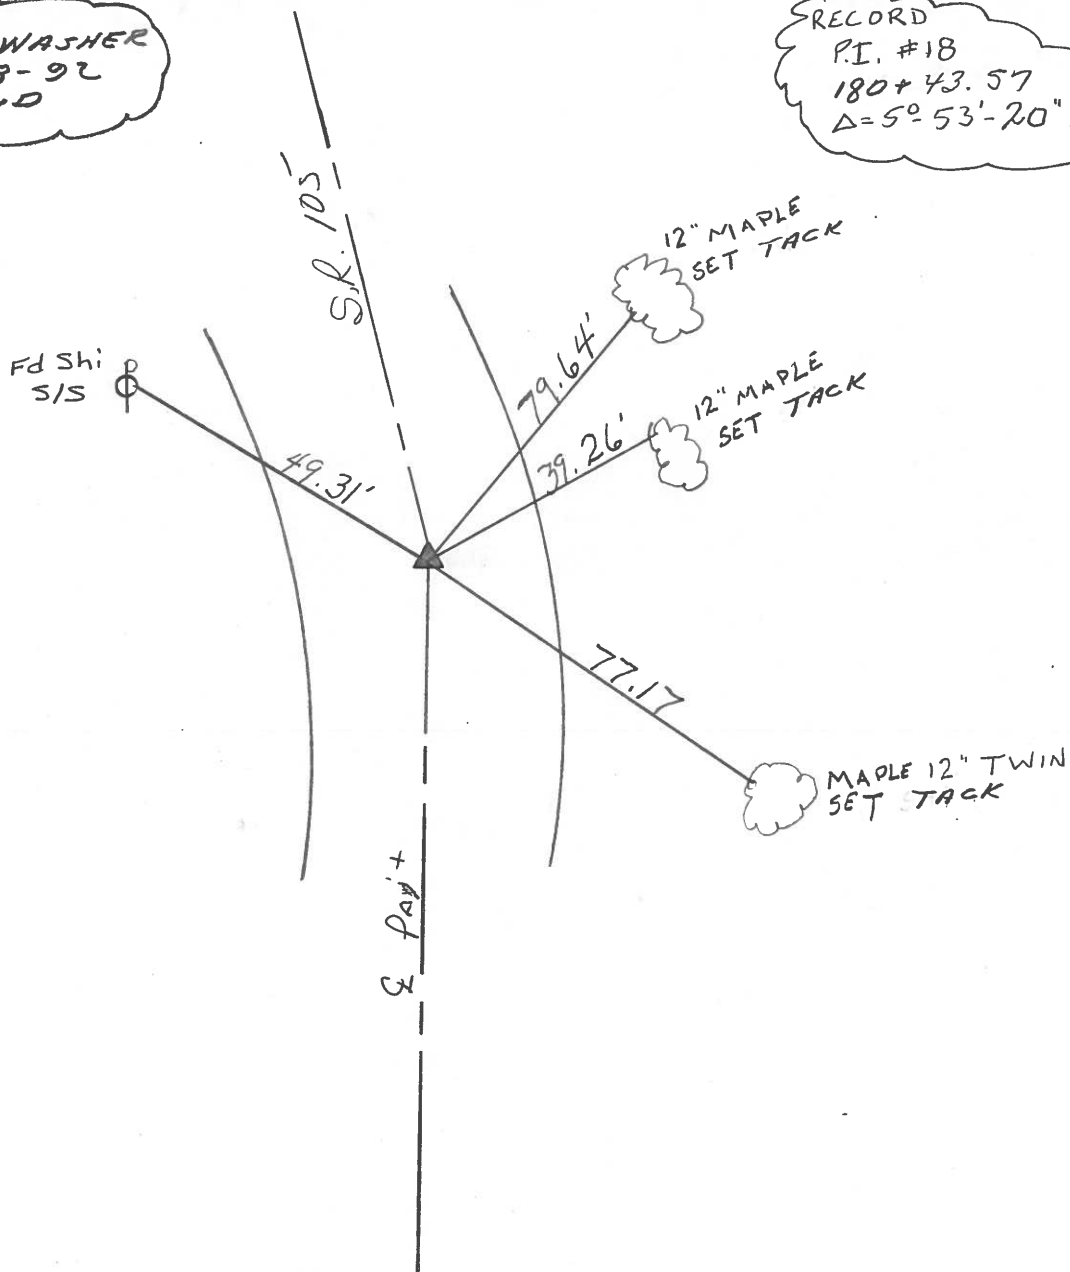

OD.O.T. DISTRICT 2 SURVEY OFFICE

SHEET _____ OF _____

County WOOD S.R. 105

Township WEBSTER

Section 14

T N, R E

Personnel HOFFMAN

HOUSEHOLDER


LOEHRKE

20

Date 4-20-82

Weather CLOUDY

Temp. +50°

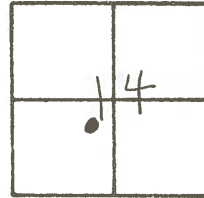


P.I. #18

180+43.57

$\Delta = 5^\circ - 53' - 20''$ LT.

SET P.K./WASHER
5-25-82 S.W.H.

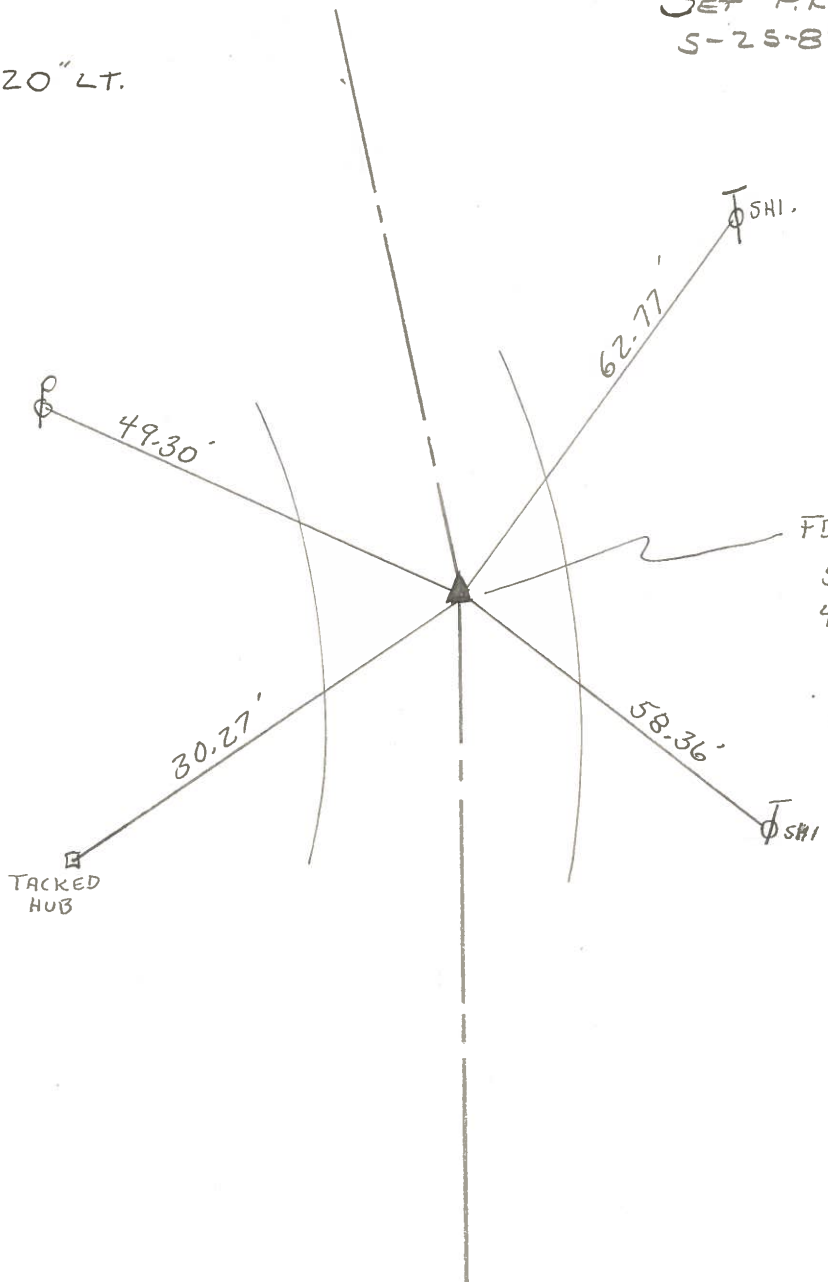

FD. SMALL SPK.
5.1' TO E. EDGE PAUT.
4.5' TO W. EDGE PAUT.
4.7 RT. O.E. ϕ

PERSONNEL	TITLE	PERSONNEL	TITLE	COUNTY	DATE
Stone	Notes			Wood	22 Sept. 72
Michalak	RA			S. R. #105	WEATHER Cool
Denno	H.C.			SEC. 14	TEMP. 85°
Curtis	R.C.				

DESCRIPTION References to Control Points JOB NO. _____
 LEFT CENTER LINE RIGHT

