


O.D.O.T. DISTRICT 2 SURVEY OFFICE (USE ONLY)


PERSONNEL	REFERENCE NO.	21	SHEET	13	OF	54
NOTES	RHOADES	DATE	9/12/16	ROUTE	SR 105	
H.C.	O'DONNELL	WEATHER	SUNNY	COUNTY	WOOD	
R.C.	TODD	TEMP.	55°	TOWNSHIP	WEBSTER	
				SECTION	14	
				T	5	N
				R	11	E

TYPE MONUMENT P.K./WASHER
 ON SURFACE - ~~BELOW~~ ON
 LEFT - ☉ PAV'T - RIGHT ON
11.2' TO RT EDGE PAVEMENT
 S.L.M. 181+95

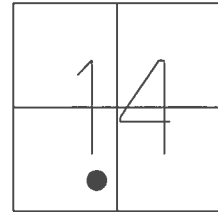

GRID: NORTHING: 629133.005 EASTING: 1676827.346


RECORD:
 ORIGIN UNKNOWN
 FD P.K./WASHER
 4/13/02, MB
 SET P.K./WASHER
 6/12/02, DCH
 FD P.K./WASHER
 REF21
 SET 1" MAG/WASHER
 10/13/17, JFO

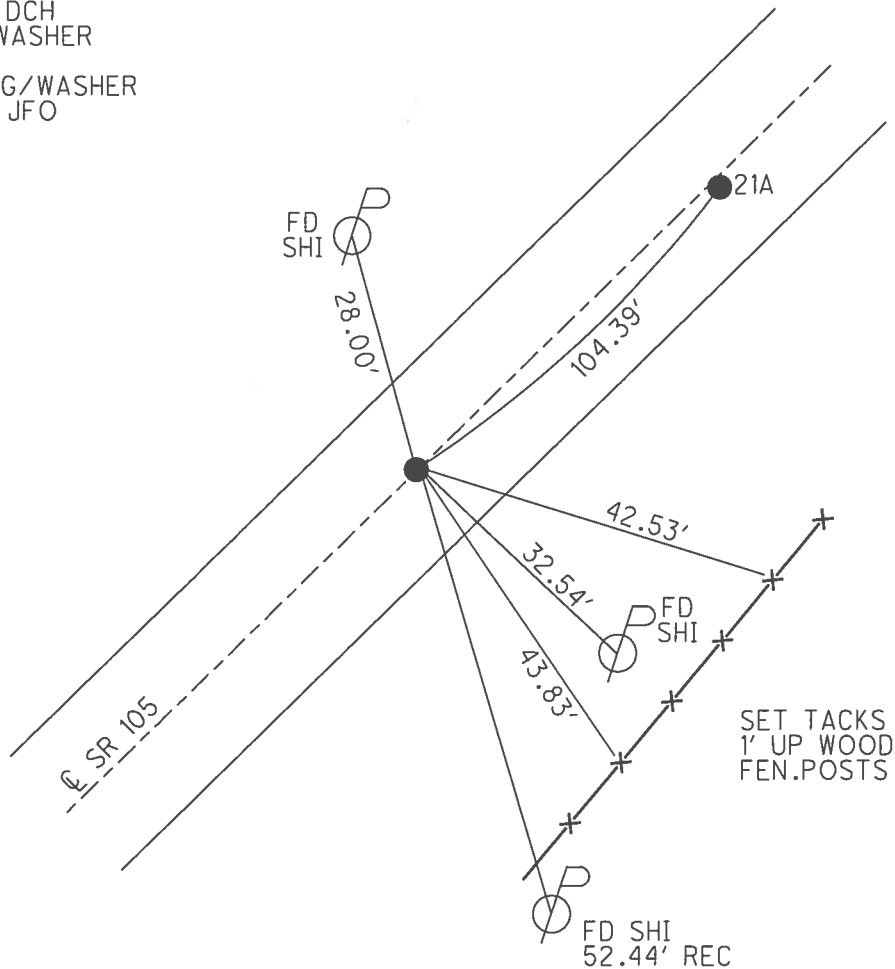

O.D.O.T. DISTRICT 2 SURVEY OFFICE (USE ONLY)


PERSONNEL	REFERENCE NO.	<u>21</u>	SHEET	<u>13</u>	OF	<u>54</u>
NOTES	<u>HOMAN</u>	DATE	<u>4/13/02</u>	ROUTE	<u>SR 105</u>	
H.C.	<u>ROUSOS</u>	WEATHER	<u>CLOUDY</u>	COUNTY	<u>WOOD</u>	
R.C.	<u>BROWN</u>	TEMP.	<u>50°</u>	TOWNSHIP	<u>WEBSTER</u>	
				SECTION	<u>14</u>	
					<u>T 5 N R 11 E</u>	

TYPE MONUMENT P.K./WASHER
 ON SURFACE - ~~BELOW~~ ON
 LEFT - ☉ PAV'T - RIGHT ON
11.2' TO RT EDGE PAVEMENT
 S.L.M. 181+95

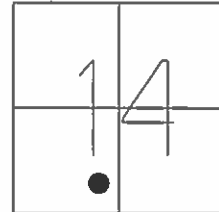

GRID: NORTHING: _____ EASTING: _____

RECORD:
 ORIGIN UNKNOWN
 SET P.K./WASHER
 6/12/02, DCH

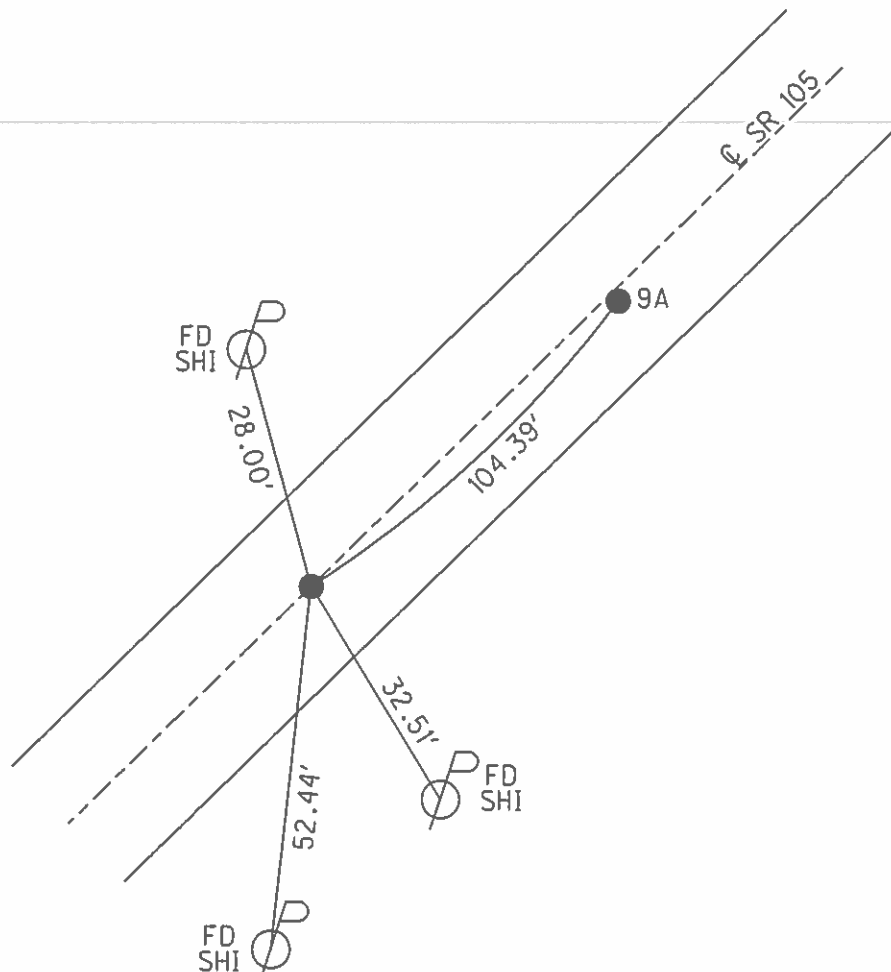

O.D.O.T. DISTRICT 2 SURVEY OFFICE

PERSONNEL

REFERENCE NO. 21

SHEET 26 OF 57

NOTES LONG

H.C. VAN DUSEN

R.C. BARNHISEL

DATE 8-19-91

WEATHER CLOUDY

TEMP. 75°

ROUTE 105

COUNTY WOOD

TOWNSHIP WEBSTER

SECTION 14

T 5 N R 11 E


TYPE MONUMENT P.K. / WASHER "A"

ON SURFACE - ~~BELOW~~ YES

~~LEFT - C~~ PAV'T. - RIGHT .8'

9.9' TO RT. EDGE PAVEMENT

S.L.M. 182+99 ~ PT "A"

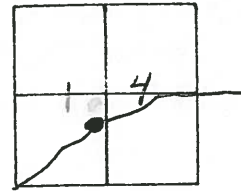

SET PK & WASHER
4-8-92
BVD

RECORD
P.I. #19
183+93.58
 $\Delta = 1^{\circ} - 24' - 20''$ LT.

A = 21A
B = 21

Fd
SHI
S/S

93.01'

105

92.89'

34.28'

39.99'

37.61'

28.61'

SET TACK
FENCE POST

SET TACK
FENCE POST

SHI. Removed By
4-8-92

104.39

SR.

181+94
PT "B"
0.7 LT &
11.2 TO RT Edge
Record: ORIGINAL UNKNOWN

SHI.

28.03'

"B"

32.51'

52.48'

SHI.



County WOOD S.R. 105

Date 4-20-82

Township WEBSTER

Weather CLOUDY

Section 14

Temp. +50°


T N, R E

Personnel HOFFMAN

HOUSEHOLDER

LOEHRKE

21

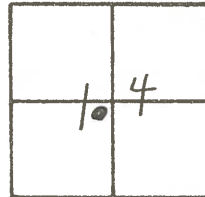

P.I. #19


183+93.58

$\Delta = 1^{\circ} 24' 20''$ LT.

A = 21A

B = 21

SET P.K.^s/WASHERS
@ BOTH POINTS
5.25-82 S.W.H.

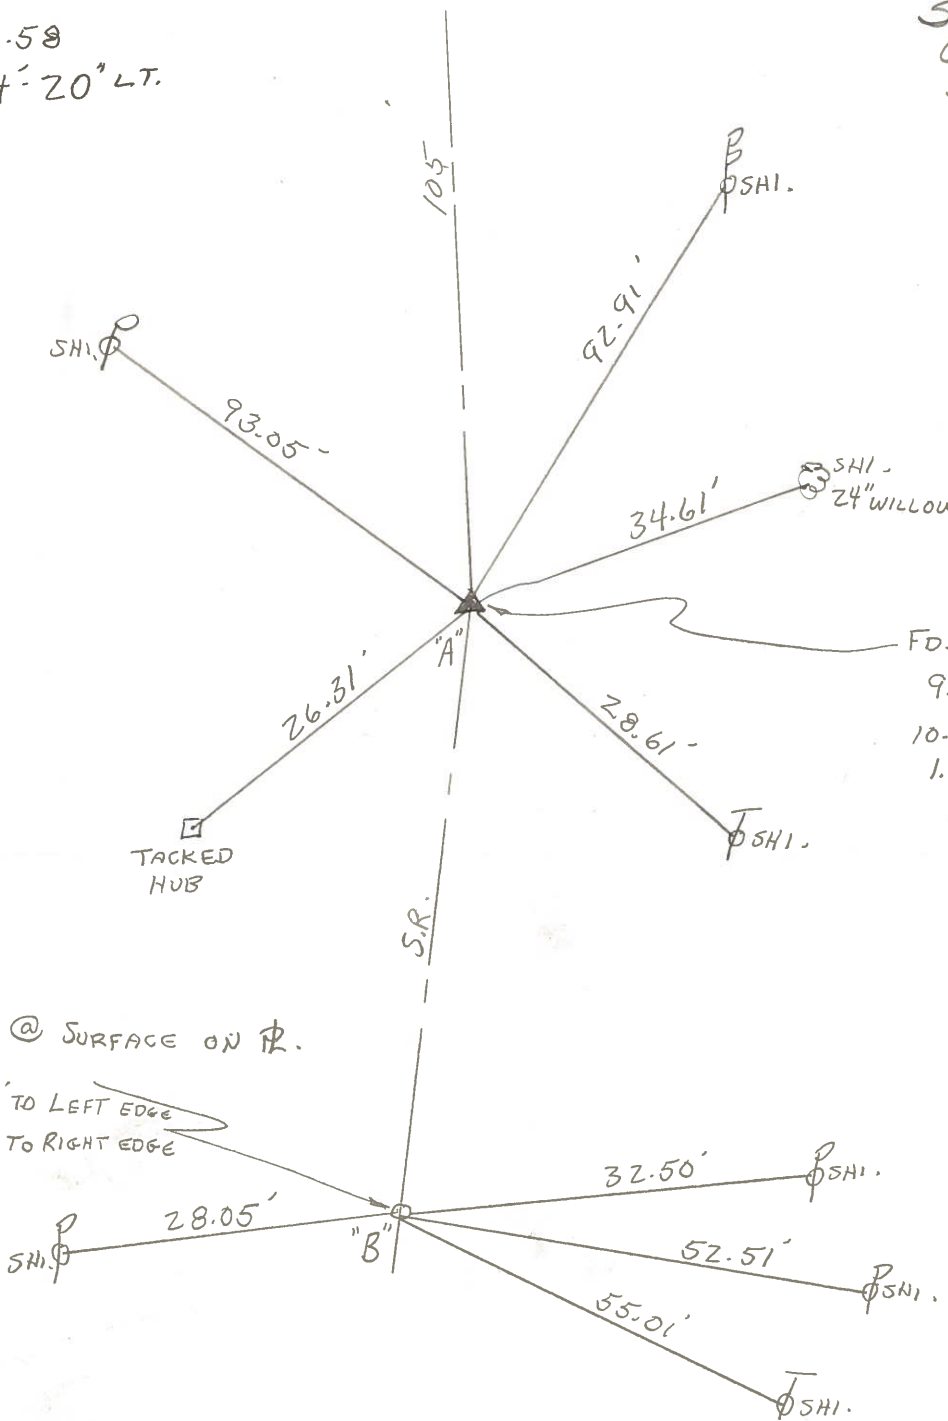

FD. BENT R.R. SPK.
9.1' - TO E. EDGE PAUT.
10.3' - TO W. EDGE PAUT.
1.0' RT. OF Φ PAUT.

FD. R.R. SPK. @ SURFACE ON Φ .
SOURCE UNKNOWN
9.8' TO LEFT EDGE
10.4' TO RIGHT EDGE

PERSONNEL	TITLE	PERSONNEL	TITLE	COUNTY	DATE
Stone	Notes			Wood	22 Sept. 72
Michalak	R			S. R. #105	WEATHER Cool
Denno	H.C.			SEC. 14	TEMP. 65°
Curtis	R.C.				

DESCRIPTION References to Control Points JOB NO. _____
 LEFT CENTER LINE RIGHT

