


O.D.O.T. DISTRICT 2 SURVEY OFFICE (USE ONLY)


PERSONNEL _____ REFERENCE NO. 21 A SHEET 14 OF 54
 NOTES RHOADES DATE 9/12/16 ROUTE SR 105
 H.C. O'DONNELL WEATHER SUNNY COUNTY WOOD
 R.C. TODD TEMP. 55° TOWNSHIP WEBSTER
 _____ SECTION 14
 _____ T 5 N R 11 E

TYPE MONUMENT P.K./WASHER
 ON SURFACE - ~~BELOW~~ ON _____
 LEFT - ☉ PAV'T - RIGHT 0.8'
9.9' TO RT EDGE PAVEMENT
 S.L.M. 182+99

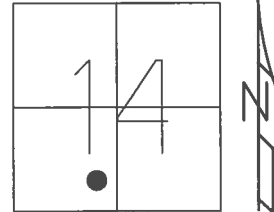

GRID: NORTHING: 629173.808 EASTING: 1676912.170


RECORD: P.I.
 STA. 183+93.58
 $\Delta = 1^{\circ}-24'-20''$ LT.
 FD P.K./WASHER
 4/13/02, DCH
 SET P.K./WASHER
 6/12/02, DCH
 FD P.K./WASHER
 REFA21
 6/6/16, JFO
 SET 1" MAG/WASHER
 10/13/17, JFO

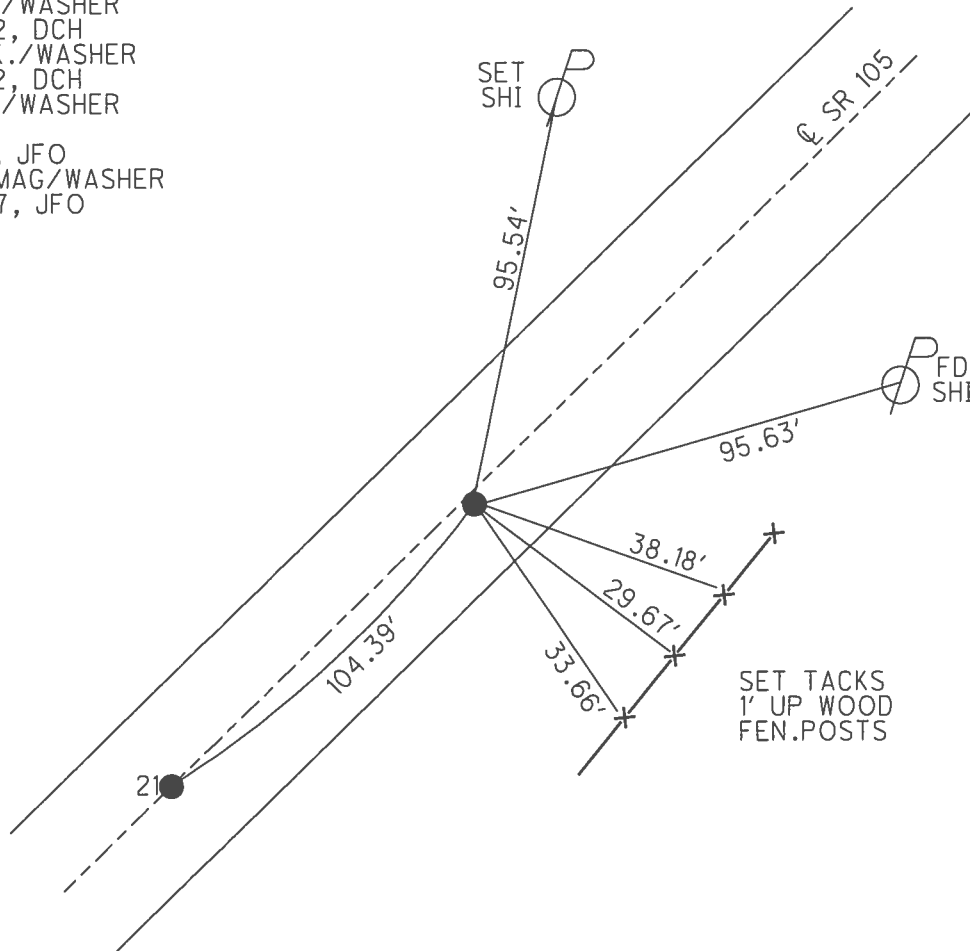

O.D.O.T. DISTRICT 2 SURVEY OFFICE (USE ONLY)


PERSONNEL _____ REFERENCE NO. 21 A SHEET 14 OF 54
 NOTES HOMAN DATE 4/13/02 ROUTE SR 105
 H.C. ROUSOS WEATHER CLOUDY COUNTY WOOD
 R.C. BROWN TEMP. 50° TOWNSHIP WEBSTER
 _____ SECTION 14
 _____ T 5 N R 11 E

TYPE MONUMENT P.K./WASHER
 ON SURFACE - ~~BELOW~~ ON
 LEFT - ☉ PAV'T - RIGHT 0.8'
9.9' TO RT. EDGE PAVEMENT
 S.L.M. 182+99

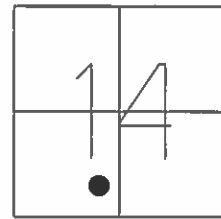

GRID: NORTHING: _____ EASTING: _____

RECORD: P.I.
 STA. 183+93.58
 $\Delta = 1^{\circ}-24'-20''$ LT.
 SET P.K./WASHER
 6/12/02, DCH

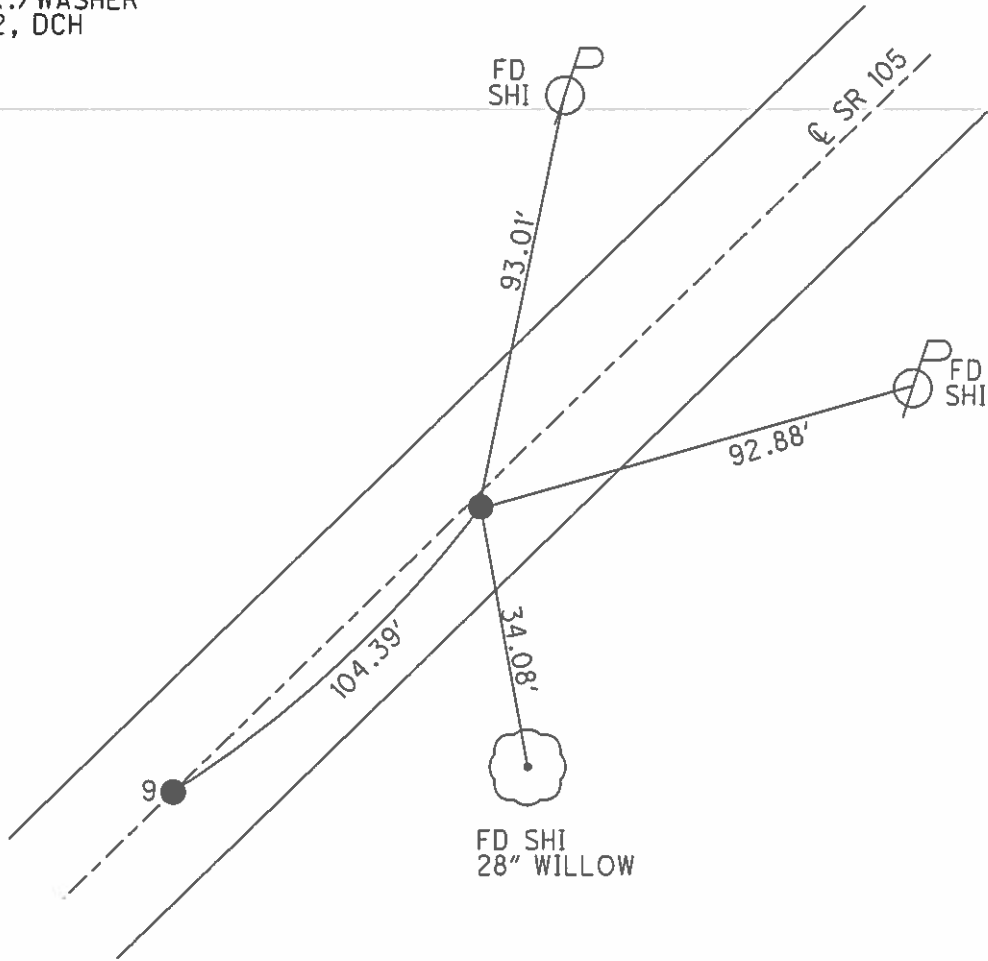

O.D.O.T. DISTRICT 2 SURVEY OFFICE

PERSONNEL

REFERENCE NO. 21

SHEET 26 OF 57

NOTES LONG

H.C. VAN DUSEN

DATE 8-19-91

ROUTE 105

R.C. BARNHISEL

WEATHER CLOUDY

COUNTY WOOD



TEMP. 75°

TOWNSHIP WEBSTER

SECTION 14

T 5 N R 11 E

TYPE MONUMENT P.K. / WASHER "A"
 ON SURFACE - ~~BELOW~~ YES
~~LEFT - C~~ PAV'T. - RIGHT - 8'
9.9' TO RT EDGE PAVEMENT
 S.L.M. 182+99 ~ PT "A"

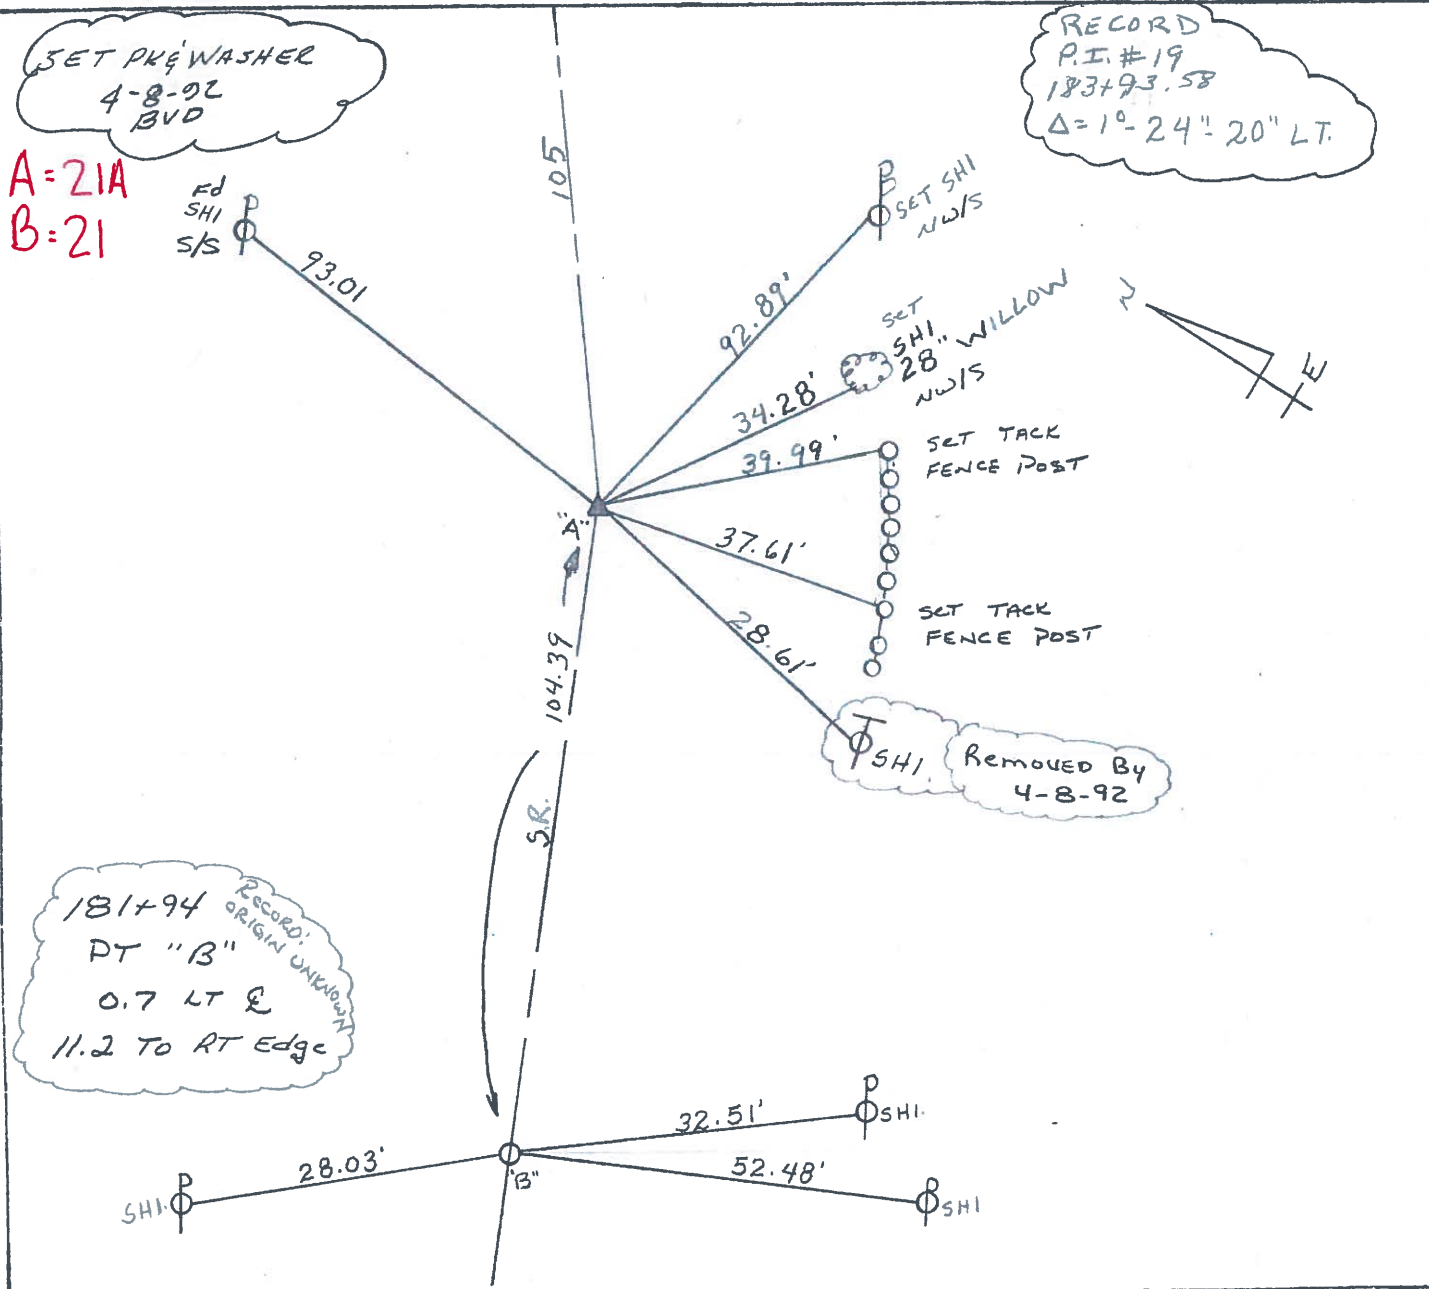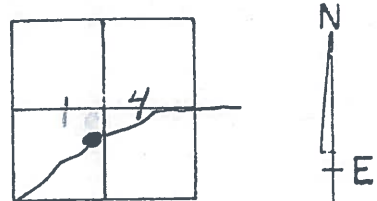

County WOOD S.R. 105

Date 4-20-82

Township WEBSTER

Weather CLOUDY

Section 14

Temp. +50°


T, N, R, E

Personnel HOFFMAN

HOUSE HOLDER

LOEHRKE

21

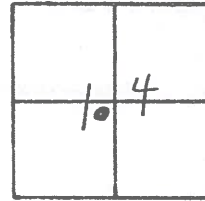

P.I. #19


183+93.58

$\Delta = 1^{\circ} 24' 20''$ LT.

A = 21A

B = 21

SET P.K.^s/WASHERS
@ BOTH POINTS
S. 25-82 SW.H.

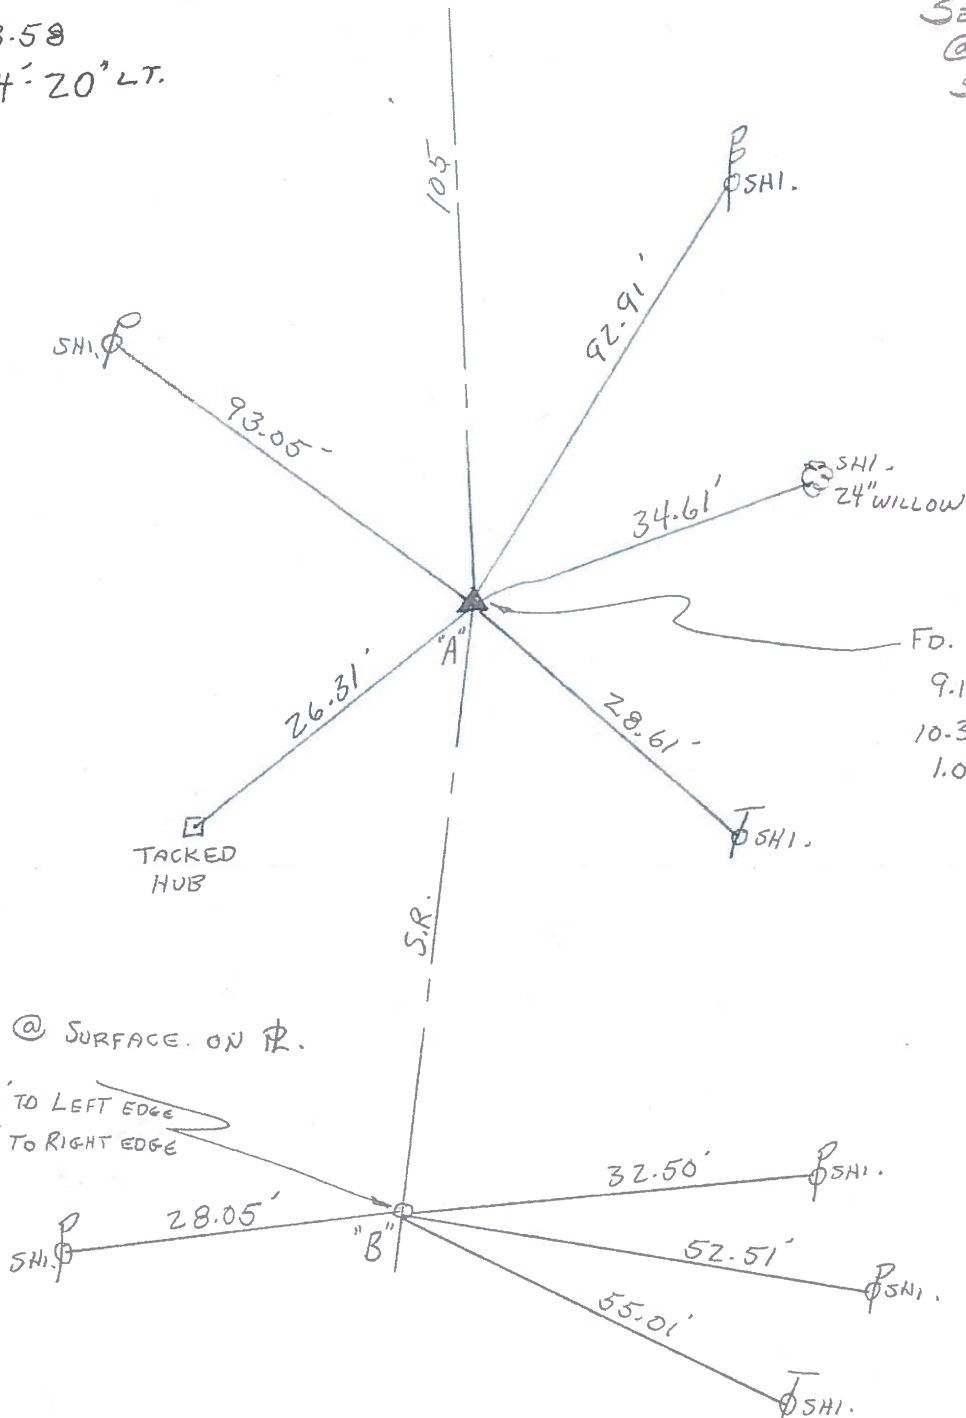

FD. BENT R.R. SPK.
9.1' - TO E. EDGE PAUT.
10.3' - TO W. EDGE PAUT.
1.0' RT. OF Φ PAUT.

FD. R.R. SPK. @ SURFACE. ON Φ .
SOURCE UNKNOWN
9.8' TO LEFT EDGE
10.4' TO RIGHT EDGE