


O.D.O.T. DISTRICT 2 SURVEY OFFICE (USE ONLY)


PERSONNEL _____ REFERENCE NO. 23 SHEET 16 OF 54
 NOTES RHOADES DATE 9/12/16 ROUTE SR 105
 H.C. O'DONNELL WEATHER SUNNY COUNTY WOOD
 R.C. TODD TEMP. 76° TOWNSHIP WEBSTER
 SECTION 14
T 5 N R 11 E

TYPE MONUMENT P.K./WASHER
 ON SURFACE - ~~BELOW~~ ON _____
 LEFT - ☉ PAV'T - ~~RIGHT~~ 1'
10' TO RT EDGE PAVEMENT
 S.L.M. 188+64

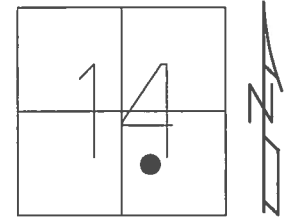

GRID: NORTHING: 629523.169 EASTING: 1677357.038


RECORD: P.I.
 STA. 189+59.36
 $\Delta = 0^{\circ}-36'-40''$ LT
 FD P.K./WASHER
 4/13/02, DCH
 SET P.K./WASHER
 5/28/02, DCH
 FD P.K./WASHER
 REF23
 6/6/16, JFO
 SET 1" MAG/WASHER
 10/13/17, JFO

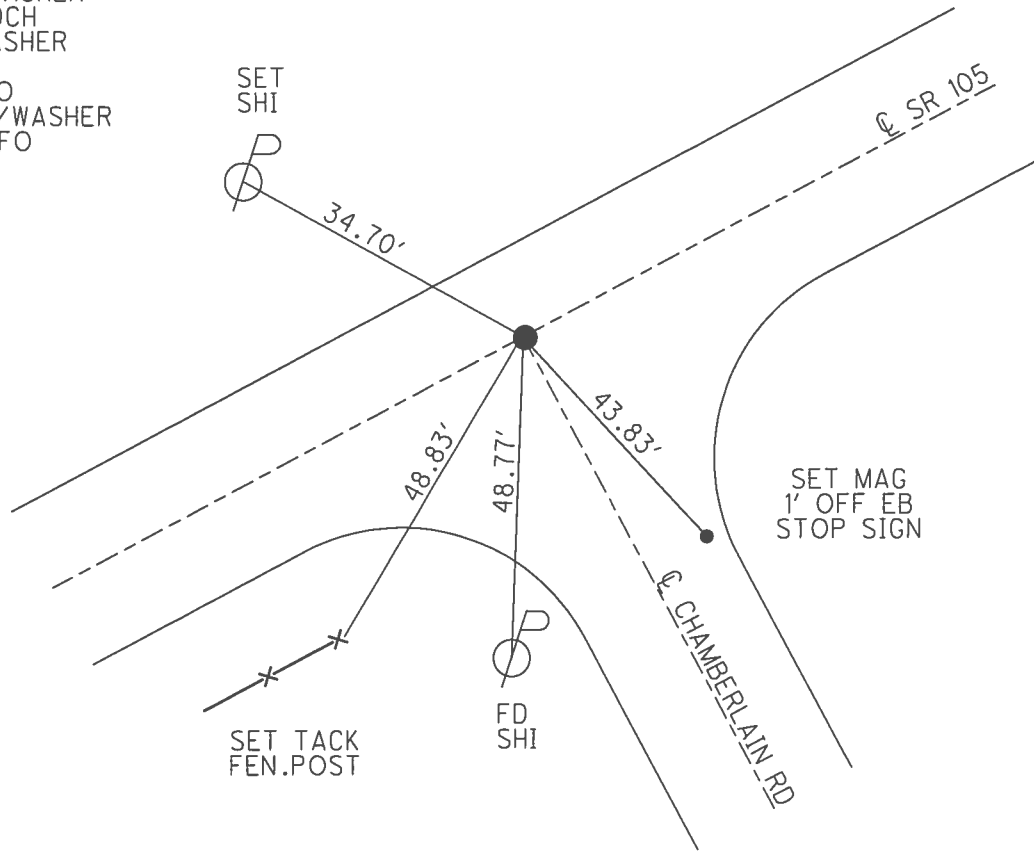

O.D.O.T. DISTRICT 2 SURVEY OFFICE (USE ONLY)


PERSONNEL _____ REFERENCE NO. 23 SHEET 16 OF 54
 NOTES HOMAN DATE 4/13/02 ROUTE SR 105
 H.C. ROUSOS WEATHER CLOUDY COUNTY WOOD
 R.C. BROWN TEMP. 50° TOWNSHIP WEBSTER
 SECTION 14
T 5 N R 11 E

TYPE MONUMENT P.K./WASHER
 ON SURFACE - ~~BELOW~~ ON
 LEFT - ☉ PAV'T - RIGHT ON
10' TO RT EDGE PAVEMENT
 S.L.M. 188+64

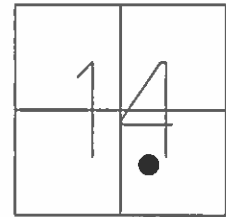

GRID: NORTHING: _____ EASTING: _____

RECORD: P.I.
 STA. 189+59.36
 $\Delta = 0^\circ-36'-40''$ LT
 SET P.K./WASHER
 5/28/02, DCH

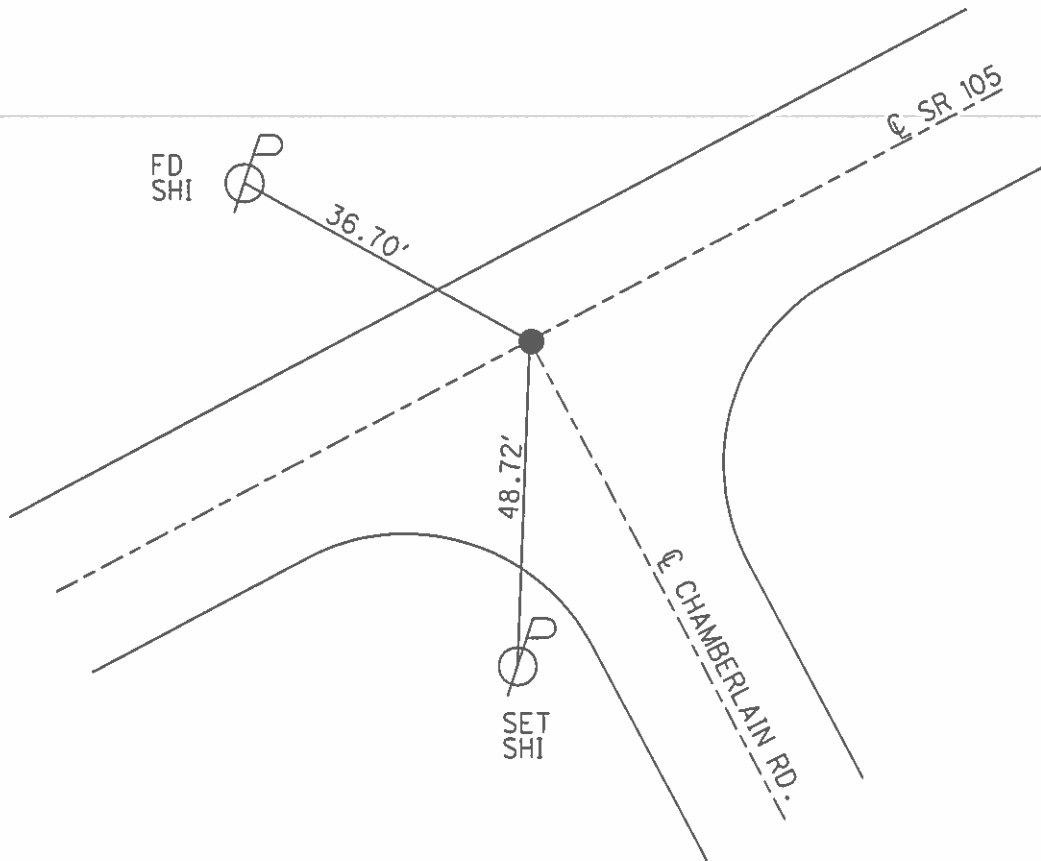

O.D.O.T. DISTRICT 2 SURVEY OFFICE

PERSONNEL

REFERENCE NO. 23

SHEET 28 OF 57

NOTES LONG

H.C. VAN DUSEN

R.C. BARNHISEL

DATE 8-20-91

WEATHER RAINY

TEMP. 65°

ROUTE 105

COUNTY WOOD

TOWNSHIP WEBSTER

SECTION 14

T5 N R 11 E


TYPE MONUMENT P.K. / WASHER

ON SURFACE - BELOW YES

~~LEFT~~ & PAV'T. - RIGHT 0.2'



9.6' TO LT EDGE PAVEMENT

S.L.M. 188+64

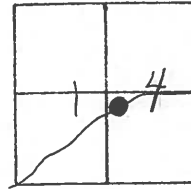

SET PK & WASHER
4-8-92
BYD

RECORD
P.I. # 21
189+59.36
Δ = 0°-36'-40" LT.

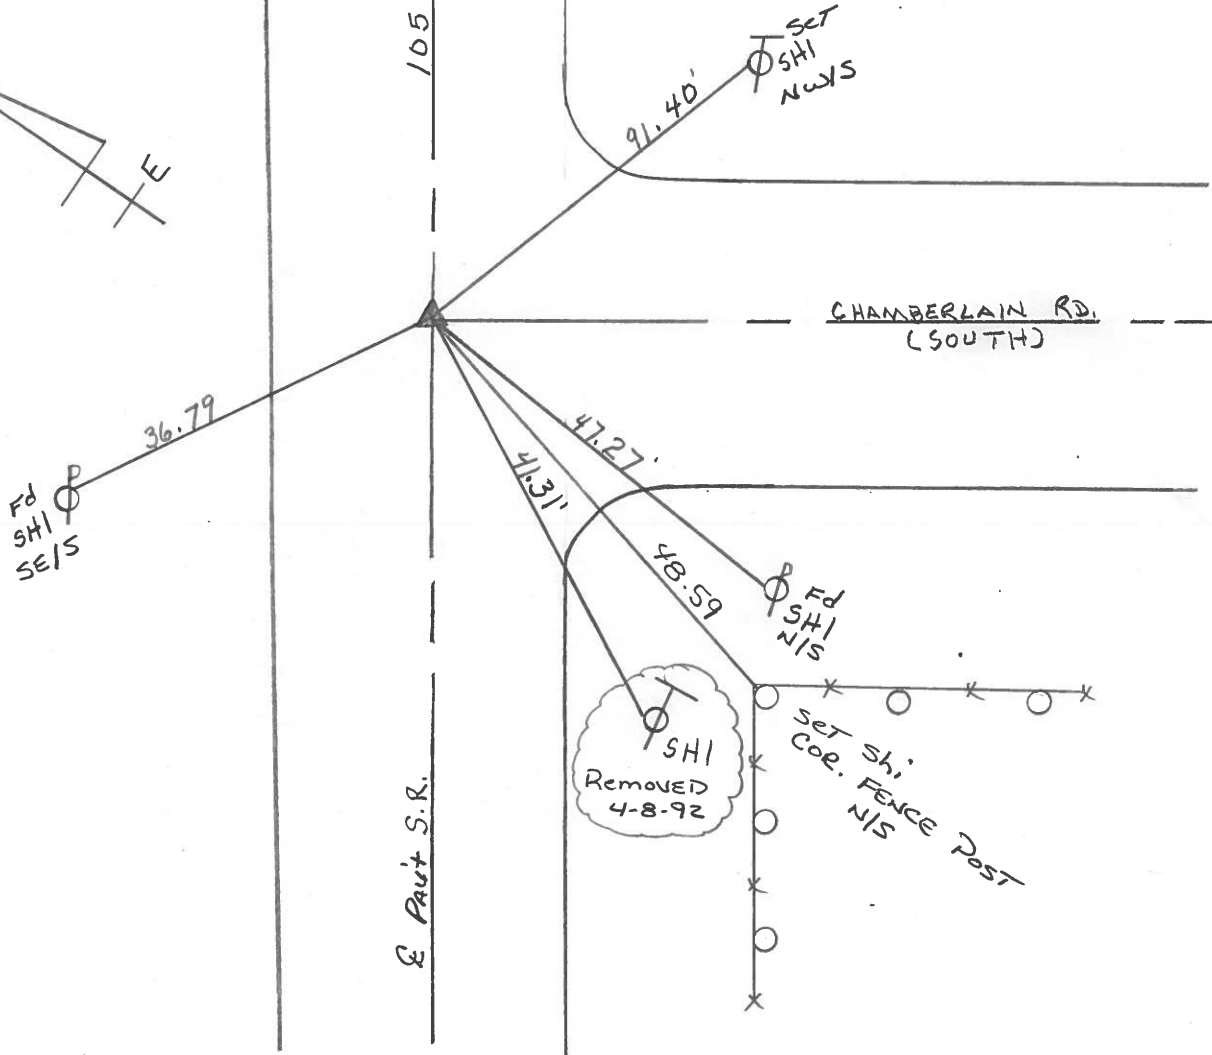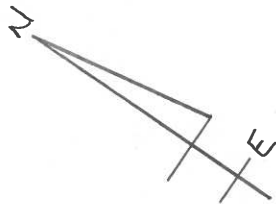

County WOOD S.R. 105

Date 4-20-82

Township WEBSTER

Weather CLOUDY

Section 14

Temp. +50°


T N, R E

Personnel HOFFMAN

HOUSEHOLDER

LOEHRKE

23

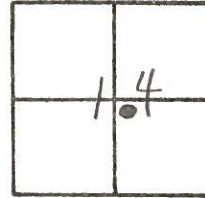


P.I. # 21

189+59.36

$\Delta = 0^{\circ}-36'-40''$ LT.

SET P.K./WASHER
5-24-82 S.W.H.

FD. R.R. SPK. @ SURFACE
10.2' TO NORTH EDGE
0.2' LT. OF ϕ PAUT.

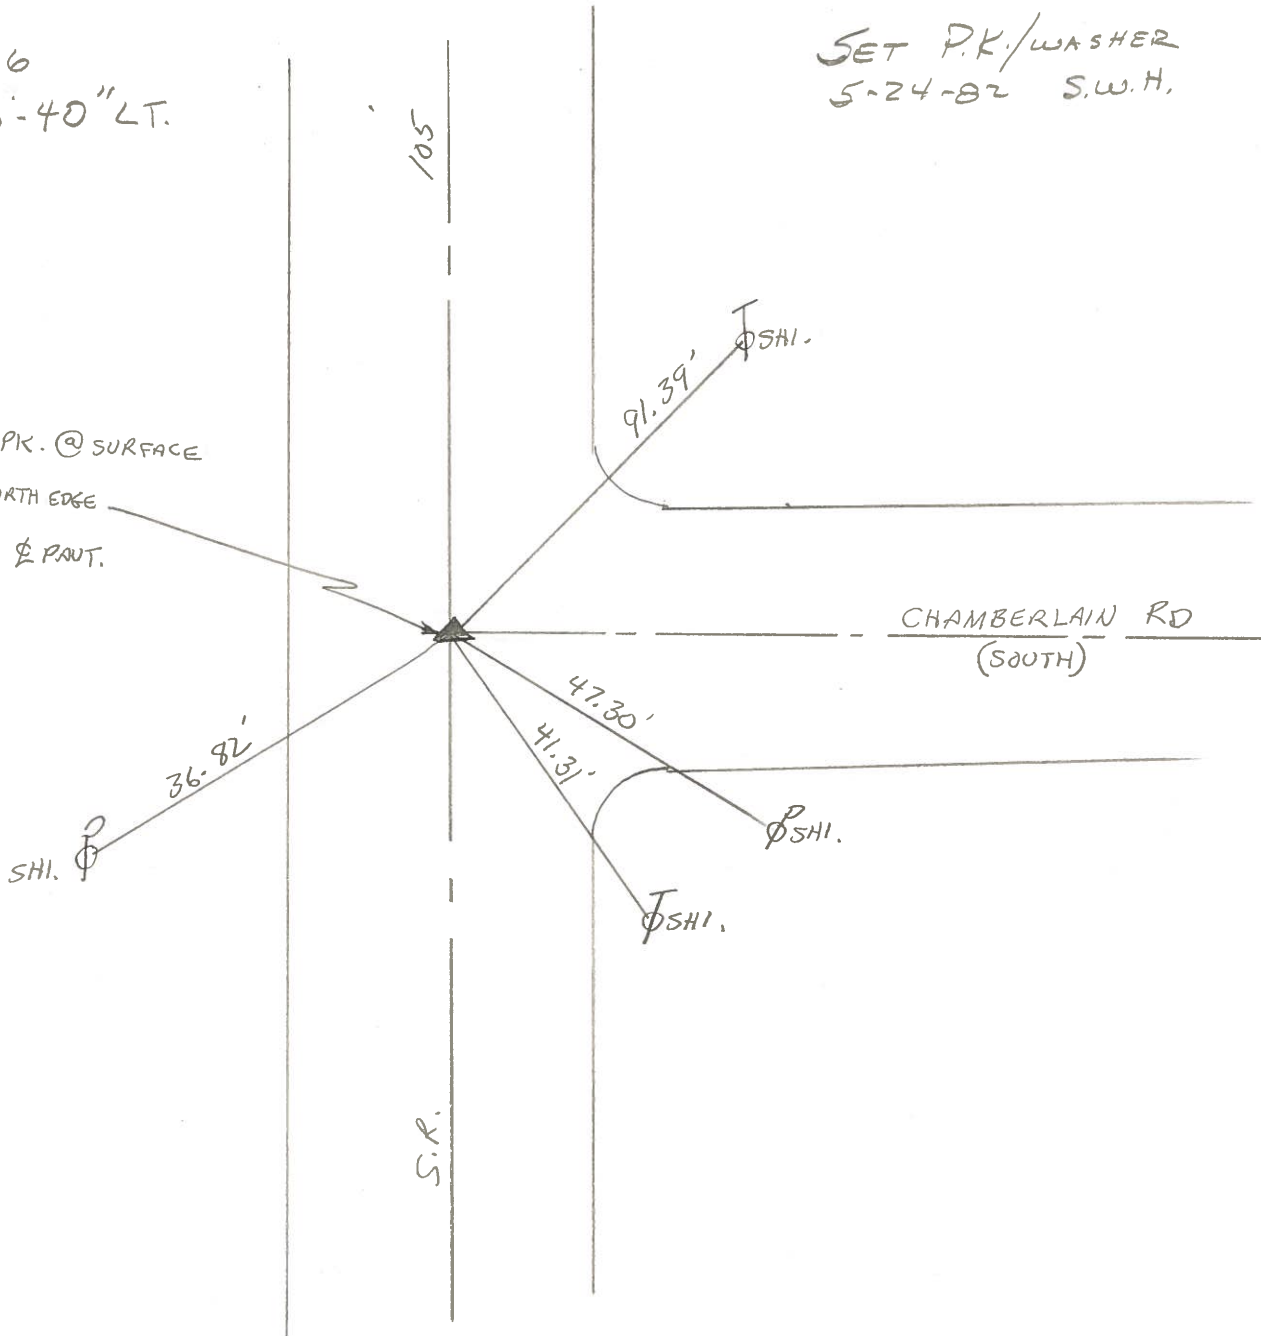

PERSONNEL	TITLE	PERSONNEL	TITLE	COUNTY	DATE
Stone				Wood	14 May 73
Michalak				S. R. #105	WEATHER Cool
Danna				SEC. 14- Webster Twp.	TEMP. 50°
Curtis					

DESCRIPTION References to Control Points JOB NO. _____

LEFT CENTER LINE RIGHT

