


O.D.O.T. DISTRICT 2 SURVEY OFFICE (USE ONLY)


PERSONNEL _____ REFERENCE NO. 27 SHEET 25 OF 54
 NOTES RHOADES DATE 9/12/16 ROUTE SR 105
 H.C. O'DONNELL WEATHER SUNNY COUNTY WOOD
 R.C. TODD TEMP. 75° TOWNSHIP WEBSTER
 SECTION 13
T 5 N R 11 E

TYPE MONUMENT P.K./WASHER
 ON SURFACE - ~~BELOW~~ ON
~~LEFT~~ - C PAV'T - RIGHT 5.5'
5' TO S EDGE PAVEMENT
 S.L.M. 222+59

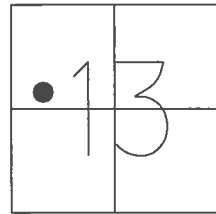

GRID: NORTHING: 630642.415 EASTING: 1680369.826


RECORD: P.I.
 STA. 223+69.18
 $\Delta = 7^\circ - 11' \text{ LT}$
 FD P.K./WASHER
 4/16/02, DCH
 SET P.K./WASHER
 6/13/02, DCH
 SET MAG/WASHER
 REF27
 6/9/16, JFO
 SET 1" MAG/WASHER
 10/13/17, JFO

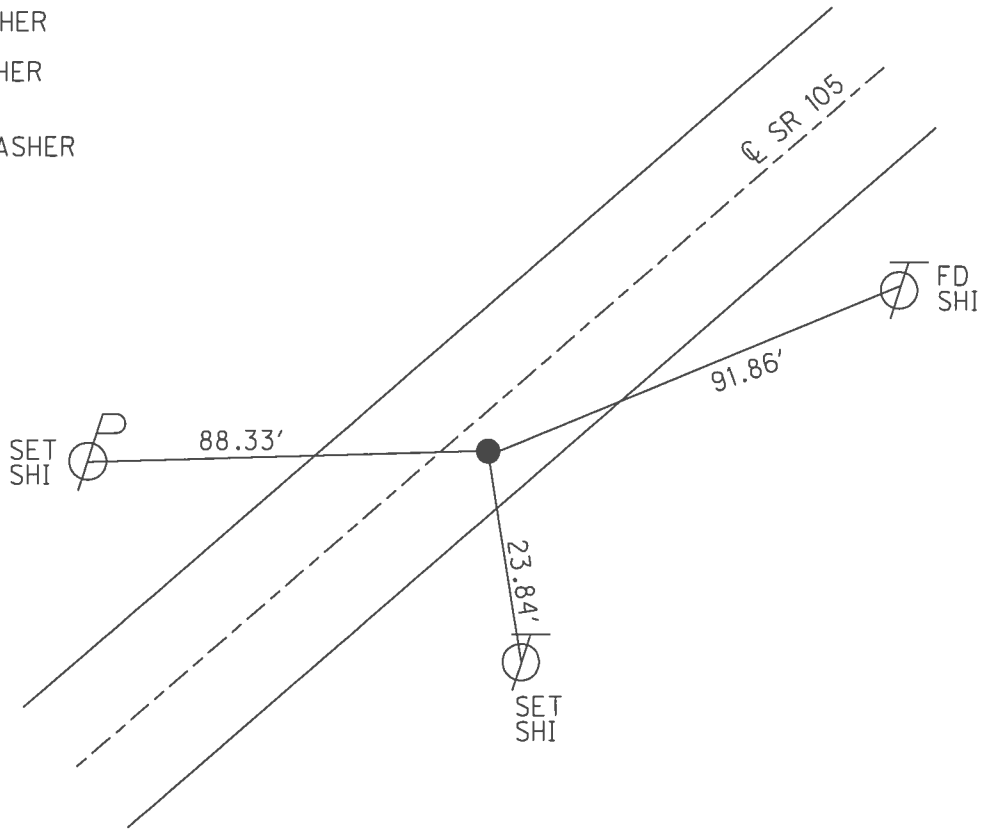

O.D.O.T. DISTRICT 2 SURVEY OFFICE (USE ONLY)


PERSONNEL _____ REFERENCE NO. 27 SHEET 25 OF 54
 NOTES ROUSOS DATE 4/16/02 ROUTE SR 105
 H.C. HOMAN WEATHER CLEAR COUNTY WOOD
 R.C. ROUSOS TEMP. 65° TOWNSHIP WEBSTER
 SECTION 13
 T 5 N R 11 E

TYPE MONUMENT P.K./WASHER
 ON SURFACE - ~~BELOW~~ ON
~~LEFT~~ - Q PAV'T - RIGHT 5.5'
5' TO S EDGE PAVEMENT
 S.L.M. 222+59

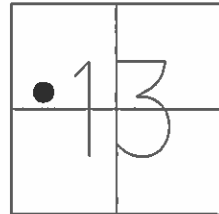

GRID: NORTHING: _____ EASTING: _____

RECORD: P.I.
 STA. 223+69.18
 $\Delta = 7^{\circ}-11'$ LT
 SET P.K./WASHER
 6/13/02, DCH

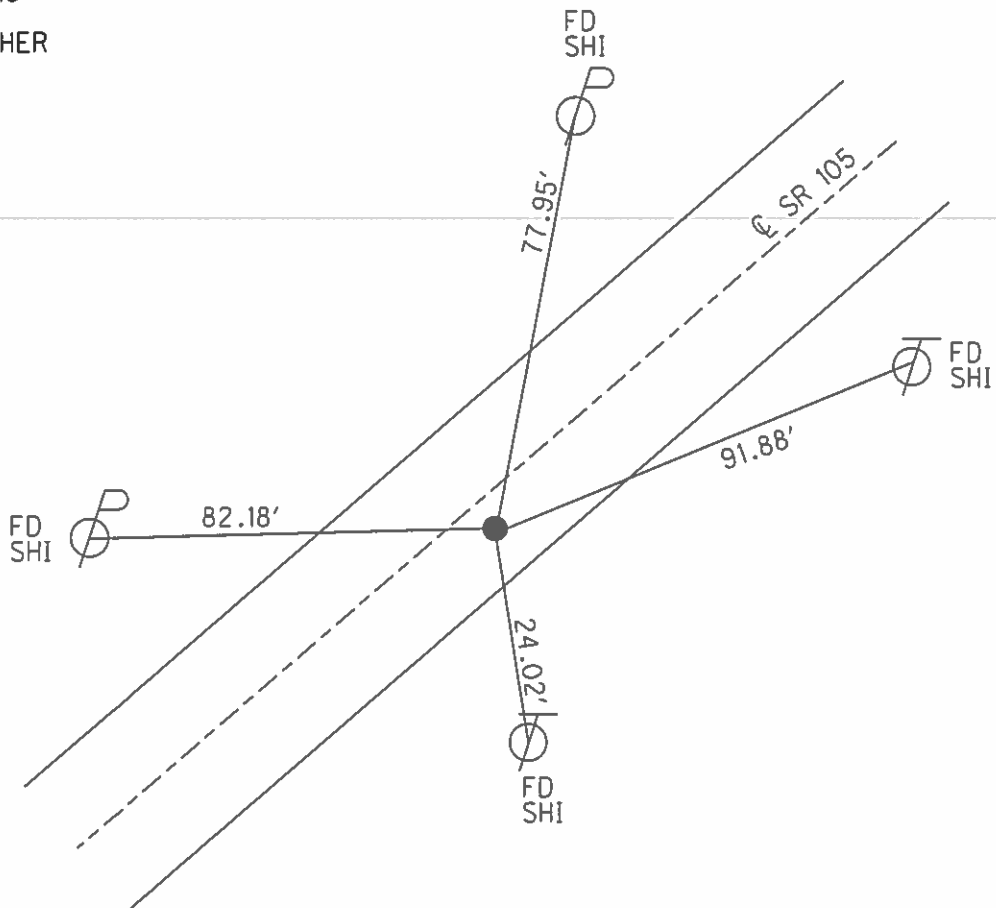

O.D.O.T. DISTRICT 2 SURVEY OFFICE

PERSONNEL

REFERENCE NO. 27

SHEET 37 OF 57

NOTES LONG

H.C. VANDUSEN

R.C. BARNHISEL

DATE 8-26-91

WEATHER SUNNY

TEMP. 85°

ROUTE 105

COUNTY WOOD

TOWNSHIP WEBSTER

SECTION 13

T 5 N R 11 E


TYPE MONUMENT P.K. / WASHER

ON SURFACE - BELOW YES

~~LEFT~~ - C PAV'T. - RIGHT 5.5'



5.0' TO S EDGE PAVEMENT

S.L.M. 222+59

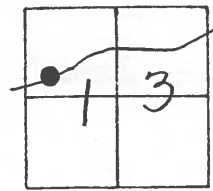

SET PK & WASHER
 4-9-92
 BVD

RECORDS
 P.I. #25
 223+69.18
 $\Delta = 7^{\circ} - 11' \text{ LT.}$

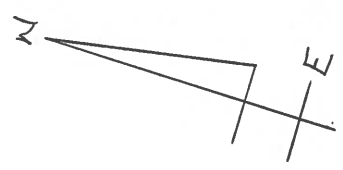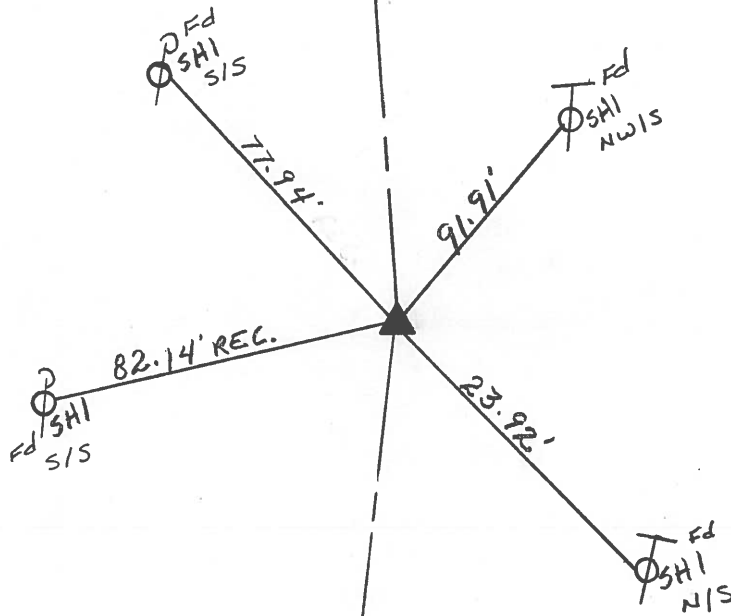

County WOOD S.R. 105

Date 4-21-82

Township WEBSTER


Weather CLOUDY

Section 13

Temp. +35°

T N, R E

Personnel HOFFMAN

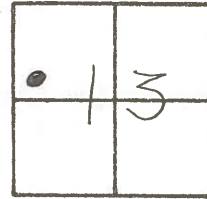

27


HOUSE HOLDER
LOEHRKE

P.I. # 25

223+69.18

Δ = 7°-11' LT.

SET P.K./WASHER
5-26-82 S.W.H.

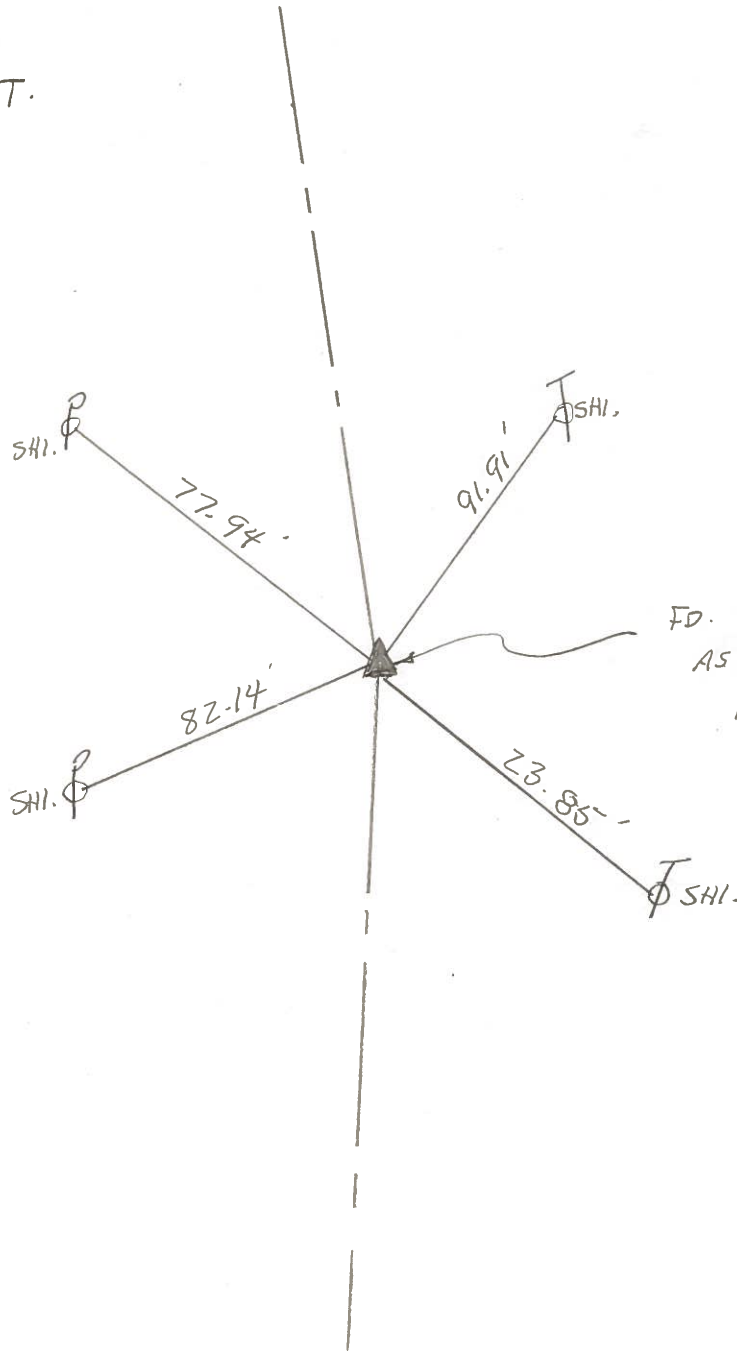

FD. BOAT SPK. 1" BELOW SURFACE
AS PER 1949 PLAN

- 14.4' - To N. EDGE PAUT.
- 4.8' - To S. EDGE PAUT.
- 4.8' - RT. OF ⚡

PERSONNEL	TITLE	PERSONNEL	TITLE
Stone			
Michalek			
Denno			
Curtis			

COUNTY Wood DATE 15 May 73
 S. R. #105 WEATHER Cool
 SEC. 13- Webster Twp TEMP. 55°

DESCRIPTION References to Central Points JOB NO. _____
 LEFT CENTER LINE RIGHT

