


O.D.O.T. DISTRICT 2 SURVEY OFFICE (USE ONLY)


PERSONNEL _____ REFERENCE NO. 28 SHEET 26 OF 54
 NOTES RHOADES DATE 9/12/16 ROUTE SR 105
 H.C. O'DONNELL WEATHER SUNNY COUNTY WOOD
 R.C. TODD TEMP. 76° TOWNSHIP WEBSTER
 SECTION 13
 T 5 N R 11 E

TYPE MONUMENT P.K./WASHER
 ON SURFACE - ~~BELOW~~ ON _____
 LEFT - ☉ PAV'T - ~~RIGHT~~ 0.5'
11.1' TO RT EDGE PAVEMENT
 S.L.M. 229+14

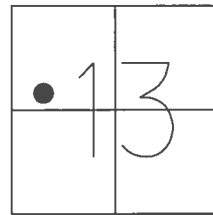

GRID: NORTHING: 631051.879 EASTING: 1680882.183


RECORD: P.O.T.
 STA. 230+25.13
 $\Delta = 0^{\circ}-00'-00''$
 PER 1949 PLAN
 SET R.R.SPIKE 1973
 FD P.K./WASHER
 4/16/02, DCH
 SET P.K./WASHER
 6/13/02, DCH
 FD P.K./WASHER
 REF28
 6/9/16, JFO
 SET 1" MAG/WASHER
 10/13/17, JFO

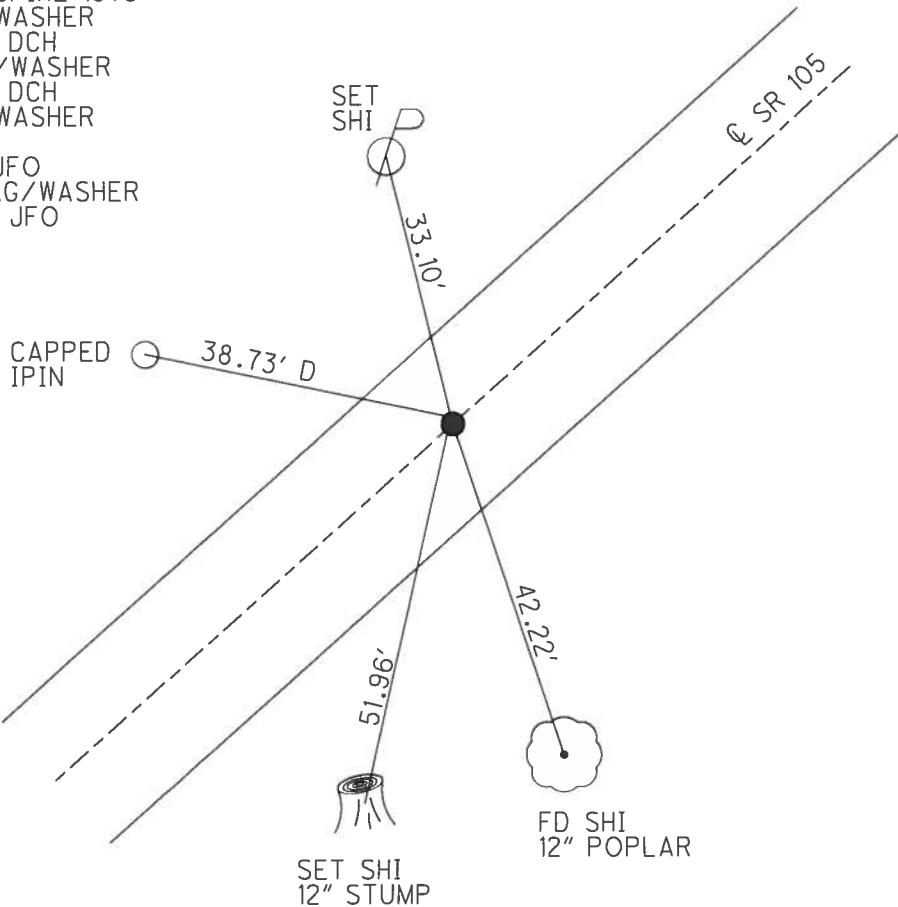

O.D.O.T. DISTRICT 2 SURVEY OFFICE (USE ONLY)


PERSONNEL _____ REFERENCE NO. 28 SHEET 26 OF 54
 NOTES ROUSOS DATE 4/16/02 ROUTE SR 105
 H.C. HOMAN WEATHER CLEAR COUNTY WOOD
 R.C. ROUSOS TEMP. 65° TOWNSHIP WEBSTER
 SECTION 13
 T 5 N R 11 E

TYPE MONUMENT P.K./WASHER
 ON SURFACE - ~~BELOW~~ ON
 LEFT - Q PAV'T - ~~RIGHT~~ 0.5'
11.1' TO RT EDGE PAVEMENT
 S.L.M. 229+14

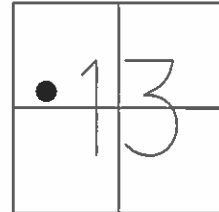

GRID: NORTHING: _____ EASTING: _____

RECORD: P.O.T.
 STA. 230+25.13
 $\Delta = 0^{\circ}-00'-00''$
 PER 1949 PLAN
 SET R.R.SPKIKE 1973
 SET P.K./WASHER
 6/13/02, DCH

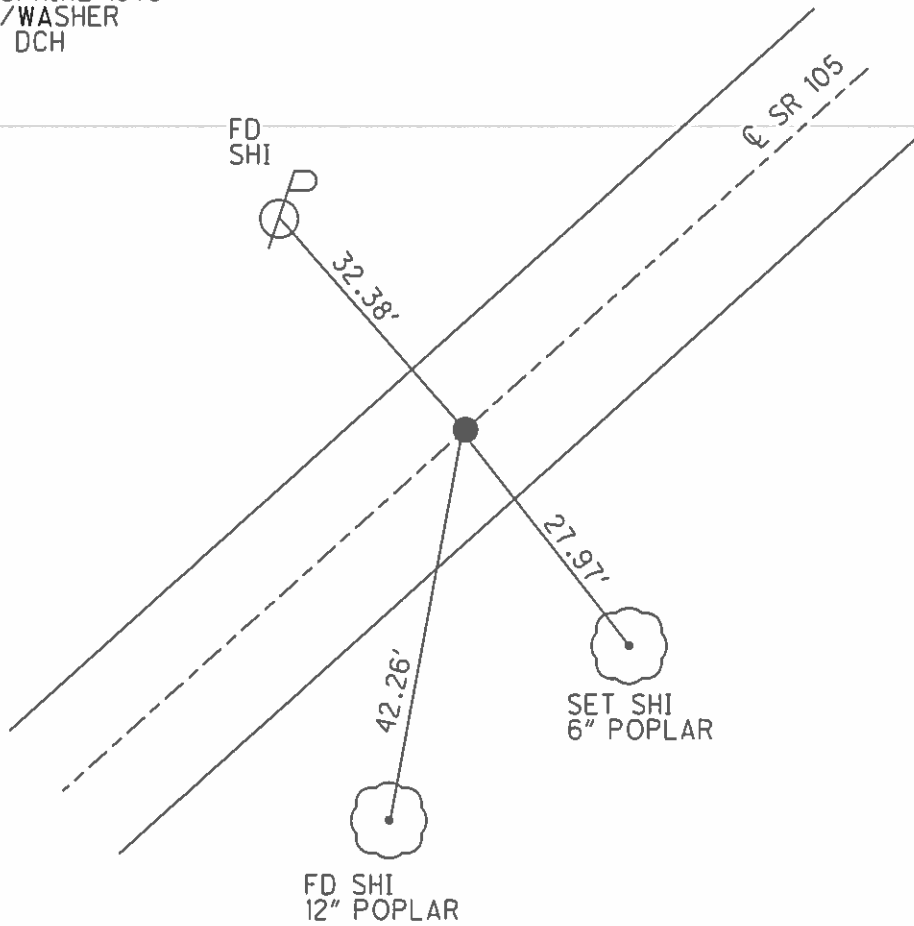

O.D.O.T. DISTRICT 2 SURVEY OFFICE

PERSONNEL

REFERENCE NO. 28

SHEET 38 OF 57

NOTES LONG

H.C. VANDUSEN

DATE 8-26-91

ROUTE 105

R.C. BARNHISEL

WEATHER SUNNY

COUNTY WOOD

TEMP. 85°

TOWNSHIP WEBSTER

SECTION 13

T5 N R 11 E


TYPE MONUMENT P.K./WASHER

ON SURFACE - ~~BELOW~~ YES

LEFT- & PAV'T. - ~~RIGHT~~ 0.5'

11.1' TO RT EDGE PAVEMENT

S.L.M. 229+14

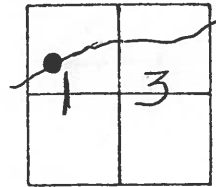


RECORDS:

P.P.T. 230+25.13
 $\Delta = 00.00'$
 Per 1949 PLANS
 Set RR SPIC, 1973

SET PK& WASHER
 4-9-92
 BVD

SHI
 POLE REMOVED
 4-9-92

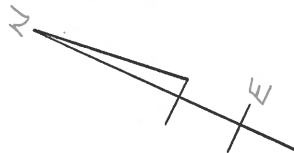

Ed
 SHI
 SIS

32.42'

73.05'

42.38'

51.99'

Ed
 SHI
 12" POPLAR
 NIS

6" ASH
 SET SHI
 NIS

Q.D.O.T. DISTRICT 2 SURVEY OFFICE

SHEET _____ OF _____

County WOOD S.R. 105

Township WEBSTER

Section 13

T.N, R.E

Personnel HOFFMAN

HOUSEHOLDER


LOHRKE

28

Date 4-21-82


Weather CLOUDY - WINDY

Temp. +35°

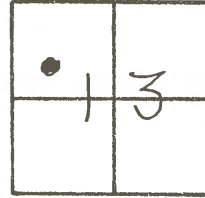

P.O.T. 230+25.13

SET P.K./WASHER
5-27-82 S.W.H.

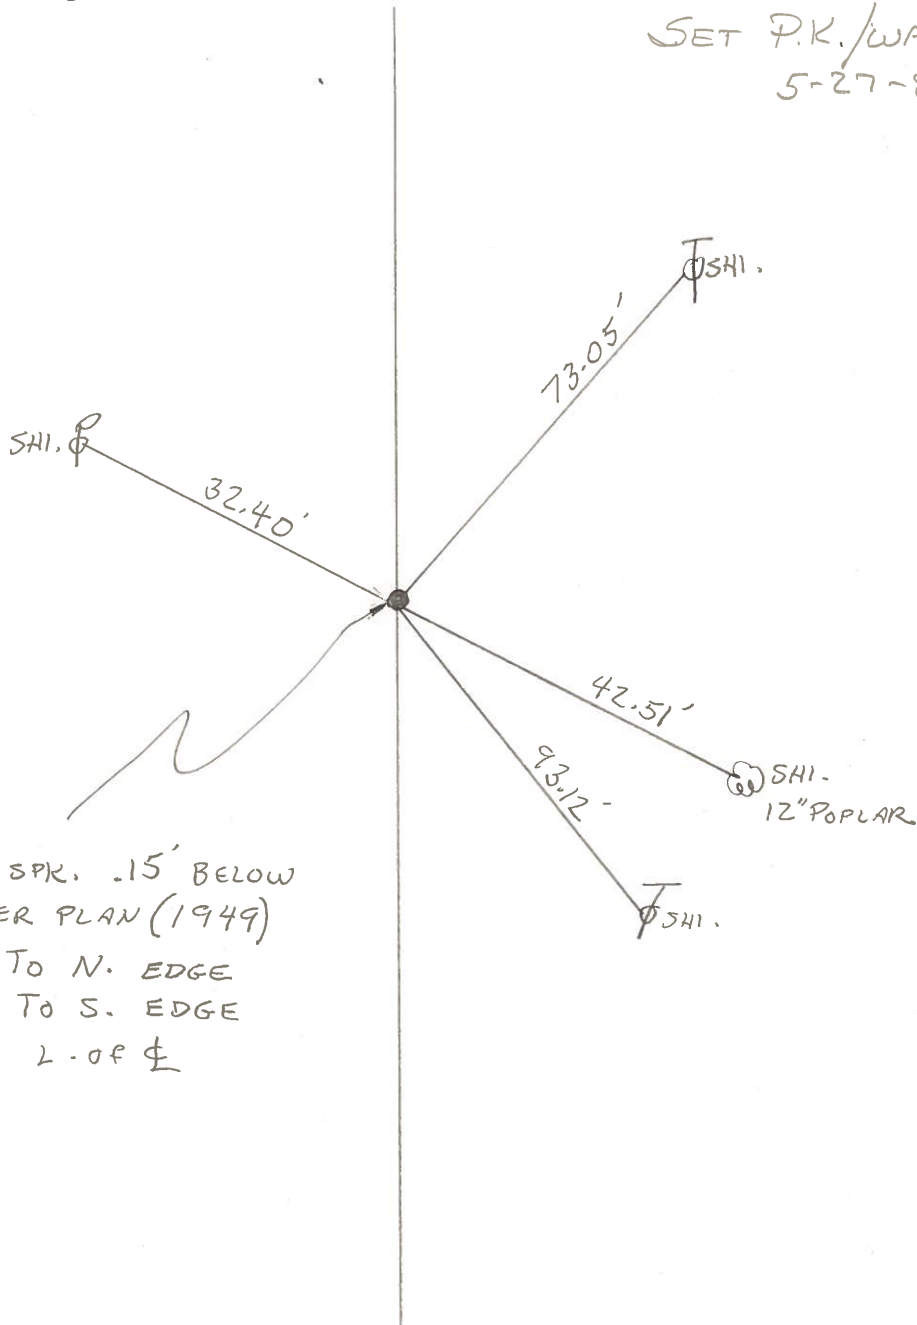

FD. R.R. SPR. .15' BELOW
 AS PER PLAN (1949)
 9.9' - TO N. EDGE
 10.5' - TO S. EDGE
 0.9' - L. OF ♂

PERSONNEL	TITLE	PERSONNEL	TITLE	COUNTY	DATE
Stone				Wood	15 May 73
Michalak				S. R. #105	WEATHER Cool
Denno				SEC. 13- Webster Twp	TEMP. 55°
Curtis					

DESCRIPTION References to Control Points JOB NO. _____
 LEFT CENTER LINE RIGHT

