


O.D.O.T. DISTRICT 2 SURVEY OFFICE (USE ONLY)


PERSONNEL _____ REFERENCE NO. 29 SHEET 27 OF 54
 NOTES RHOADES DATE 9/13/16 ROUTE SR 105
 H.C. O'DONNELL WEATHER FAIR COUNTY WOOD
 R.C. TODD TEMP. 58° TOWNSHIP WEBSTER
 SECTION 13
 T 5 N R 11 E

TYPE MONUMENT P.K./WASHER
 ON SURFACE - ~~BELOW~~ ON _____
 LEFT - ☉ PAV'T - ~~RIGHT~~ 9.5'
0.6' TO LT EDGE PAVEMENT
 S.L.M. 235+36

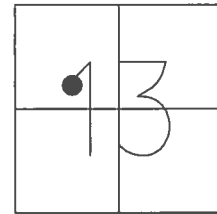

GRID: NORTHING: 631440.098 EASTING: 1681368.026

RECORD: P.I.
 STA. 236+47.24
 $\Delta = 16^{\circ}-30'-00''$ RT
 FD P.K./WASHER
 4/16/02, DCH
 SET P.K./WASHER
 5/28/02, DCH
 FD P.K./WASHER
 REF29
 6/9/16, JFO
 SET 1" MAG/WASHER
 10/13/17, JFO

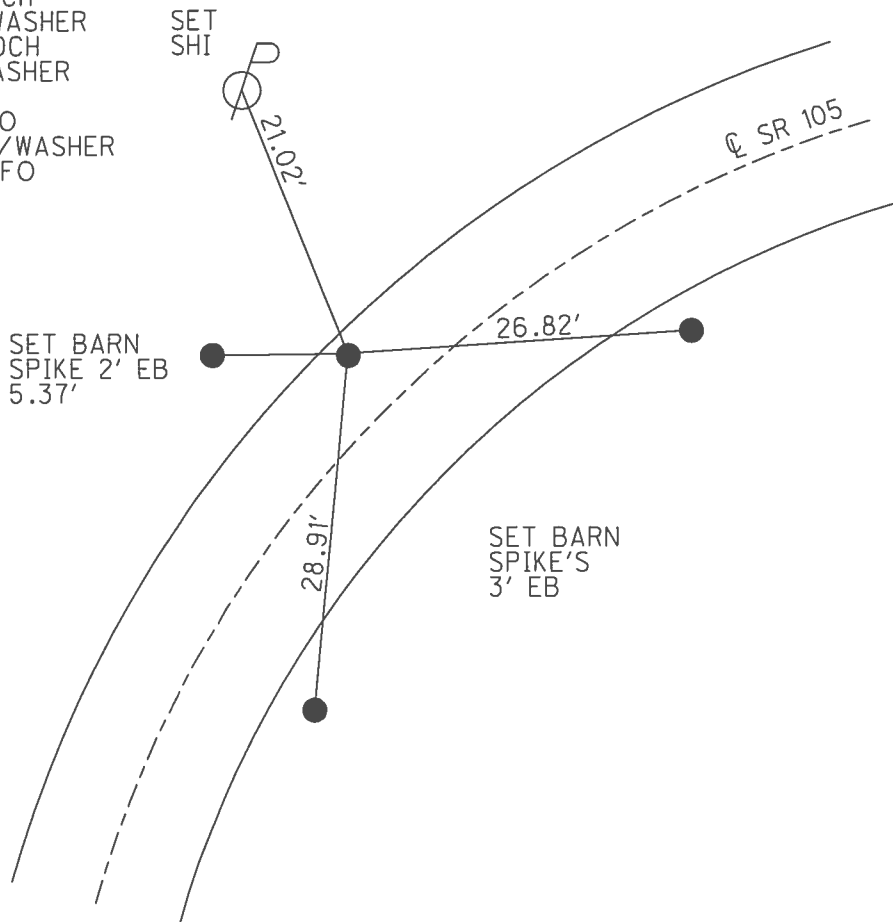


O.D.O.T. DISTRICT 2 SURVEY OFFICE (USE ONLY)

PERSONNEL _____ REFERENCE NO. 29 SHEET 27 OF 54


NOTES ROUSOS DATE 4/16/02 ROUTE SR 105
H.C. HOMAN WEATHER CLEAR COUNTY WOOD
R.C. ROUSOS TEMP. 65° TOWNSHIP WEBSTER
SECTION 13
T 5 N R 11 E

TYPE MONUMENT P.K./WASHER
ON SURFACE - ~~BELOW~~ ON _____
LEFT - ☉ PAV'T - ~~RIGHT~~ 9.5'
0.6' TO LT EDGE PAVEMENT
S.L.M. 235+36

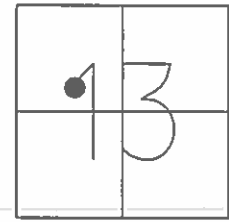

GRID: NORTHING: _____ EASTING: _____

RECORD: P.I.
STA. 236+47.24
 $\Delta = 16^{\circ}-30'-00''$ RT
SET P.K./WASHER
5/28/02, DCH

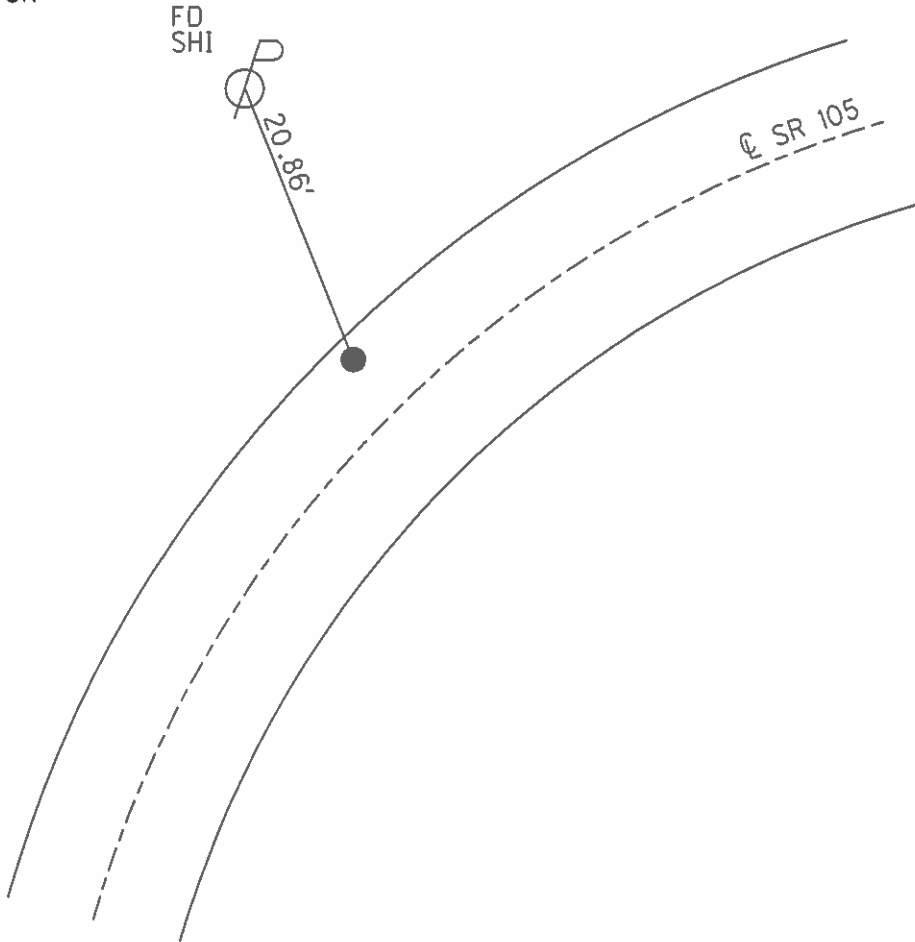

O.D.O.T. DISTRICT 2 SURVEY OFFICE

PERSONNEL

REFERENCE NO. 29

SHEET 39 OF 57

NOTES LONG

H.C. VANDUSEN

R.C. BARNHISEL

DATE 8-26-91

WEATHER SUNNY

TEMP. 85°

ROUTE 105

COUNTY WOOD

TOWNSHIP WEBSTER

SECTION 13

T5 N R 11 E


TYPE MONUMENT P.K / WASHER

ON SURFACE - ~~BELOW~~ YES

LEFT - 0.6' TO LT EDGE PAVEMENT



RIGHT - ~~RIGHT~~ 9.5'

S.L.M. 235 + 36

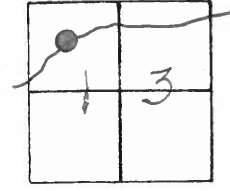

RECORD
 P.I. #26
 236 + 47.24
 $\Delta = 16^{\circ} - 30' - 00''$ RT.

SET PK & WASHER
 11-26-91
 BVD

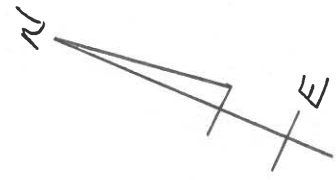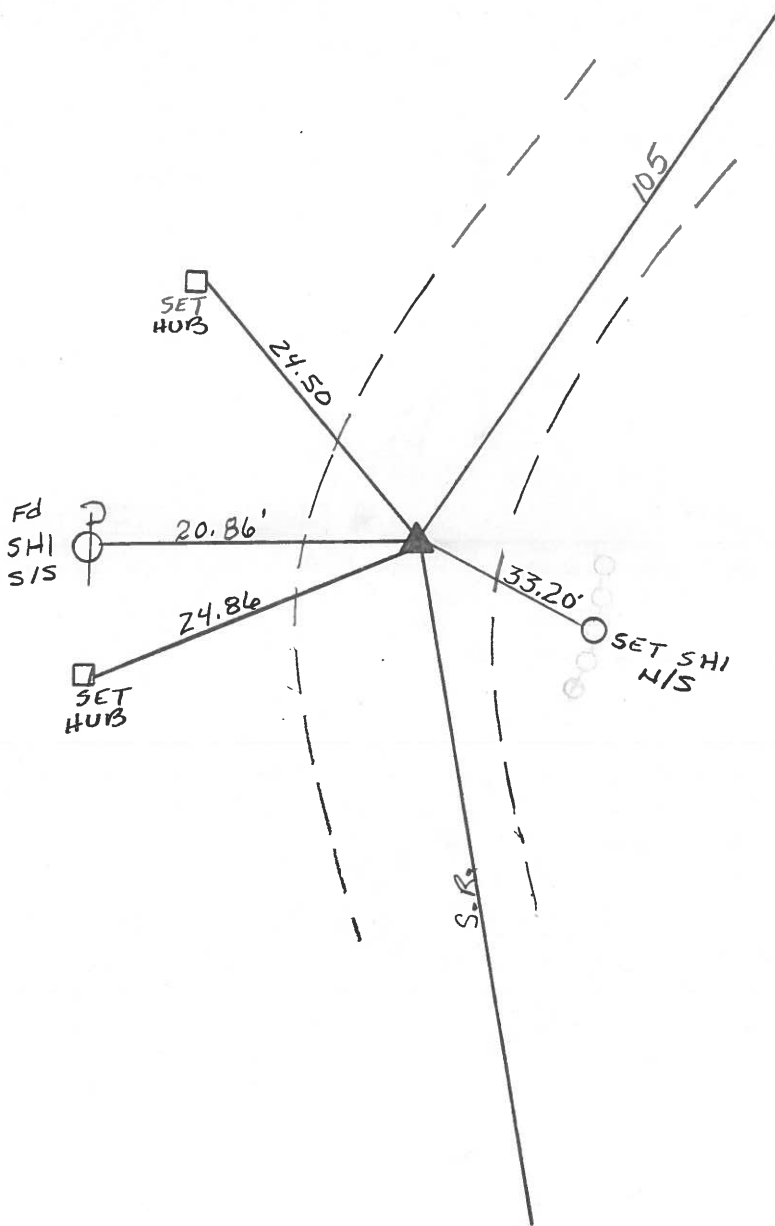

County WOOD S.R. 105

Township WEBSTER

Section 13

T N, R E

Personnel HOFFMAN

HOUSEHOLDER


LOENRKE

29

Date 4-21-82

Weather WINDY

Temp. +40°

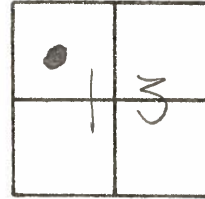


P.I. #26

236+47.24

A = 16°-30'-00" RT.

SET P.K/WASHER
5-27-82 S.W.H.

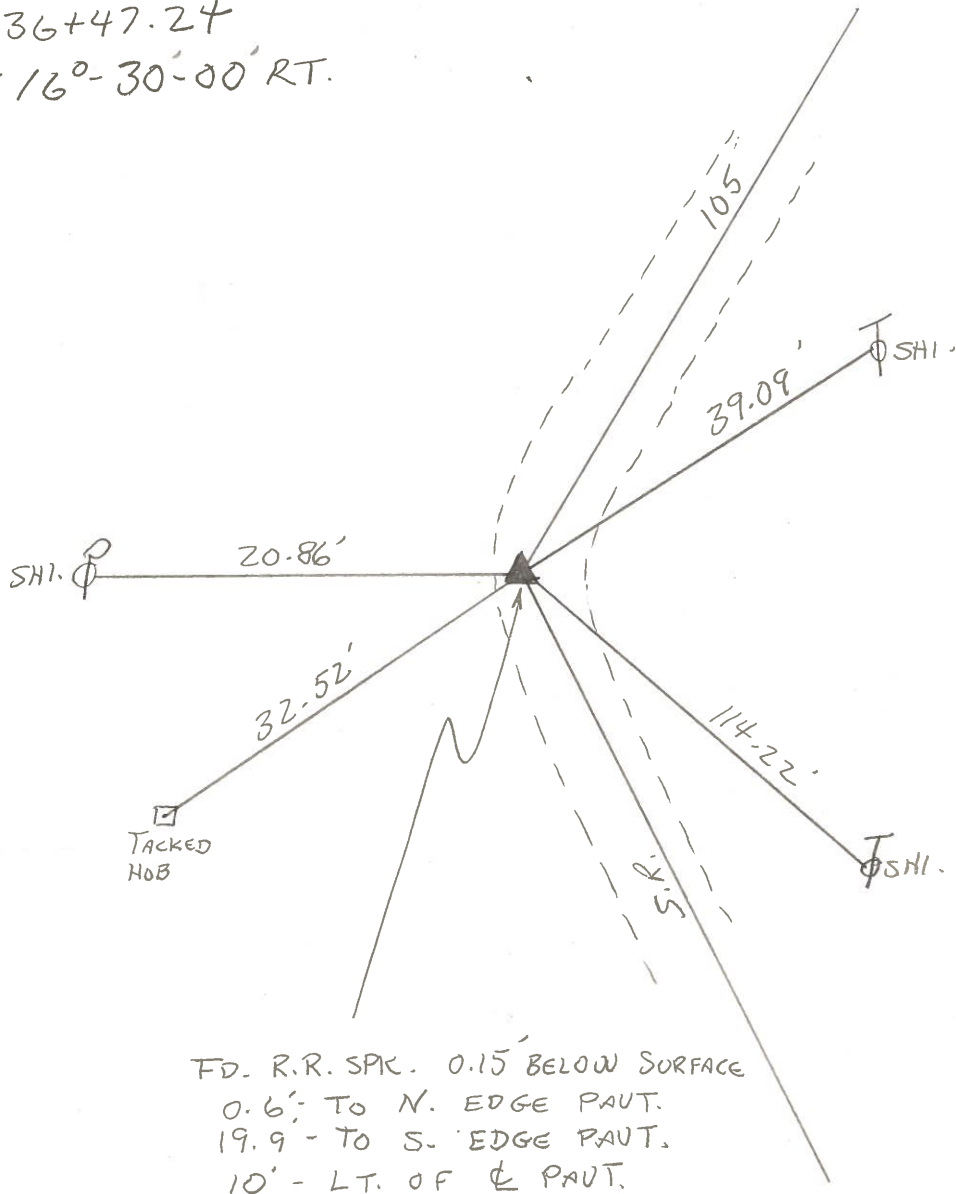

PERSONNEL	TITLE	PERSONNEL	TITLE	COUNTY	DATE
Stone		Brown		Wood	16 July 73
Michalak				S. R. #105	WEATHER Fair
Deno				SEC. Webster Twp.	TEMP. 75°
Curtis					

DESCRIPTION References to Central Points JOB NO. _____
 LEFT CENTER LINE RIGHT

