


O.D.O.T. DISTRICT 2 SURVEY OFFICE (USE ONLY)


PERSONNEL	REFERENCE NO.	<u>30</u>	SHEET	<u>28</u>	OF	<u>54</u>
NOTES	<u>RHOADES</u>	DATE	<u>10/13/17</u>	ROUTE	<u>SR 105</u>	
H.C.	<u>O'DONNELL</u>	WEATHER	<u>HAZE</u>	COUNTY	<u>WOOD</u>	
R.C.	<u>FARKAS</u>	TEMP.	<u>59°</u>	TOWNSHIP	<u>WEBSTER</u>	
				SECTION	<u>13</u>	
				T	<u>5</u>	N
				R	<u>11</u>	E

TYPE MONUMENT 1" MAG/WASHER
 ON SURFACE - ~~BELOW~~ ON
~~LEFT~~ - Q PAV'T - RIGHT 3.7'
6.5' TO RT EDGE PAVEMENT
 S.L.M. 239+36

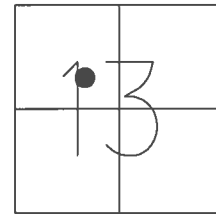

GRID: NORTHING: 631591.178 EASTING: 1681739.647


RECORD: P.I.
 STA. 240+48.41
 $\Delta = 3^{\circ}-45'-00''$ LT
 FD P.K./WASHER
 4/16/02,
 SET P.K./WASHER
 5/31/02, DCH
 SET MAG/WASHER
 REF 30
 6/9/16, JFO
 SET 1" MAG/WASHER
 10/13/17, JFO

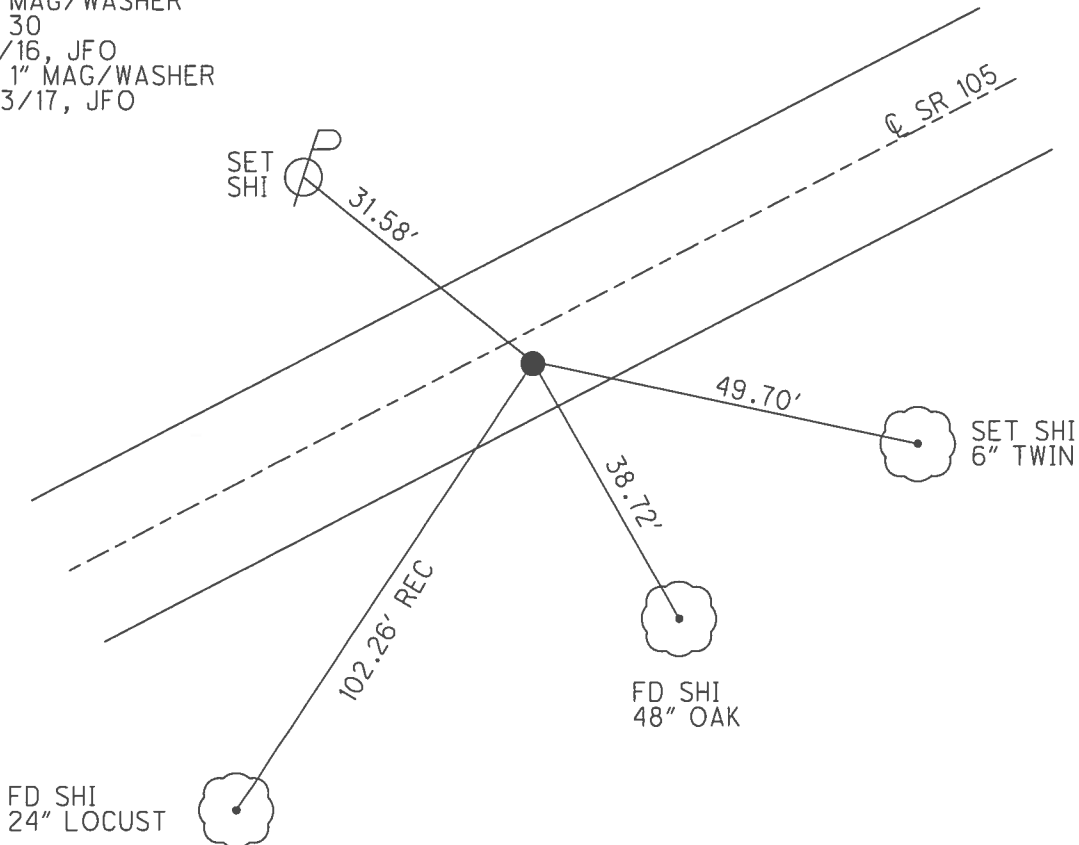

O.D.O.T. DISTRICT 2 SURVEY OFFICE (USE ONLY)


PERSONNEL _____ REFERENCE NO. 30 SHEET 28 OF 54
 NOTES ROUSOS DATE 4/16/02 ROUTE SR 105
 H.C. HOMAN WEATHER CLEAR COUNTY WOOD
 R.C. ROUSOS TEMP. 65° TOWNSHIP WEBSTER
 _____ SECTION 13
 _____ T 5 N R 11 E

TYPE MONUMENT P.K./WASHER
 ON SURFACE - ~~BELOW~~ ON
~~LEFT~~ - Q PAV'T - RIGHT 3.7'
6.5' TO RT EDGE PAVEMENT
 S.L.M. 239+36

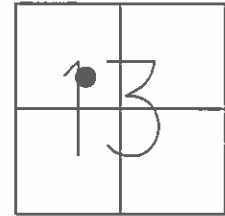

GRID: NORTHING: _____ EASTING: _____

RECORD: P.I.
 STA. 240+48.41
 $\Delta = 3^\circ-45'-00''$ LT
 SET P.K./WASHER
 5/31/02, DCH

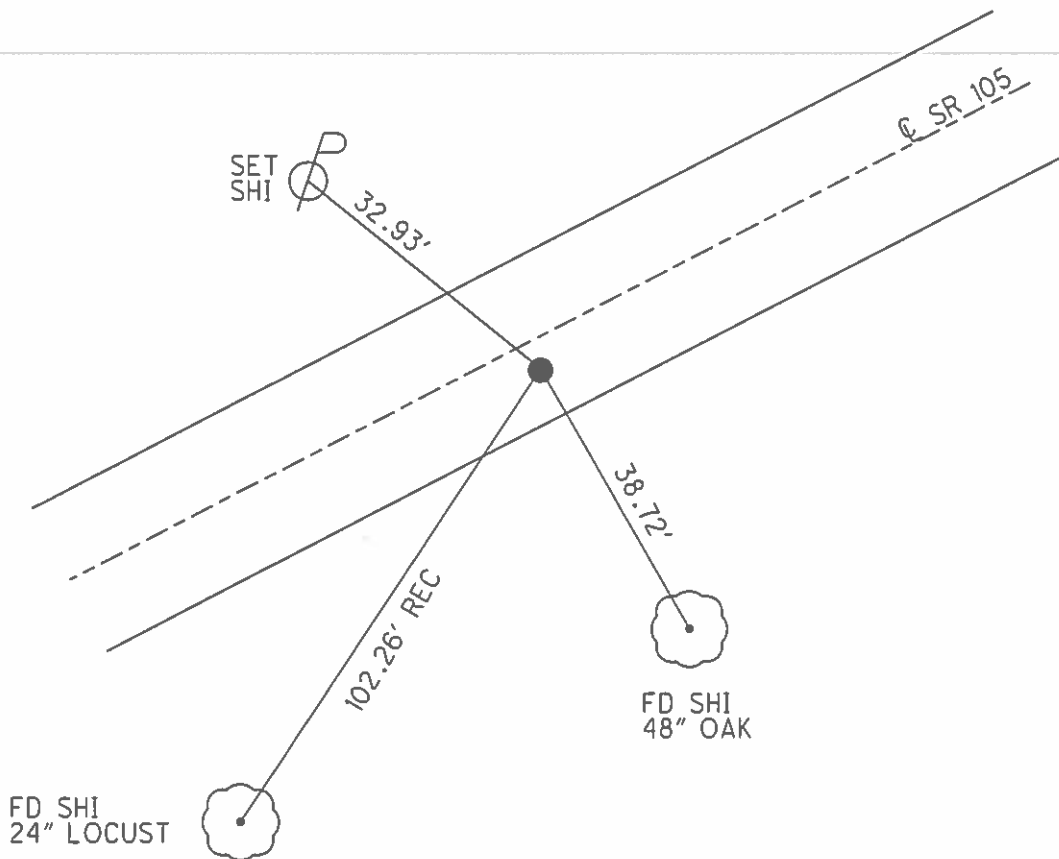

O.D.O.T. DISTRICT 2 SURVEY OFFICE

PERSONNEL

REFERENCE NO. 30

SHEET 40 OF 57

NOTES LONG

H.C. VANDUSEN

DATE 8-26-91

ROUTE 105

R.C. BARNHISEL

WEATHER SUNNY

COUNTY WOOD

TEMP. 90°

TOWNSHIP WEBSTER

SECTION 13


T5 NR 11 E

TYPE MONUMENT P.K. / WASHER

ON SURFACE - BELOW YES



~~LEFT~~ - 6.5' TO RT. EDGE PAVEMENT

S.L.M. 239+36

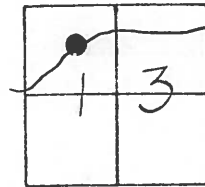

RECORD P.I. #27
 246+98.91
 $\Delta = 3^{\circ} - 45' - 00''$ LT.

SET PK & WASHER
 4-9-92
 BVD

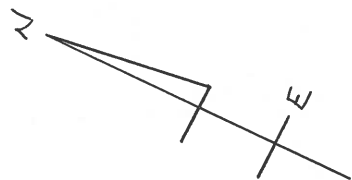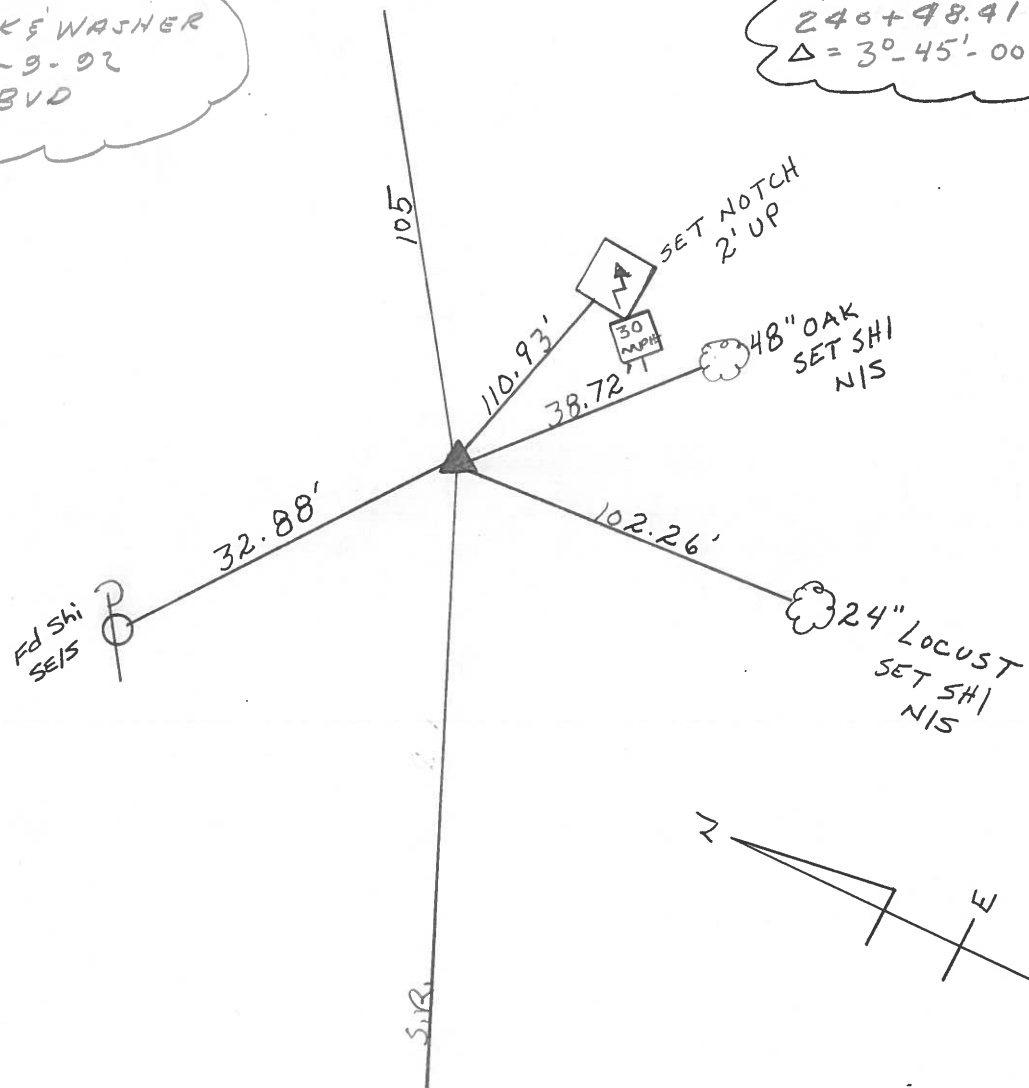

County WOOD S.R. 105

Township WEBSTER

Section 13

T. N, R. E

Personnel HOFFMAN

HOUSEHOLDER


LOEHRKE

#30

Date 4-21-82

Weather CLOUDY

Temp. +40°

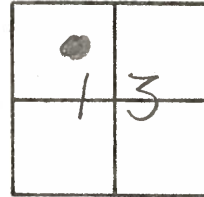


P.I. #27

240+48.41

$\Delta = 3^{\circ} - 45' - 00''$ LT.

SET P.K./WASHER
5-27-82 S.W.H.

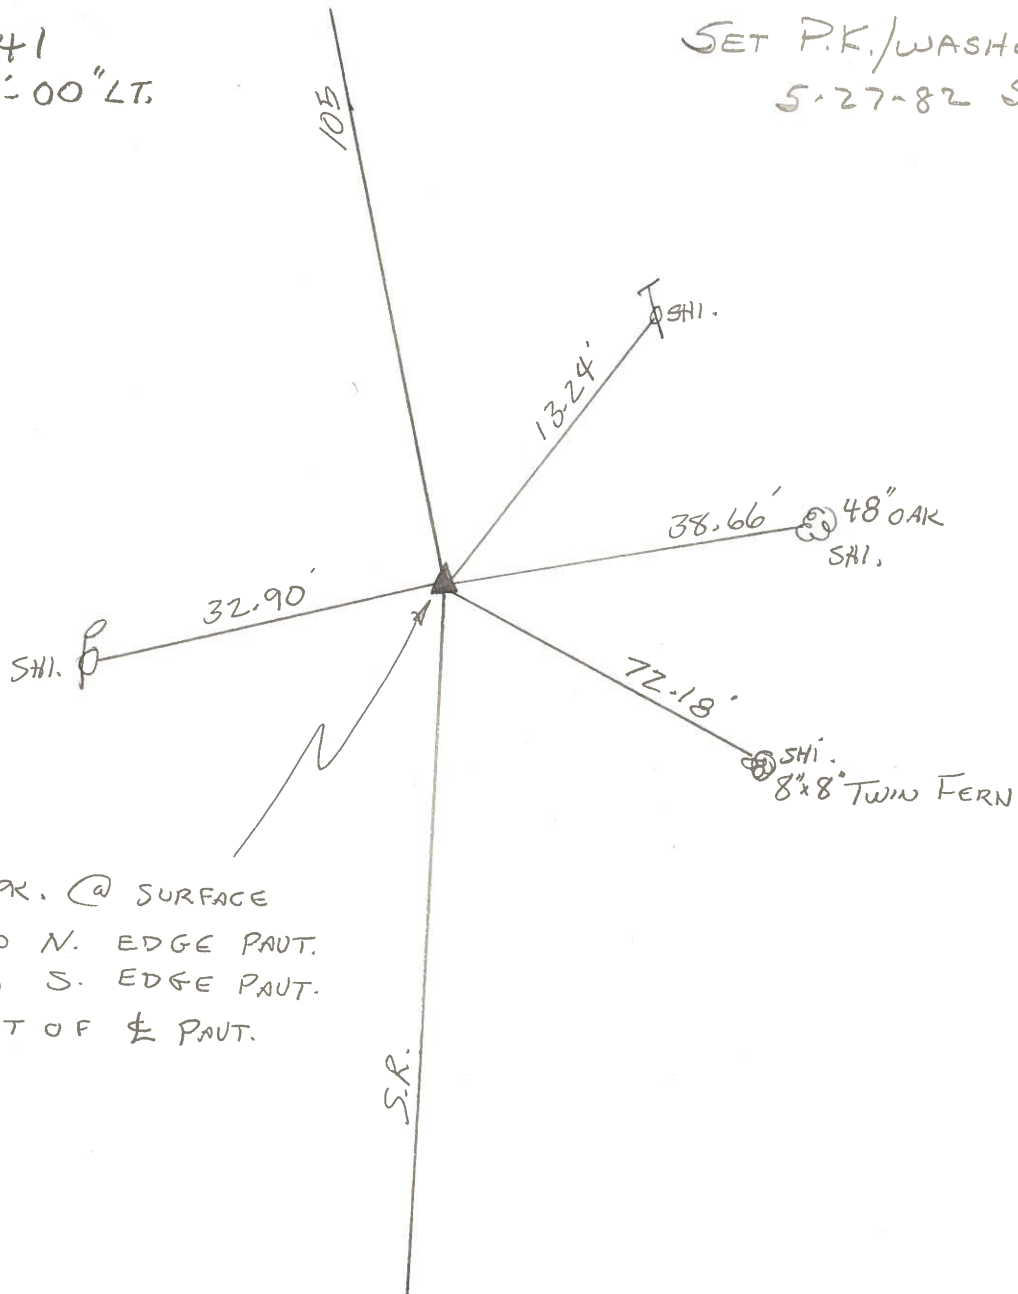

FD. R.R. SPK. @ SURFACE

13.4' - TO N. EDGE PAUT.

6.5' - TO S. EDGE PAUT.

30.1' - RT OF $\frac{1}{2}$ PAUT.

PERSONNEL	TITLE	PERSONNEL	TITLE	COUNTY	DATE	WEATHER	TEMP.
Stone		Brannan		Wood	16 July 73	Fair	75°
Michalak				S. R. #105			
Deno				SEC. Webster Twp.			
Curtis							

DESCRIPTION References to Central Points JOB NO. _____
 LEFT CENTER LINE RIGHT

