


O.D.O.T. DISTRICT 2 SURVEY OFFICE (USE ONLY)


PERSONNEL _____ REFERENCE NO. 31 SHEET 29 OF 54
 NOTES RHOADES DATE 9/13/16 ROUTE SR 105
 H.C. O'DONNELL WEATHER FAIR COUNTY WOOD
 R.C. TODD TEMP. 58° TOWNSHIP WEBSTER
 SECTION 13
T 5 N R 11 E

TYPE MONUMENT P.K./WASHER
 ON SURFACE - ~~BELOW~~ ON
~~LEFT~~ - Q PAV'T - RIGHT 2.5'
8.2' TO RT EDGE PAVEMENT
 S.L.M. 242+04

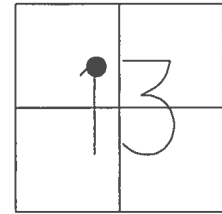

GRID: NORTHING: 631708.323 EASTING: 1681981.136


RECORD: P.I.
 STA. 243+16.87
 $\Delta = 6^{\circ}-10'-00''$ LT
 FD P.K./WASHER
 4/16/02, DCH
 SET P.K./WASHER
 5/31/02, DCH
 FD P.K./WASHER
 REF31
 6/9/16, JFO
 SET 1" MAG/WASHER
 10/13/17, JFO

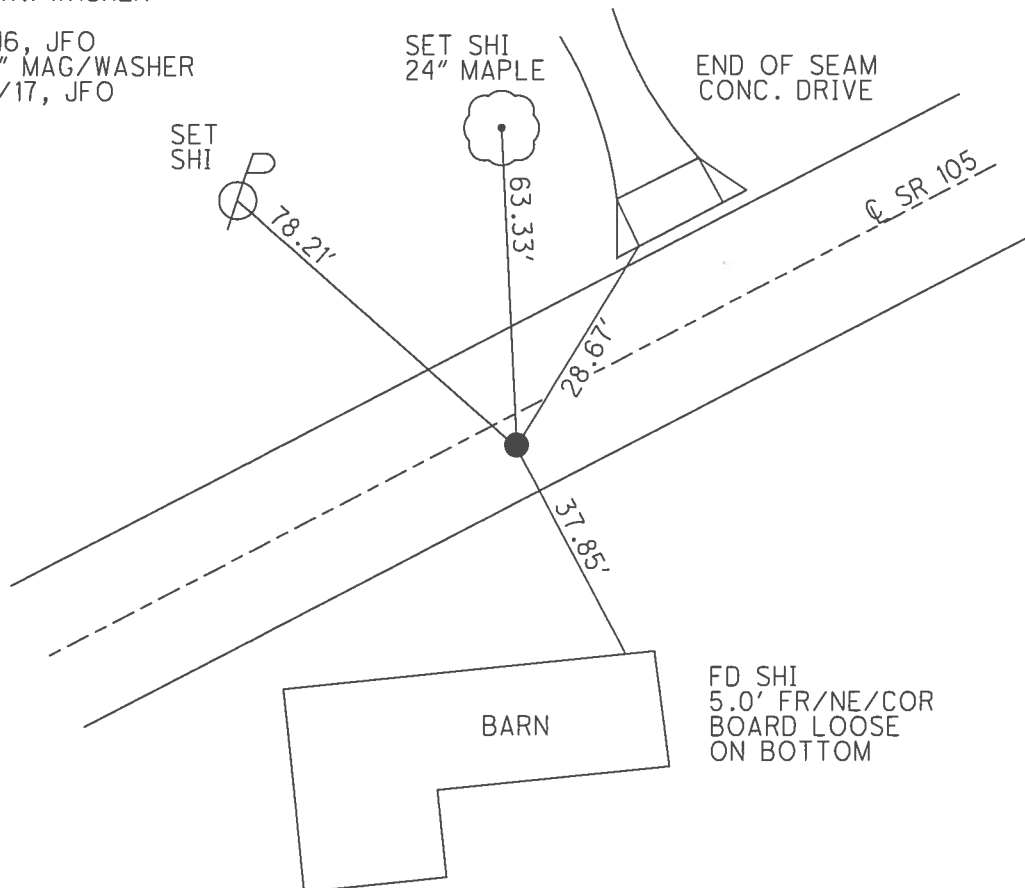

O.D.O.T. DISTRICT 2 SURVEY OFFICE (USE ONLY)


PERSONNEL _____ REFERENCE NO. 31 SHEET 29 OF 54
 NOTES ROUSOS DATE 4/16/02 ROUTE SR 105
 H.C. HOMAN WEATHER CLEAR COUNTY WOOD
 R.C. ROUSOS TEMP. 65° TOWNSHIP WEBSTER
 _____ SECTION 13
 _____ T 5 N R 11 E

TYPE MONUMENT P.K./WASHER
 ON SURFACE - ~~BELOW~~ ON
~~LEFT~~ - CL PAV'T - RIGHT 2.5'
8.2' TO RT EDGE PAVEMENT
 S.L.M. 242+04

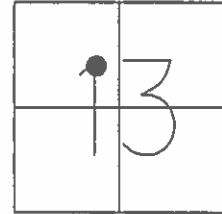

GRID: NORTHING: _____ EASTING: _____

RECORD: P.I.
 STA. 243+16.87
 $\Delta = 6^{\circ}-10'-00''$ LT
 SET P.K./WASHER
 5/31/02, DCH

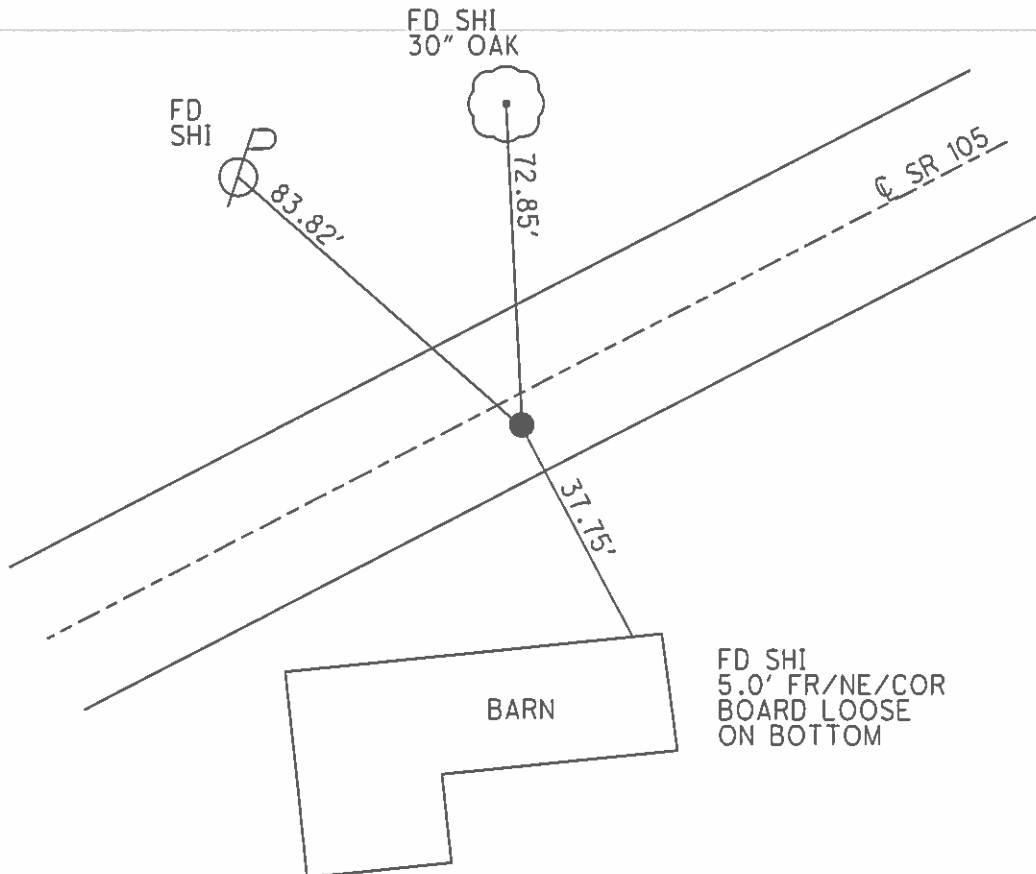

O.D.O.T. DISTRICT 2 SURVEY OFFICE

PERSONNEL

REFERENCE NO. 31

SHEET 41 OF 57

NOTES LONG

H.C. VAN DUSEN

DATE 8-26-91

ROUTE 105

R.C. BARNHISEL

WEATHER SUNNY

COUNTY WOOD

TEMP. 90°

TOWNSHIP WEBSTER

SECTION 13

T5 N R 11 E


TYPE MONUMENT P.K./WASHER

ON SURFACE -BELOW YES

~~LEFT~~ - C PAV'T. - RIGHT 2.5


8.2' TO RT EDGE PAVEMENT

S.L.M. 242+04

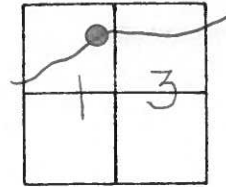

SET PK& WASHER
 4-9-92
 BVD

RECORD
 P.I. #28
 243+16.87
 $\Delta = 6^\circ - 10' - 00''$ LT

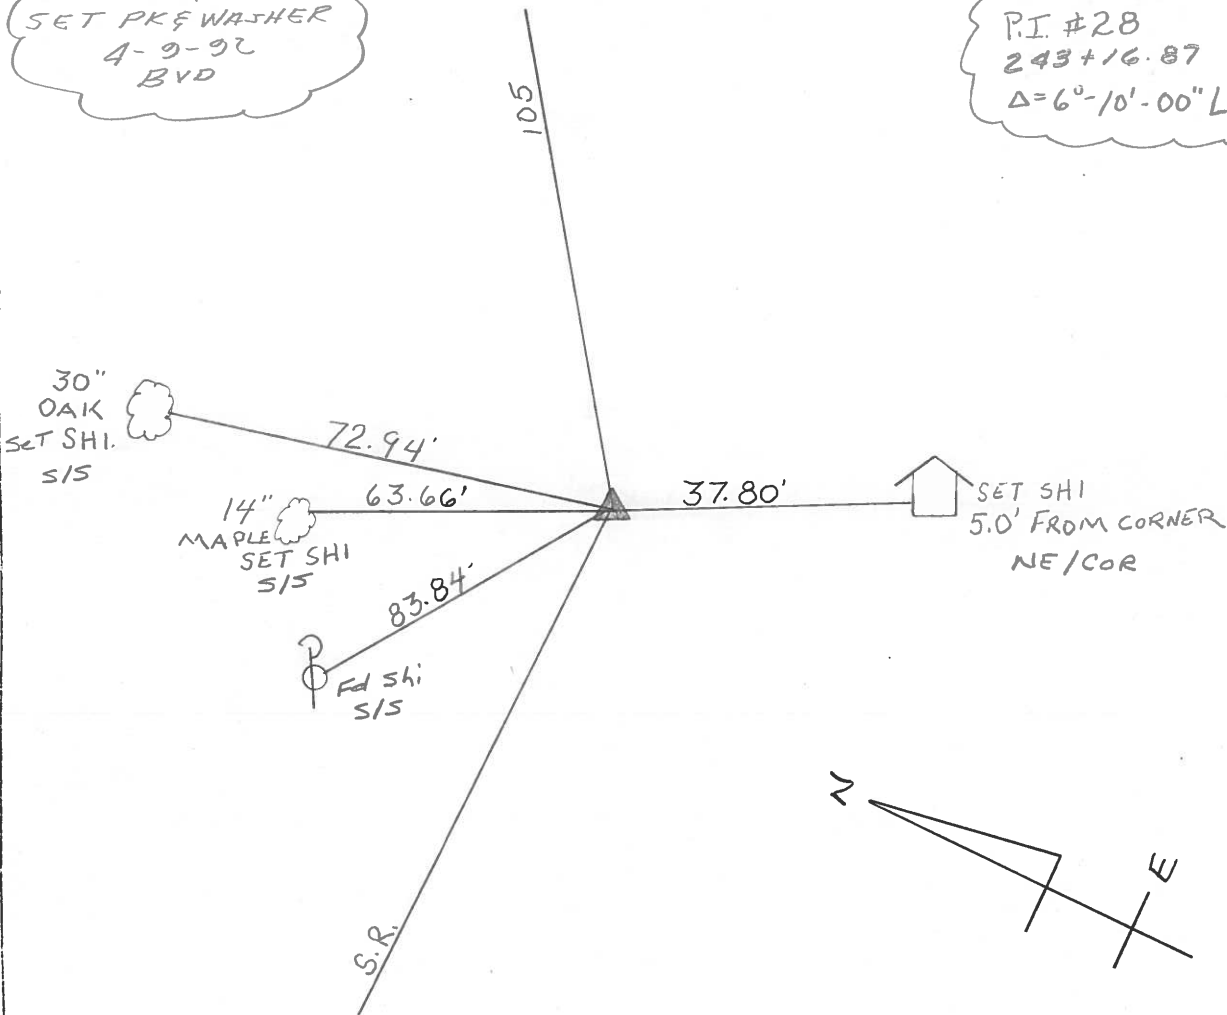

County Wood S.R. 105

Date 4-21-82

Township WEBSTER

Weather WINDY

Section 13

Temp. +40°


T. N, R. E

Personnel HOFFMAN

#31

HOUSEHOLDER


LOEHRKE

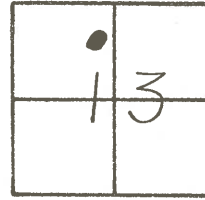

P.I. #28

243 + 16.87

$\Delta = 6^{\circ} - 10' - 00''$ LT.

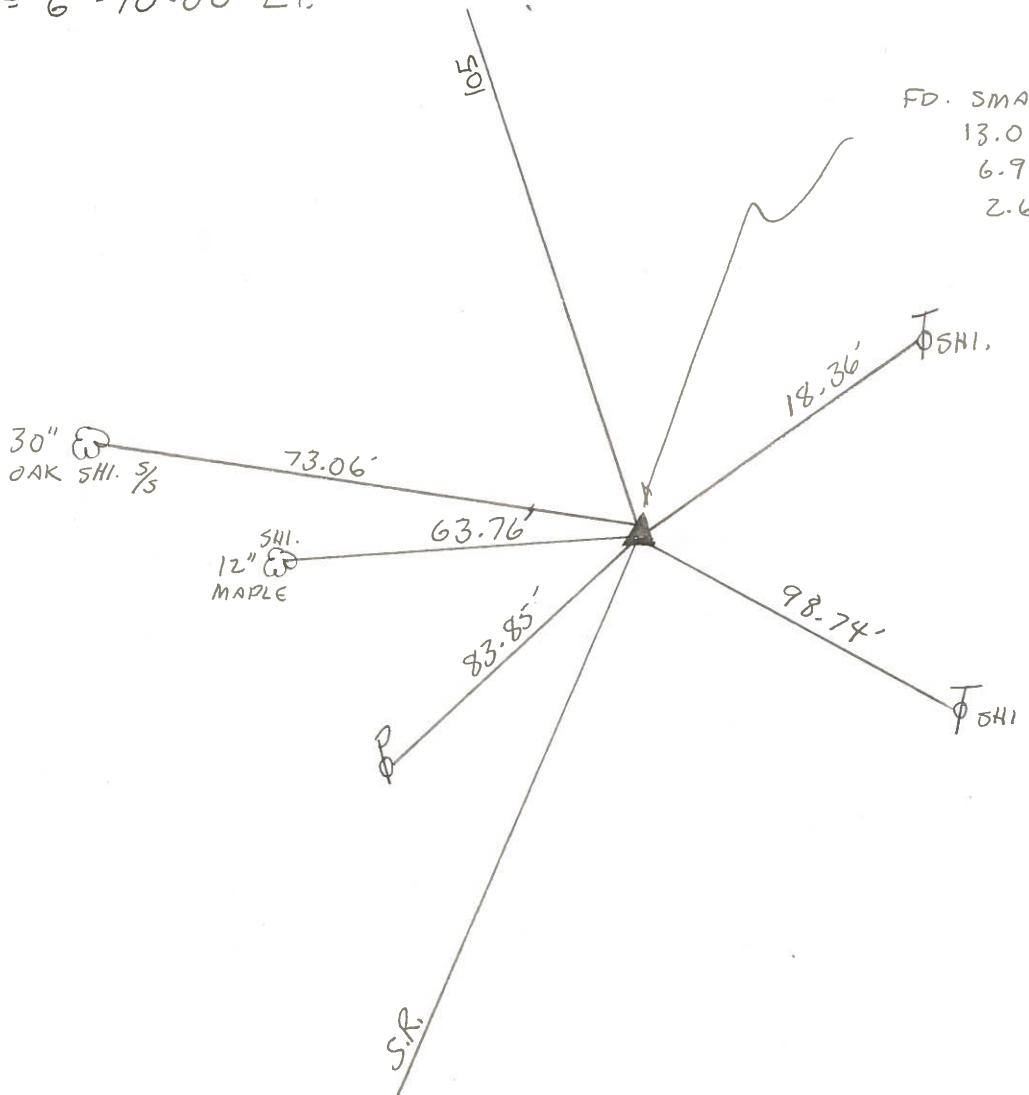

FD. SMALL R.R. SPK.

13.0' TO N. EDGE PAVT.

6.9' TO S. EDGE PAVT.

2.6' RT. OF Φ PAVT.

SET P.K./WASHER
5-27-82 S.W.H.

PERSONNEL	TITLE	PERSONNEL	TITLE	COUNTY	DATE	WEATHER	TEMP.
Stone		Brennan		Wood	16 July 73	Fair	75°
Michelak				#105			
Dennø				Webster Twp.			
Curtis							

DESCRIPTION References to Control Points JOB NO. _____

