


O.D.O.T. DISTRICT 2 SURVEY OFFICE (USE ONLY)


PERSONNEL _____ REFERENCE NO. 32 SHEET 30 OF 54
 NOTES RHOADES DATE 9/13/16 ROUTE SR 105
 H.C. O'DONNELL WEATHER FAIR COUNTY WOOD
 R.C. TODD TEMP. 58° TOWNSHIP WEBSTER
 _____ SECTION 13
 _____ T 5 N R 11 E

TYPE MONUMENT P.K./WASHER
 ON SURFACE - ~~BELOW~~ ON
 LEFT - ☉ PAV'T - ~~RIGHT~~ 9.6"
1.3' TO LT EDGE PAVEMENT
 S.L.M. 244+50

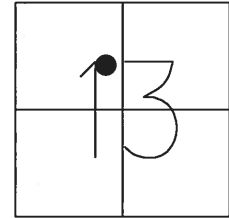

GRID: NORTHING: 631839.047 EASTING: 1682189.740

RECORD: P.I.
 STA. 245+63.14
 $\Delta = 27^{\circ}-06'-20''$ RT
 FD P.K./WASHER
 4/16/02, DCH
 SET P.K./WASHER
 5/31/02, DCH
 FD P.K./WASHER
 REFA32
 6/9/16, JFO
 SET 1" MAG/WASHER
 10/13/17, JFO

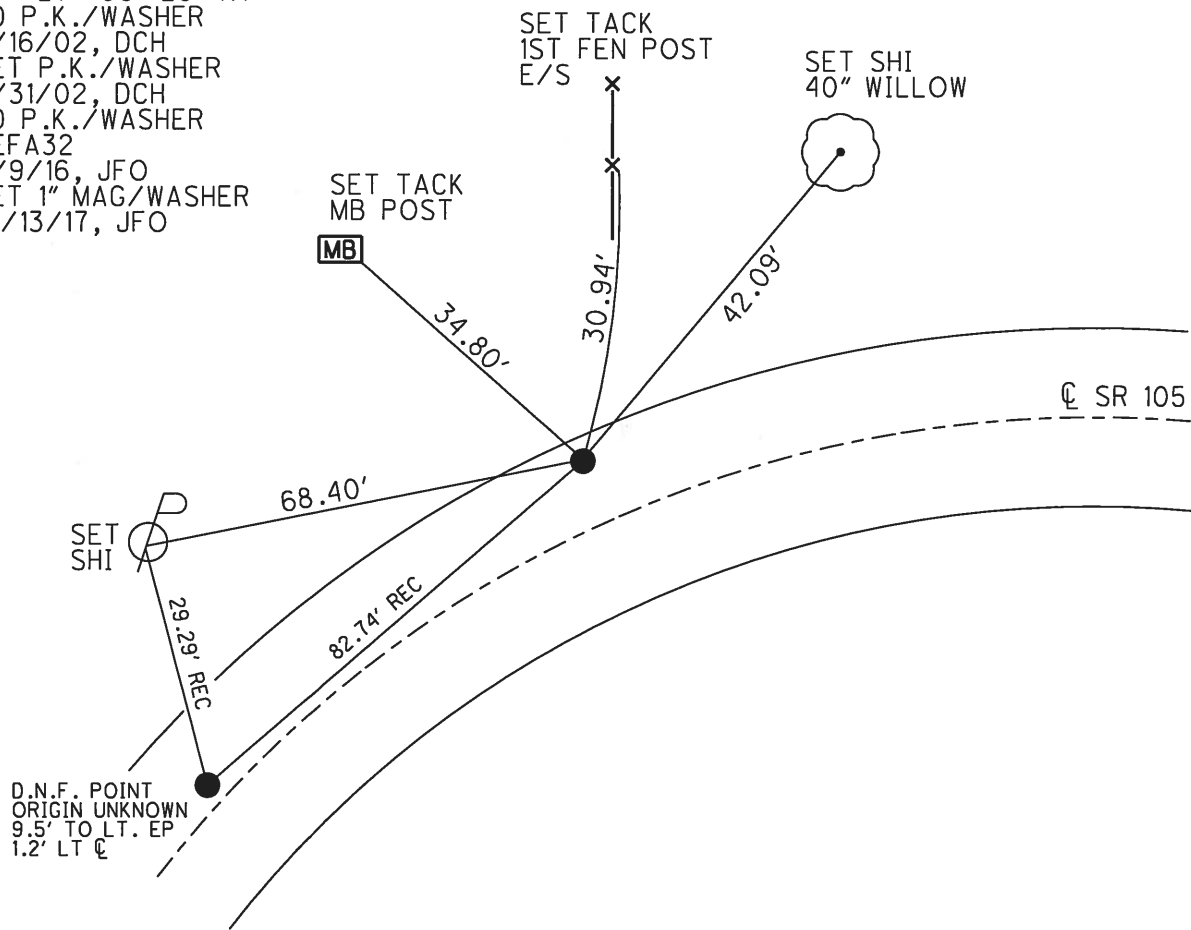


D.N.F. POINT
 ORIGIN UNKNOWN
 9.5' TO LT. EP
 1.2' LT ☉

O.D.O.T. DISTRICT 2 SURVEY OFFICE (USE ONLY)


PERSONNEL _____ REFERENCE NO. 32 SHEET 30 OF 54
 NOTES ROUSOS DATE 4/16/02 ROUTE SR 105
 H.C. HOMAN WEATHER CLEAR COUNTY WOOD
 R.C. ROUSOS TEMP. 65° TOWNSHIP WEBSTER
 SECTION 13
 T 5 N R 11 E

TYPE MONUMENT P.K./WASHER
 ON SURFACE - ~~BELOW~~ ON _____
 LEFT - ☉ PAV'T - ~~RIGHT~~ 9.6"
1.3' TOLT EDGE PAVEMENT
 S.L.M. 244+50

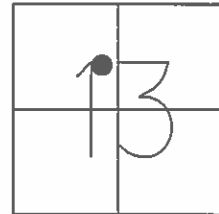

GRID: NORTHING: _____ EASTING: _____

RECORD: P.I.
 STA. 245+63.14
 $\Delta = 27^{\circ}-06'-20''$ RT
 SET P.K./WASHER
 5/31/02, DCH

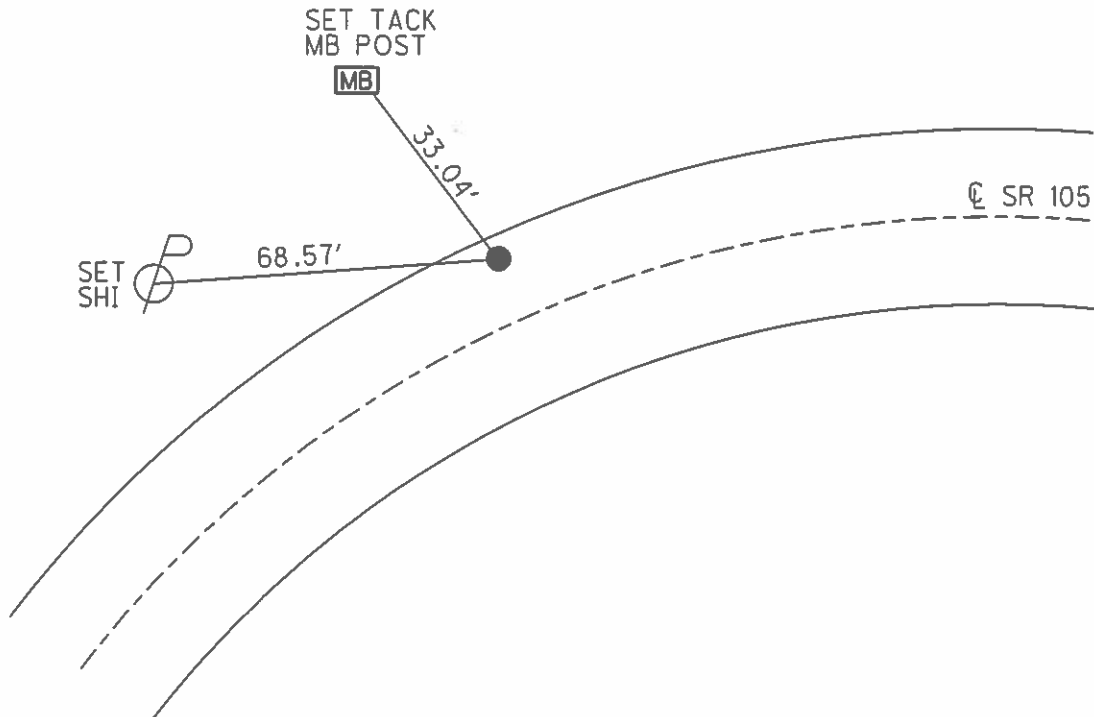

O.D.O.T. DISTRICT 2 SURVEY OFFICE

PERSONNEL

REFERENCE NO. 32

SHEET 42 OF 57

NOTES LONG

H.C. VANDUSEN

R.C. BARNHISEL

DATE 8-26-91

WEATHER SUNNY

TEMP. 90°

ROUTE 105

COUNTY WOOD

TOWNSHIP WEBSTER

SECTION 13

T5 N R 11 E


TYPE MONUMENT P.K. / WASHER "A"

ON SURFACE - BELOW YES

LEFT- & PAV'T. - RIGHT 9.6'


1.3 TO LT EDGE PAVEMENT

S.L.M. 244+50

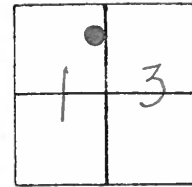

SET PK & WASHER
 4-9-92
 BVD

RECORD
 P.I. # 29
 245+63.14
 $\Delta = 27^{\circ}-06'-20''$ RT.

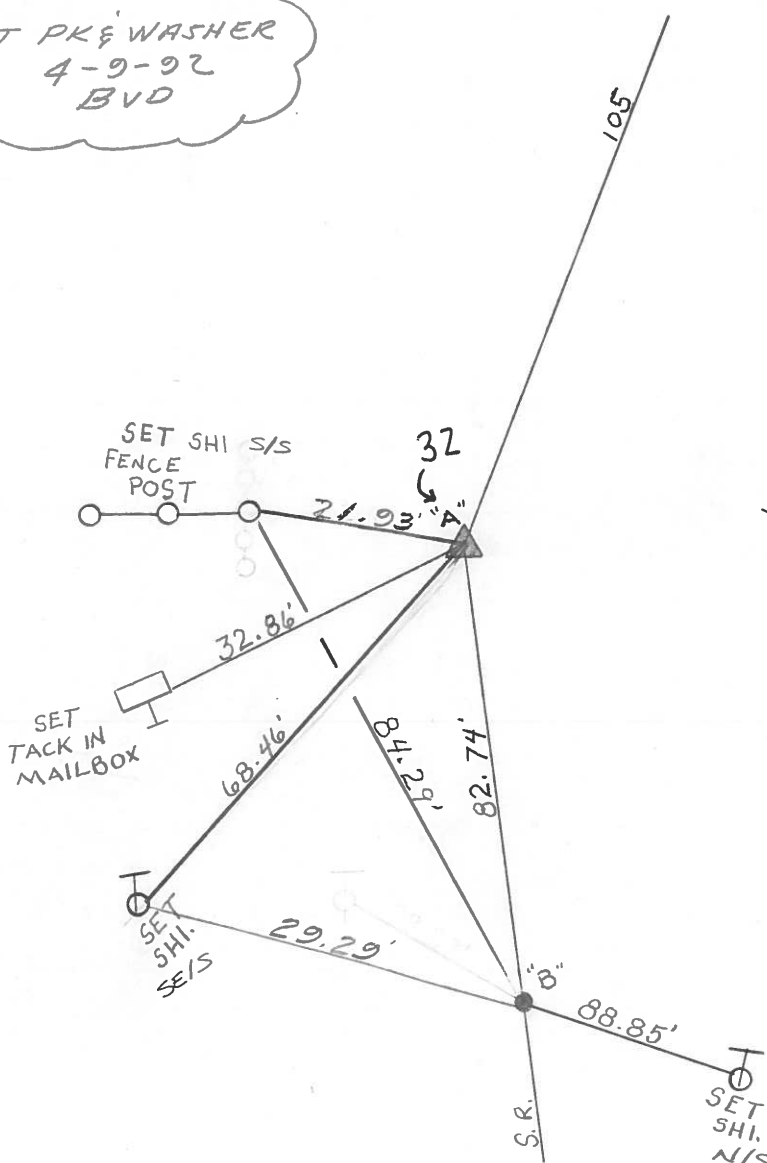

PT "B"
 ORIGIN UNKNOWN
 9.5 To LT Edge
 1.2 LT of R
 243+67 SLM

County WOOD S.R. 105

Date 4-21-82

Township WEBSTER


Weather WINDY - CLOUDY

Section 13

Temp. +40°

T N, R E

Personnel HOFFMAN

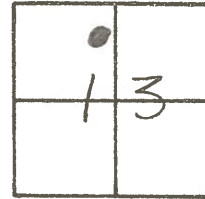

HOUSEHOLDER

LOEHRKE

32

P.I # 29

245+63.14


$\Delta = 27^{\circ} - 06' - 20''$ RT.

SET P.K./WASHER @ BOTH POINTS
5-27-82 SW.H.

POINT "A"

FD. SMALL R.R. SPK. @ SURFACE

- 1.9' - TO N. EDGE
- 19.7' - TO S. EDGE
- 11.2' - LT. OF Φ

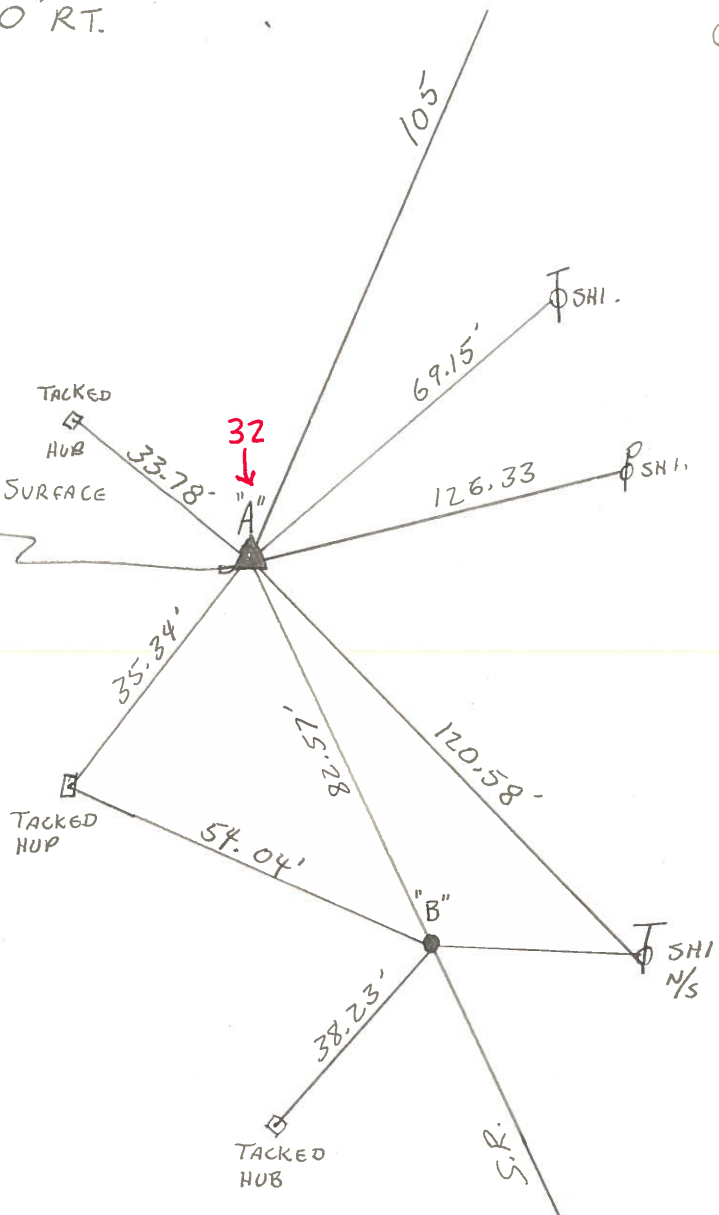

POINT "B"

SOURCE UNKNOWN
FD. P.K. NAIL @ SURFACE

- 9.3' - TO N. EDGE
- 10.9' - TO S. EDGE
- 1.8' - LT. OF Φ

PERSONNEL TITLE PERSONNEL TITLE

COUNTY Wood DATE 16 July 73

Stane Brennan

S. R. #105 WEATHER Fair

Michalak

Danno

SEC. Webster Twp. TEMP. 75°

Curtis

DESCRIPTION LEFT REFERENCES TO CONTROL POINTS CENTER LINE RIGHT JOB NO.

