



O.D.O.T. DISTRICT 2 SURVEY OFFICE (USE ONLY)

PERSONNEL \_\_\_\_\_ REFERENCE NO. 33 SHEET 31 OF 54  
 NOTES RHOADES DATE 10/13/17 ROUTE SR 105  
 H.C. O'DONNELL WEATHER HAZE COUNTY WOOD  
 R.C. FARKAS TEMP. 59° TOWNSHIP WEBSTER  
 \_\_\_\_\_ SECTION 13  
 \_\_\_\_\_ T 5 N R 11 E

TYPE MONUMENT 1" MAG/WASHER  
 ON SURFACE - ~~BELOW~~ ON \_\_\_\_\_  
 LEFT - ☉ PAV'T - ~~RIGHT~~ 9'  
2' TO LT EDGE PAVEMENT  
 S.L.M. 247+33

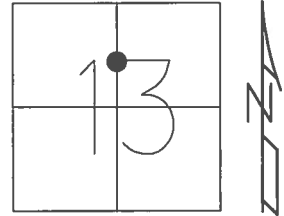

GRID: NORTHING: 631863.500 EASTING: 1682474.220

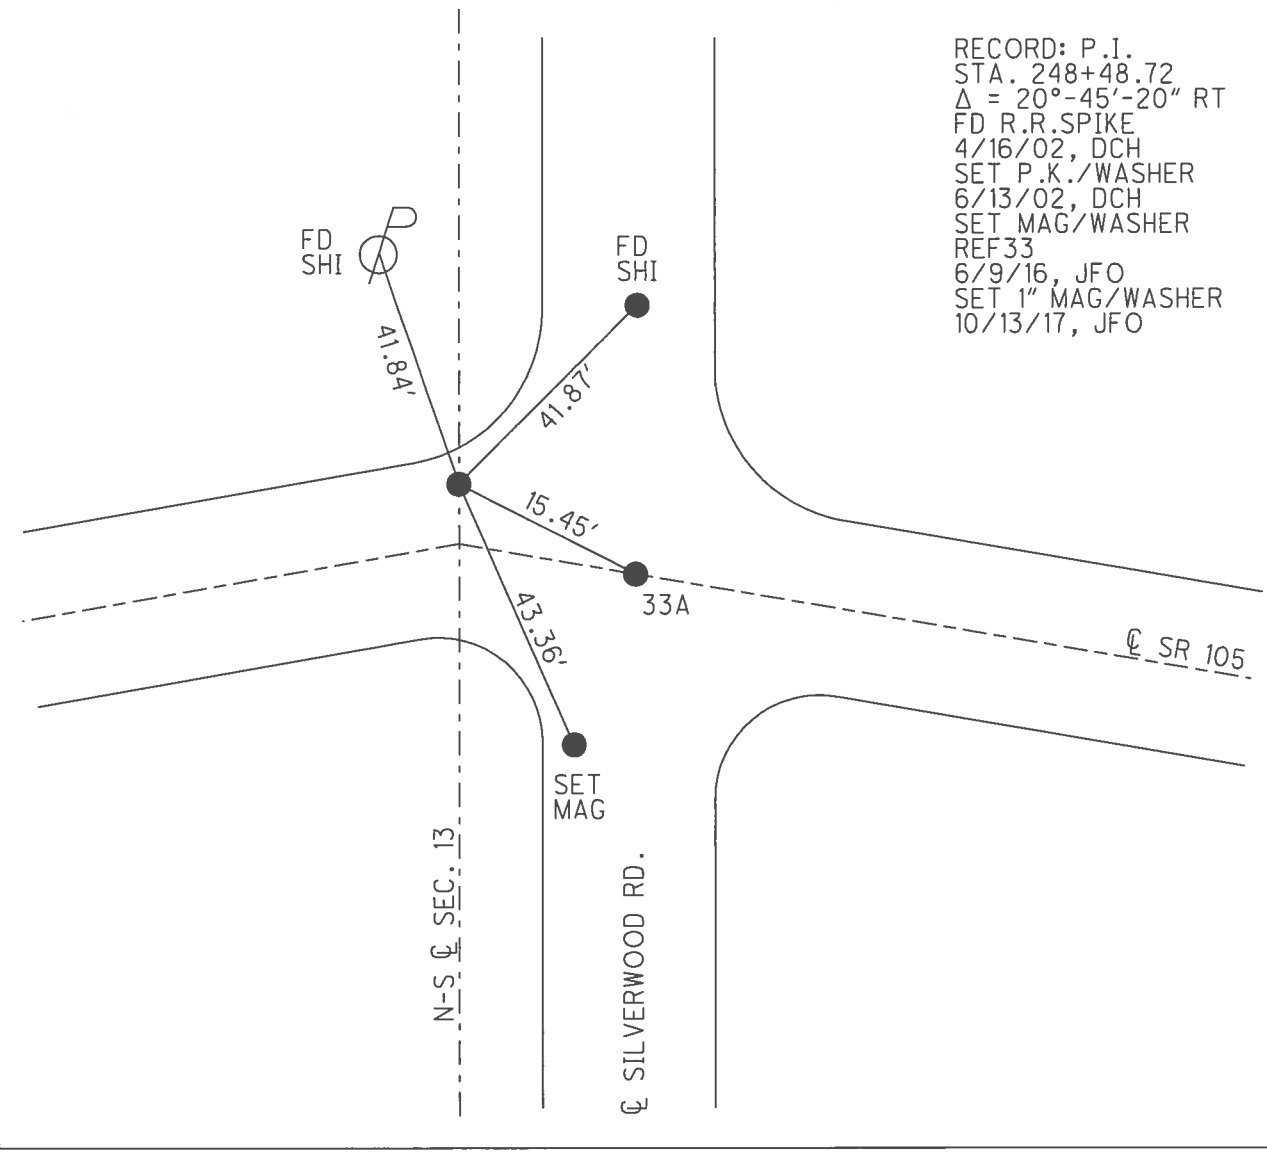


RECORD: P.I.  
 STA. 248+48.72  
 $\Delta = 20^\circ - 45' - 20''$  RT  
 FD R.R. SPIKE  
 4/16/02, DCH  
 SET P.K./WASHER  
 6/13/02, DCH  
 SET MAG/WASHER  
 REF33  
 6/9/16, JFO  
 SET 1" MAG/WASHER  
 10/13/17, JFO

O.D.O.T. DISTRICT 2 SURVEY OFFICE (USE ONLY)


PERSONNEL \_\_\_\_\_ REFERENCE NO. 33 SHEET 31 OF 54  
 NOTES ROUSOS DATE 4/16/02 ROUTE SR 105  
 H.C. HOMAN WEATHER CLEAR COUNTY WOOD  
 R.C. ROUSOS TEMP. 65° TOWNSHIP WEBSTER  
 SECTION 13  
T 5 N R 11 E

TYPE MONUMENT R.R. SPIKE  
 ON SURFACE - ~~BELOW~~ ON \_\_\_\_\_  
 LEFT - ☉ PAV'T - ~~RIGHT~~ 9'  
2' TO LT EDGE PAVEMENT  
 S.L.M. 247+33

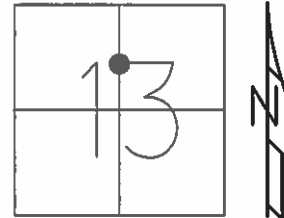

GRID: NORTHING: \_\_\_\_\_ EASTING: \_\_\_\_\_

RECORD: P.I.  
 STA. 248+48.72  
 $\Delta = 20^\circ - 45' - 20''$  RT  
 SET P.K./WASHER  
 6/13/02, DCH

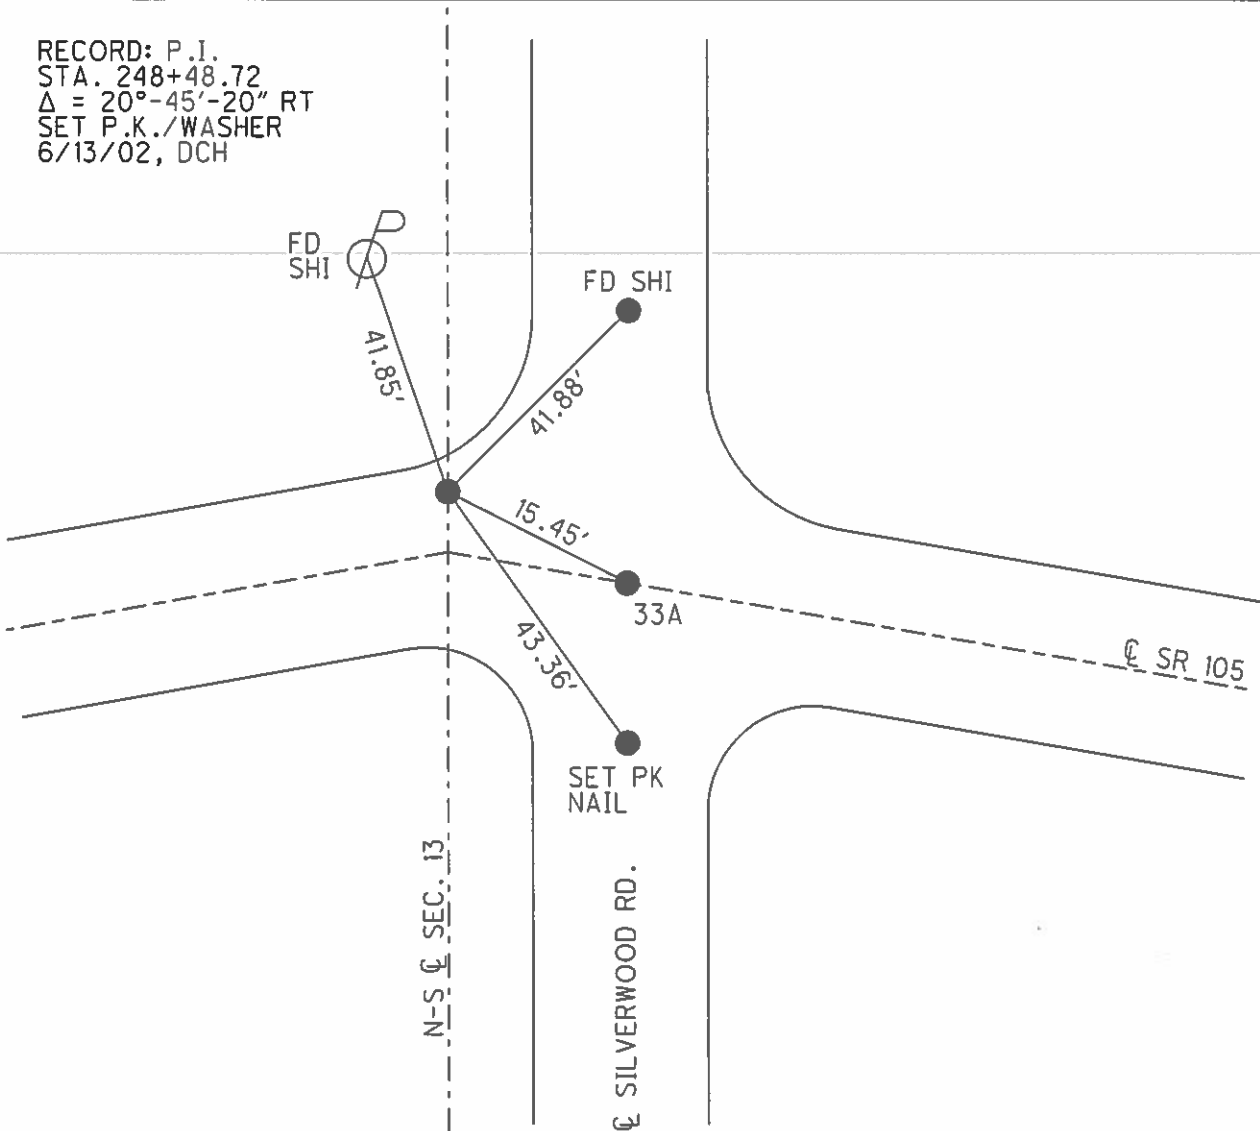

# O.D.O.T. DISTRICT 2 SURVEY OFFICE

PERSONNEL \_\_\_\_\_

REFERENCE NO. 33

SHEET 43 OF 57

NOTES LONG

H.C. VANDUSEN

DATE 8-26-91

ROUTE 105

R.C. BARNHISEL

WEATHER SUNNY

COUNTY WOOD

TEMP. 90°

TOWNSHIP WEBSTER

SECTION 13

T.5 N R.11 E


TYPE MONUMENT P.K. / WASHER

ON SURFACE - ~~BELOW~~ YES

LEFT - CL. PAV'T. - ~~RIGHT~~ 9.0'


2.0' TO LT. EDGE PAVEMENT

S.L.M. 247+33

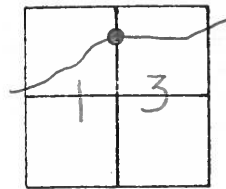

SET PK & WASHER  
 4-9-92  
 BVD

RECORD  
 P.I. #30  
 248+48.72  
 $\Delta = 20^\circ - 45' - 20''$  RT.

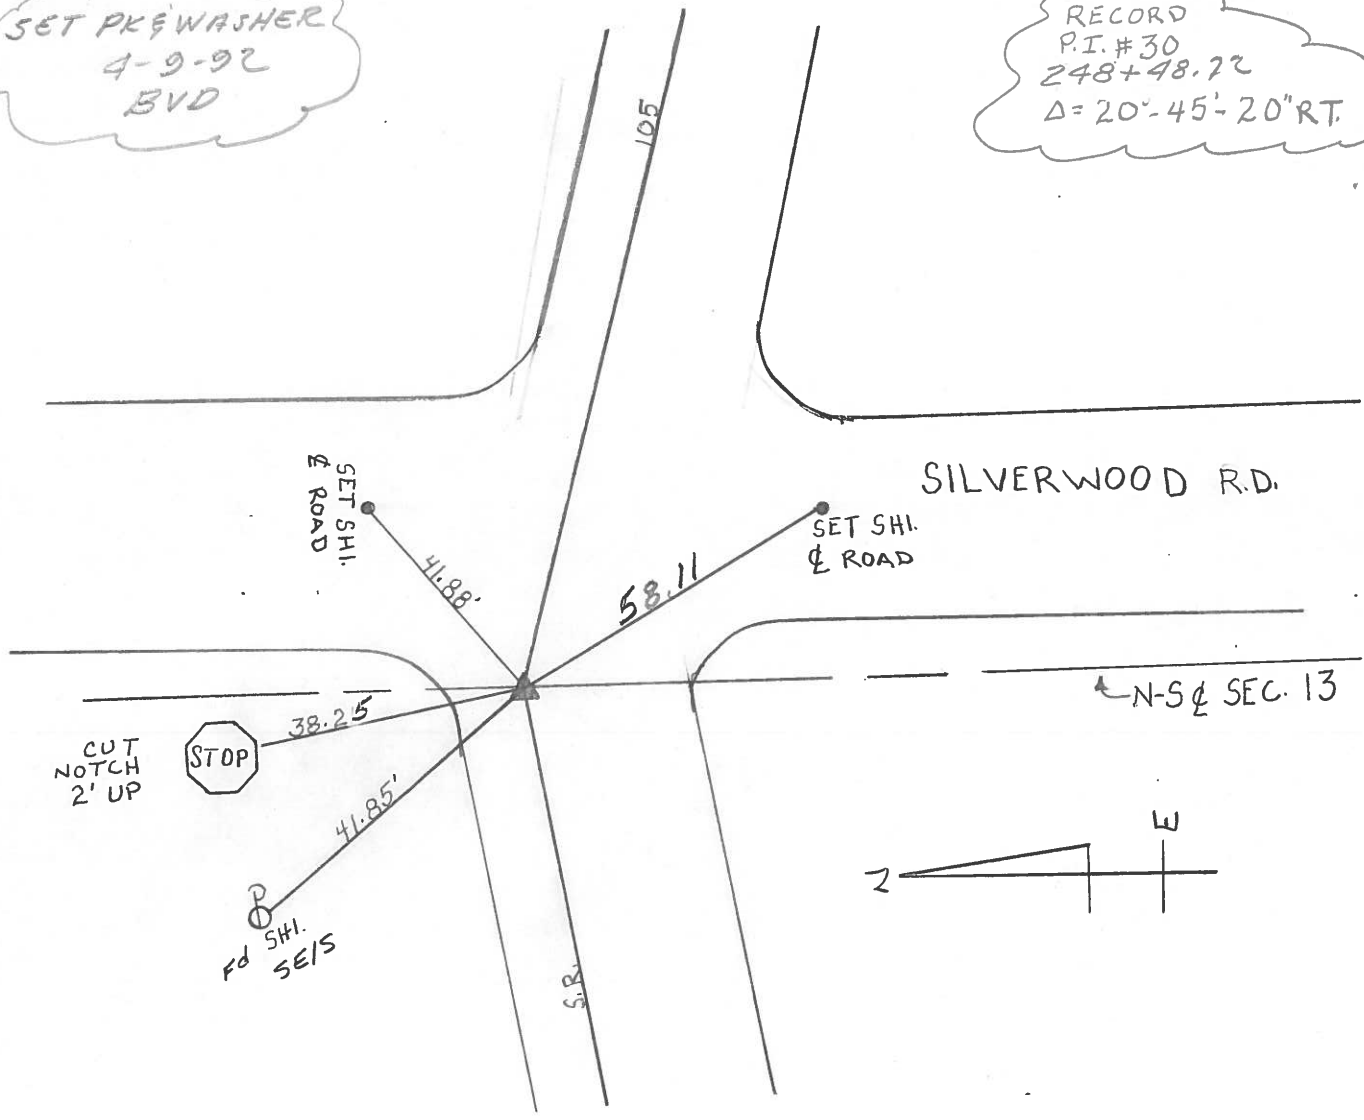

County WOOD S.R. 105

Date 4-21-82

Township WEBSTER


Weather CLEAR

Section 13

Temp. +45°

T N, R E

Personnel HOFFMAN

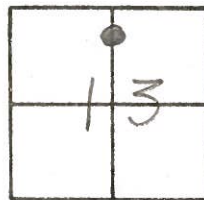

#33


HOUSEHOLDER  
LOEHRKE

P.I. #30

248+48.72

$\Delta = 20^{\circ}-45'-20''$  RT.

SET P.K./WASHER  
5-27-82 S.W.H.

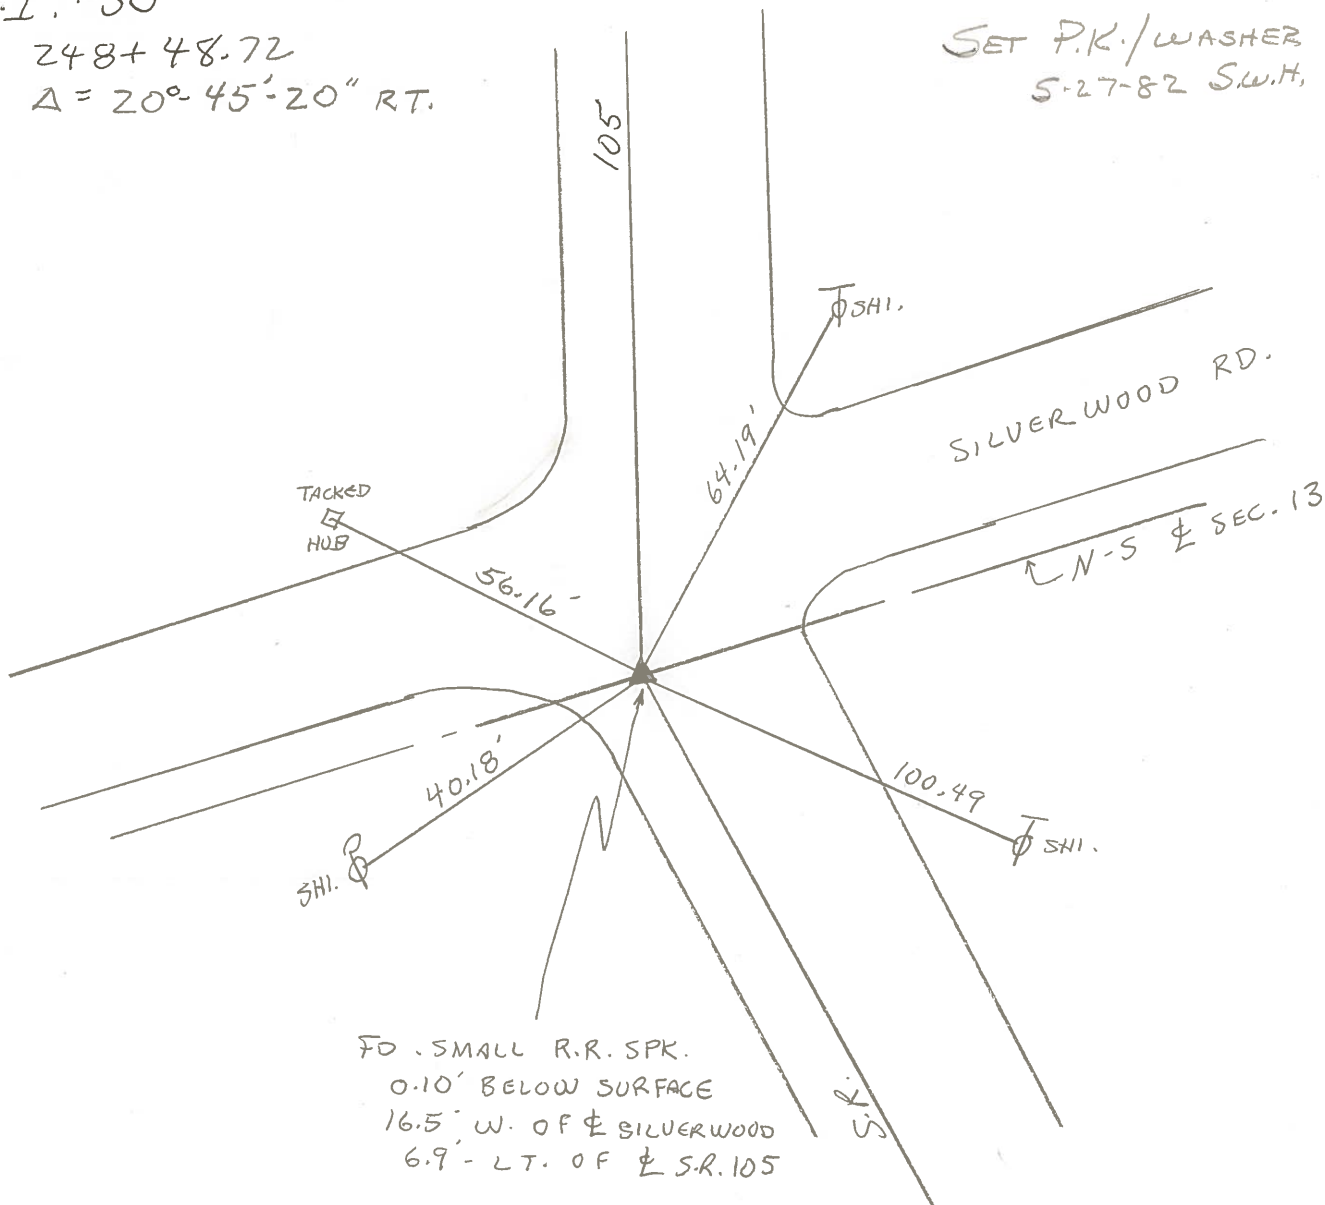

PERSONNEL	TITLE	PERSONNEL	TITLE	COUNTY	DATE	WEATHER	TEMP.
Stone		Brogan		Wood	16 July 73	Fair	75°
Michalak				#105			
Denno				Webster Twp			
Curtis							

DESCRIPTION References to Control Points JOB NO. \_\_\_\_\_  
 LEFT CENTER LINE RIGHT

