



O.D.O.T. DISTRICT 2 SURVEY OFFICE (USE ONLY)

PERSONNEL _____ REFERENCE NO. 33 A SHEET 32 OF 54
 NOTES RHOADES DATE 10/13/17 ROUTE SR 105
 H.C. O'DONNELL WEATHER HAZE COUNTY WOOD
 R.C. FARKAS TEMP. 59° TOWNSHIP WEBSTER
 SECTION 13
 T 5 N R 11 E

TYPE MONUMENT 1" MAG/WASHER
 ON SURFACE - ~~BELOW~~ ON _____
 LEFT - ☉ PAV'T - ~~RIGHT~~ 4.5'
 - TO - EDGE PAVEMENT
 S.L.M. 247+48

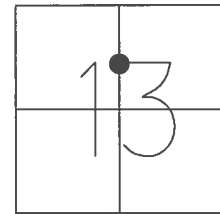

GRID: NORTHING: 631857.190 EASTING: 1682488.342

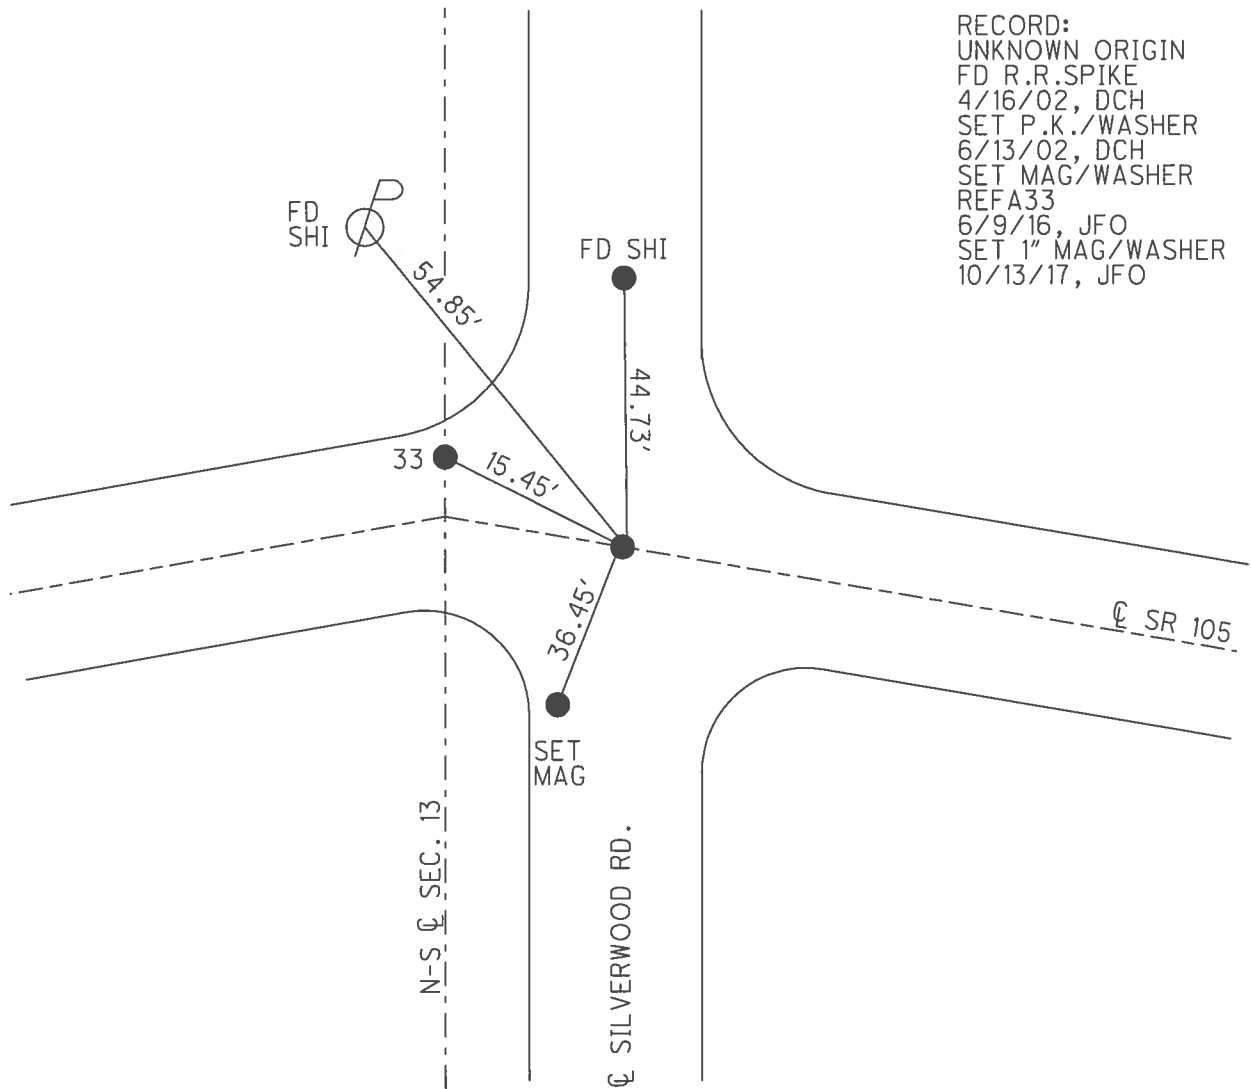


RECORD:
 UNKNOWN ORIGIN
 FD R.R. SPIKE
 4/16/02, DCH
 SET P.K./WASHER
 6/13/02, DCH
 SET MAG/WASHER
 REFA33
 6/9/16, JFO
 SET 1" MAG/WASHER
 10/13/17, JFO

O.D.O.T. DISTRICT 2 SURVEY OFFICE (USE ONLY)

PERSONNEL _____ REFERENCE NO. 33 A SHEET 32 OF 54
 NOTES ROUSOS DATE 4/16/02 ROUTE SR 105
 H.C. HOMAN WEATHER CLEAR COUNTY WOOD
 R.C. ROUSOS TEMP. 65° TOWNSHIP WEBSTER
 SECTION 13
 T 5 N R 11 E

TYPE MONUMENT R.R. SPIKE
 ON SURFACE - ~~BELOW~~ ON _____
 LEFT - ☉ PAV'T - ~~RIGHT~~ - _____
 - TO - EDGE PAVEMENT
 S.L.M. 247+48

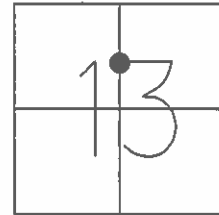

GRID: NORTHING: _____ EASTING: _____

RECORD:
 UNKNOWN ORIGIN
 SET P.K./WASHER
 6/13/02, DCH

