


O.D.O.T. DISTRICT 2 SURVEY OFFICE (USE ONLY)


PERSONNEL _____ REFERENCE NO. 35 SHEET 34 OF 54
 NOTES RHOADES DATE 10/17/17 ROUTE SR 105
 H.C. O'DONNELL WEATHER FAIR COUNTY WOOD
 R.C. FARKAS TEMP. 65° TOWNSHIP WEBSTER
 _____ SECTION 13
 _____ T 5 N R 11 E

TYPE MONUMENT 1" MAG/WASHER
 ON SURFACE - ~~BELOW~~ ON
~~LEFT~~ - CL PAV'T - RIGHT 1.9'
8.6' TO S EDGE PAVEMENT
 S.L.M. 252+53

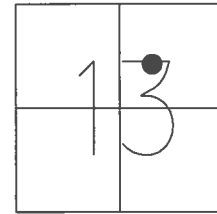

GRID: NORTHING: 631789.494 EASTING: 1682985.819


RECORD: P.I.
 STA. 253+68.69
 $\Delta = 3^{\circ}-10'-20''$ LT
 FD P.K./WASHER
 4/15/02, DCH
 SET P.K./WASHER
 6/13/02, DCH
 FD P.K.SHANK
 SET MAG/WASHER
 REF35
 6/9/16, JFO
 SET 1" MAG/WASHER
 10/17/17, JFO

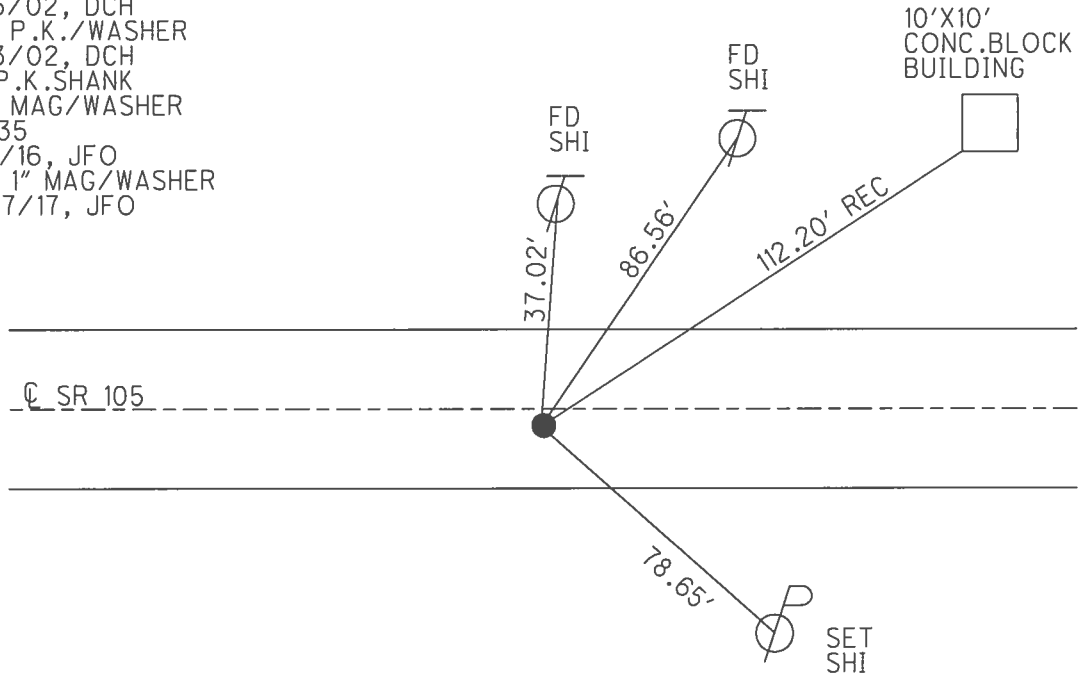

O.D.O.T. DISTRICT 2 SURVEY OFFICE (USE ONLY)


PERSONNEL _____ REFERENCE NO. 35 SHEET 34 OF 54
 NOTES ROUSOS DATE 4/15/02 ROUTE SR 105
 H.C. HOMAN WEATHER PT SUNNY COUNTY WOOD
 R.C. BROWN TEMP. 60° TOWNSHIP WEBSTER
 SECTION 13
T 5 N R 11 E

TYPE MONUMENT P.K./WASHER
 ON SURFACE - ~~BELOW~~ ON _____
~~LEFT~~ - ☉ PAV'T - RIGHT 1.9'
8.6' TO S EDGE PAVEMENT
 S.L.M. 252+53

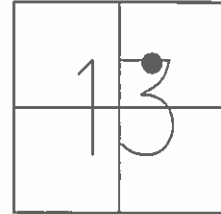

GRID: NORTHING: _____ EASTING: _____

RECORD: P.I.
 STA. 253+68.69
 $\Delta = 3^{\circ}-10'-20''$ LT
 SET P.K./WASHER
 6/13/02, DCH

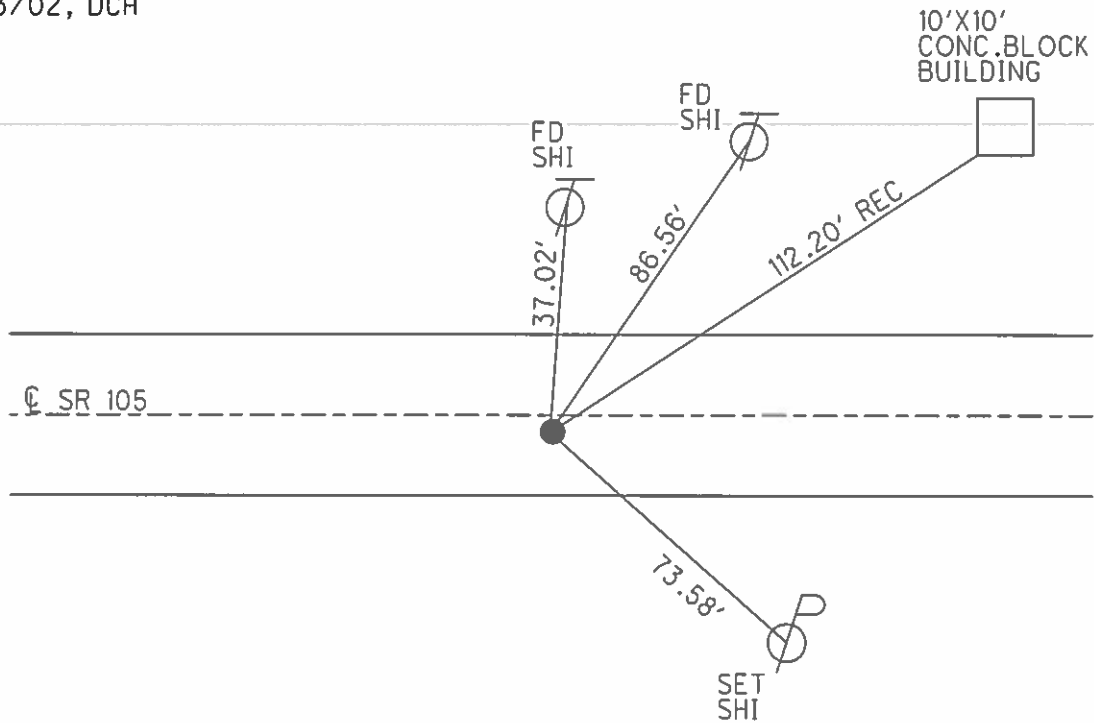

O.D.O.T. DISTRICT 2 SURVEY OFFICE

PERSONNEL _____

REFERENCE NO. 35

SHEET 45 OF 57

NOTES LONG

H.C. VANDUSEN

R.C. BARNHISEL

DATE 8-26-91

WEATHER SUNNY

TEMP. 92°

ROUTE 105

COUNTY WOOD

TOWNSHIP WEBSTER

SECTION 13

T 5 N R H E



TYPE MONUMENT P.K. / WASHER

ON SURFACE - ~~BELOW~~ YES

~~LEFT~~ - PAV'T. - RIGHT 1.9'

8.6' TO S EDGE PAVEMENT

S.L.M. 252+53

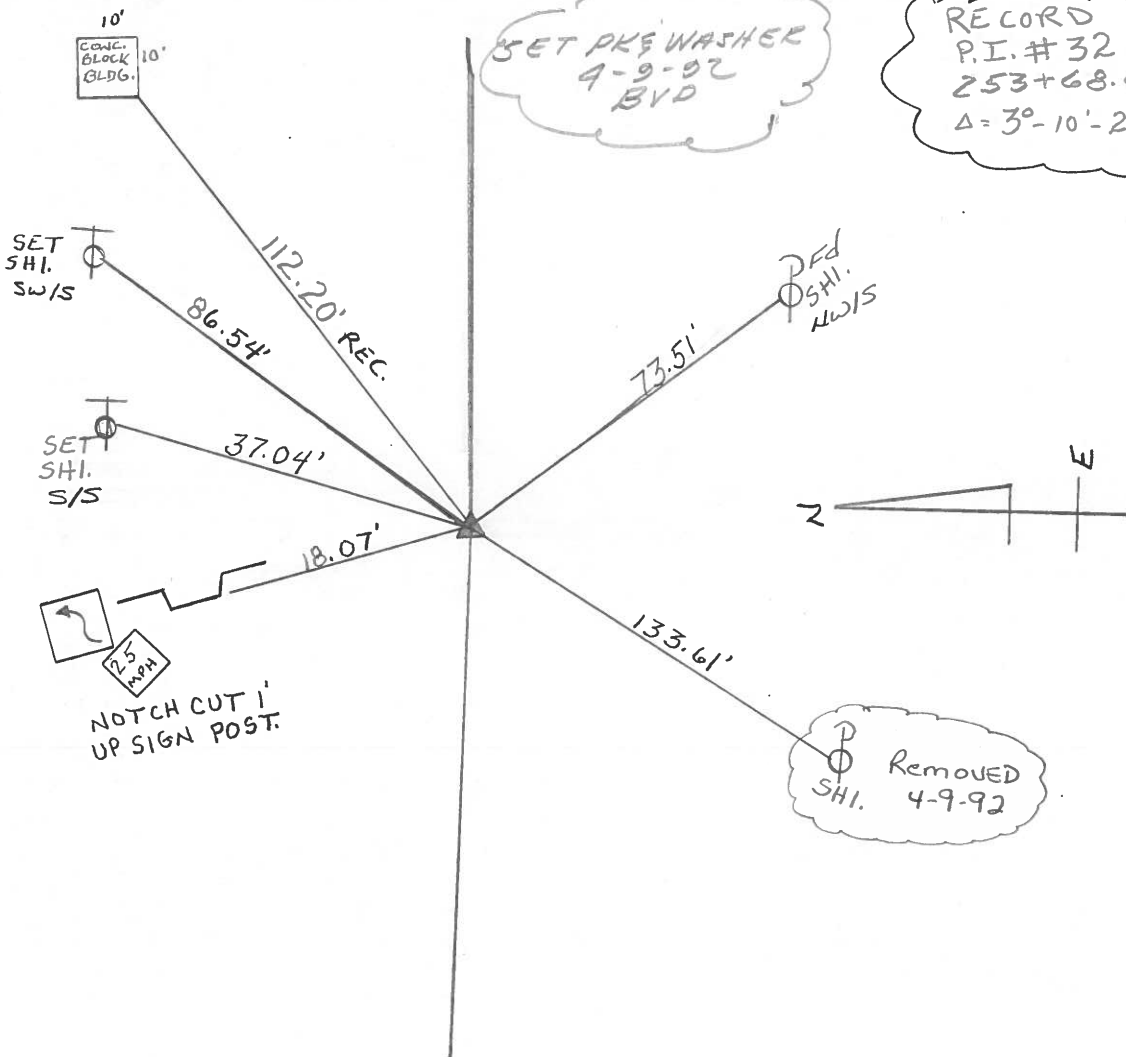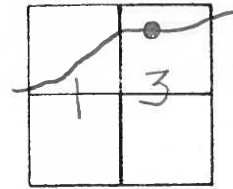

RECORD
P.I. #32
253+68.69
Δ = 3°-10'-20" LT.

County Wood S.R. 105

Date 4-21-82

Township WEBSTER

Weather CLEAR - WINDY

Section 13

Temp. +45°


T N, R E

Personnel HOFFMAN

HOUSEHOLDER

LOEHRKE

35

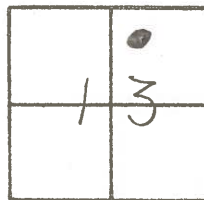


P.I. #32

253+68.69

$\Delta = 3^{\circ} - 10' - 20''$ LT.

SET P.K./WASHER
5-27-82 SWH

TOP OF 2nd
CONC. BLOCK
FROM BOTTOM
N.W. COR.

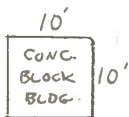

112.20'

28.11'

18.11'

73.53'



FD. BOAT SPIK. @ SURFACE
11.4' - TO N. EDGE
8.5' - TO S. EDGE
1.4' - RT. OF \perp



NOTCH CUT 1' UP
SIGN POST.

133.61'



PERSONNEL	TITLE	PERSONNEL	TITLE	COUNTY	DATE	WEATHER	TEMP.
Stone		Brannan		Wood	16 July 73	Fair	75°
Michalak				S. R. #105			
Deane				SEC. Webster Top.			
Curtis							

DESCRIPTION References to Control Points JOB NO. _____

