


O.D.O.T. DISTRICT 2 SURVEY OFFICE (USE ONLY)


PERSONNEL _____ REFERENCE NO. 36 SHEET 36 OF 54
 NOTES RHOADES DATE 10/17/17 ROUTE SR 105
 H.C. O'DONNELL WEATHER FAIR COUNTY WOOD
 R.C. FARKAS TEMP. 65° TOWNSHIP WEBSTER
 _____ SECTION 13
 _____ T 5 N R 11 E

TYPE MONUMENT 1" MAG/WASHER
 ON SURFACE - ~~BELOW~~ ON
~~LEFT~~ - Q PAV'T - RIGHT 6'
4.4' TO S EDGE PAVEMENT
 S.L.M. 257+40

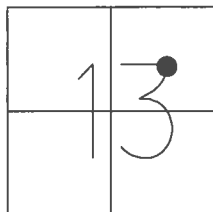

GRID: NORTHING: 631791.292 EASTING: 1683474.259


RECORD: P.I.
 STA. 258+57.05
 $\Delta = 8^{\circ}-30'-20''$ LT
 FD P.K./WASHER
 4/15/02, DCH
 SET P.K./WASHER
 5/31/02, DCH
 SET MAG/WASHER
 REF36
 6/10/16, JFO
 SET 1" MAG/WASHER
 10/17/17, JFO

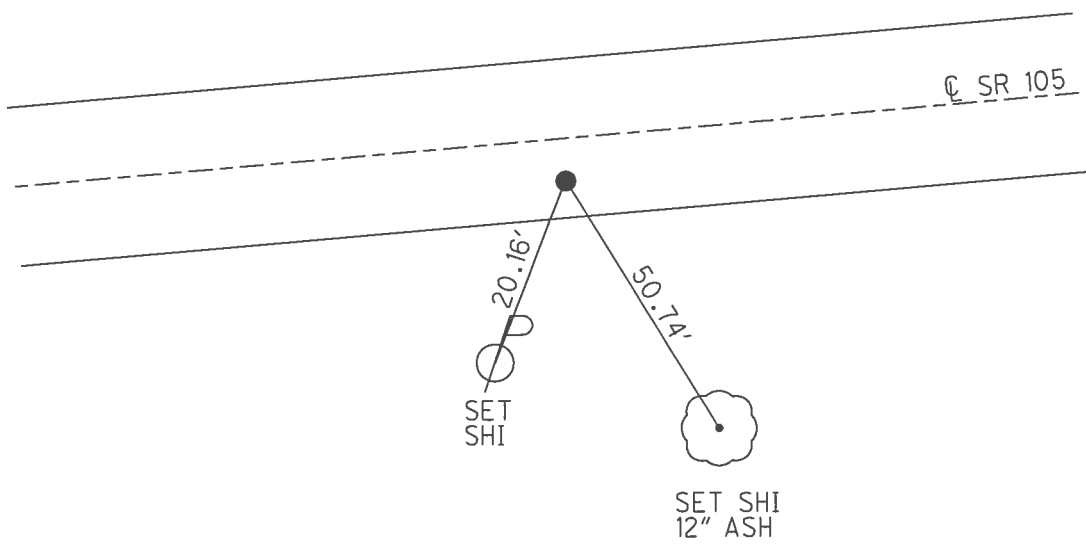

O.D.O.T. DISTRICT 2 SURVEY OFFICE (USE ONLY)


PERSONNEL _____ REFERENCE NO. 36 SHEET 36 OF 54
 NOTES ROUSOS DATE 4/15/02 ROUTE SR 105
 H.C. HOMAN WEATHER PT SUNNY COUNTY WOOD
 R.C. BROWN TEMP. 60° TOWNSHIP WEBSTER
 SECTION 13
T 5 N R 11 E

TYPE MONUMENT P.K./WASHER
 ON SURFACE - ~~BELOW~~ ON _____
~~LEFT~~ - Q PAV'T - RIGHT 6'
4.4' TO S EDGE PAVEMENT
 S.L.M. 257+40

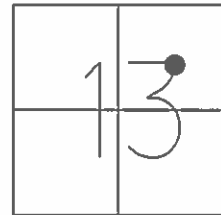

GRID: NORTHING: _____ EASTING: _____

RECORD: P.I.
 STA. 258+57.05
 $\Delta = 8^{\circ}-30'-20''$ LT
 SET P.K./WASHER
 5/31/02, DCH

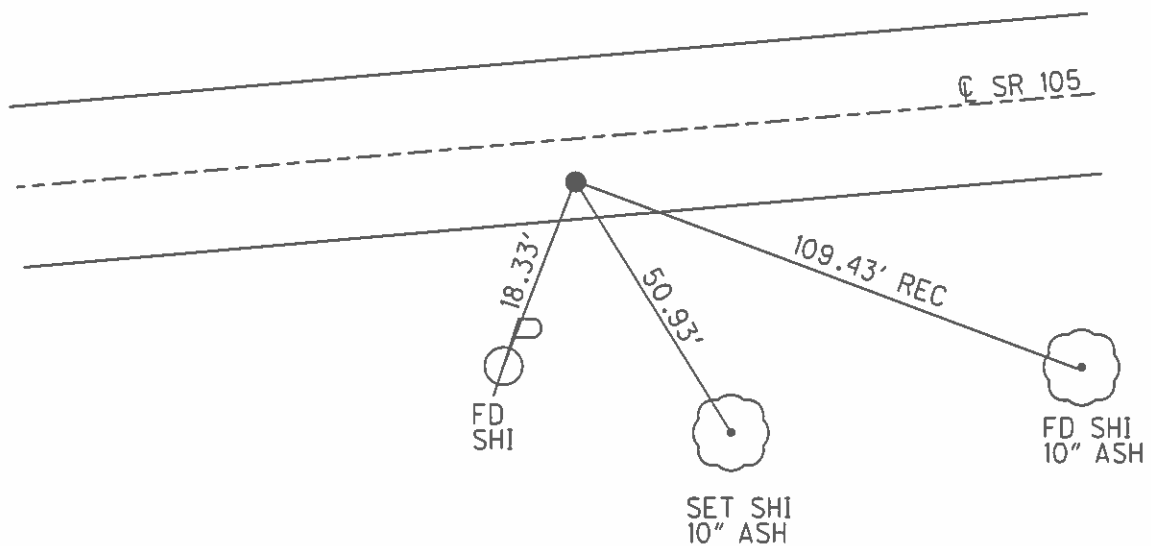

O.D.O.T. DISTRICT 2 SURVEY OFFICE

PERSONNEL _____

REFERENCE NO. 36

SHEET 47 OF 57

NOTES LONG

H.C. VANDUSEN

R.C. BARWISSEL

DATE 8-26-91

WEATHER SUNNY & HOT

TEMP. 95°

ROUTE 105

COUNTY WOOD

TOWNSHIP WEBSTER

SECTION 13

T5 N R 11 E


TYPE MONUMENT P.K. WASHER

ON SURFACE - BELOW YES

~~LEFT~~ - 6 PAV'T. - RIGHT 60'


4.4' TO 5 EDGE PAVEMENT

S.L.M. 257+40

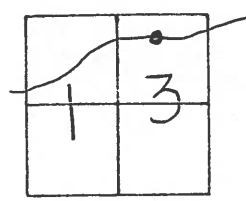

SET PK & WASHER
11-26-91
BVD

RECORD
P.I. #33
258+57.05
 $\Delta = 8^\circ - 30' - 20''$ LT.

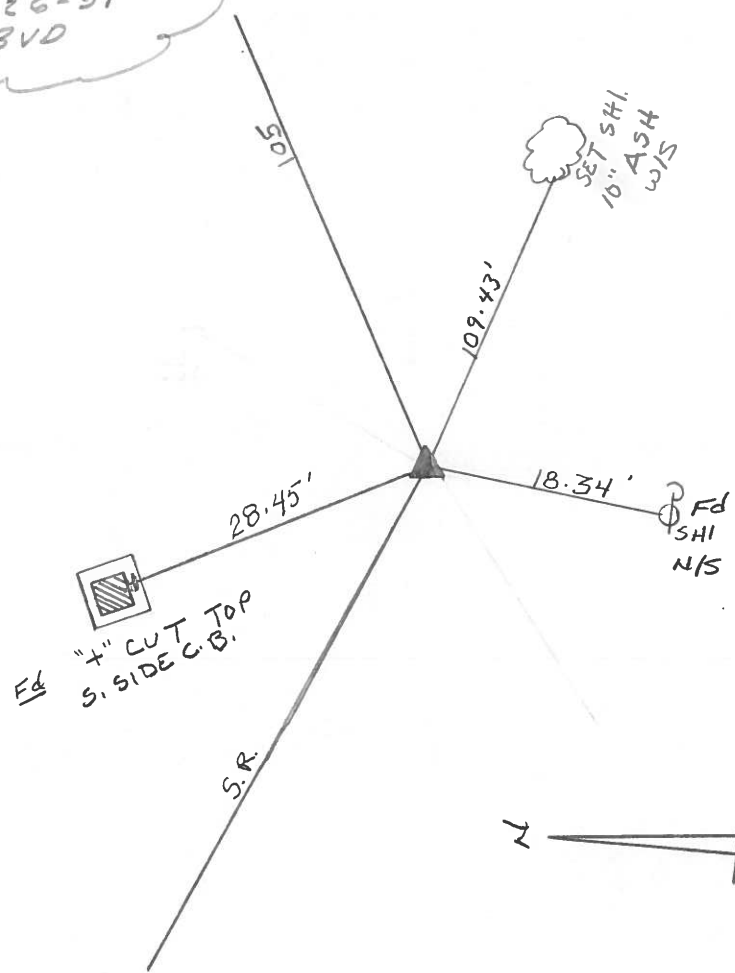

County WOOD S.R. 105

Township WEBSTER

Section 13

T, N, R, E

Personnel HOFFMAN

HOUSEHOLDER


LOEHRKE

#36

Date 4-21-82

Weather CLEAR

Temp. +45°

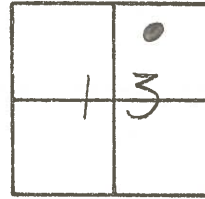


P.I. #33

258+57.05

$\Delta = 8^{\circ} - 30' - 20''$ LT.

SET P.K./WASHER
5-27-82 S.W.H.

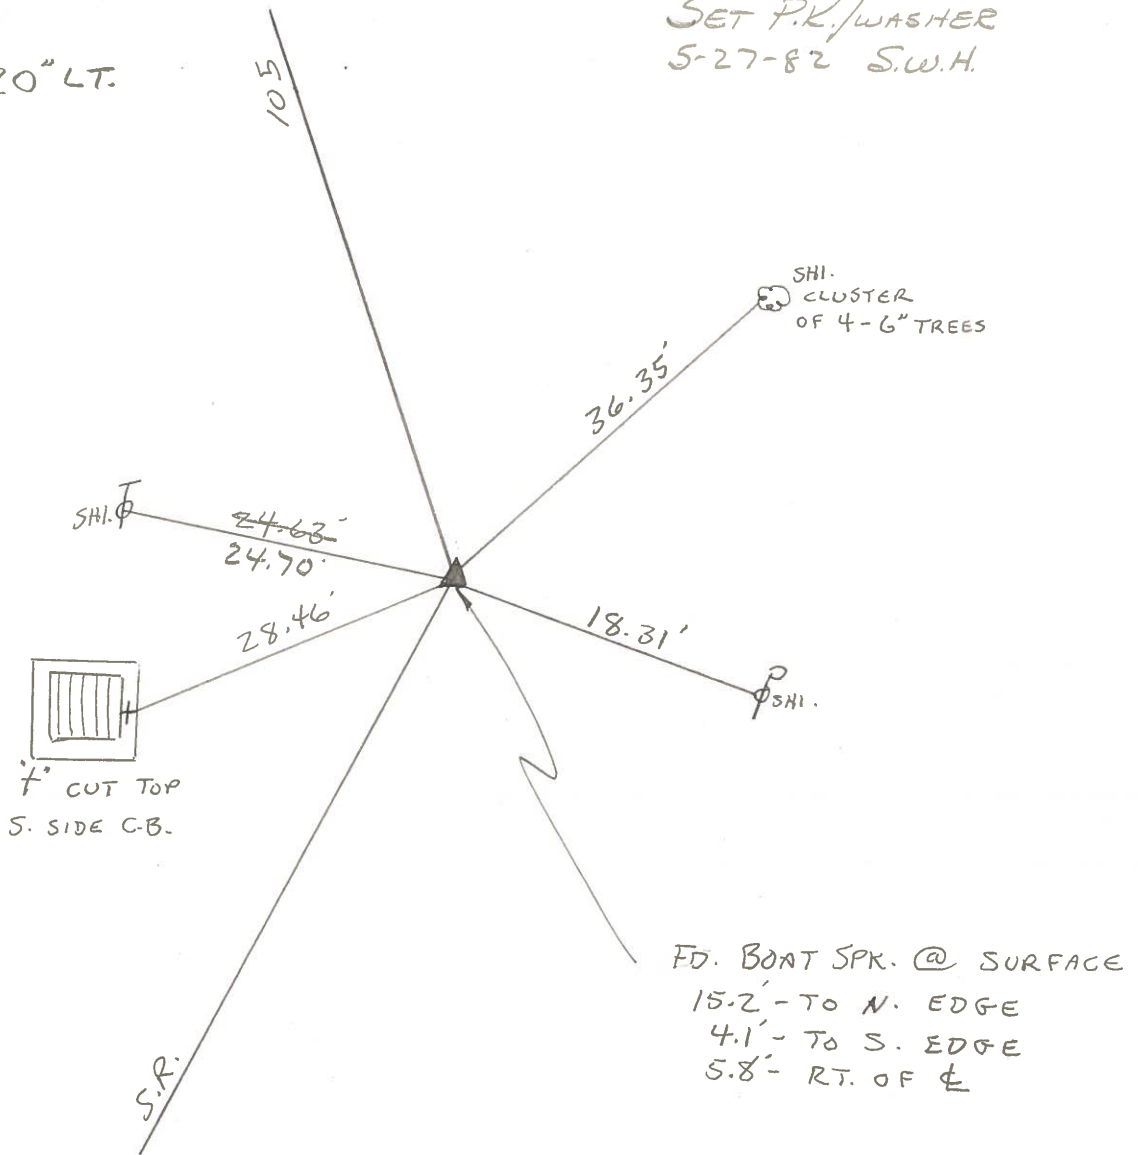

FD. BOAT SPR. @ SURFACE
15.2' - TO N. EDGE
4.1' - TO S. EDGE
5.8' - RT. OF ϕ

PERSONNEL	TITLE	PERSONNEL	TITLE	COUNTY	DATE
Stone		Brennan		Wood	16 July 73
Michalak				S. R. #105	WEATHER Fair
Deane				SEC. Webster Top.	TEMP. 75°
Curtis					

DESCRIPTION References to Control Points JOB NO. _____

