


O.D.O.T. DISTRICT 2 SURVEY OFFICE (USE ONLY)


PERSONNEL _____ REFERENCE NO. 39 SHEET 40 OF 54
 NOTES RHOADES DATE 9/13/16 ROUTE SR 105
 H.C. O'DONNELL WEATHER FAIR COUNTY WOOD
 R.C. TODD TEMP. 58° TOWNSHIP WEBSTER
 _____ SECTION 13
 _____ T 5 N R 11 E

TYPE MONUMENT P.K.NAIL
 ON SURFACE - ~~BELOW~~ ON _____
~~LEFT~~ - CL PAV'T - RIGHT 2'
8.5' TO RT EDGE PAVEMENT
 S.L.M. 274+02

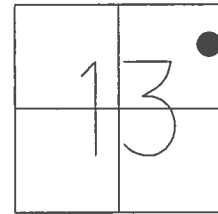

GRID: NORTHING: 632274.062 EASTING: 1685037.757


RECORD:
 ORIGIN UNKNOWN
 FD P.K.NAIL
 SET P.K./WASHER
 6/13/02, DCH
 SET MAG/WASHER
 REFB39
 6/10/16, JFO
 SET 1" MAG/WASHER
 10/17/17, JFO

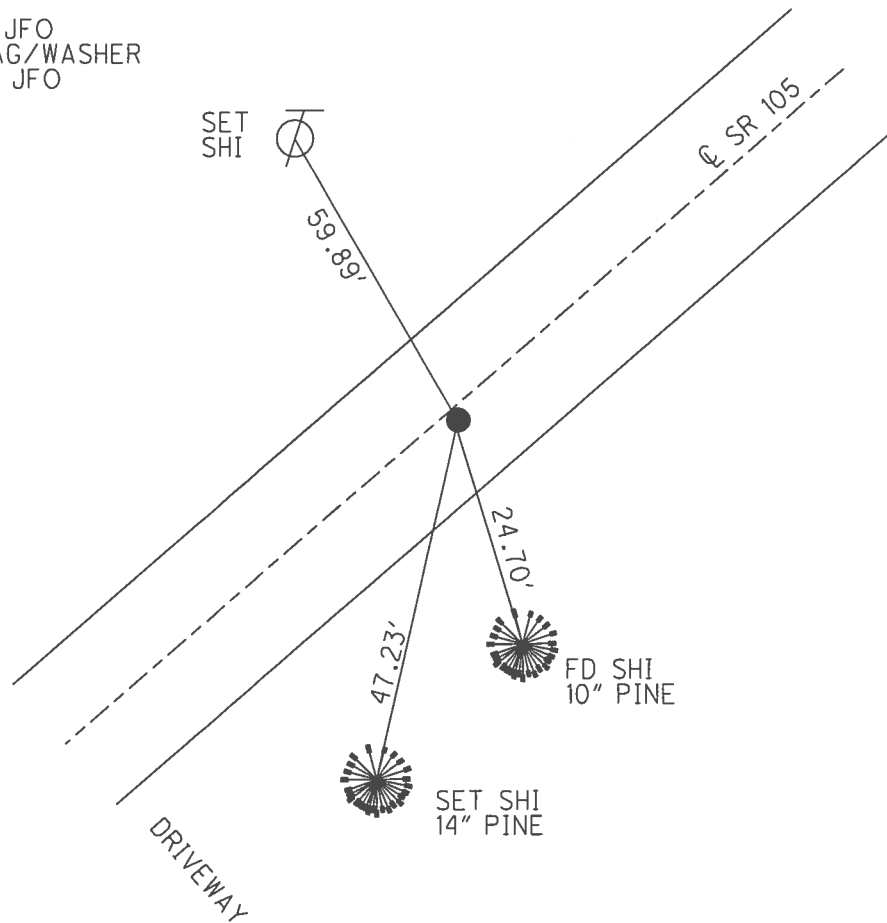

O.D.O.T. DISTRICT 2 SURVEY OFFICE (USE ONLY)


PERSONNEL _____ REFERENCE NO. 39 SHEET 40 OF 54
 NOTES ROUSOS DATE 4/15/02 ROUTE SR 105
 H.C. HOMAN WEATHER PT SUNNY COUNTY WOOD
 R.C. BROWN TEMP. 60° TOWNSHIP WEBSTER
 SECTION 13
 T 5 N R 11 E

TYPE MONUMENT P.K.NAIL
 ON SURFACE - ~~BELOW~~ ON _____
~~LEFT~~ - Q PAV'T - RIGHT 2'
8.5' TO RT EDGE PAVEMENT
 S.L.M. 274+02

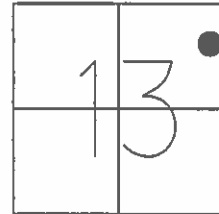

GRID: NORTHING: _____ EASTING: _____

RECORD:
 ORIGIN UNKNOWN
 SET P.K./WASHER
 6/13/02, DCH

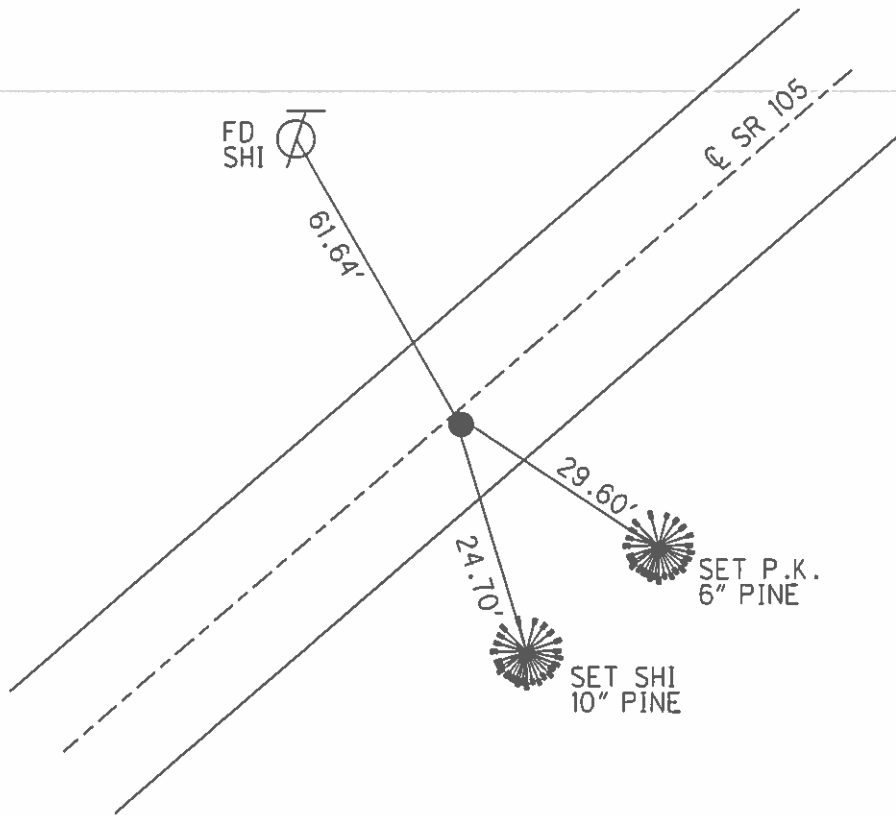

O.D.O.T. DISTRICT 2 SURVEY OFFICE

PERSONNEL

REFERENCE NO. 39-40

SHEET 50 OF 57

NOTES LONG

H.C. VANDUSEN

R.C. BARNHISEL

DATE 8-27-91

WEATHER SUNNY

TEMP. 85°

ROUTE 105

COUNTY WOOD

TOWNSHIP WEBSTER

SECTION 13

T 5 N R 11 E


TYPE MONUMENT P.K./WASHER "A", "B" & "C"

ON SURFACE - ~~BELOW~~ YES

~~LEFT~~ - PAV'T. - RIGHT 1./

9.0 TO RT. EDGE PAVEMENT

S.L.M. 275+37

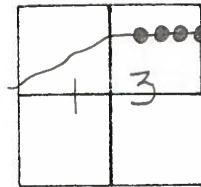


PT "D"
ORIGIN UNKNOWN
2.0 RT of \mathcal{E}
8.5 TO RT Edge
Fd P.K. Nail

PT "C" P.O.T.
0.6 RT of \mathcal{E}
9.4 TO RT Edge
Record: 277+95.78

PT "B" P.O.T.
1.1 RT of \mathcal{E}
9.0 TO RT Edge
Record: 276+70.80

PT "A" P.O.T. SHI.
1.1 RT of \mathcal{E}
9.0 TO RT Edge
Record: 276+56.63

A = 39A
B = 39B
C = 40
D = 39

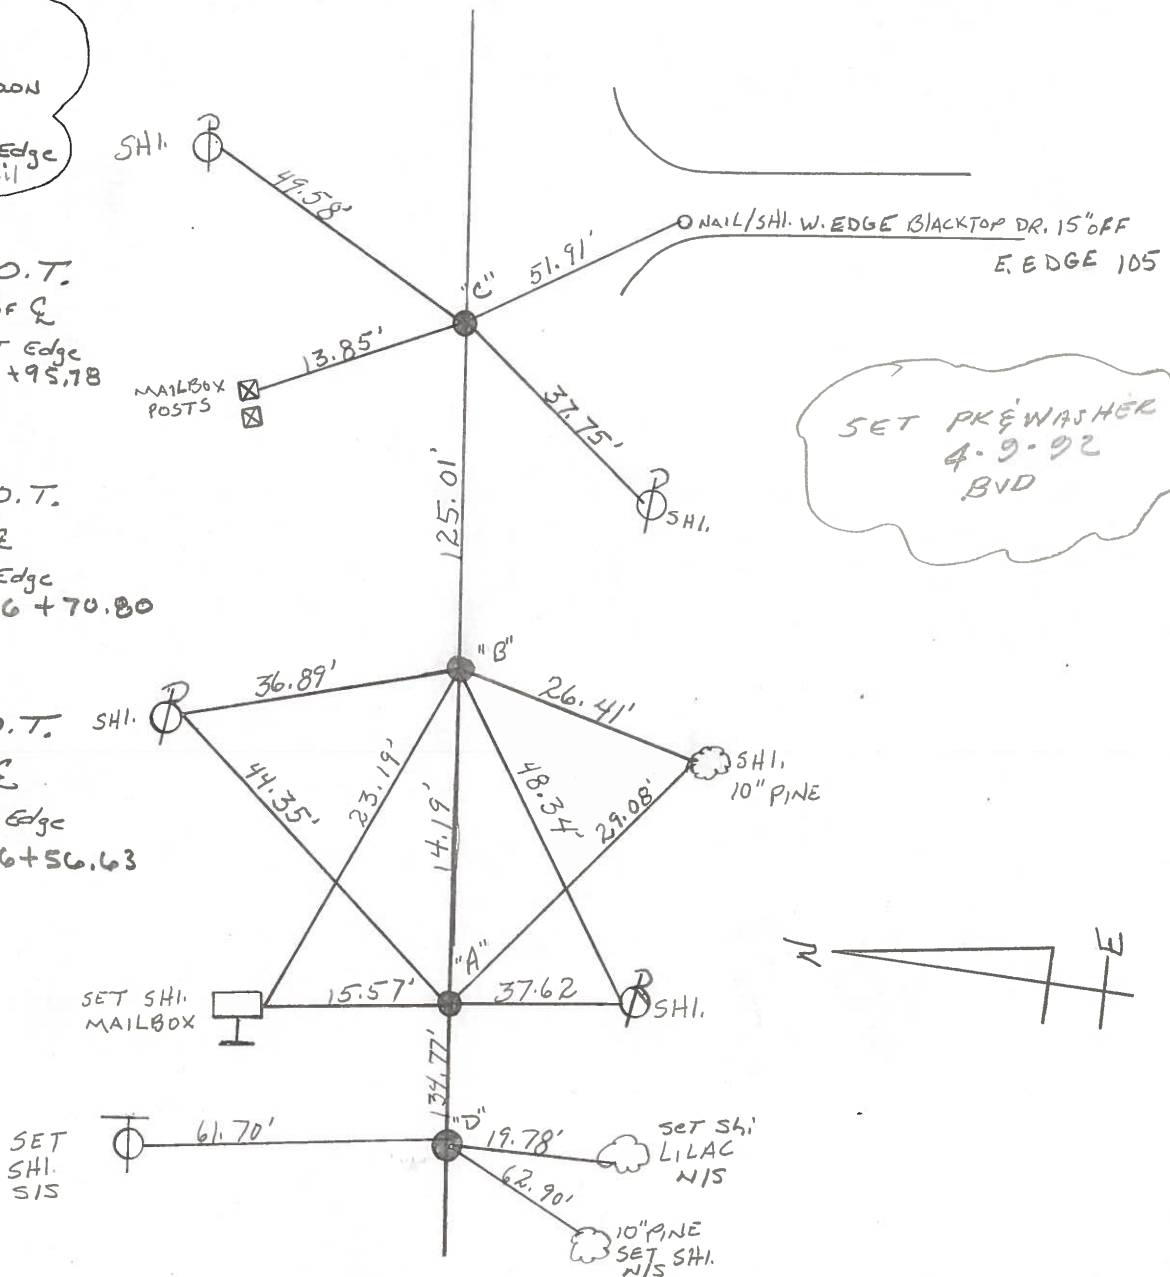

PERSONNEL	TITLE	PERSONNEL	TITLE	COUNTY	DATE
Stone	STAG	Brennan		Wood	16 July 73
Michalak				#105	WEATHER Mild
Danno				SEC. Webster Twp.	TEMP. 78°
Curtis					

DESCRIPTION References to Control Points JOB NO. _____

