


O.D.O.T. DISTRICT 2 SURVEY OFFICE (USE ONLY)


PERSONNEL _____ REFERENCE NO. 39 A SHEET 41 OF 54
 NOTES RHOADES DATE 9/13/16 ROUTE SR 105
 H.C. O'DONNELL WEATHER FAIR COUNTY WOOD
 R.C. TODD TEMP. 58° TOWNSHIP WEBSTER
 SECTION 13
T 5 N R 11 E

TYPE MONUMENT P.K.NAIL
 ON SURFACE - ~~BELOW~~ ON _____
~~LEFT~~ - C PAV'T - RIGHT 1.1'
9' TO RT EDGE PAVEMENT
 S.L.M. 275+37

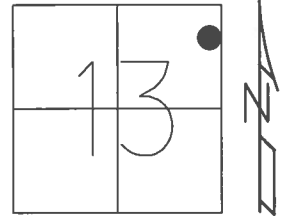

GRID: NORTHING: 632359.733 EASTING: 1685141.750


RECORD: P.O.T.
 STA. 276+56.63
 FD P.K./WASHER
 4/15/02, DCH
 SET P.K./WASHER
 6/13/02, DCH
 FD P.K.NAIL
 REF39
 6/10/16, JFO
 SET 1" MAG/WASHER
 10/17/17, JFO

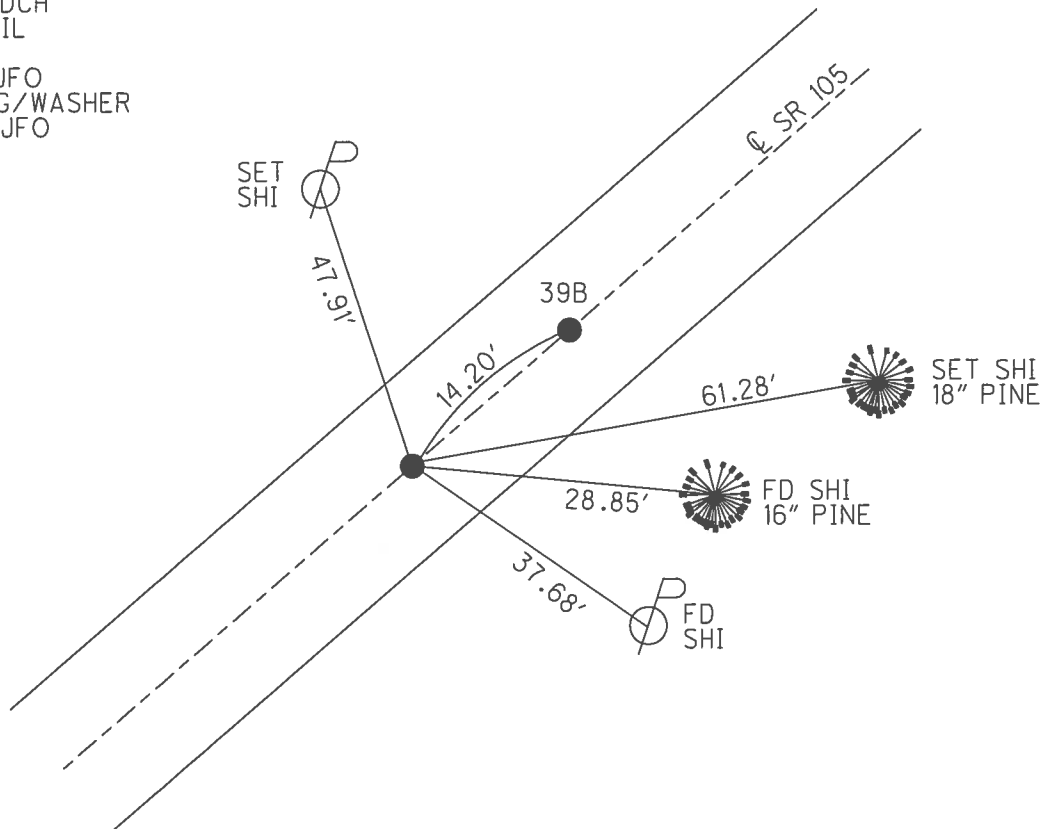

O.D.O.T. DISTRICT 2 SURVEY OFFICE (USE ONLY)


PERSONNEL	REFERENCE NO.	39 A	SHEET	41	OF	54
NOTES	ROUSOS	DATE	4/15/02	ROUTE	SR 105	
H.C.	HOMAN	WEATHER	PT SUNNY	COUNTY	WOOD	
R.C.	BROWN	TEMP.	60°	TOWNSHIP	WEBSTER	
				SECTION	13	
				T	5	N
				R	11	E

TYPE MONUMENT P.K./WASHER
 ON SURFACE - ~~BELOW~~ ON
~~LEFT~~ - Q PAV'T - RIGHT 1.1'
9' TO RT EDGE PAVEMENT
 S.L.M. 275+37

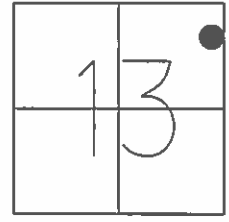

GRID: NORTHING: _____ EASTING: _____

RECORD: P.O.T.
 STA. 276+56.63
 SET P.K./WASHER
 6/13/02, DCH

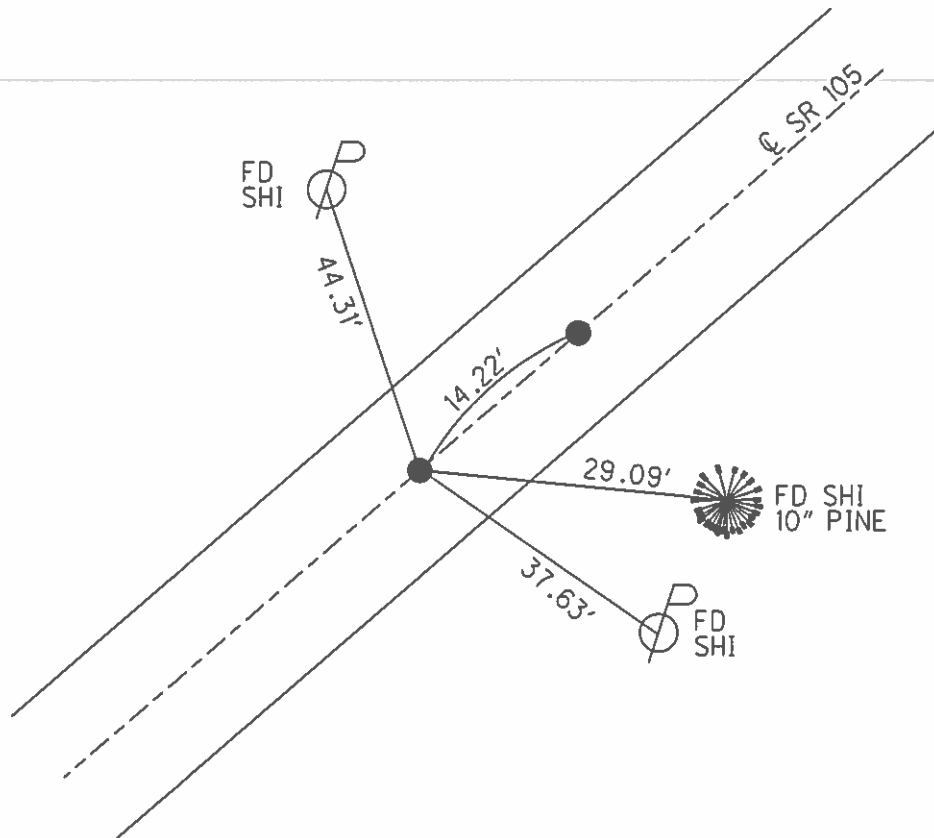

O.D.O.T. DISTRICT 2 SURVEY OFFICE

PERSONNEL

REFERENCE NO. 39-40

SHEET 50 OF 57

NOTES LONG

H.C. VANDUSEN

R.C. BARNHISEL

DATE 8-27-91

WEATHER SUNNY

TEMP. 85°

ROUTE 105

COUNTY WOOD

TOWNSHIP WEBSTER

SECTION 13

T 5 N R 11 E


TYPE MONUMENT P.K./WASHER "A", "B" & "C"

ON SURFACE - ~~BELOW~~ YES

~~LEFT~~ C PAV'T. - RIGHT 1.1

9.0 TO RT. EDGE PAVEMENT

S.L.M. 275+37

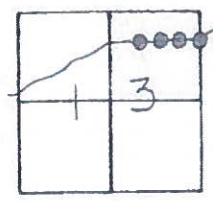


PT "D"
ORIGIN UNKNOWN
2.0 RT of ξ
8.5 TO RT Edge
Fd P.K. Nail

PT "C" P.O.T.
0.6 RT of ξ
9.4 TO RT Edge
Record: 217+95.78

PT "B" P.O.T.
1.1 RT of ξ
9.0 TO RT Edge
Record: 276+70.80

PT "A" P.O.T.
1.1 RT of ξ
9.0 TO RT Edge
Record: 276+56.63

A = 39A
B = 39B
C = 40
D = 39

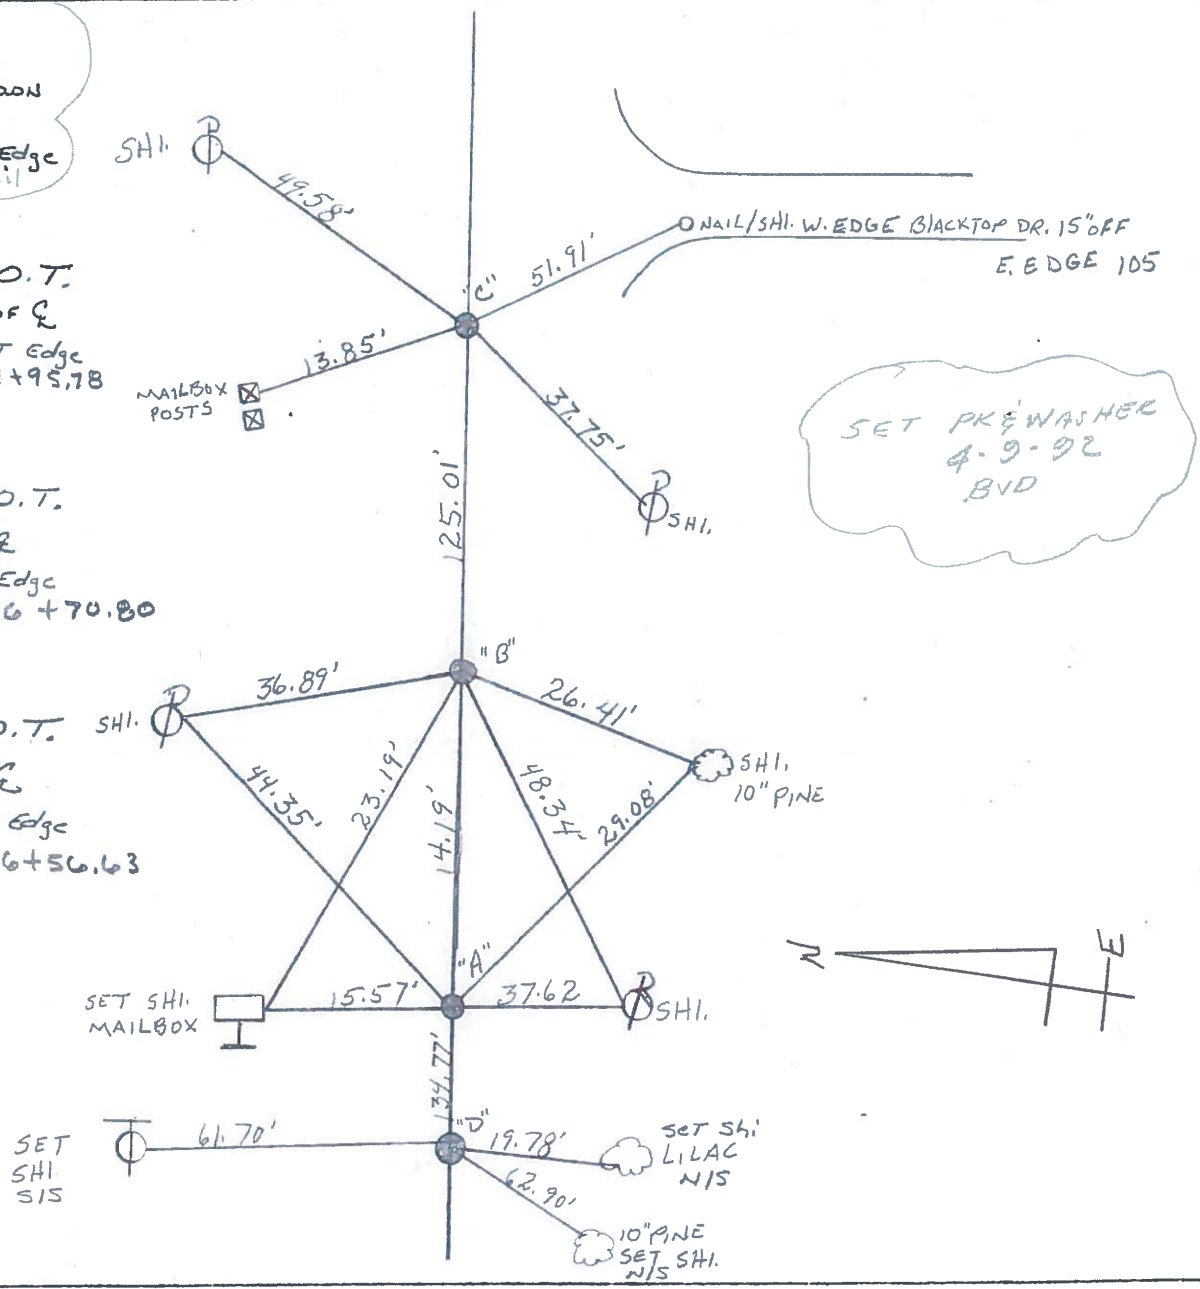

SET PK & WASHER
4-9-92
BVD

ON NAIL/SHI. W. EDGE BLACKTOP DR. 15' OFF
E. EDGE 105

Q.D.O.T. DISTRICT 2 SURVEY OFFICE

SHEET _____ OF _____

County WOOD S.R. 105

Date 4-21-82

Township WEBSTER

Weather WINDY

Section 13

Temp. +45°


T, N, R, E

Personnel HOFFMAN

HOUSEHOLDER

LOEHRKE


#39 - #40

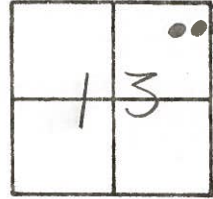

A=39A
B=39B
C=40
D=


SET P.K. & WASHER @ ALL
3-POINTS 5-27-82 S.W.H.

STA. 277+95.78 - P/L
P.O.T.

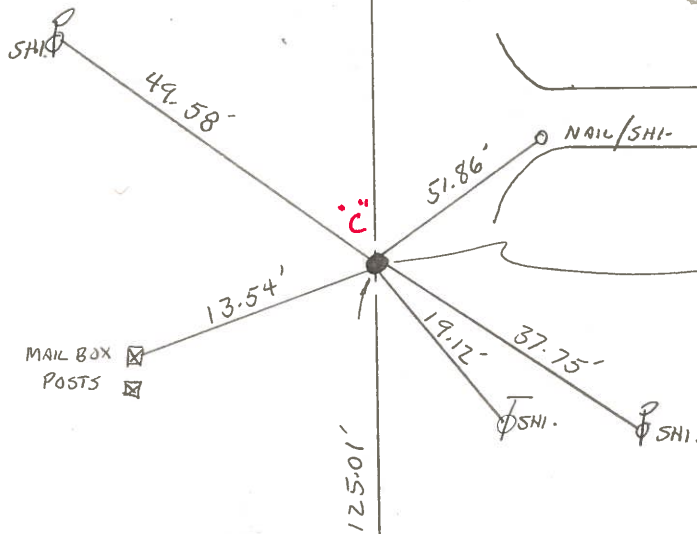


FD. P.K. NAIL
10.2' - TO N. EDGE
9.1' - TO S. EDGE
0.7' - RT. OF ϕ

STA. 276+70.80 - P/L
P.O.T.

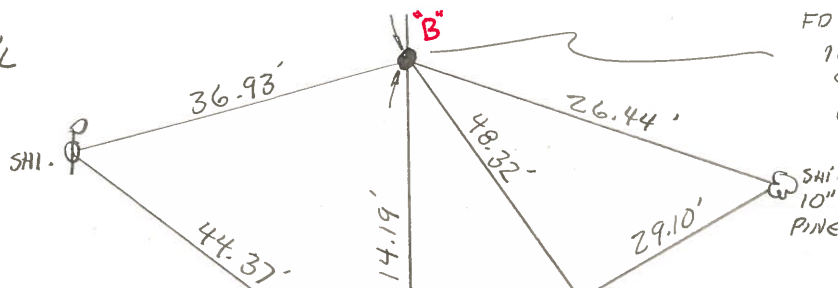

FD. P.K. NAIL TO SURFACE
10.0' - TO N. EDGE
9.2' - TO S. EDGE
0.3' - RT. OF ϕ

STA. 276+56.63 - P/L
P.O.T.

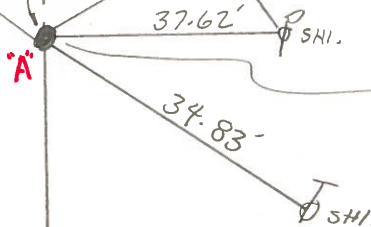

FD. P.K. NAIL TO SURFACE
8.8' - TO S. EDGE
10.0' - TO N. EDGE
0.35' - RT. OF ϕ