


O.D.O.T. DISTRICT 2 SURVEY OFFICE (USE ONLY)


PERSONNEL _____ REFERENCE NO. 39 B SHEET 42 OF 54
 NOTES RHOADES DATE 9/13/16 ROUTE SR 105
 H.C. O'DONNELL WEATHER FAIR COUNTY WOOD
 R.C. TODD TEMP. 58° TOWNSHIP WEBSTER
 _____ SECTION 13
 _____ T 5 N R 11 E

TYPE MONUMENT MAG/WASHER
 ON SURFACE - ~~BELOW~~ ON _____
~~LEFT~~ - CL PAV'T - RIGHT 1.1'
9' TORT EDGE PAVEMENT
 S.L.M. 275+51

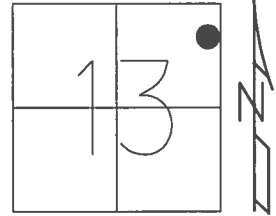

GRID: NORTHING: 632368.682 EASTING: 1685152.754


RECORD: P.O.T.
 STA. 276+70.80
 FD P.K./WASHER
 4/15/02, DCH
 SET P.K./WASHER
 6/13/02, DCH
 FD P.K.SHANK
 SET MAG/WASHER
 REFA39
 6/10/16, JFO
 SET 1" MAG/WASHER
 10/17/17, JFO

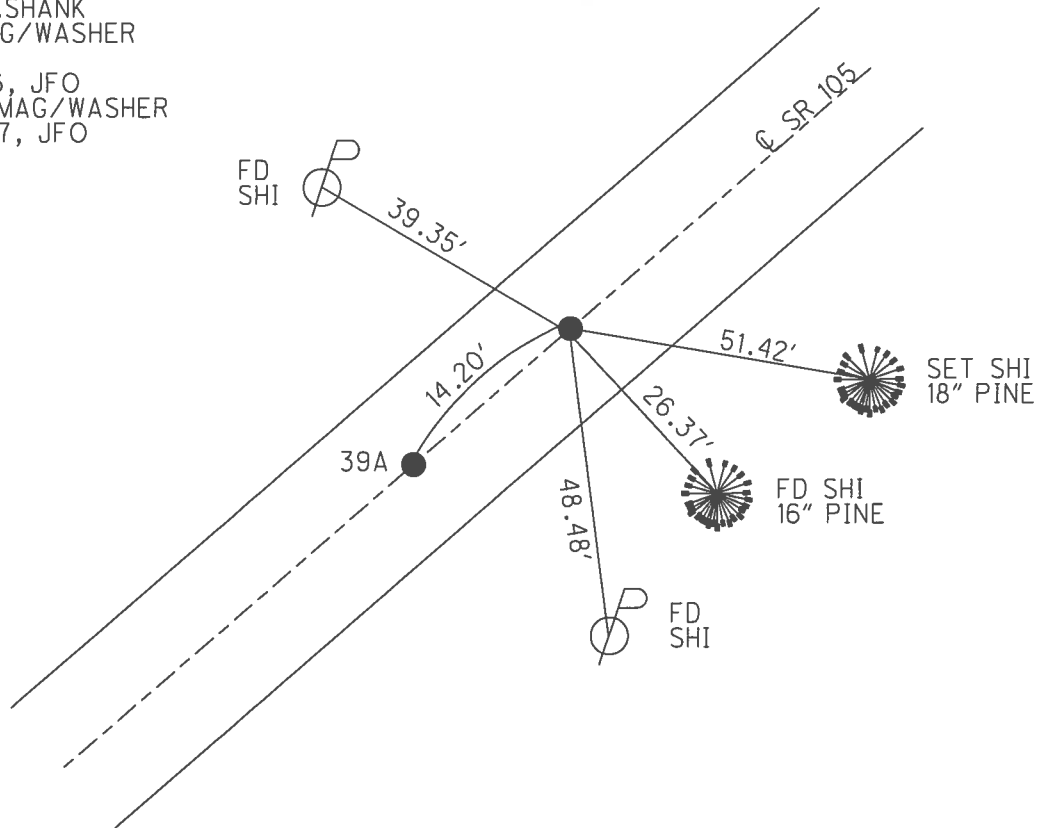

O.D.O.T. DISTRICT 2 SURVEY OFFICE (USE ONLY)


PERSONNEL _____ REFERENCE NO. 39 B SHEET 42 OF 54
 NOTES ROUSOS DATE 4/15/02 ROUTE SR 105
 H.C. HOMAN WEATHER PT SUNNY COUNTY WOOD
 R.C. BROWN TEMP. 60° TOWNSHIP WEBSTER
 _____ SECTION 13
 _____ T 5 N R 11 E

TYPE MONUMENT P.K./WASHER
 ON SURFACE - ~~BELOW~~ ON
~~LEFT~~ - Q PAV'T - RIGHT 1.1'
9' TORT EDGE PAVEMENT
 S.L.M. 275+51

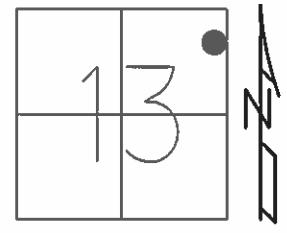

GRID: NORTHING: _____ EASTING: _____

RECORD: P.O.T.
 STA. 276+70.80
 SET P.K./WASHER
 6/13/02, DCH

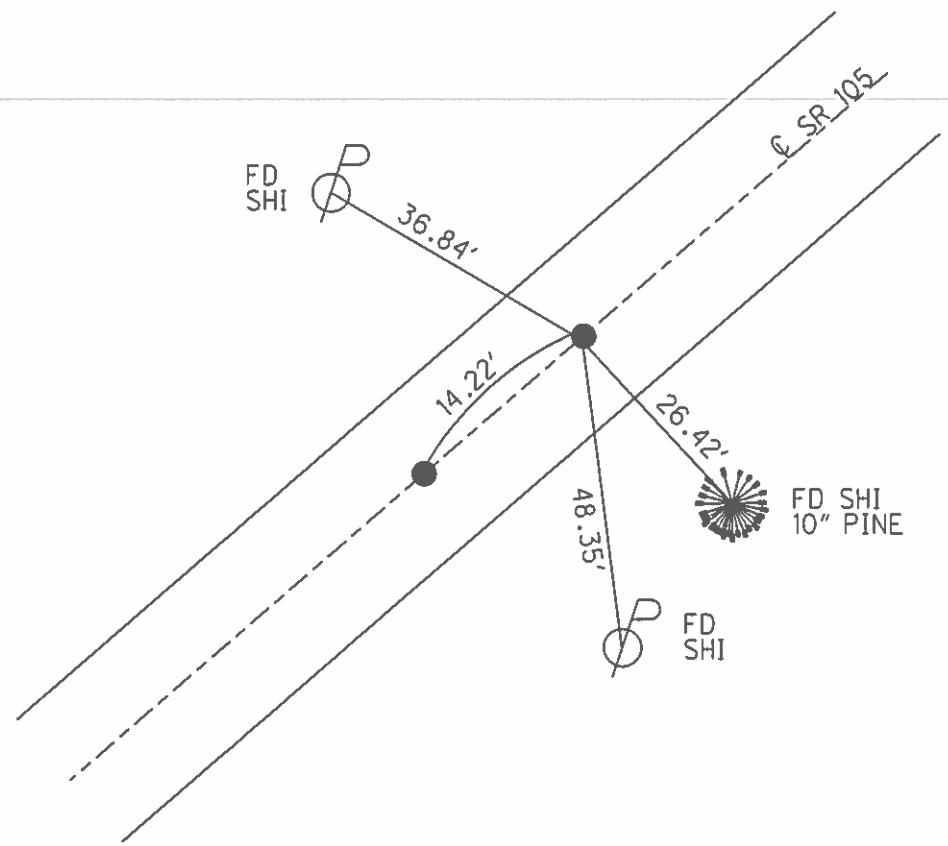

O.D.O.T. DISTRICT 2 SURVEY OFFICE

PERSONNEL

REFERENCE NO. 39-40

SHEET 50 OF 57

NOTES LONG

H.C. VANDUSEN

R.C. BARNHISEL

DATE 8-27-91

WEATHER SUNNY

TEMP. 85°

ROUTE 105

COUNTY WOOD

TOWNSHIP WEBSTER

SECTION 13

T5 N R 11 E



TYPE MONUMENT P.K./WASHER "A", "B" & "C"

ON SURFACE - ~~BELOW~~ YES

~~LEFT~~ C PAV'T. - RIGHT 1.1

9.0 TO RT. EDGE PAVEMENT

S.L.M. 275+37

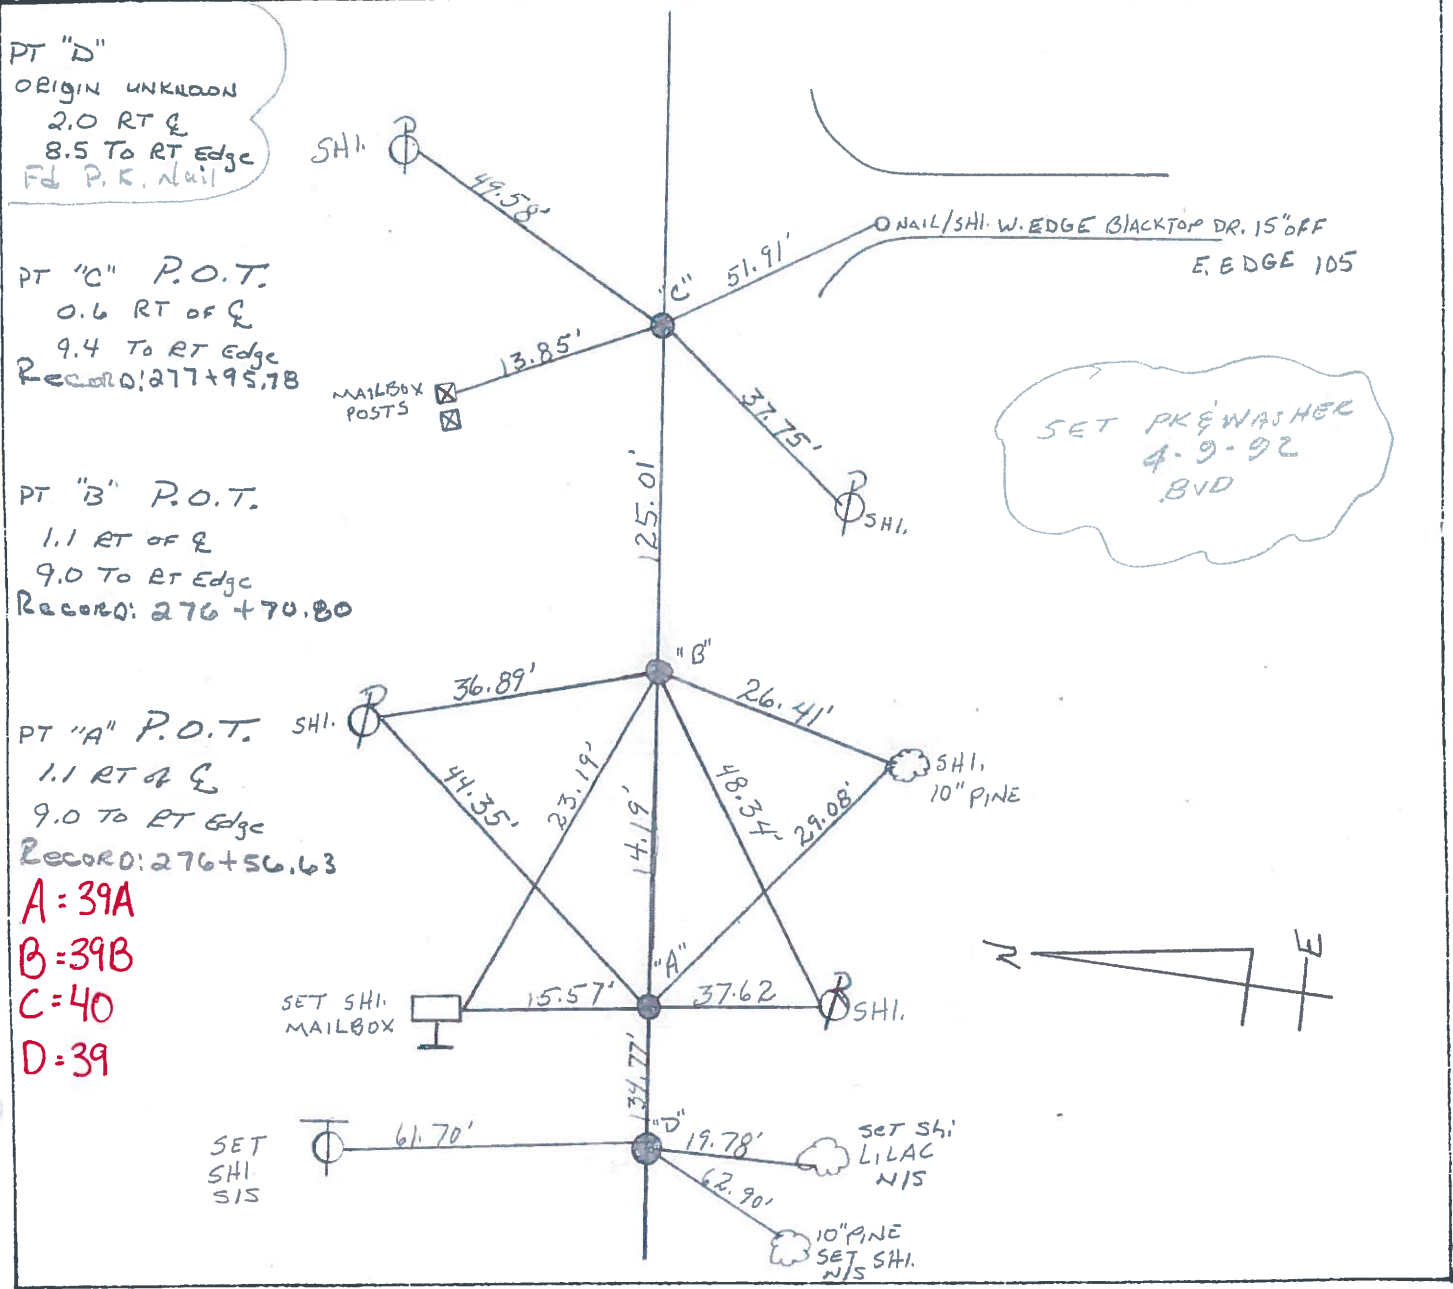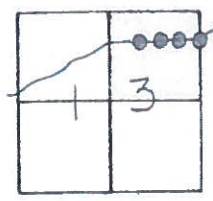

PT "D"
ORIGIN UNKNOWN
2.0 RT of ξ
8.5 TO RT Edge
Fd P.K. Nail

PT "C" P.O.T.
0.6 RT of ξ
9.4 TO RT Edge
Record: 277+95.78

PT "B" P.O.T.
1.1 RT of ξ
9.0 TO RT Edge
Record: 276+70.80

PT "A" P.O.T.
1.1 RT of ξ
9.0 TO RT Edge
Record: 276+56.63

A = 39A
B = 39B
C = 40
D = 39

SET PK & WASHER
4-9-92
BVD



County WOOD S.R. 105

Date 4-21-82

Township WEBSTER

Weather WINDY

Section 13

Temp. +45°


T N, R E

Personnel HOFFMAN

HOUSEHOLDER

LOEHRKE


#39 - #40

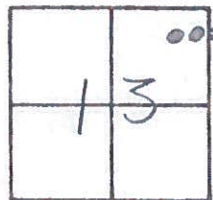


A = 39A
B = 39B
C = 40
D =

SET P.K. & WASHER @ A
3 POINTS 5-27-82 S.W.

STA. 277+95.78 - P/L
P.O.T.

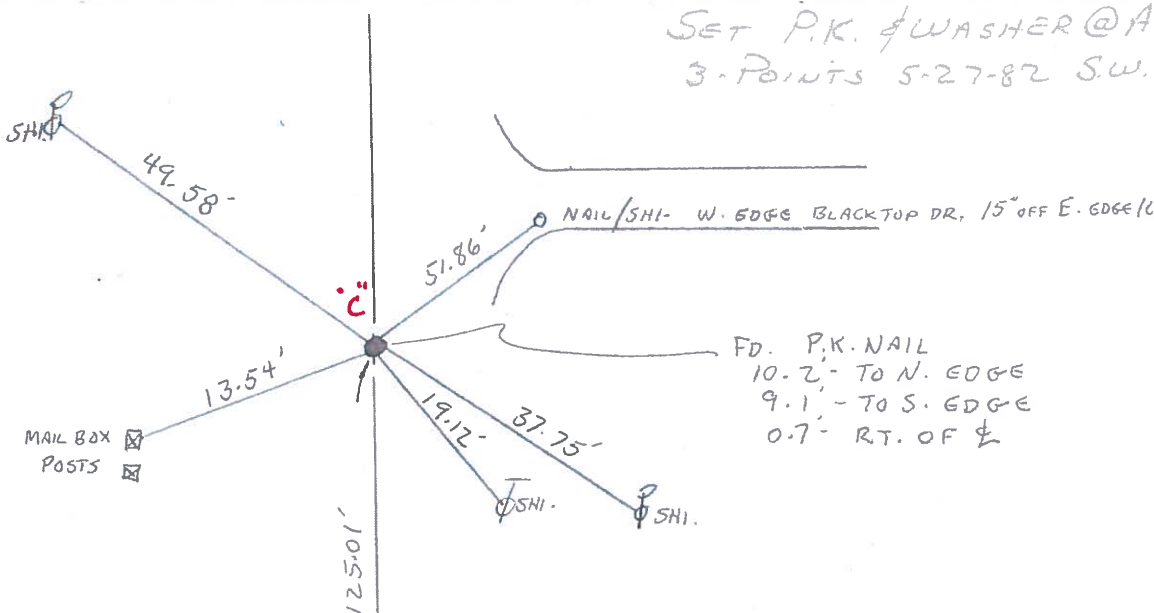

STA. 276+70.80 - P/L
P.O.T.

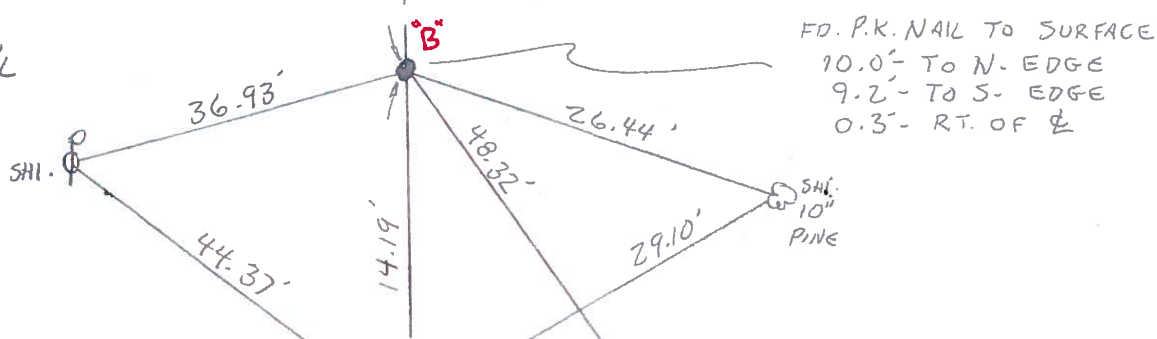

STA. 276+56.63 - P/L
P.O.T.

