


O.D.O.T. DISTRICT 2 SURVEY OFFICE (USE ONLY)


PERSONNEL _____ REFERENCE NO. 41 SHEET 44 OF 54
 NOTES RHOADES DATE 9/13/16 ROUTE SR 105
 H.C. O'DONNELL WEATHER FAIR COUNTY WOOD
 R.C. TODD TEMP. 58° TOWNSHIP WEBSTER
 SECTION 7
 T 5 N R 11 E

TYPE MONUMENT P.K.NAIL
 ON SURFACE - ~~BELOW~~ ON _____
~~LEFT~~ - ☉ PAV'T - RIGHT 3.5'
6.7' TO S EDGE PAVEMENT
 S.L.M. 279+69

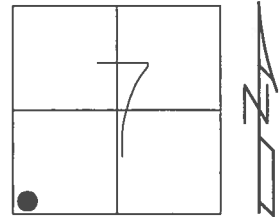

GRID: NORTHING: 632631.086 EASTING: 1685471.097


RECORD: P.I.
 STA. 280+89.22
 $\Delta = 2^\circ 23' 00''$ LT
 FD P.K./WASHER
 4/15/02, DCH
 SET P.K./WASHER
 5/31/02, DCH
 FD P.K.NAIL
 REF41
 6/10/16, JFO
 SET 1" MAG/WASHER
 NEWREF41
 10/17/17, JFO

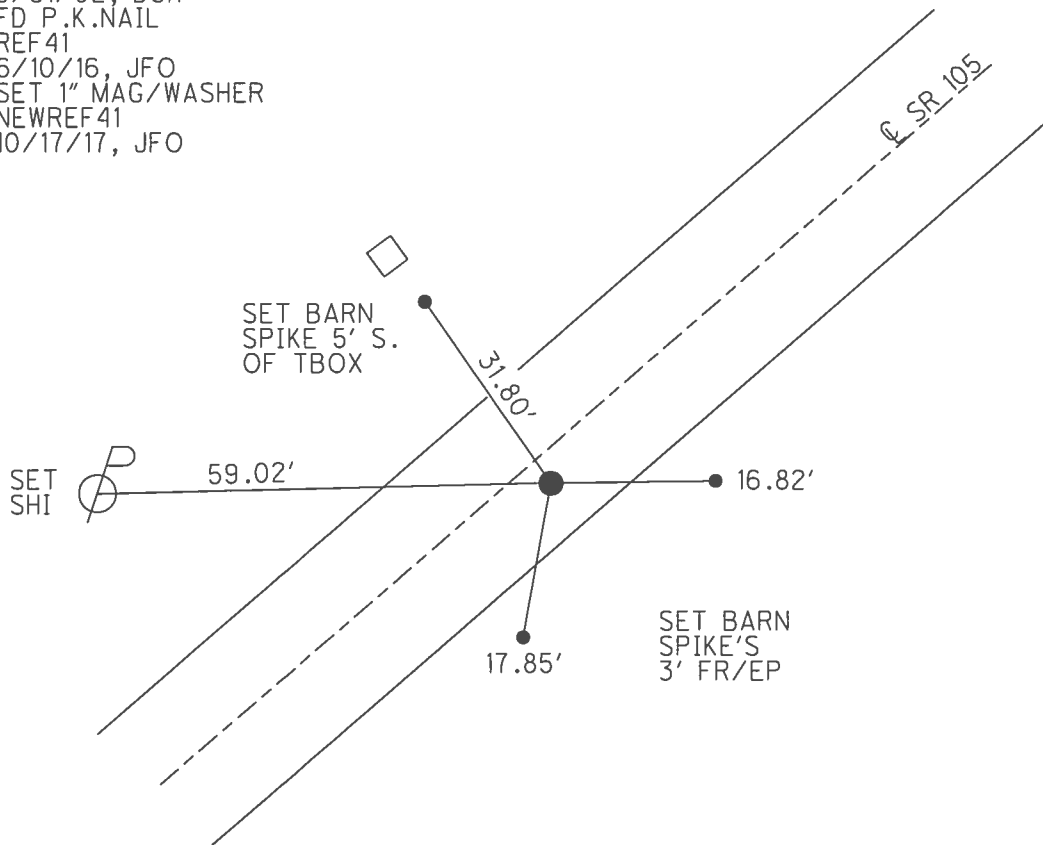


O.D.O.T. DISTRICT 2 SURVEY OFFICE (USE ONLY)

PERSONNEL	REFERENCE NO.	41	SHEET	44	OF	54
NOTES	ROUSOS	DATE	4/15/02	ROUTE	SR 105	
H.C.	HOMAN	WEATHER	SUNNY	COUNTY	WOOD	
R.C.	BROWN	TEMP.	74°	TOWNSHIP	WEBSTER	
				SECTION	7	
				T	5	N
				R	11	E

TYPE MONUMENT P.K./WASHER
 ON SURFACE - ~~BELOW~~ ON
~~LEFT~~ - CL PAV'T - RIGHT 3.5'
6.7' TO S EDGE PAVEMENT
 S.L.M. 279+69
 GRID: NORTHING: _____ EASTING: _____

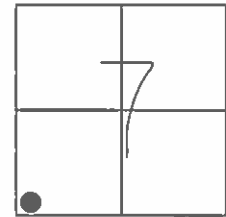

RECORD: P.I.
 STA. 280+89.22
 $\Delta = 2^\circ 23' 00''$ LT
 SET P.K./WASHER
 5/31/02, DCH

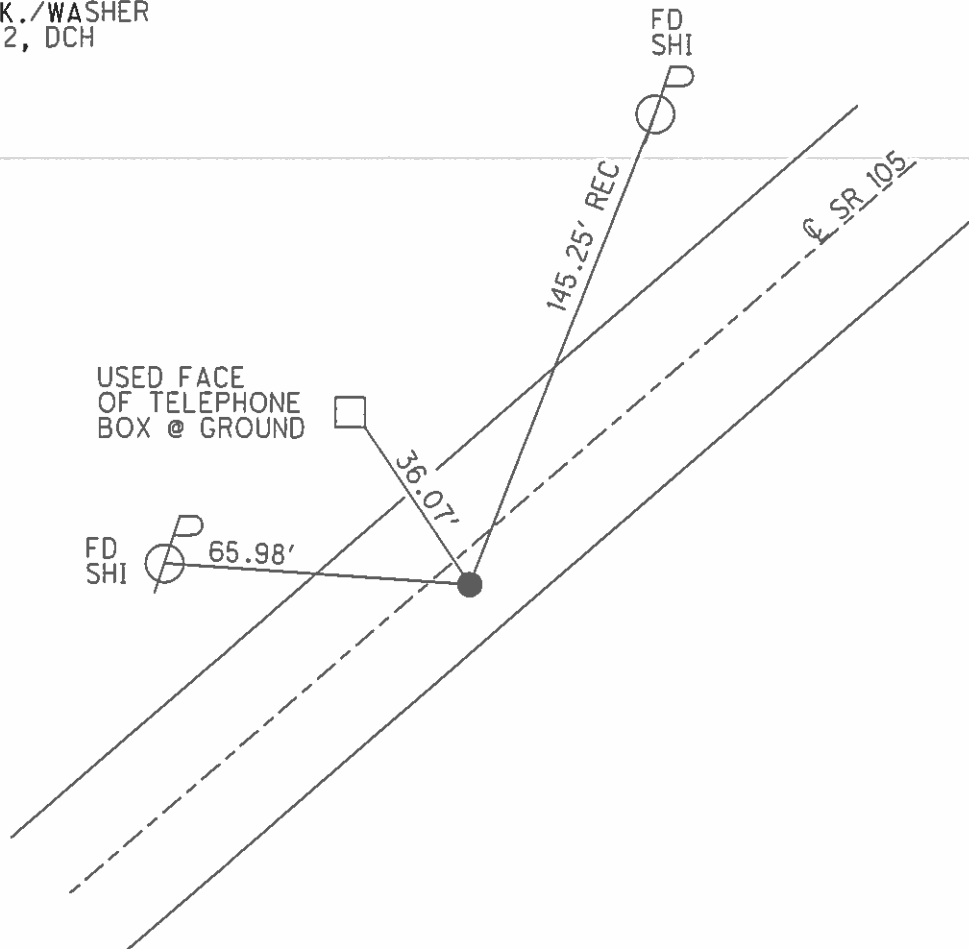

O.D.O.T. DISTRICT 2 SURVEY OFFICE

PERSONNEL _____

REFERENCE NO. 41

SHEET 51 OF 57

NOTES LONG

H.C. VANDUSEN

DATE 8-27-91

ROUTE 105

R.C. BARNHISEL

WEATHER SUNNY

COUNTY WOOD

TEMP. 85°

TOWNSHIP WEBSTER

SECTION 7

T 5 N R 11 E


TYPE MONUMENT P.K. / WASHER

ON SURFACE - BELOW YES

~~LEFT~~ - 6 PAV'T. - RIGHT 3.5'


6.7' TO S EDGE PAVEMENT

S.L.M. 279+69

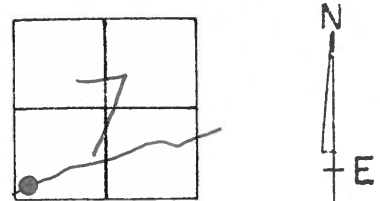

SET PK& WASHER
11-26-91
BVD

RECORD
P.I. #36
280+89.22
 $\Delta = 2^{\circ} - 23' - 00''$ LT.

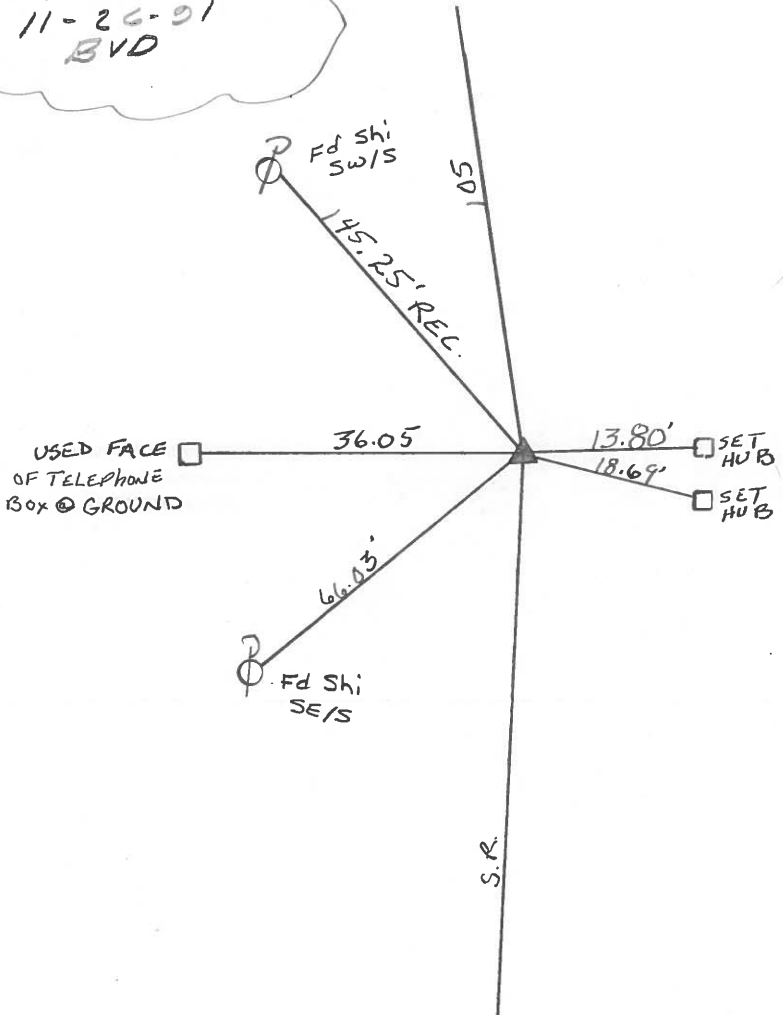

County WOOD S.R. 105

Date 4-21-82

Township WEBSTER

Weather CLEAR

Section 7

Temp. +45°


T N, R E

Personnel HOFFMAN

HOUSEHOLDER

LOEHRKE

#41

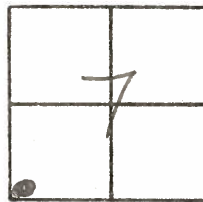


P.I. #36

280+89.22

$\Delta = 2^{\circ}-23'-00''$ LT.

SET P.K./WASHER
5-27-82 S.W.H.

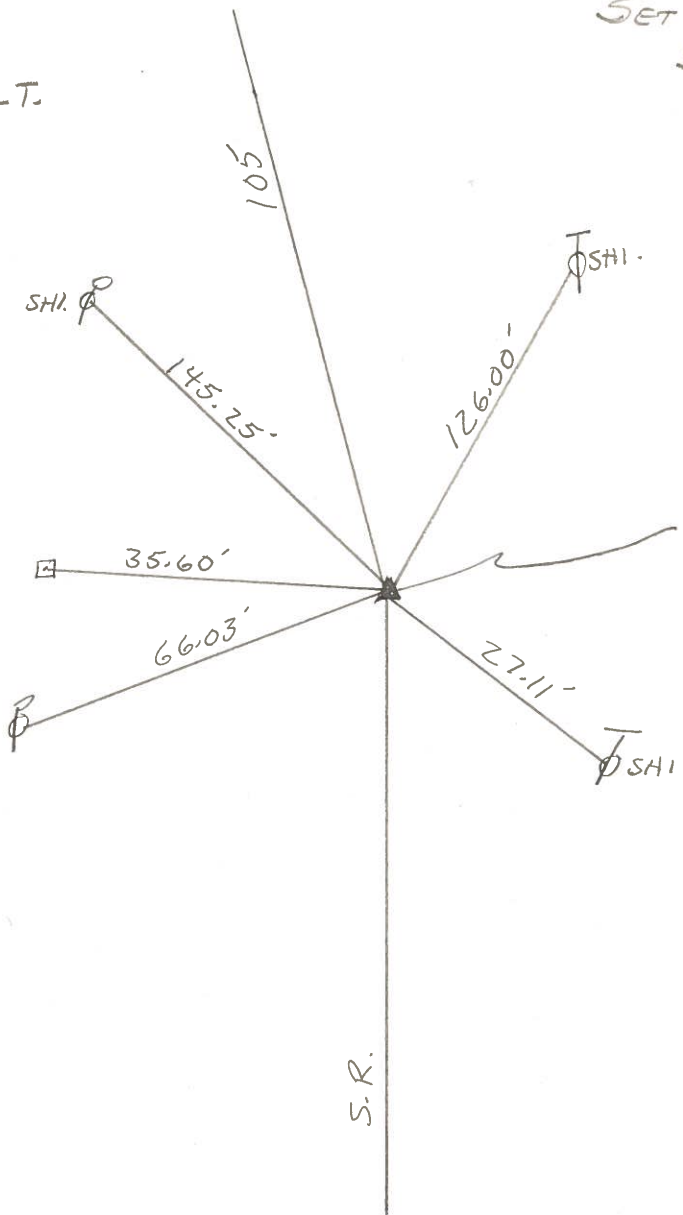

FD. SMALL R.R. SPK. @ SURFACE
13.2' - TO N. EDGE
6.7' - TO S. EDGE
2.9' - RT. OF Φ

PERSONNEL	TITLE	PERSONNEL	TITLE	COUNTY	DATE
Stane		Brennan		Wood	16 July 73
Michalak				S. R. #105	WEATHER Mild
Deano				SEC. Webster Twp.	TEMP. 78°
Curtis					

DESCRIPTION References to Control Points JOB NO. _____

