


O.D.O.T. DISTRICT 2 SURVEY OFFICE (USE ONLY)


PERSONNEL _____ REFERENCE NO. 42 SHEET 45 OF 54
 NOTES RHOADES DATE 9/13/16 ROUTE SR 105
 H.C. O'DONNELL WEATHER FAIR COUNTY WOOD
 R.C. TODD TEMP. 58° TOWNSHIP WEBSTER
 _____ SECTION 7
 _____ T 5 N R 11 E

TYPE MONUMENT P.K./WASHER
 ON SURFACE - ~~BELOW~~ ON _____
 LEFT - ☉ PAV'T - ~~RIGHT~~ 9.5'
1.2' TO LT EDGE PAVEMENT
 S.L.M. 285+51

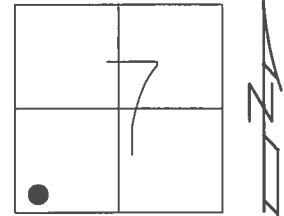

GRID: NORTHING: 633023.783 EASTING: 1685909.580


RECORD: P.I.
 STA. 286+71.80
 $\Delta = 14^\circ 44' 20''$ RT
 FD P.K./WASHER
 4/15/02, DCH
 SET P.K./WASHER
 6/13/02, DCH
 FD P.K./WASHER
 REF42
 6/10/16, JFO
 SET 1" MAG/WASHER
 10/17/17, JFO

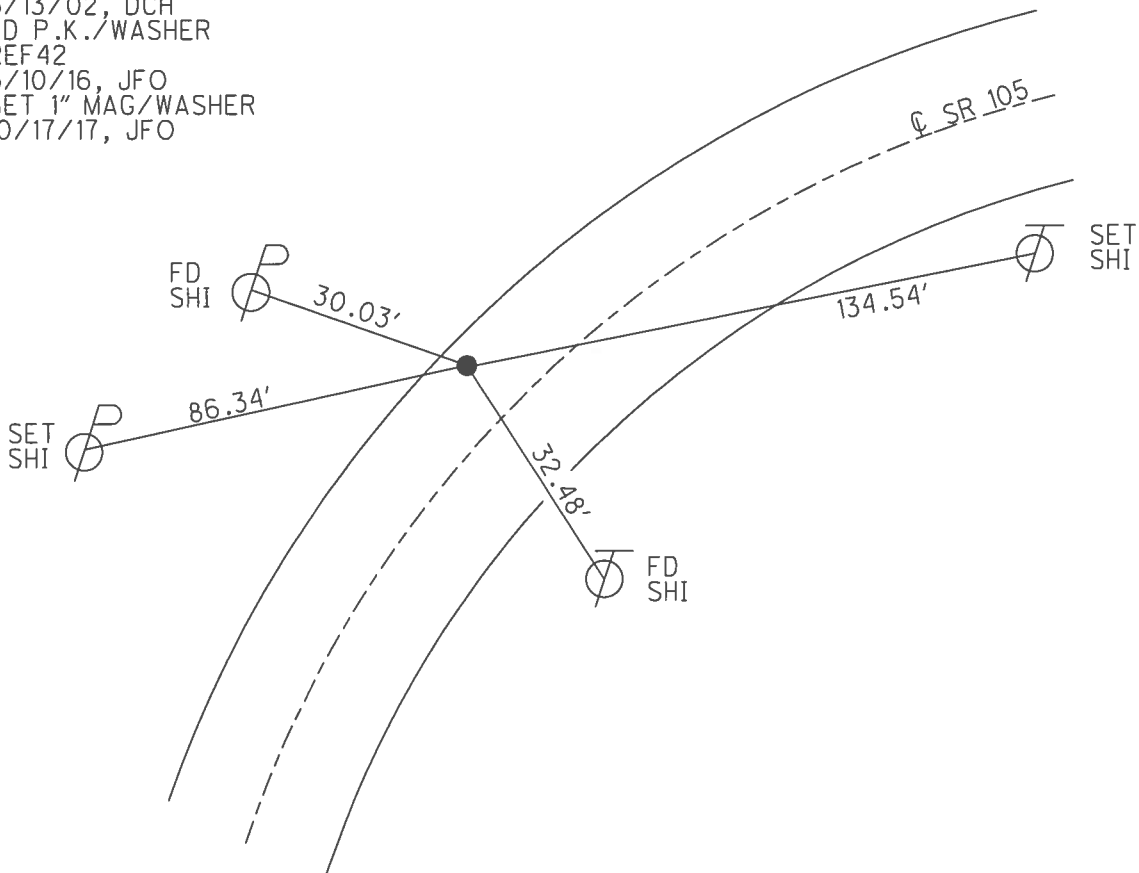

O.D.O.T. DISTRICT 2 SURVEY OFFICE (USE ONLY)


PERSONNEL _____ REFERENCE NO. 42 SHEET 45 OF 54
 NOTES ROUSOS DATE 4/15/02 ROUTE SR 105
 H.C. HOMAN WEATHER SUNNY COUNTY WOOD
 R.C. BROWN TEMP. 74° TOWNSHIP WEBSTER
 SECTION 7
T 5 N R 11 E

TYPE MONUMENT P.K./WASHER
 ON SURFACE - ~~BELOW~~ ON _____
 LEFT - ☉ PAV'T - ~~RIGHT~~ 9.5'
1.2' TO LT EDGE PAVEMENT
 S.L.M. 285+51

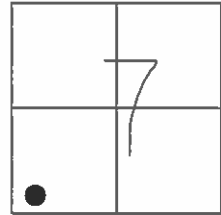

GRID: NORTHING: _____ EASTING: _____

RECORD: P.I.
 STA. 286+71.80
 $\Delta = 14^\circ 44' 20''$ RT
 SET P.K./WASHER
 6/13/02, DCH

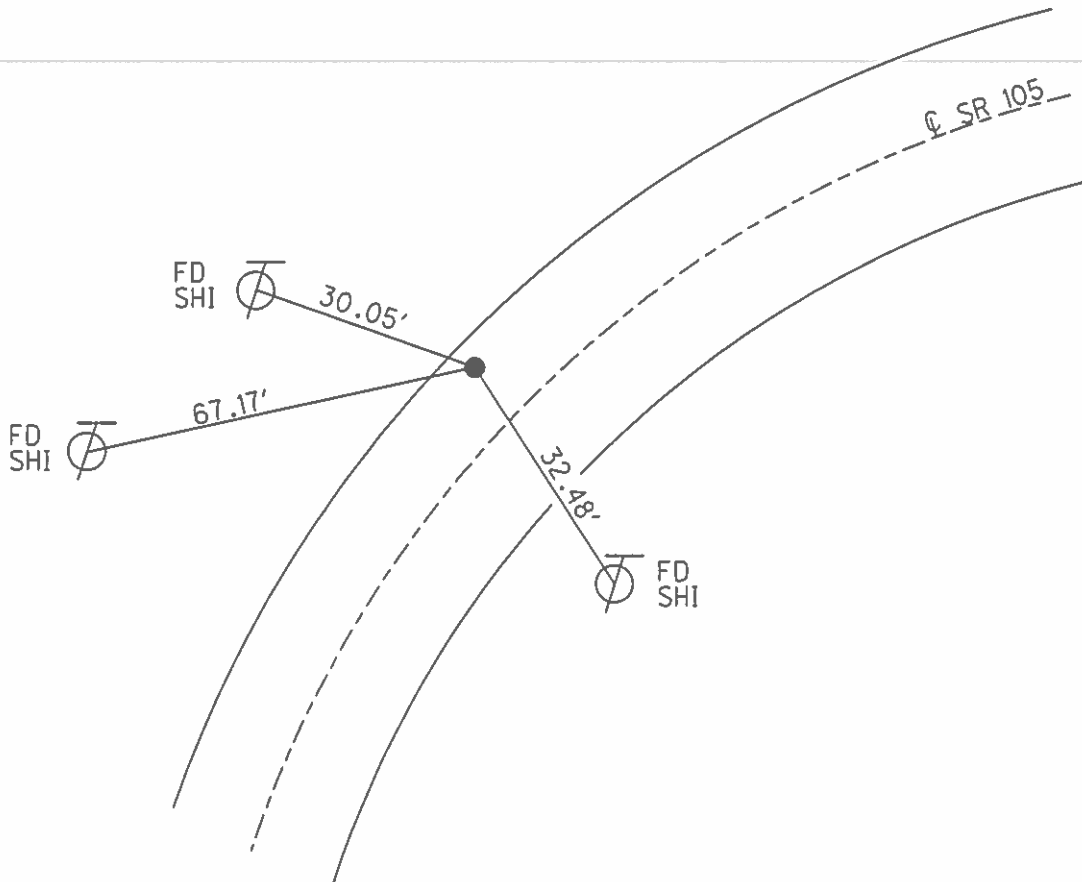

O.D.O.T. DISTRICT 2 SURVEY OFFICE

PERSONNEL _____

REFERENCE NO. 42

SHEET 52 OF 57

NOTES LONG

H.C. VANDUSEN

DATE 8-27-91

ROUTE 105

R.C. BARNHISEL

WEATHER SUNNY

COUNTY WOOD

TEMP. 88°

TOWNSHIP WEBSTER

SECTION 7

T.5 N R.11 E


TYPE MONUMENT P.K. / WASHER

ON SURFACE - ~~BELOW~~ YES

LEFT - C PAV'T. - ~~RIGHT~~ 9.5'


1.2' TO LT. EDGE PAVEMENT

S.L.M. 285+51

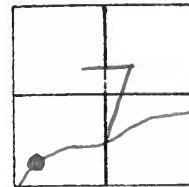

SET PK& WASHER
4-9-92
BVD

RECORD
P.I #37
286+71.80
Δ = 14°-44'-20" RT.

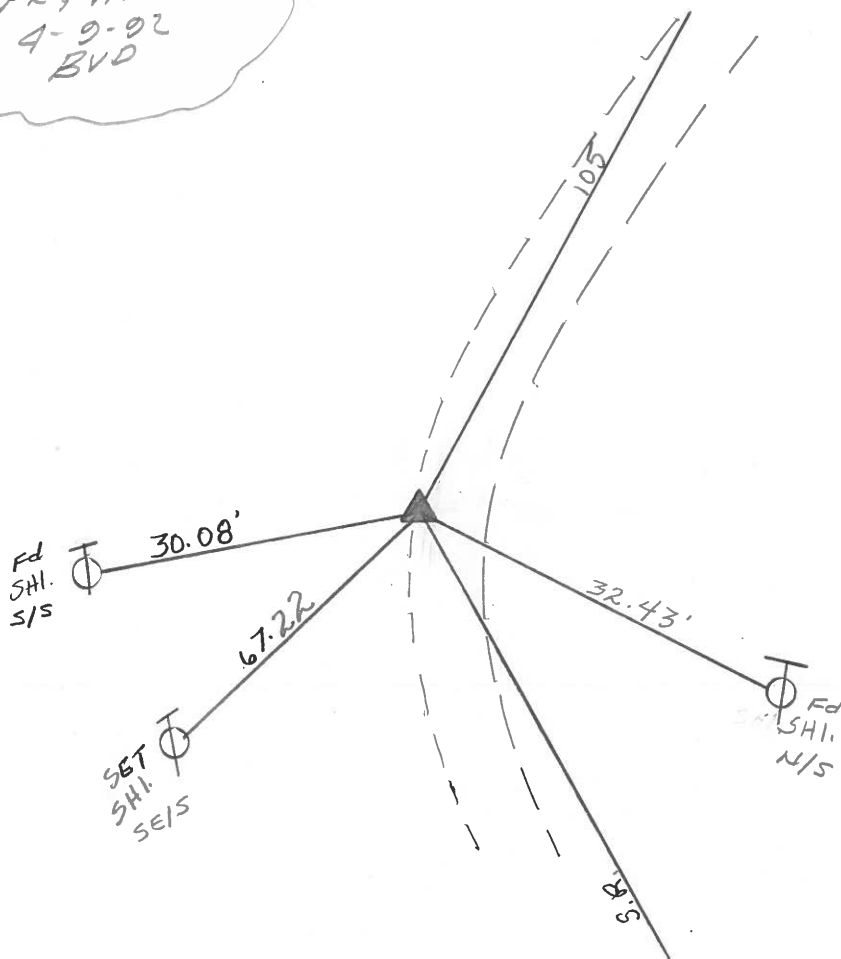

County WOOD S.R. 105

Township WEBSTER

Section 7

T. N, R. E

Personnel HOFFMAN

HOUSEHOLDER


LOEHRKE

#42

Date 4-21-82

Weather WINDY

Temp. +40°

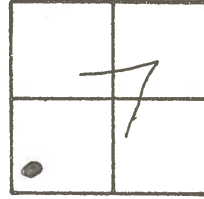


P.I. #37

286+71.80

$\Delta = 14^{\circ} - 44' - 20''$ RT.

SET P.K./WASHER
5-27-82 S.W.H.

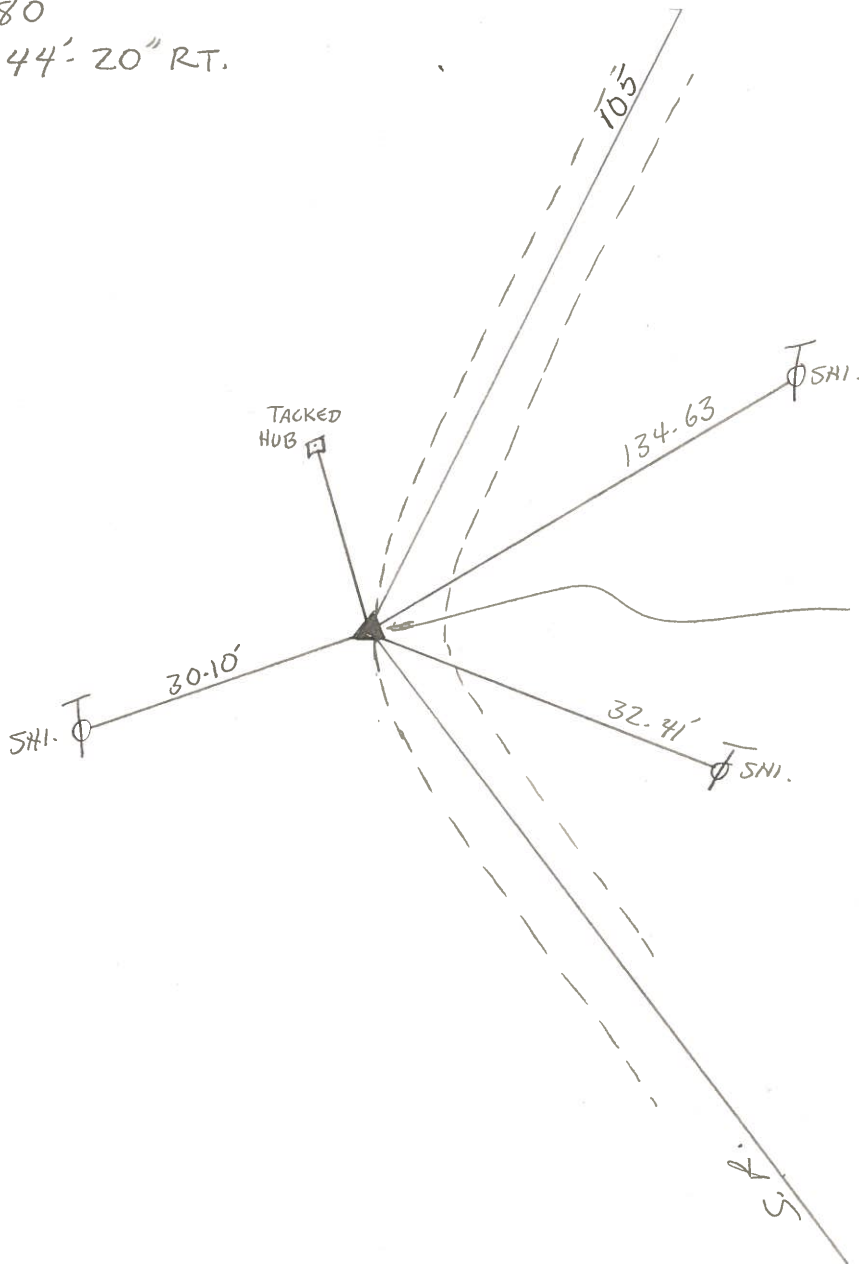

FD. R.R. SPK. - 0.15' BELOW
ON EDGE OF PAVT.
10.1 LT. OF \perp

PERSONNEL TITLE PERSONNEL TITLE

Stone Michaelak Dennis Curtis

COUNTY Wood DATE 16 July 73

S. R. #105 WEATHER Fair

SEC. Webster Twp. TEMP. 78°

DESCRIPTION References to Control Points JOB NO.

